



Addendum 1
Project No. 9557460, UCD Medical Campus Operating Rooms Modernization
Bid Packages 5.1, 7, 10, 17

This addendum to the RFP documents consists of page AD-1-1 thru AD1-3 and attachments. The following changes, additions, or deletions shall be made to the listed documents as indicated, and all other conditions shall remain the same.

RFI RESPONSES

1. Question (General): At the teams meeting it was mentioned that there could be a possibility that work could be paused during a normal shift? If this were to occur who will be responsible for the time/production lost that day?

Response: In the event this occurs, it will be addressed on a case-by-case basis. Bidder shall bid to the schedule durations provided.

2. Question (BP 5.1, Demo & Abatement): Will we have a lay down area for bins, or do we need to base our pricing on removing waste from the site every day? If there is one can you provide a map of where this will be located?

Response: The project does have a small laydown area. See attached *Site Logistics Plan*. Refer to the *General Scope of Work and Project Specific Conditions* that begins on page 10 of the Bid Package 5.1. Section E, Site Logistics, item 12 Clean Up provides information on the removal of waste. As noted, Swinerton will provide dump carts and Swinerton will be responsible for conveying the bins to/from the debris and recycling containers with the exception of hazmat as indicated. Also, the *Scope of Work and Project Specific Conditions Demolition & Lead Abatement* (starting on page 22), the following items 4 and 5 have been striked out on page 25:

~~4. Provide covered carts for transporting debris from the demolition site to the dumpsters.~~

~~5. Include additional mobilizations to demolish temporary barriers upon completion of each phase.~~

3. Question (General): Can you provide photos of a typical OR room and the other areas of work?

Response: Pictures are not available with ORs in use.

4. Question (BP-5, Demo & Abatement): Who will be responsible to provide temporary walls per each phase?

Response: The General Contractor will be responsible for the temporary partitions, both install and removal.

5. Question (General): Could you please provide the teams meeting slides.



Response: See attached plans shown during the pre-bid meeting. We are also attaching an enhanced version of the Site Logistics plan, because the original version included in the Box folder had some words cut off.

6. Question (BP-7, DFH): The permit 3 set of plans is extremely unclear as to the scope of the DFH work. The bid package skips over the permit 3 scope of work but notes it directly in alternate 3. It is unclear if this is all the information that is being provided to price up this alternate or not. If so, can we get an identification as to the size of doors and the hardware sets that are intended for use here?

Response: Permit 3 is to be priced as an add alternate and is not in base budget scope at this point. Utilize the following assumption for pricing the add alternate:

Opening	Size	Dr Matl	Fr Mat	Rating	Card Read	HDW Set
3P200CX	6070	WD	HM	60	CR	Custom
3P200CY	3070	WD	HM	60	CR	04
3P219Y	3070	WD	HM	60	CR	04
3P219B	3070	WD	HM	60		02
3P230BZ	3070	WD	HM		CR	04
3P230BX	3070	WD	HM		CR	04
3P230BY	3070	WD	HM		CR	04
3P219A	3070	WD	HM	60		02

HARDWARE SET NO. 02

<u>QTY</u>		<u>DESCRIPTION</u>	<u>CATALOG NUMBER</u>	<u>FINISH</u>	<u>MFR</u>
3	EA	HINGE	5BB1HW 4.5 X 4.5	652	IVE
1	EA	HOSPITAL LATCH	HL6 2 3/4" A	630	SCH
1	EA	SURFACE CLOSER	4040XP DEL RW/PA	689	LCN
2	EA	ARMOR PLATE	8400 34" X 2" LDW B-CS	630	IVE
1	EA	WALL STOP	WS401/402CCV	626	IVE
1	EA	GASKETING	188SBK PSA	BK	ZER
1	EA	DOOR BOTTOM	350AA	AA	ZER

HARDWARE SET NO. 04

<u>QTY</u>		<u>DESCRIPTION</u>	<u>CATALOG NUMBER</u>	<u>FINISH</u>	<u>MFR</u>
2	EA	HINGE	5BB1HW 4.5 X 4.5	652	IVE
1	EA	ELECTRIC HINGE	5BB1HW 4.5 X 4.5 TW8	652	IVE
1	EA	EU STOREROOM LOCK	ND80TDEU RHO RX 12/24 VDC	626	SCH
1	EA	PERMANENT CORE	23-030 (EF KEYWAY)	626	SCH
1	EA	SURFACE CLOSER	4040XP RW/PA	689	LCN
1	EA	ARMOR PLATE	8402 34" X 2" LDW B-CS	630	IVE
1	EA	WALL STOP	WS401/402CCV	626	IVE
1	EA	GASKETING	188SBK PSA	BK	ZER
		CARD READER	BY WORK OF DIVISION 28		
		POWER SUPPLY	BY WORK OF DIVISION 28		



7. Question (General): The bond requirements note that bids over \$200,000 will require a bid bond. Bid package 7.0, for example, calls out as a value of \$95K. Is this bond price requirement based on the base bid value or of the bid with the alternates?

Response: The Bid Bond refers to the lump sum base bid only. If lump sum base bid before adding any alternates is under \$200,000, a bid bond is not required.

8. Question (BP-7, DFH): What is the lead requirement for the lead lined stainless windows and lead lined door 3P735X? It doesn't appear that the frame is to hold any lead lining, only lead glass, please confirm. Additionally what mechanism is to hold the glass in place as detail is unclear?

Response: Please refer to revised door schedule A-1601 for door & window properties. Also see A-1602 for head, jamb and sill details. See physicist report for additional information on lead requirements.

9. Question (BP-7, DFH): 3P735Y does not call out to be a lead lined door, but it appears as if it should be. Please verify.

Response: Per the Physicist Report provided to the design team, this door is not required to be lead lined and therefore was not noted as such in the drawings.

5. Question (BP-7, DFH): Please clarify which OR doors need closers replaced?

Response: See attached for highlighted scope exhibit where this is required. This is for the existing pair of doors on the dirty side section of each OR as specified on the door schedule. This is required at each of the 24 ORs.

DocuSigned by:

Lisa Hinton

D6185A12E133405...

Lisa Hinton

Project Manager

Facilities Planning and Development

4800 2nd Ave, FSSB Suite 3010

Sacramento, CA 95817

Employee Parking and Shuttle Services Map




Parking and Transportation Services

4800 2nd Avenue, Suite 1100
Sacramento, CA 95817

health.ucdavis.edu/parking

916-734-2687

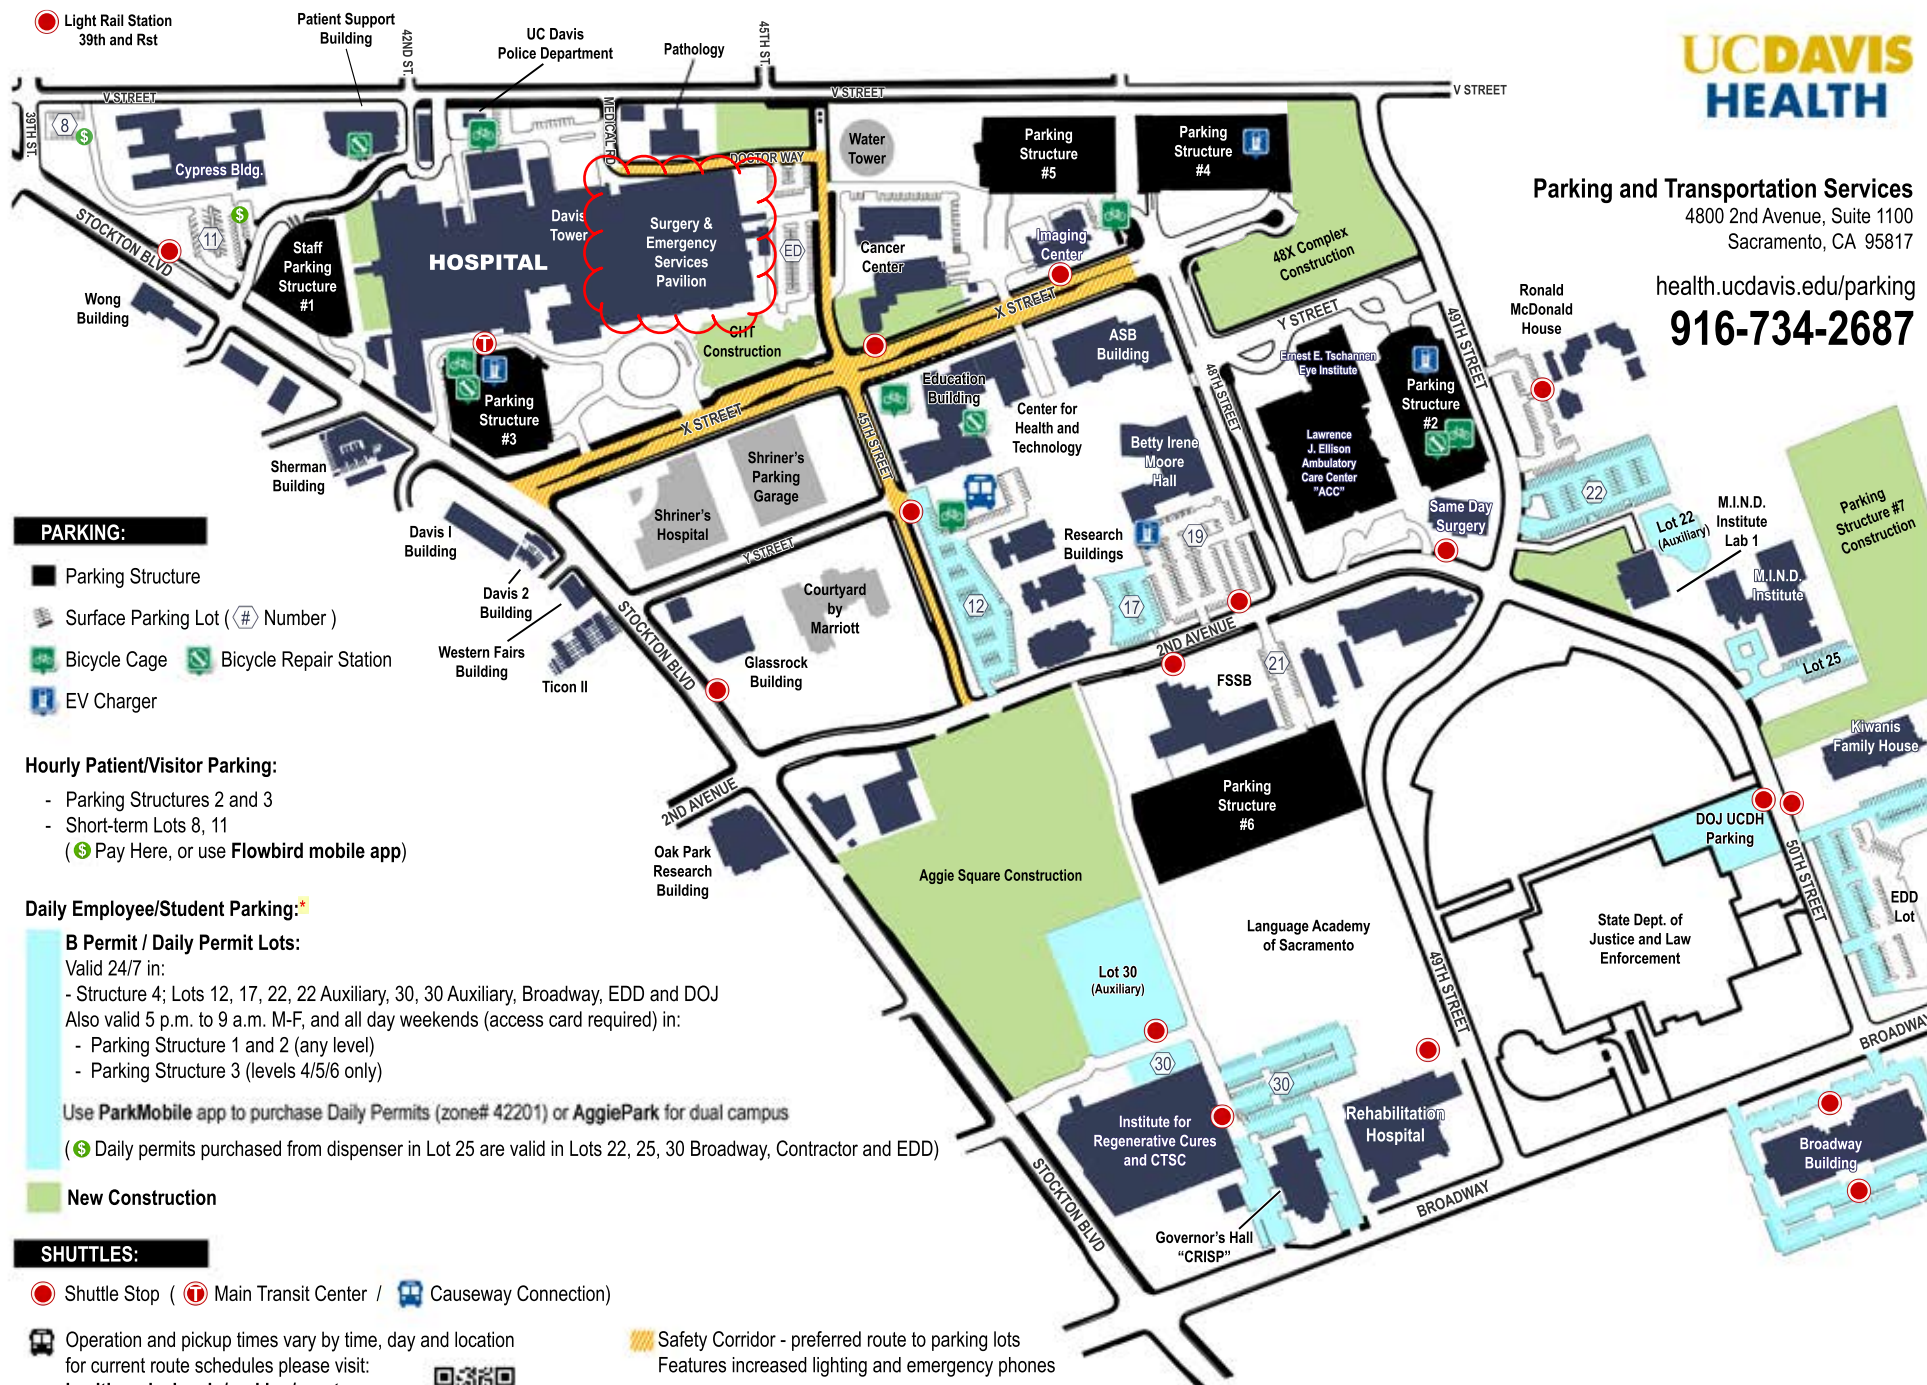

PARKING:

- Parking Structure
- Surface Parking Lot (# Number)
- Bicycle Cage
- Bicycle Repair Station
- EV Charger

Hourly Patient/Visitor Parking:

- Parking Structures 2 and 3
- Short-term Lots 8, 11
- (Pay Here, or use Flowbird mobile app)

Daily Employee/Student Parking:

B Permit / Daily Permit Lots:

Valid 24/7 in:

- Structure 4; Lots 12, 17, 22, 22 Auxiliary, 30, 30 Auxiliary, Broadway, EDD and DOJ

Also valid 5 p.m. to 9 a.m. M-F, and all day weekends (access card required) in:

- Parking Structure 1 and 2 (any level)
- Parking Structure 3 (levels 4/5/6 only)

Use **ParkMobile** app to purchase Daily Permits (zone# 42201) or **AggiePark** for dual campus

(Daily permits purchased from dispenser in Lot 25 are valid in Lots 22, 25, 30 Broadway, Contractor and EDD)

New Construction

SHUTTLES:

- Shuttle Stop (Main Transit Center / Causeway Connection)

- Operation and pickup times vary by time, day and location for current route schedules please visit: health.ucdavis.edu/parking/courtesy →

For pickup requests call: (916) 734-2687

- Safety Corridor - preferred route to parking lots
Features increased lighting and emergency phones

* To manage your parking account, visit ucdmc.aimsparking.com or use the **ParkMobile** app to purchase daily permits

UCDH SESP OR MODERNIZATION PHASING PLAN

PRELIMINARY:
NOT FOR
CONSTRUCTION

DEPARTMENT OF HEALTHCARE ACCESS AND INFORMATION

UCDAVIS
HEALTH
FACILITIES DESIGN & CONSTRUCTION
4800 2ND AVENUE SUITE 3010
SACRAMENTO, CALIFORNIA 95817
(916) 734-7824

TAYLOR
design

CONSULTANT LOG:

REV	REVISION DESCRIPTION	DATE

PROJECT STATUS

ARCHITECT PROJECT NO.: 6490
OSHPH NO.: TBD
BUILDING: 02841
FLOOR WING: OR MODERNIZATION

PROJECT TITLE: OR MODERNIZATION
SHEET TITLE: LEVEL 3 OVERALL FLOOR PLAN - ELECTRICAL AREAS OF WORK


ARCH/ENGR: ECOM	FD&C JOB NO.: <JOB NO.>	SHEET NO.: E-103	
UCDMC PROJ. MANAGER: LH	SCALE: AS SHOWN		
DESIGNED BY: ECOM	DATE: 05/11/2016		
DRAWN BY: ECOM	CAD FILE: -	SHEET	OF

Legend OR Phase

Description	Quantity	Unit
Phase 1 - OR	4	Count
Phase 2 - OR	4	Count
Phase 3 - OR	4	Count
Phase 4 - OR	4	Count
Phase 5 - OR	4	Count
Phase 6 - OR	4	Count

Legend PACU Phase


Description	Quantity	Unit
Misc. Locations	6	Count
Phase 1 - RHT PACU	5	Count
Phase 2 - PHT PACU	5	Count
Phase 3 - RHT PACU	5	Count
Phase 4 - PACU	7	Count
Phase 5 - PACU	5	Count
Phase 6 - PACU	6	Count
Phase 7 - PACU	10	Count
Phase 8 - PACU	9	Count
Phase 9 - PACU	6	Count
Phase 10 - PACU	7	Count

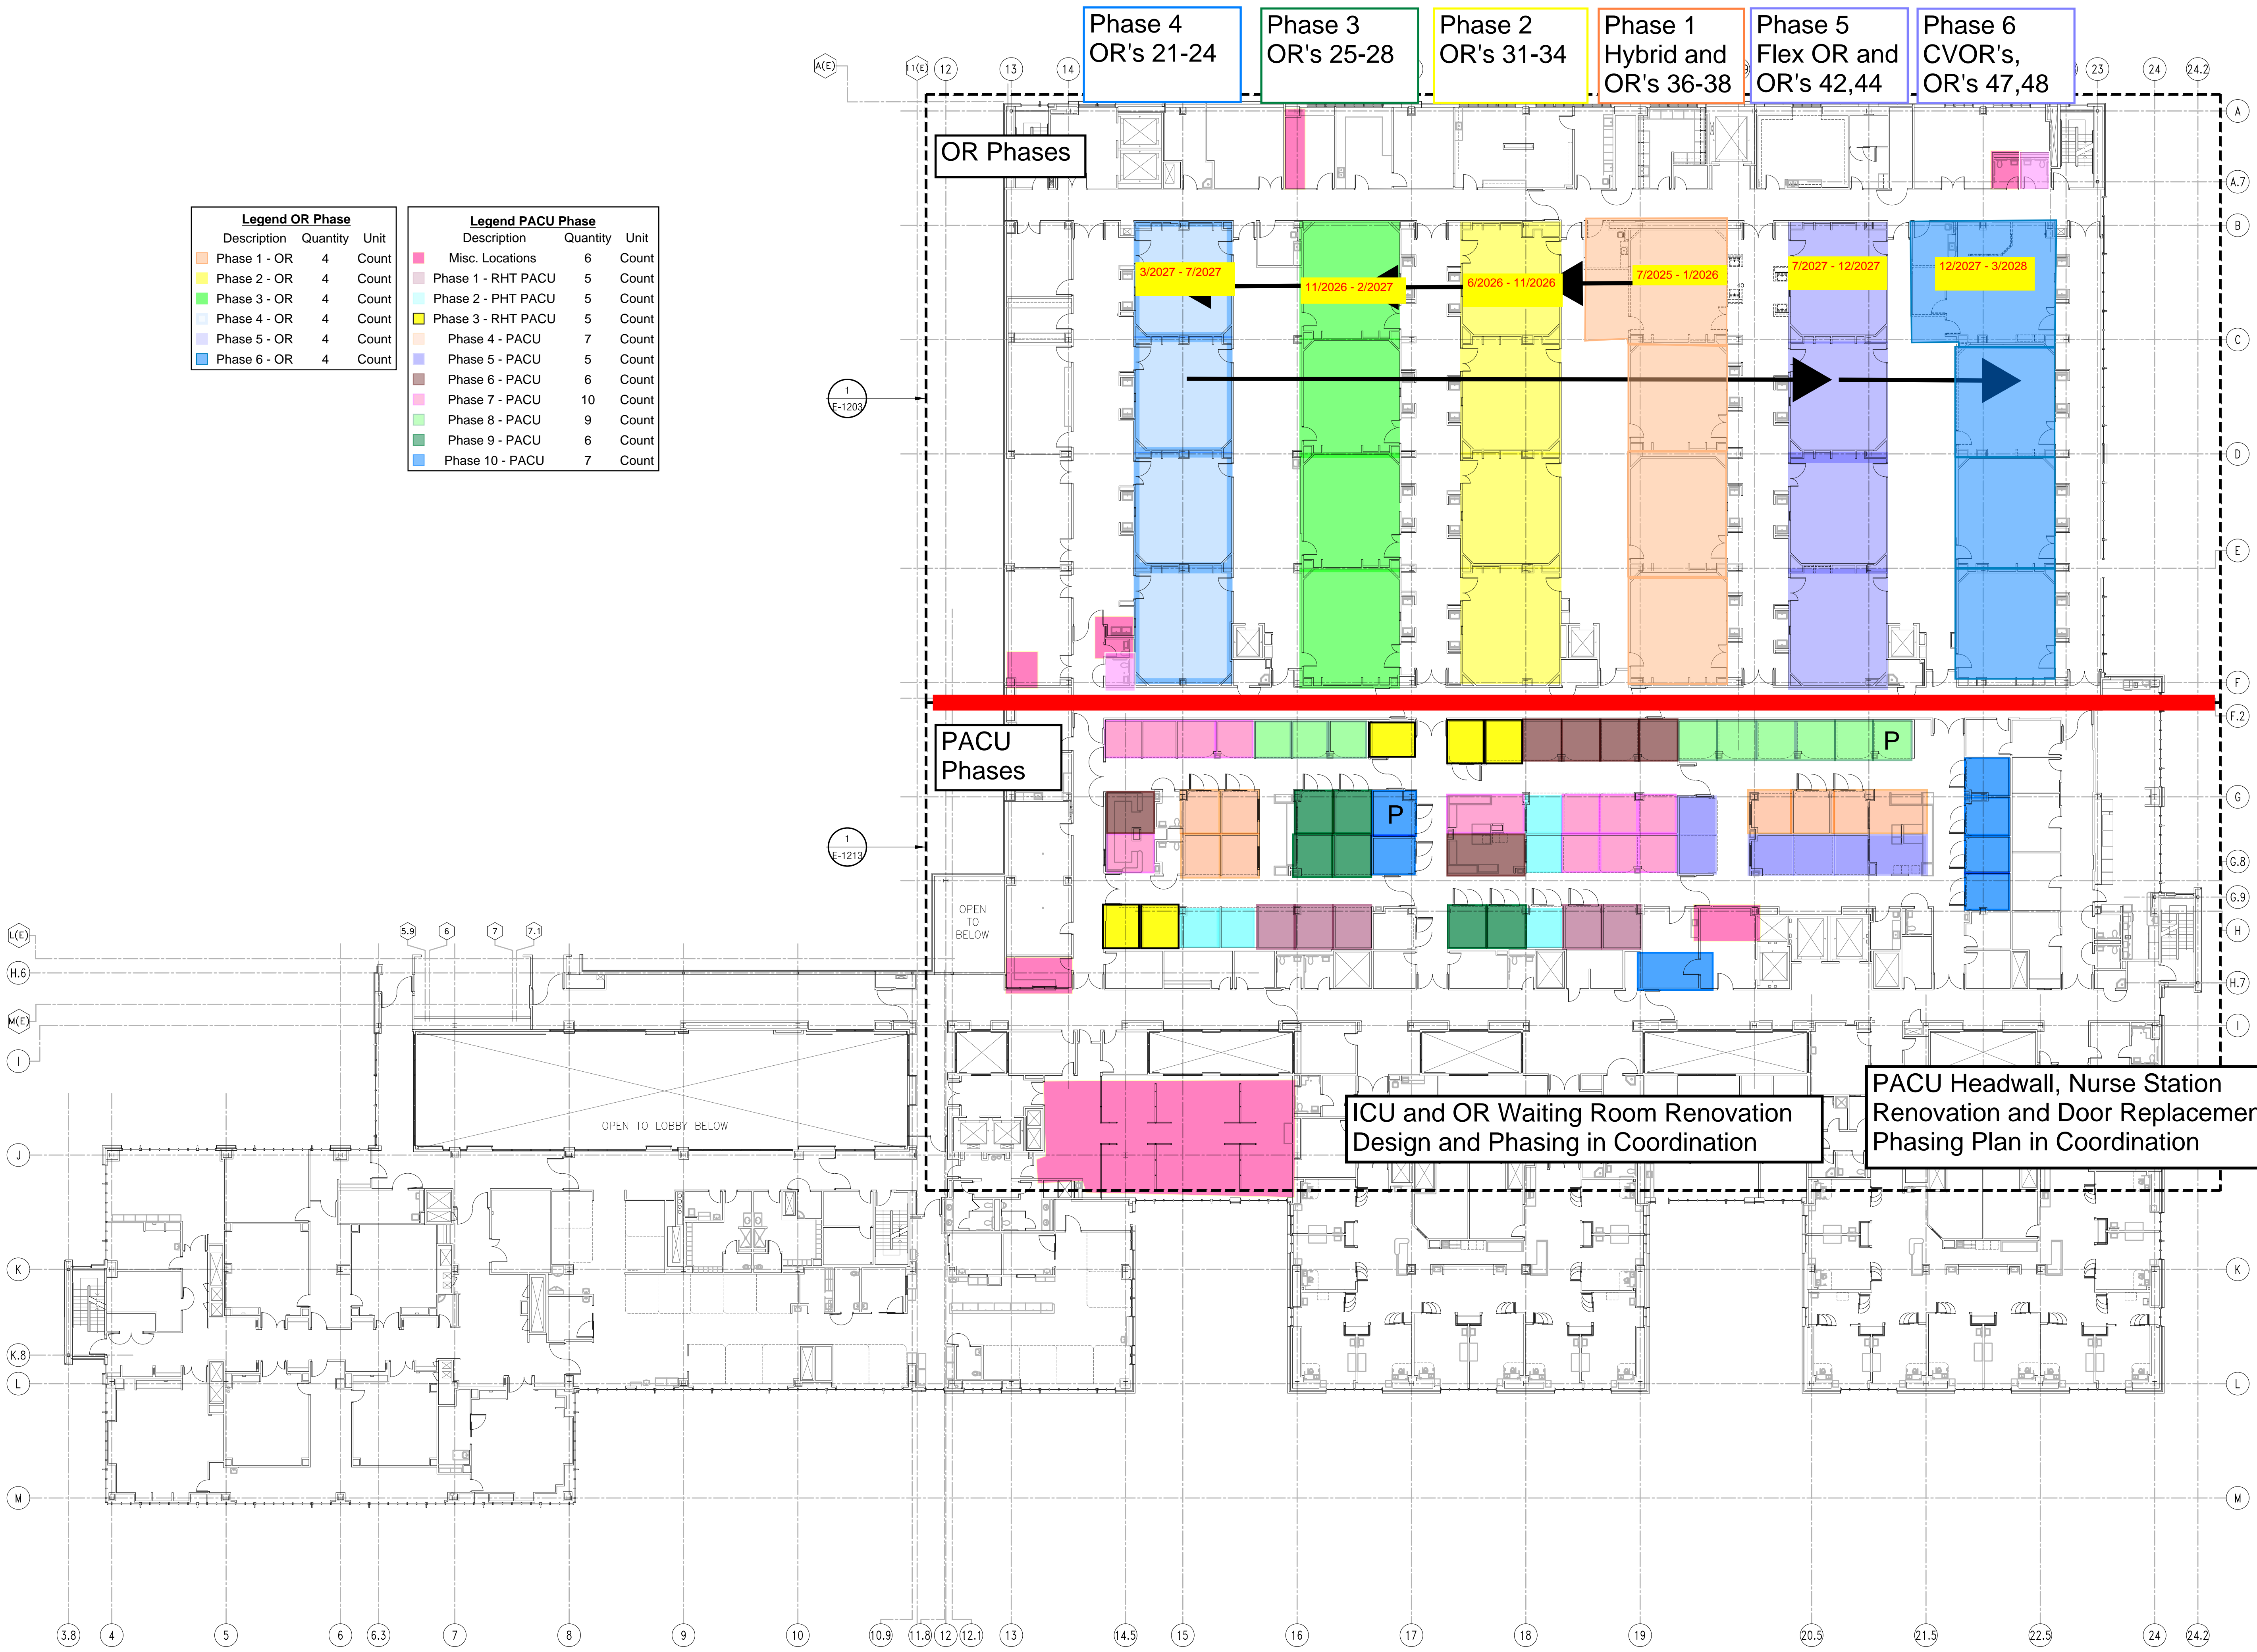

1 LEVEL 3 OVERALL FLOOR PLAN - ELECTRICAL AREAS OF WORK
1" = 20'-0"

© 12/22/2021 12:00:00 AM TAYLOR & ASSOCIATES ARCHITECTS. IF THIS DRAWING IS NOT 30x42 IT HAS BEEN MODIFIED

FILE NAME: Flr Path

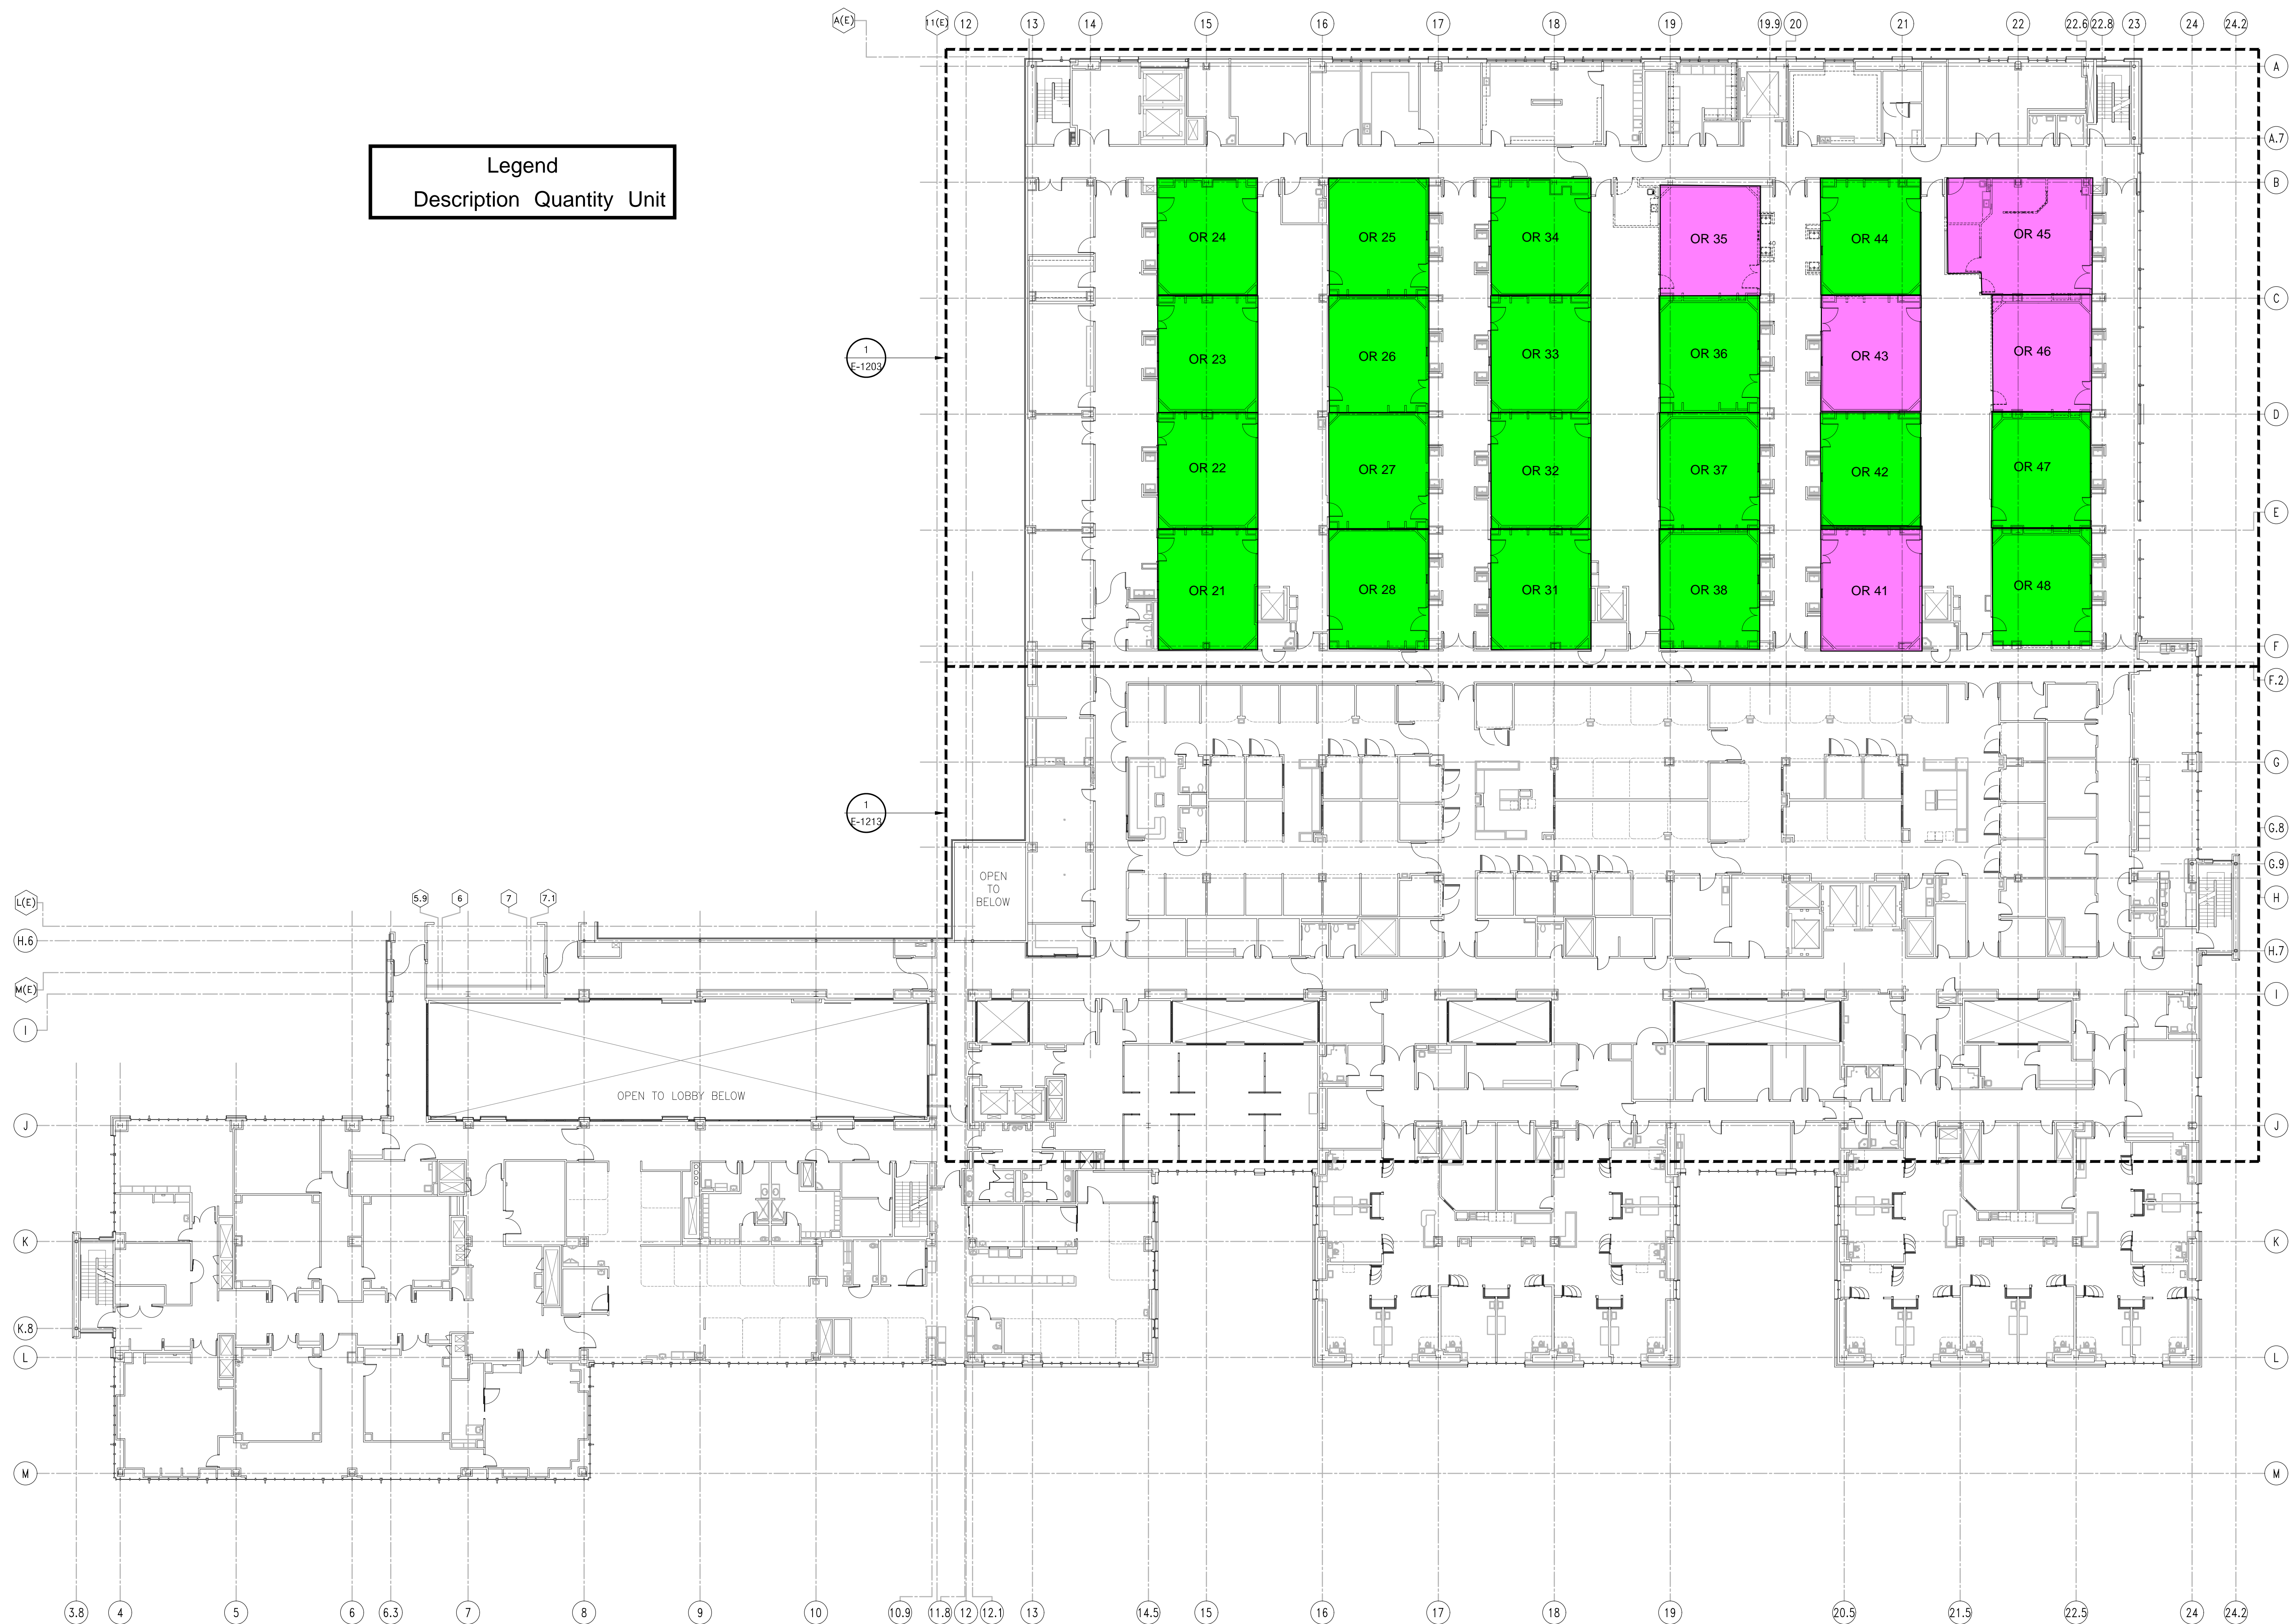

1 LEVEL 3 OVERALL FLOOR PLAN - ELECTRICAL AREAS OF WORK
1" = 20'-0"



**PRELIMINARY:
NOT FOR
CONSTRUCTION**

DEPARTMENT OF HEALTHCARE ACCESS AND INFORMATION

UCDAVIS HEALTH

**UCDAVIS
HEALTH**
FACILITIES DESIGN & CONSTRUCTION
4800 2ND AVENUE SUITE 3010
SACRAMENTO, CALIFORNIA 95817
(916) 734-7824

**TAYLOR
design**

CONSULTANT LOGO:

REV	REVISION DESCRIPTION	DATE

PROJECT STATUS

ARCHITECT PROJECT NO. 6490

OSHPH NO. TBD

BUILDING 02841

FLOOR WING:

PROJECT TITLE
OR MODERNIZATION

**LEVEL 3 OVERALL FLOOR PLAN -
ELECTRICAL AREAS OF WORK**


ARCH/ENGR. ECOM	FD&C JOB NO. <JOB NO.>	SHEET NO.
UCDMC PROJ. MANAGER LH	SCALE AS SHOWN	E-103
DESIGNED BY ECOM	DATE 05/11/2016	
DRAWN BY ECOM	CAD FILE -	SHEET OF

© 4/17/2024 2:52:12 PM TAYLOR & ASSOCIATES ARCHITECTS P THIS DRAWING IS NOT 30%42% IT HAS BEEN MODIFIED

FILE NAME: Autodesk Docs\\6490\\UCDH-Med Ctr OR Mod\\6490-UCDH-Med Ctr OR Mod\\R24.nt

Permit 1 and 2 Make Ready and OR
Modernization Construction Crew Access, Staging
Areas and Facilities Plan
Level 2

KEYNOTE LEGEND	
KEY	KEYNOTE TEXT

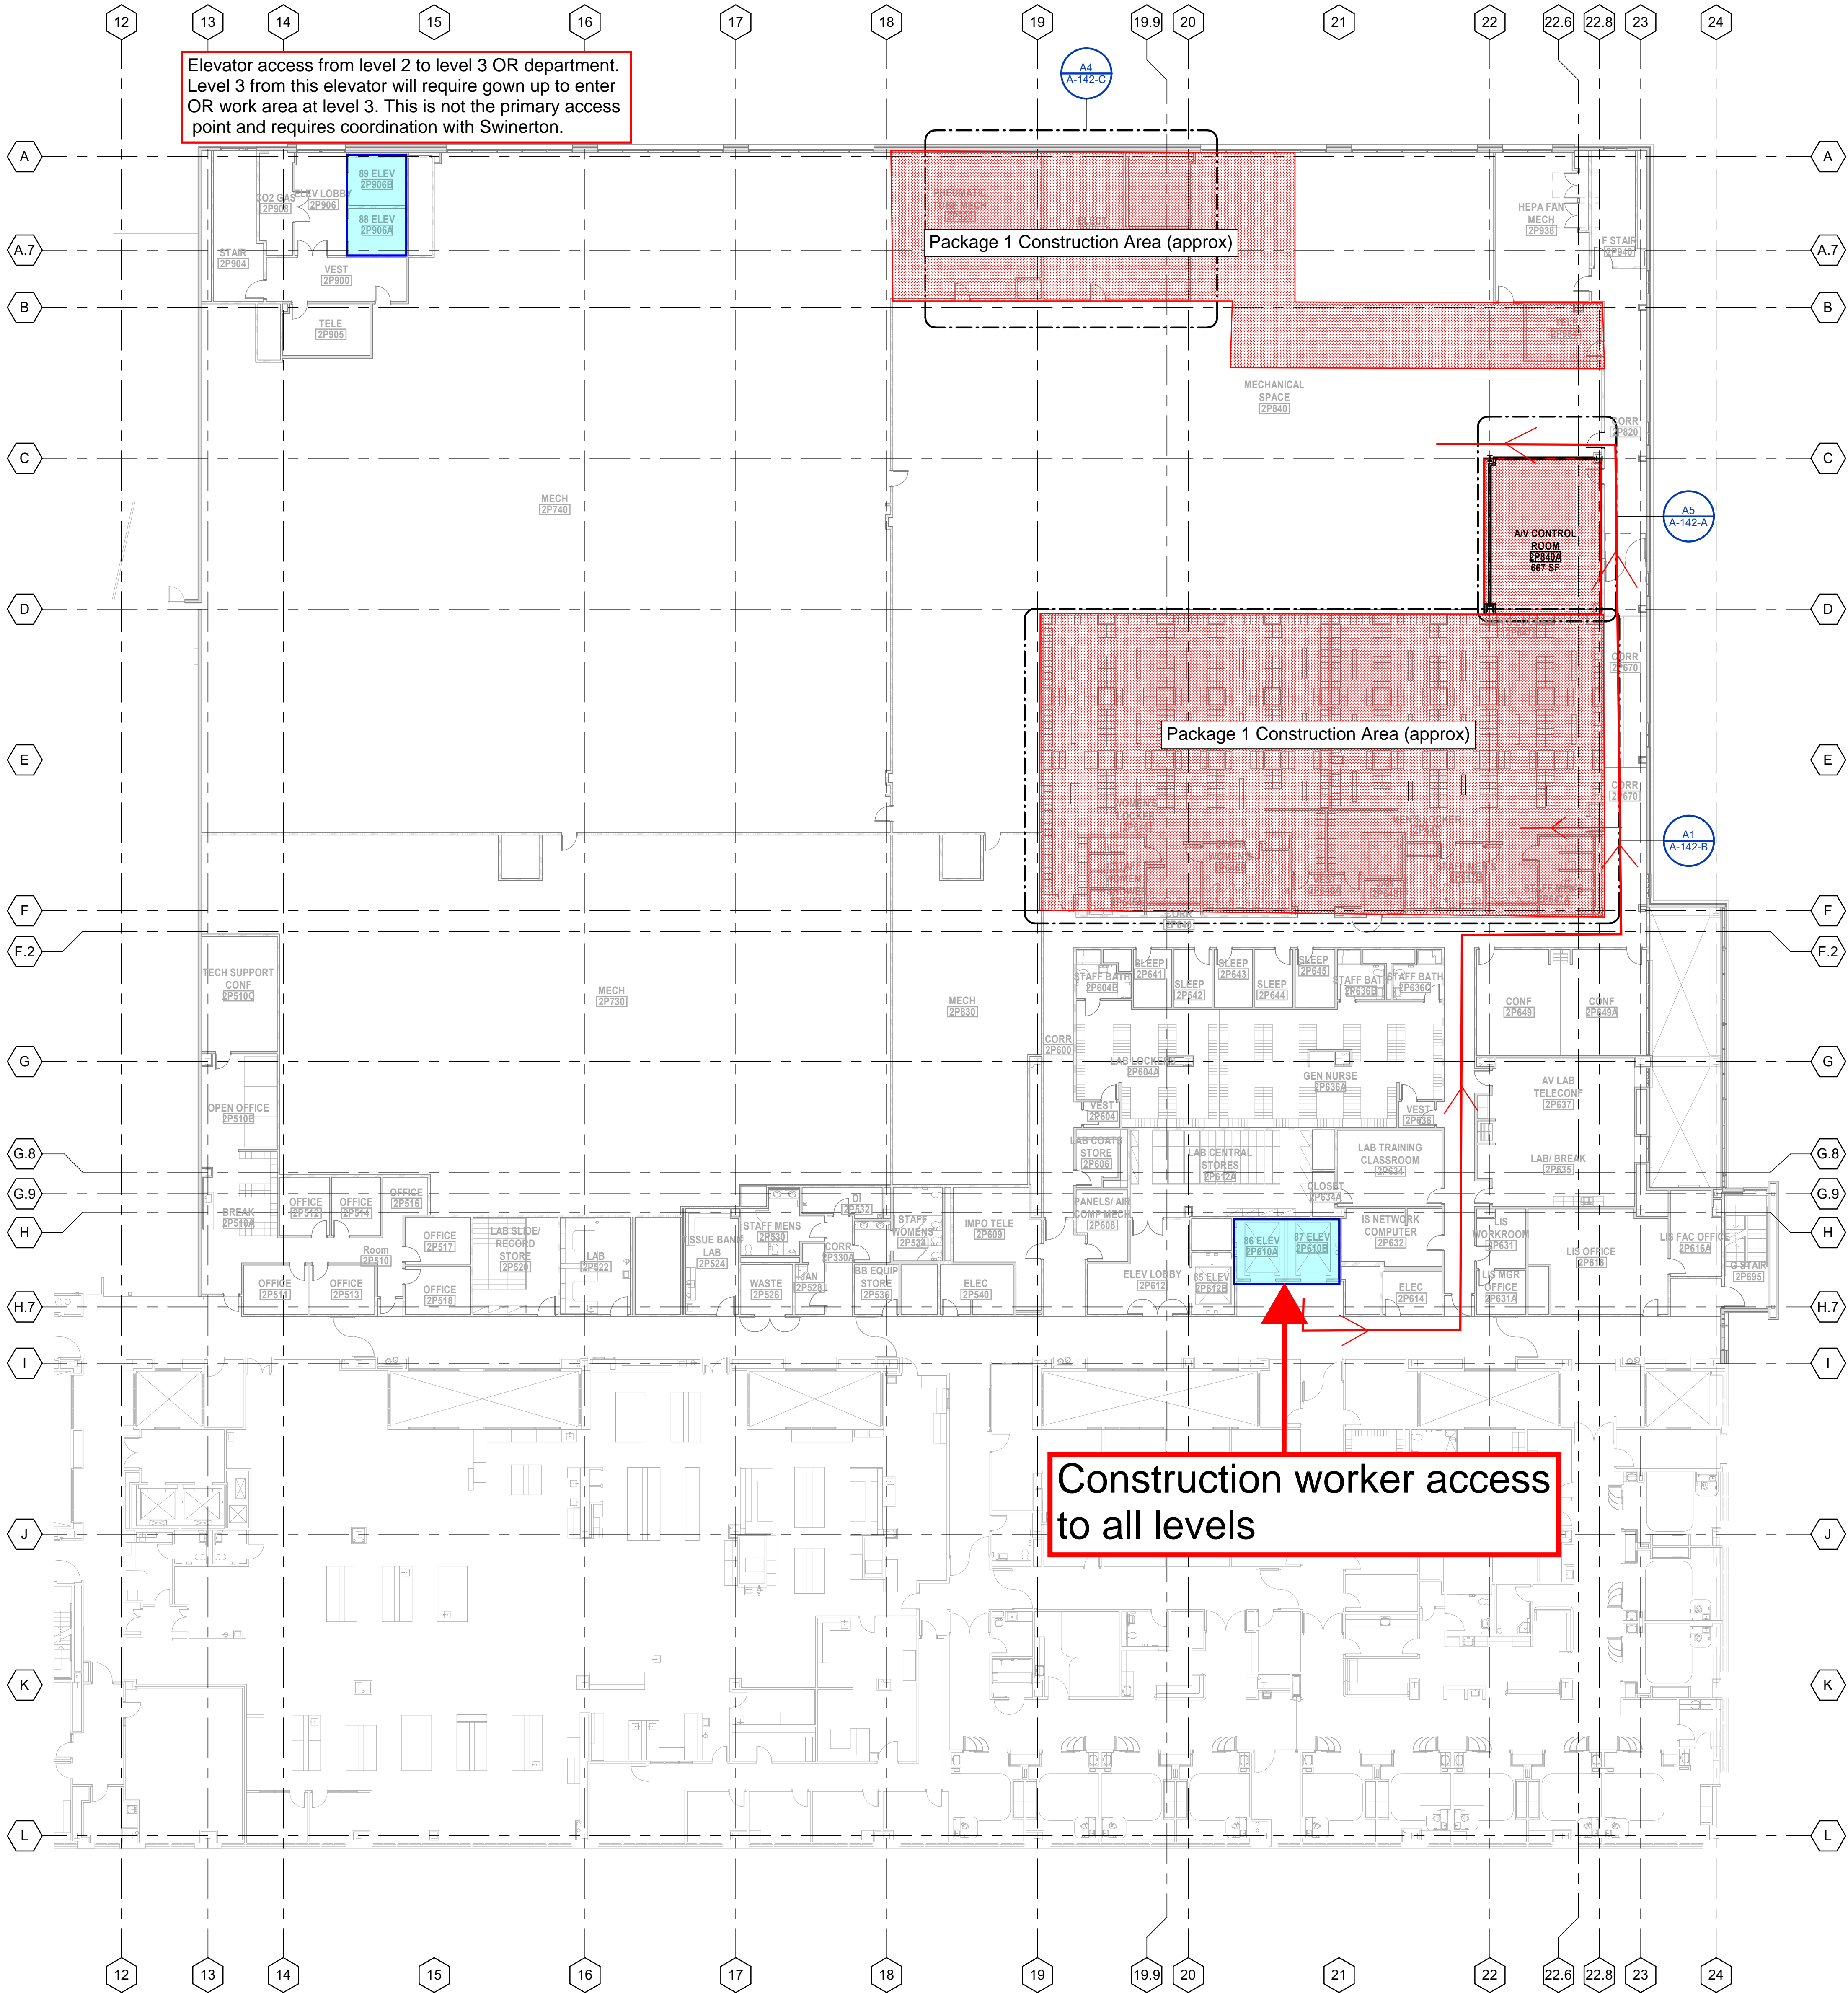

A2 LEVEL 2 OVERALL FLOOR PLAN
1/16" = 1'-0"

DEPARTMENT OF HEALTHCARE ACCESS AND INFORMATION

**PRELIMINARY:
NOT FOR
CONSTRUCTION**

DESIGN PROFESSIONALS OF RECORD:

**UC DAVIS
HEALTH**

FACILITIES DESIGN & CONSTRUCTION
4800 2ND AVENUE SUITE 3010
SACRAMENTO, CALIFORNIA 95817
(916) 734-7024


**TAYLOR
design**

REV	REVISION DESCRIPTION	DATE

SCHEMATIC DESIGN

OPERATING ROOM & PACU MODERNIZATION

LEVEL 2 OVERALL FLOOR PLAN

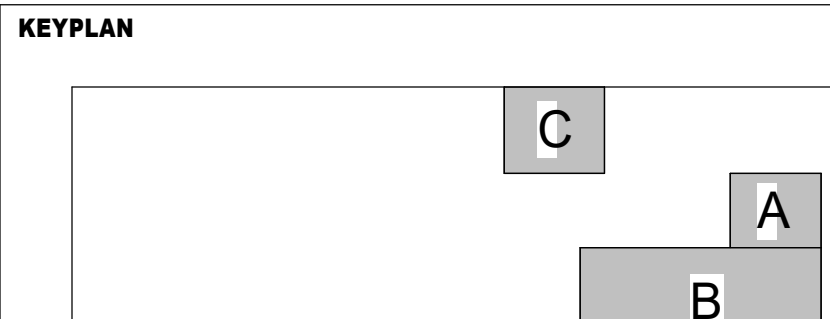


PROJECT NO: 6490		BUILDING NO: 02841		FLOOR NO: FLOOR	
ARCHITECT PROJECT NO: 6490		PROJECT TITLE: OPERATING		SHEET TITLE: LEVEL 2 C	
ARCH: JENGR TAYLOR DESIGN				SHEET NO.	
UCLMDC PROJ. MANAGER L. HINTON				A-122	
SCALE 1/16" = 1'-0"					
DATE 04/12/24					
DESIGNED BY TAYLOR DESIGN				SHEET	
DRAWN BY TAYLOR DESIGN				OF	

6/3/2025 10:31:55 AM TAYLOR & ASSOCIATES ARCHITECTS IF THIS DRAWING IS NOT 30x42" IT HAS BEEN MODIFIED


FILE NAME: Autodesk Docs\\6490\\UCDH-Med Ctr OF Mod\\6490-UCDH-Med Ctr OF Mod-R24.rvt

WINDOW SCHEDULE														
MARK	SIZE		TYPE	FINISH	MATERIAL	GLAZING	TYPE	FIRE RATING	DETAILS					COMMENTS
	WIDTH	HEIGHT							HEAD	JAMB	SILL	MULLIONS		
												HORIZONT AL	VERTICAL	
735	2' - 4"	3' - 3"	A		HM	GL-B			E3/A-1602	E3/A-1602	E3/A-1602			70
735A	10' - 0"	4' - 1"	A		HM	GL-B			E3/A-1602	E3/A-1602	E3/A-1602			70

WINDOW TYPE LEGEND

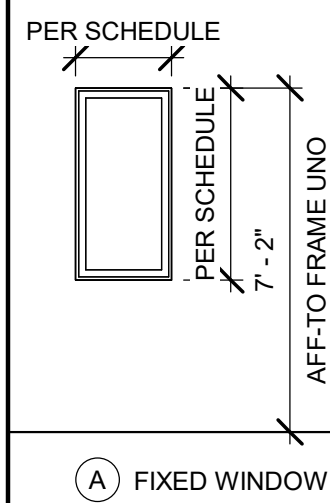

DOOR TYPE LEGEND

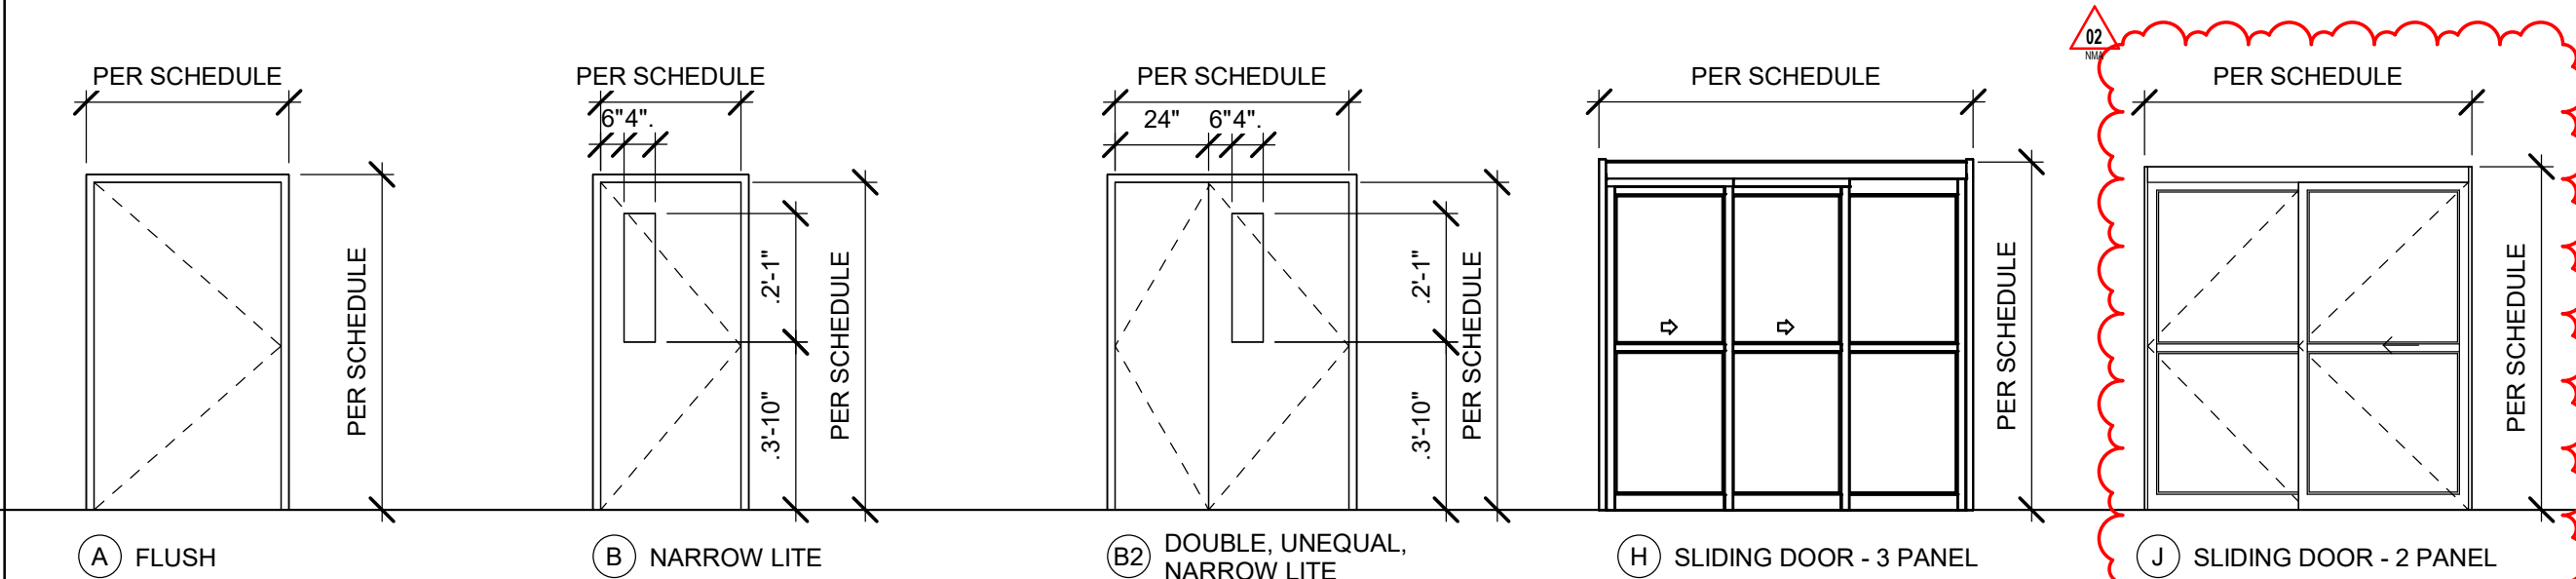

DOOR SCHEDULE NOTES	
NO.	NOTE
ACCESSORIES	
01	DOOR SEAL
02	KICK PLATE
03	ONE ACTIVE LEAF - AUTO FLUSH BOLT
04	AUTOMATIC DOOR BOTTOM
05	MOP PLATE
06	34" ARMOR PLATE (SS)
07	ARMOR PLATE BOTH SIDES OF DOOR
08	DOOR FRAME PROTECTION (ACROVYN)
09	GASKETING
10	ASTRAGAL
11	DOOR SWEEP
DOOR STOPS	
12	OVERHEAD STOP
13	FLOOR STOP
14	WALL BUMPER
HINGES	
21	ELECTRIFIED HINGES
22	HEAVY DUTY
24	CONTINUOUS HINGE
LEVER / LOCKSET / LOCKS	
31	PRIVACY LOCKSET
32	CLASSROOM LOCKSET
33	STORAGE ROOM LOCKSET
34	ELECTRIFIED LOCKSET
35	PASSAGE LATCH
36	OFFICE LOCKSET
37	EXIT / PANIC HARDWARE
38	CYLINDER LOOKS AT BASE OF DOORS
39	ELECTRIFIED STRIKE
40	CARD READER
41	KEYPAD
42	RESCUE HARDWARE
43	HOSPITAL LATCH
OPENER / CLOSER	
51	CLOSER
52	DOOR SILENCER
53	180 DEGREE OUTSWING CLOSER
54	AUTOMATIC DOOR SENSOR AT BOTH SIDE OF THE DOOR
55	DOOR ACTUATOR, BAR
56	DOOR ACTUATOR, HILOW SQAURE
57	DOOR ACTUATOR, HILOW CIRCLE
58	ADD HOLD OPEN, MOUNT IN PARALLEL WITH 5 SCREWS
59	MAGNETIC HOLD OPEN
60	CLOSER, HEAVY DUTY
PROPERTIES	
70	LEAD LINED, MATCH EQUIVALENT LEAD SHIELDING WEIGHT TO ADJACENT
71	LEAD LINED, (SPECIFY POUND)
72	MRI SHIELDED DOOR
73	EXTERIOR DOOR
74	NEW DOOR IN EXISTING FRAME

GLAZING TYPE - PACKAGE 2	
TYPE	DESCRIPTION
GL-A	1/4" CLEAR TEMPERED GLASS
GL-B	2# LEAD WINDOW

DOOR SCHEDULE GENERAL NOTES	
1.	REFER TO A-0002 FOR GENERAL DOOR NOTES.
2.	REFER TO ABBREVIATIONS CODES ON SHEET G-0001.
3.	PAINT DOOR AND FRAME TO MATCH ADJACENT WALL, UNO.
4.	PROVIDE DOOR HARDWARE THAT CAN OPEN 180 DEGREES TO THE DOORS THAT SWING OUT TO THE HALLWAY AND CORRIDORS.
5.	EXISTING FIRE RATED DOORS SHALL BE TIGHTLY FITTING, WITH GAPS NO MORE THAN 1/8" AT JAMBS AND HEAD, AND 3/4" MAXIMUM AT BOTTOM. REFER TO NFPA 80 (2019) 6.3.1.7 CLEARANCES. WHERE REQUIRED, PROVIDE JAMB ADAPTERS SUCH AS "ACTIVE FIRE DOOR PRODUCTS - ACTIVE DOOR GAP FILLER" AS NEEDED. FINISH TO MATCH DOOR FRAME WHEN ATTACHED TO DOOR FRAME. VERIFY FINISH WITH ARCHITECT WHEN ATTACHED TO DOOR.

EXISTING DOOR SCHEDULE - PACKAGE 2 / ALL PHASES																
MARK	SIZE			DOOR				DETAIL			FRAME		FIRE RATING LABEL	HARDWARE SET NO	NOTES	
	W	HT	THK	MATL	FIN	ELV	GLZ	HEAD	JAMB	SILL	MATL	FIN				
Level 3																
(E)3P721X	6'-0"	8'-0"	0'-1 3/4"	(E)	(E)	B2	(E)	(E)	(E)	(E)	(E)	(E)	NIR	(E)	REPLACE CLOSER; INSTALL LCN 4041; PARALLEL ARM W/ (5) SCREWS	
(E)3P722X	6'-0"	8'-0"	0'-1 3/4"	(E)	(E)	B2	(E)	(E)	(E)	(E)	(E)	(E)	NIR	(E)	REPLACE CLOSER; INSTALL LCN 4041; PARALLEL ARM W/ (5) SCREWS	
DOOR SCHEDULE - SEGMENT D / O.R. PHASE 1.2																	
MARK	DOOR							FRAME				FIRE RATING LABEL	HARDWARE SET NO	NOTES			
	SIZE			MATL	FIN	ELV	GLZ	DETAIL			MATL				FIN		
	W	HT	THK					HEAD	JAMB	SILL							
Level 3																	
3P735X	6'-0"	8'-0"	0'-1 3/4"	WD	PL	B2	GL-A	A3/A-1602	C3/A-1602	A3/A-1503	HM	PT	N/R	01	07, 08, 09, 10, 11, 12, 43, 60, 71(1)		
3P735Y	3'-6"	7'-0"	0'-1 3/4"	WD	PL	B	GL-A	E9/A-1602	C9/A-1602	A9/A-1602	HM	PT	N/R	02	07, 08, 09, 11, 12, 22, 43, 60		
3P923X	4'-0"	7'-0"	0'-1 3/4"	WD	PL	A	N/A	E9/A-1602	C9/A-1602	A9/A-1602	(E)	PT	45 MIN	05	06, 08, 09, 14, 34, 40, 51, 74; RECERTIFY FRAME RATING.		
3P925X	3'-6"	7'-0"	0'-1 3/4"	WD	PL	B	GL-A	E9/A-1602	C9/A-1602	A9/A-1602	HM	PT	N/R	02	07, 08, 09, 12, 22, 43, 60		

DOOR SCHEDULE - SEGMENT F / O.R. PHASE 6															
MARK	SIZE			DOOR				DETAIL			FRAME		FIRE RATING LABEL	HARDWARE SET NO	NOTES
	W	HT	THK	MATL	FIN	ELV	GLZ	HEAD	JAMB	SILL	MATL	FIN			
Level 3															
3P745AX	4'-0"	7'-0"	0'-1 3/4"	WD	PL	B	GL-A	E9/A-1602	C9/A-1602	A9/A-1602	HM	PT	N/R	03	07, 08, 09, 12, 22, 43, 60
3P745AY	8'-0"	7'-0"	0'-6"	AL	AN	H	GL-A	G7/A-1602	E7/A-1602	-	AL	AN	N/R	-	40; HARDWARE PER MFR
3P745AZ	8'-0"	7'-0"	0'-6"	AL	AN	H	GL-A	G7/A-1602	E7/A-1602	-	AL	AN	N/R	-	40; HARDWARE PER MFR
3P745Y	3'-6"	7'-0"	0'-1 3/4"	WD	PL	B	GL-A	E9/A-1602	C9/A-1602	A9/A-1602	HM	PT	N/R	02	07, 08, 09, 11, 12, 22, 43, 60
3P746Y	3'-6"	7'-0"	0'-1 3/4"	WD	PL	B	GL-A	A3/A-1602	C3/A-1602	A9/A-1602	HM	PT	N/R	02	07, 08, 09, 11, 12, 22, 43, 60

DOOR SCHEDULE - SEGMENT G / PACU PHASE 1.1																
	MARK	SIZE			DOOR				DETAIL			FRAME		FIRE RATING LABEL	HARDWARE SET NO	NOTES
		W	HT	THK	MATL	FIN	ELV	GLZ	HEAD	JAMB	SILL	MATL	FIN			
Level 3																
	3P537X	6'- 10"	7'- 0"	0'- 1 3/4"	AL	AN	J	GL-A	B7/A-1602	A7/A-1602	-	AL	AN	N/R	-	HARDWARE PER MFR; VERIFY (E) RO PRIOR TO FABRICATION
	3P538X	6'- 10"	7'- 0"	0'- 1 3/4"	AL	AN	J	GL-A	B7/A-1602	A7/A-1602	-	AL	AN	N/R	-	HARDWARE PER MFR; VERIFY (E) RO PRIOR TO FABRICATION
	3P541X	6'- 10"	7'- 0"	0'- 1 3/4"	AL	AN	J	GL-A	B7/A-1602	A7/A-1602	-	AL	AN	N/R	-	HARDWARE PER MFR; VERIFY (E) RO PRIOR TO FABRICATION
	3P543X	6'- 10"	7'- 0"	0'- 1 3/4"	AL	AN	J	GL-A	B7/A-1602	A7/A-1602	-	AL	AN	N/R	-	HARDWARE PER MFR; VERIFY (E) RO PRIOR TO FABRICATION
	3P554X	6'- 10"	7'- 0"	0'- 1 3/4"	AL	AN	J	GL-A	B7/A-1602	A7/A-1602	-	AL	AN	N/R	-	HARDWARE PER MFR; VERIFY (E) RO PRIOR TO FABRICATION
	3P556X	6'- 10"	7'- 0"	0'- 1 3/4"	AL	AN	J	GL-A	B7/A-1602	A7/A-1602	-	AL	AN	N/R	-	HARDWARE PER MFR; VERIFY (E) RO PRIOR TO FABRICATION
	3P557X	6'- 10"	7'- 0"	0'- 1 3/4"	AL	AN	J	GL-A	B7/A-1602	A7/A-1602	-	AL	AN	N/R	-	HARDWARE PER MFR; VERIFY (E) RO PRIOR TO FABRICATION

DOOR SCHEDULE - SEGMENT H / PACU PHASE 2.1															
MARK	SIZE			DOOR				DETAIL		SILL	FRAME		FIRE RATING LABEL	HARDWARE SET NO	NOTES
	W	HT	THK	MATL	FIN	ELV	GLZ	HEAD	JAMB		MATL	FIN			
Level 3															
3P561X	6'-10"	7'-0"	0'-1 3/4"	AL	AN	J	GL-A	B7/A-1602	A7/A-1602	-	AL	AN	N/R	-	HARDWARE PER MFR; VERIFY (E) RO PRIOR TO FABRICATION
3P563X	6'-10"	7'-0"	0'-1 3/4"	AL	AN	J	GL-A	B7/A-1602	A7/A-1602	-	AL	AN	N/R	-	HARDWARE PER MFR; VERIFY (E) RO PRIOR TO FABRICATION
3P565X	6'-10"	7'-0"	0'-1 3/4"	AL	AN	J	GL-A	B7/A-1602	A7/A-1602	-	AL	AN	N/R	-	HARDWARE PER MFR; VERIFY (E) RO PRIOR TO FABRICATION
3P567X	6'-10"	7'-0"	0'-1 3/4"	AL	AN	J	GL-A	B7/A-1602	A7/A-1602	-	AL	AN	N/R	-	HARDWARE PER MFR; VERIFY (E) RO PRIOR TO FABRICATION
3P569X	6'-10"	7'-0"	0'-1 3/4"	AL	AN	J	GL-A	B7/A-1602	A7/A-1602	-	AL	AN	N/R	-	HARDWARE PER MFR; VERIFY (E) RO PRIOR TO FABRICATION
3P601X	3'-0"	7'-0"	0'-1 3/4"	HM	PTD	A	-	G6/A-1602	G6/A-1602	JA/A-1602	PTD	HM	45 MIN	04	07, 08, 09, 14, 22, 34, 40, 51



door highlights represent where closers need to be replaced.

CUSTOM WALL PROTECTION LOCATION. PANELS TO BE FULL HEIGHT AND EXTEND LENGTH OF WALL FROM I TO #39500 ON THIS SIDE C FINISH LEGEND FOR SPEC

October 24, 2024

To whom it may concern:

This document is a Shielding Design Report for an interventional cardiac catheterization lab.

This report has one update:

1. The proposed barrier for Wall G has been updated from 3 inches to 1.25 inches.
2. The adjacent space has been updated from "exam room" to "storage".
3. Therefore, **the barrier recommendation for Wall G is updated to proposed 1.25 inches drywall sufficient.**

Facility Information

Facility Name: University of California Davis Health

Facility Address:

Installation Division: Radiology

Equipment Information

Location: OR 35

Machine Type: XA

Make: Philips

Model: Azurion 7 C20 FlexArm

Maximum Technique Factors: 130 kV/800 mA

Number of Tubes: 1

Energy Waveform: High frequency

CA Machine No: N/A

Description of Imaging Technology

This is a single plane peripheral interventional imaging system (Figure 1), with a variety of interventional-specific imaging capabilities, including three-dimensional "spins" to acquire data for cross-sectional imaging and evaluation. The design of the system precludes any primary radiation incidence on the radiation barriers in the room as the detectors are always in position to intercept the primary beam.



Workload

It is estimated that 20 exams will be performed per week per NCRP 147 recommendations. Calculations were for a 25 exam per week workload. Most patients are greater than 18 years old.

Architectural Information

Drawings can be found in Appendix A and B of this document. All adjacent spaces, besides the control room, are uncontrolled. These adjacent rooms include a storage room and corridors.

Composition of Floor & Ceiling

The composition of the floors and ceilings are a minimum of 3.25 inches normal weight concrete on an 18 gage (0.04 inch) steel deck. Drawings can be found in Appendix C. Full occupancy is assumed both above and below the room.

Shielding Summary

The tables below summarize the shielding requirements and proposed construction materials for the radiography room (see Appendix D for more details).

Shielding Requirements: Pavillion OR35				
Barrier	Adjacent Space	Barrier Material	Min Barrier Thickness Required (mm)	Proposed Construction (Minimum Nominal Weight lb/ft ²)
Door A	Corridor	Wood	153.2	A wood or steel door is sufficient.
Wall B	Control booth	Lead	0.5	Minimum 2 lb/sqft ² Lead
Wall C	Corridor	Lead	0.5	Minimum 2 lb/sqft ² Lead
Wall D	Corridor	Lead	0.5	Minimum 2 lb/sqft ² Lead
Door E	Corridor door	Lead	0.3	Minimum 1 lb/sqft ² Lead
Wall F	Patient exam room	Lead	0.7	Minimum 2 lb/sqft ² Lead
Wall G	Storage room	Gypsum	19.1	Proposed 1.25 inches gypsum sufficient
Ceiling	Attic	Concrete	7.1	Existing 3.25 inch concrete acceptable
Floor	Full Occupancy	Concrete	30.1	Existing 3.25 inch concrete acceptable

Additional Requirements

1. All shielding will extend from the floor to a height of 7 feet.
2. All windows, frames, doors, and door frames on a wall must meet the minimal shielding requirements specified for that wall.
3. Any penetrations in the shielding, such as outlets, must meet the minimal shielding requirements. This can be achieved by wrapping the backs with lead.
4. The technologist must always have a clear line of sight to the patient or functional video monitoring.
5. The technologist must be able to communicate to the patient (both provide instructions and always hear responses) in person or via an intercom.
6. For remodels with existing shielding: Any walls that require patching must be patched with shielding equivalent to existing shielding.
7. Shielding greater than or equal to 8 lb/ft² uses plywood. This shielding requires 16-inch studs for construction.
8. All rooms containing x-ray equipment require a "Caution X-Ray" sign or placard outside of the room

Shielding must be recalculated if:

1. The workload estimate increases by more 25%
2. The adjacent spaces are reassigned
3. The equipment is designated to a different room
4. The equipment placement within the room changes by more than 2 ft.

Summary

In accordance with NRC Reports 49 & 147, the proposed facility design meets or exceeds shielding requirements. Please feel free to contact me


(semckenney@ucdavis.edu, 916-734-7223) if you have any questions regarding this report.

Sincerely,

A handwritten signature in black ink that reads "Sarah McKenney". The signature is fluid and cursive, with the first name "Sarah" and last name "McKenney" clearly legible.


Sarah McKenney, Ph.D.
Medical Physicist

Shielded room is highlighted in pink. The clean core (adjacent to wall G) is highlighted in yellow.

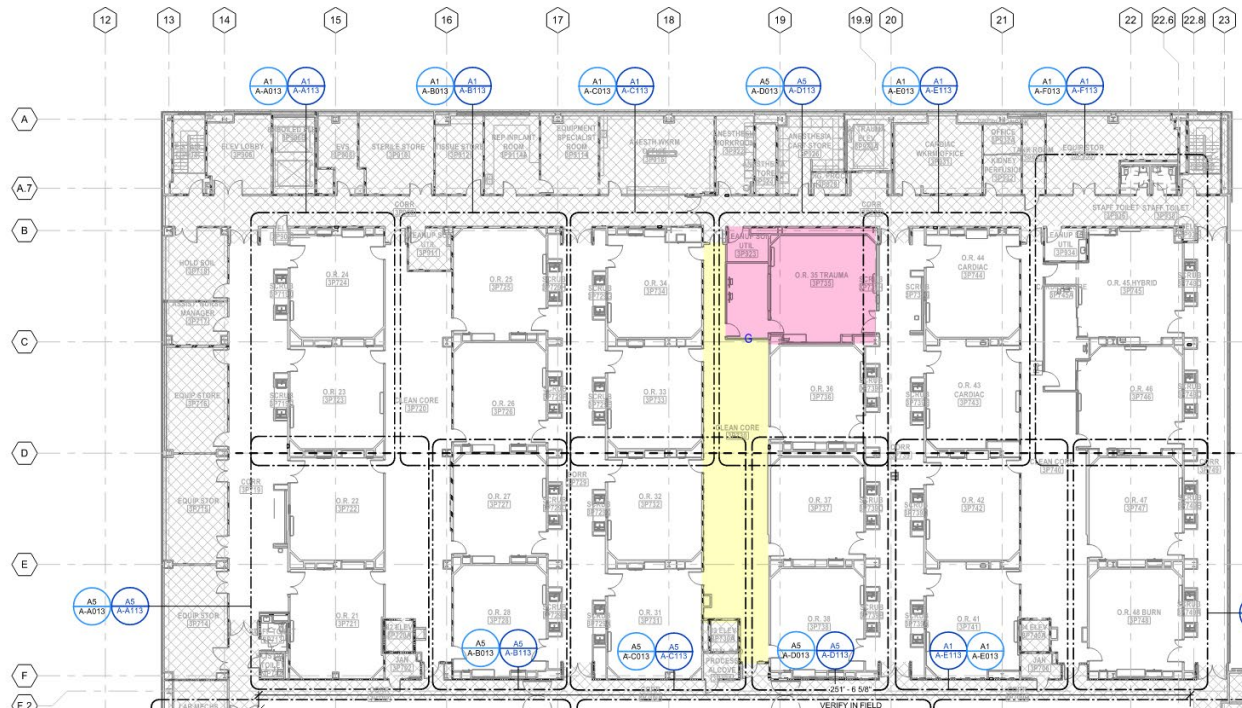


The floor plan illustrates the layout of the ADT Adaptation Floor Plate 1. The central area is the Exam Room, which contains a large table (14'6" x 4420mm) and various equipment including a Safety Zone, Ceiling Inlet, and Iso Center. The Corridor is located on the right side of the room. The floor plan includes numerous labels for equipment and safety zones, such as C1, B2, C2, C3, C4, C815, C

Appendix C: Elevation Drawing

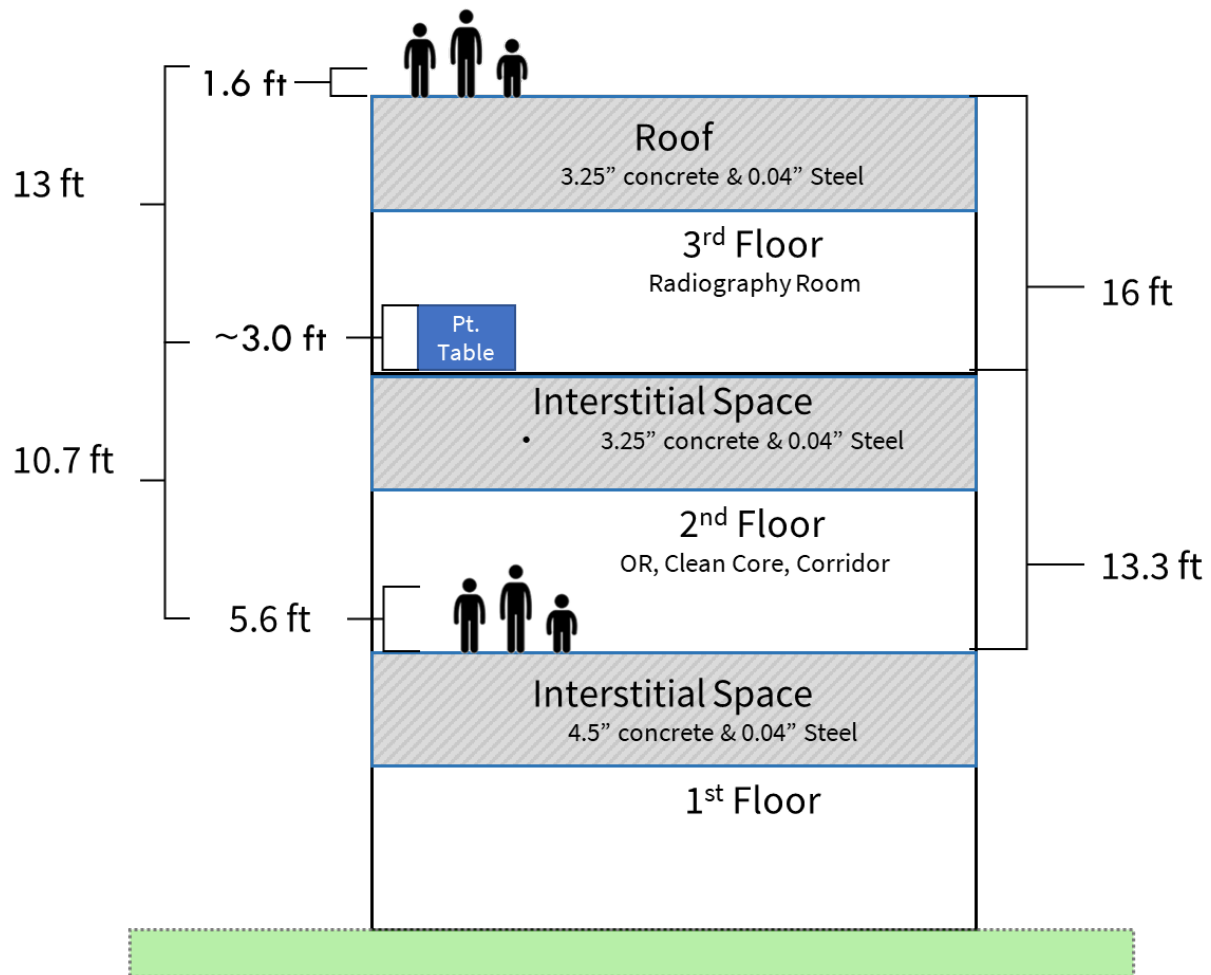

Appendix D: Calculation Details

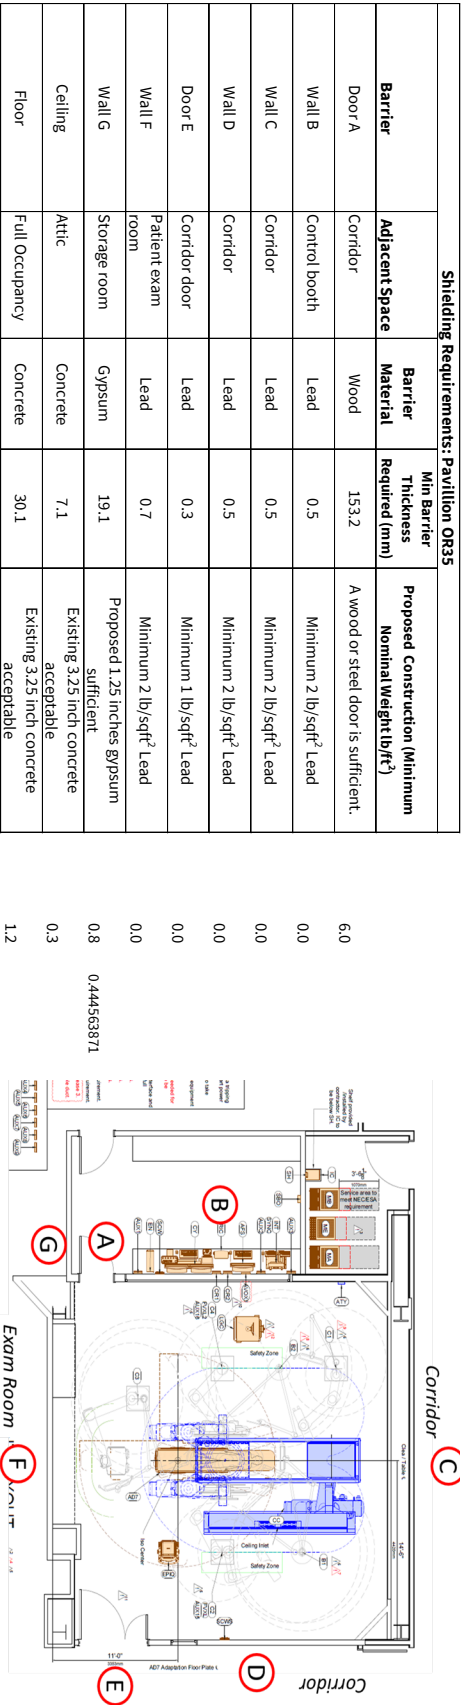

Barrier	Adjacent Space	Type	Occupancy (T)	Use Factor (U) (primary)	Distance (ft)	K _{ea} (mGy/wk)	K _{goal} [p] (mGy/wk)	Barrier material	Type	alpha	beta	gamma	Thickness (mm)
Door A	Corridor	Controlled	0.20	0.00	18.6	0.32	0.10	Wood	S+L	0.01	0.00	1.24	153.15
Wall B	Control booth	Controlled	1.00	0.00	14.3	2.62	0.10	Lead	S+L	2.35	14.94	0.74	0.50
Wall C	Corridor	Uncontrolled	0.20	0.00	14.1	0.54	0.02	Lead	S+L	2.35	14.94	0.74	0.51
Wall D	Corridor	Uncontrolled	0.20	0.00	14.1	0.54	0.02	Lead	S+L	2.35	14.94	0.74	0.51
Door E	Corridor door	Uncontrolled	0.13	0.00	16.1	0.26	0.02	Lead	S+L	2.35	14.94	0.74	0.33
Wall F	Patient exam room	Uncontrolled	0.50	0.00	15.3	1.17	0.02	Lead	S+L	2.35	14.94	0.74	0.74
Wall G	Storage room	Uncontrolled	0.05	0.00	21.9	0.06	0.02	Gypsum	S+L	0.01	0.06	0.73	19.10
Ceiling	Attic	Uncontrolled	0.03	0.00	13.0	0.08	0.02	Concrete	S+L	0.04	0.16	0.04	7.08
Floor	Full Occupancy	Uncontrolled	1.00	0.00	10.7	4.51	0.02	Concrete	S+L	0.04	0.16	0.04	30.08

An uncontrolled area has a limit of 0.02 mGy/wk, a controlled area has a limit of 0.1 mGy/wk (NRCP Reg 147)

Calculations are 0.3 m (1 ft) within an adjacent room unless a built-in object is indicated on the plans.


DX Use Factors of primary beam are from NRCP 147, Table 4.4; U=1 for secondary & leakage dose

Conex, break area and exterior laydown. Material delivery to occur here, no parking available here. DUMPSTER LOCATION ALSO.

UCD OR MODERNIZATION
SITE LOGISTICS PLAN
3/20/2025

Parking garage 5 construction parking on levels 2 to roof

SESP Building 10
Project Site

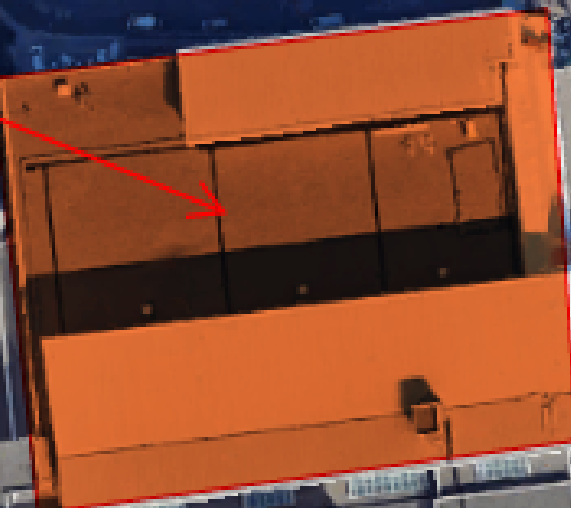

Day shift entry point, card access

Night shift entry point, card access

Night shift parking

