

GENERAL

This addendum forms a part of the Contract Documents and modifies the original Bidding Documents dated April 2024, and consists of pages AD1-1 through AD1-3 Specifications Sections listed below, and Drawings Sheet listed below. The following changes, additions and/or deletions shall be made to the following documents: all other conditions shall remain the same.

**ITEM NO. I – CONTRACT DOCUMENTS
ANNOUNCEMENT TO PREQUALIFIED BIDDERS
SUPPLEMENTARY INSTRUCTIONS TO BIDDERS
QUALIFICATION QUESTIONNAIRE**

1. Contractor Qualification Questionnaire, p. 3 – correct typo in Criteria Item 4. Change from “Project was completed within the last ten (5) years and accepted as complete prior to April 30, 2024.” To “Project was completed within the last *five* (5) years and accepted as complete prior to April 30, 2024.” See attached revised QQ.
2. CHANGE Bid deadline to June 25, 2024, at 2:00 p.m.

ITEM NO. II – SPECIFICATIONS

1. SECTION 01 11 00, 1.02 E DESCRIPTION OF WORK: Construction sequence of x-ray rooms shall be in order, as follows: ED 3, 1P758; ED 1, 1P752; ED 2, 1P754.
2. SECTION 015610 – Airborne Contaminants Control
Infection Control Risk Assessment Worksheet – Contractors should assume that Class V precautions will be required for all work.

ITEM NO. III – DRAWINGS

1. ADD ACD-001 DRAFT –
 - a. Narrative
 - b. Plans A201, A202, A662, A672, A673, E301
 - c. Section 09 22 16 Non-Structural Metal Framing, Section 09 29 00 Gypsum Board, Section 13 49 00 Radiation Protection.

ITEM NO. IV – CLARIFICATIONS

Q1: Can OPM-0043-13 be incorporated into the drawing set to reduce requirements for drilled anchors and the associated disruption?

A1: We assume this RFI is proposing to use Mason West Badger clips in lieu of the expansion anchor per the approved contract documents. For MEP utility conduit support, this is acceptable; contractor to submit shop drawing during construction for DPOR review. For ceiling hanger/brace wires, this is acceptable; DPOR will submit ACD/NMA for HCAI approval. For partition walls, use expansion anchors per approved contract drawings. For overhead scanner support retrofit detail on S9.01, use expansion anchors per approved contract drawings.

Q2: During the pre-bid conference it was mentioned that Fire Alarm drawings would be by the electrical contractor, but this is not noted as a deferred submittal on G000; please confirm if FA is deferred and who is responsible.

A2: There are no fire alarm or fire protection modifications required. If any modifications are required to support construction activities, Contractor to coordinate with Fire Marshall and HCAI as necessary.

Q3: A2.01 shows an opening in the corridor wall getting infilled in 1P754. There is no wall tag identification and a privacy curtain is shown at what looks to be an infilled door location. Please confirm if there is a wall to infill on the plan east side of room 1P754.

A3: This is shown incorrectly; only a temporary barrier system is to be installed.

Q4: No shut off or isolation valves are shown between the zone valve box and the medical gas ports in the rooms. If there are no existing valves, this will result in multiple med gas shut downs impacting all three rooms. Please advise if this is the intent, or if owner intends to install isolation valves for each space.

A4: Contractor is to provide medical gas shut off valves for each medical gas service above the ceiling within each room. Valve locations shall be coordinated with the University and in accessible locations. Perform testing of medical gas systems upon installation of valves and installation of all piping systems. A total of (9) valves shall be installed, (3) per room. Work shall be sequenced such that ALL valves are installed as part of MEP safe-off activities prior to the start of active demolition in the first phase. Valve installations shall occur during a single overnight shift, not longer than 12-hours in duration, with work occurring in one room at a time, such that a minimum of two rooms are still available for diagnostic imaging by the University. If work cannot be completed in a single 12-hour shift, then work to be completed in successive daily overnight shifts, until complete. The University shall carry the contract with CYA to provide temporary medical gas service during the shut down; Contractor shall provide all necessary supervision and coordination with related parties (IOR, CYA, UCD PO&M, etc) to properly plan and manage the shutdown.

Q5: Please advise if a PIN70 coordination study is required for this project and if so who is responsible for completion of the study.

A5: PIN 70 has been completed as part of the permit drawings.

Q6: There are several references to verify existing, retrofit where required. Has the SEOR confirmed the existing conditions or should we expect to retrofit?

A6: Not all existing conditions have been verified; Contractor should assume retrofitting all locations per the approved contract documents. Contractor to provide credit during construction for locations that meet criteria to not require the retrofit details.

Q7: Please confirm if the use of the University electrical system for temp power is available per Section 01 51 00.

A7: Use of University electrical system for temporary power is available. DPOR will provide an ACD to identify the allowable non-emergency circuit to utilize inside each room for temporary power.

Q8: The majority of the information in Section 079200 Joint Sealants relates to exterior conditions which do not apply to this project. Please clarify.

Q8: Please disregard any portions that are not applicable to this project.

Q9: Section 099000 Painting makes extensive reference to exterior work and to mockups. We do not believe either of these are applicable to this project. Please clarify.

A9: Mockups are not required per this Section 099000. Please disregard any portions not applicable to this project.

Q10: Keynote D4 on A201 reads 'REMOVE (E) GENERAL RADIOLOGY EQUIPMENT'. We believe all such equipment will be removed by the Owner's Equipment vendor. Please clarify.

A10: Correct; Please see Note H under General Notes – Demolition Plan. Contractor to coordinate and provide site supervision during the removal of the equipment by others.

Q11: Keynote D9 on A201 reads "REMOVE (E) EQUIPMENT AND STORE TO BE REPLACED IN SAME LOCATION AT END OF CONSTRUCTION". Will this be the Contractor responsibility or will it be done by owner?

A11: Equipment will be removed by the Contractor; Contractor to coordinate with the University before discarding. New equipment to be installed by Contractor per the contract documents and to be coordinated with the department. Please see Note H under General Notes – Demolition Plan.

Q12: Keynote F13 on A201 read "(N) WALL MOUNTED APRON STORAGE RACK...REPAIR WALL...AFTER RELOCATION". Is this rack new or relocated? Please clarify.

A12: Apron storage will be new. Contractor to provide wall patching as required after removal of existing.

Q13: Item F31 Room Singage on the Equipment Schedule on A202 is listed as Contractor Provided / Department Installed. Please confirm if this is correct.

A13: Signage is to be Contractor provided and installed.

Q14: Item F39 Phone on the Equipment Schedule on A202 is listed as Contractor Provided / Department Installed. Please confirm is this is correct.

A14: Phone is to be University provided and installed.

Q15: The Specifications do not provide any specifications for light gauge metal framing, drywall or lead-lined drywall. Please clarify.

A15: Sections have been provided in DRAFT ACD 01, included with this Addendum issuance.

Q16: There are a significant number of items on the Equipment Schedule A202 where the PROVIDED/INSTALLED column is left blank. Please clarify.

A16: Please see updated A202, included with DRAFT ACD 01, included with this Addendum issuance.

Q17: Instructions noted at the bottom of page 2 of 9 of the Contractor Qualification Questionnaire request information to be included in the questionnaire form only and attachments are not allowed, but questions III.B.(6), III.C.(6) and III.D request attachments. Please confirmed attachments are allowed/required.

A17: Attachments are allowed as necessary to comply with the requirements of the Qualification Questionnaire.

Q18: During a previous job walk it was noticed that there were several mobile HEPA carts on the 2nd floor; will the selected contractor have permission to use carts to perform work outside of the containment area or do project budgets need to include their own units?

A18: Access to University owned mobile HEPA carts cannot be guaranteed. Contractors should plan on providing their own containment for all work.

Q19: Please provide the onsite date for the X-ray equipment for coordination with the project schedule.

A19: The exact onsite date for the X-ray equipment is not yet defined; per Section 01 31 00 Coordination, Contractor shall provide a minimum of 60-day notice prior to requiring the owner furnished equipment onsite. Contractor shall also allocate 45 days for installation, testing and licensing of owner furnished equipment, once anchorage and installation has been completed by the Contractor.

DocuSigned by:

Craig Ganes

01FE1BEEC6F64BF...

Craig Ganes – Project Manager
Facilities Design & Construction
UC Davis Health

HGA

MEMO

TO: *TBD*

FROM: Greg Osecheck Writer's Direct Dial 916-787-5127

DATE: May 23, 2024

SUBJECT: Narrative of changes for **Post Approval Document NO. 001**
 HGA Commission Number 1500-148-00
 UCDH Gen. Radiology Equipment Replacement - Rooms 1P752, 1P754, & 1P758
 HCAI #: **S231373-34-00-ACD-001**

OWNER:

University of California Davis Health
 UC Davis Medical Center
 2315 Stockton Blvd.
 Sacramento, CA 95817

COPY TO:

Zach Price - UCDH

HCAI:

TBD
 HCAI Regional Compliance Officer
 2020 W. El Camino Avenue, Suite 800
 Sacramento, CA 95833

Pursuant to General and Supplementary Conditions of the Contract, the following instructions are included in the work. Please acknowledge your acceptance and return a copy to the Architect.

DESCRIPTION OF THE WORK:

All revisions are clouded and noted with **Delta 3**

Sheet No.	Narrative of Changes
A201	<ul style="list-style-type: none"> Added construction barriers in demolition plan; Added and updated keynotes
A202	<ul style="list-style-type: none"> Updated equipment schedule
A662	<ul style="list-style-type: none"> Added detail #13
A672	<ul style="list-style-type: none"> Added note to detail #4 and detail #5
A673	<ul style="list-style-type: none"> Added sheet
E301	<ul style="list-style-type: none"> Added in provisions for temporary power. Electrical contractor to remove after construction has been completed.
Attachments	Revised Sheets: A201, A202, A662, A672, A673, E301 Reference Sheets: A201, A202, A662, A672, E301 Structural Calculations Revised Specification Reference Specification

May 23, 2024

Narrative of Changes S220648-34-00- **Post Approval Document NO. 001**

Page 2

By: Greg Osecheck
AOR – C33192



HAMMEL, GREEN AND ABRAHAMSON, INC.

TABLE OF CONTENTS**Division 00 — Procurement and Contracting Requirements - Not Used****Division 01 — General Requirements**

011100	Summary of the Work
011400	Work Restrictions
012200	Allowances
012300	Alternates
012500	Clarification Information Procedures
012550	Contract Modification Procedures
012700	Unit Prices
012900	Measurement and Payment
013100	Coordination
013200	Contract Schedules
013220	Construction Progress Reporting
013300	Shop Drawings, Product Data and Samples
013400	Contractor(S) Emergency Procedures
013500	IISM Requirement Verification Card
013500	ILSM Criteria and Daily Log Template
013500	ILSM Impact Worksheet 10-2017
013500	Special Procedures
013900	Green Building Policy Implementation
014100	Regulatory Requirements
014200	References
014300	Mock-Ups
014500	Quality Control
014510	Seismic Control – HCAI
014550	Inspection and Testing of Work
015100	Temporary Utilities
015200	Construction Facilities
015500	Vehicular Access and Parking
015600	Temporary Barriers, Enclosures and Controls
015610	Airborne Contaminants Control
015610	ICRA Form
015620	Requirements for Ceiling Access to Spaces Containing Asbestos
016100	Product Requirements
017200	Preparation
017300	Cutting and Patching
017400	Cleaning
017500	Starting and Adjusting Systems
017600	Protection of Existing and Installed Construction
017700	Closeout Procedures
017800	Closeout Submittals
018200	Demonstration and Training
019100	Commissioning
019110	Building Envelope Commissioning

Division 02 — Existing Conditions

024120	Selective Demolition
--------	----------------------

Divisions 03 through 05 - Not Used

Not Used

Division 06 — Wood, Plastics, and Composites

061000 Rough Carpentry
 064100 Architectural Wood Casework

Division 07 — Thermal and Moisture Protection

079200 Joint Sealants

Division 08 — Openings - Not Used**Division 09 — Finishes**

092216 Non-Structural Metal Framing
 092900 Gypsum Board
 096513 Resilient Base and Accessories
 096516 Resilient Sheet Flooring
 099000 Painting

Division 10 — Specialties

102600 Wall and Door Protection

Division 11 — Equipment - Not Used**Division 12 — Furnishings**

123661 Simulated Stone Countertops

Division 13 - Special Construction

134900 Radiation Protection

Divisions 143 through 21 - Not Used**Division 22 — Plumbing**

220500 Common Work Results for Plumbing
 220518 Escutcheons for Plumbing Piping
 220523.12 Ball Valves for Plumbing Piping
 220529 Hangers and Supports for Plumbing Piping and Equipment
 220553 Identification for Plumbing Piping and Equipment
 220719 Plumbing Piping Insulation
 221116 Domestic Water Piping
 221119 Domestic Water Piping Specialties
 221316 Sanitary Waste and Vent Piping
 221319 Sanitary Waste Piping Specialties
 226000 Gas Piping for Laboratory and Healthcare Facilities

Division 23 — Heating Ventilating and Air Conditioning

230593 Testing, Adjusting, and Balancing for HVAC

Division 25 — Integrated Automation - Not Used**Division 26 — Electrical**

260500 Common Work Results for Electrical
 260519 Low-Voltage Electrical Power Conductors and Cables
 260526 Grounding and Bonding and Electrical Systems
 260529 Hangers and Supports for Electrical Systems
 260533 Raceways and Boxes for Electrical Systems
 260544 Sleeves and Sleeve Seals for Electrical Raceways and Cabling
 260548 Seismic Controls for Electrical Systems
 260548 Seismic Controls for Electrical Systems
 260553 Identification for Electrical Systems
 260923 Lighting Control Devices
 262726 Wiring Devices
 262816 Enclosed Switches and Circuit Breakers
 265119 Led Interior Lighting

265219 Emergency and Exit Lighting

Divisions 27 through 33 - Not Used

END TABLE OF CONTENTS

SECTION 092216
NON-STRUCTURAL METAL FRAMING

PART 1 - GENERAL

1.1 SUMMARY

- A. Section Includes:
1. Non-load-bearing steel framing systems for interior partitions.

1.2 ACTION SUBMITTALS

- A. Product Data: For each type of product.

1.3 INFORMATIONAL SUBMITTALS

- A. Product Certificates: For each type of code-compliance certification for studs and tracks.
- B. Evaluation Reports: For embossed steel studs and tracks, firestop tracks, post-installed anchors and power-actuated fasteners, from ICC-ES or other qualified testing agency acceptable to authorities having jurisdiction.

1.4 QUALITY ASSURANCE

- A. Code-Compliance Certification of Studs and Tracks: Provide documentation that framing members are certified according to the product-certification program of the Certified Steel Stud Association the Steel Framing Industry Association or the Steel Stud Manufacturers Association.

PART 2 - PRODUCTS

2.1 PERFORMANCE REQUIREMENTS

- A. Fire-Test-Response Characteristics: For fire-resistance-rated assemblies that incorporate non-load-bearing steel framing, provide materials and construction identical to those tested in assembly indicated, according to ASTM E 119 by an independent testing agency.
- B. STC-Rated Assemblies: For STC-rated assemblies, provide materials and construction identical to those tested in assembly indicated on Drawings, according to ASTM E 90 and classified according to ASTM E 413 by an independent testing agency.
- C. Performance Requirements: Provide metal framing as indicated but not lesser bare metal thickness than that required to comply with ASTM C754 assuming horizontal loading of 5 lbf/sq. ft. under the following conditions:
1. Gypsum board partitions:
 - a. Standard systems: Maximum deflection of 1/240 of partition height.
- D. Design framing systems in accordance with AISI S220, "North American Specification for the Design of Cold-Formed Steel Framing - Nonstructural Members," unless otherwise indicated.
- E. Design framing systems to accommodate deflection of primary building structure and construction tolerances and to withstand design loads with a maximum deflection of 1 inch (25 mm).

2.2 FRAMING SYSTEMS

- A. Framing Members, General: Comply with ASTM C 754 for conditions indicated.
1. Steel Sheet Components: Comply with ASTM C 645 requirements for metal unless otherwise indicated.
 2. Protective Coating: ASTM A 653/A 653M, G40, hot-dip galvanized unless otherwise indicated.
- B. Studs and Tracks (MET STUD): ASTM C 645. Use either steel studs and tracks or embossed steel studs and tracks.
1. Steel Studs and Tracks:
 - a. Minimum Base-Metal Thickness: 0.0329 inch.
 - b. Depth: As indicated on Drawings.
 2. Embossed Steel Studs and Tracks: Roll-formed and embossed with surface deformations to stiffen the framing members so that they are structurally equivalent to conventional ASTM C 645 steel studs and tracks.
 - a. Depth: As indicated on Drawings.
- C. Slip-Type Head Joints: Where indicated, provide one of the following:
1. Single Long-Leg Track System: ASTM C 645 top track with 2-inch-deep flanges in thickness not less than indicated for studs, installed with studs friction fit into top track and with continuous bridging located within 12 inches of the top of studs to provide lateral bracing.
 2. Double-Track System: ASTM C 645 top outer tracks, inside track with 2-inch-deep flanges in thickness not less than indicated for studs and fastened to studs, and outer track sized to friction-fit over inner track.
- D. Firestop Tracks: Top track manufactured to allow partition heads to expand and contract with movement of structure while maintaining continuity of fire-resistance-rated assembly indicated; in thickness not less than indicated for studs and in width to accommodate depth of studs.
- E. Flat Strap and Backing Plate: Steel sheet for blocking and bracing in length and width indicated.
1. Minimum Base-Metal Thickness: 0.0329 inch.
- F. Cold-Rolled Channel Bridging: Steel, 0.0538-inch minimum base-metal thickness, with minimum 1/2-inch-wide flanges.
1. Depth: As indicated on Drawings.
 2. Clip Angle: Not less than 1-1/2 by 1-1/2 inches, 0.068-inch-thick, galvanized steel.
- G. Hat-Shaped, Rigid Furring Channels (MET FURG-1): ASTM C 645.
1. Minimum Base-Metal Thickness: 0.0329 inch.
 2. Depth: As indicated on Drawings.
- H. Resilient Furring Channels: 1/2-inch-deep, steel sheet members designed to reduce sound transmission.
1. Configuration: Asymmetrical or hat shaped.
- I. Cold-Rolled Furring Channels: 0.053-inch uncoated-steel thickness, with minimum 1/2-inch-wide flanges.
1. Depth: As indicated on Drawings.
 2. Furring Brackets: Adjustable, corrugated-edge-type steel sheet with minimum uncoated-steel thickness of 0.0329 inch.
 3. Tie Wire: ASTM A 641/A 641M, Class 1 zinc coating, soft temper, 0.062-inch-diameter wire, or double strand of 0.048-inch-diameter wire.

-
- J. Z-Shaped Furring (MET FURG-2): With slotted or nonslotted web, face flange of 1-1/4 inches, wall attachment flange of 7/8 inch, minimum uncoated-metal thickness of 0.0179 inch, and depth required to fit insulation thickness indicated.

2.3 AUXILIARY MATERIALS

- A. General: Provide auxiliary materials that comply with referenced installation standards.
1. Fasteners for Steel Framing: Of type, material, size, corrosion resistance, holding power, and other properties required to fasten steel members to substrates.
- B. Isolation Strip at Exterior Walls: Provide the following:
1. Foam Gasket: Adhesive-backed, closed-cell vinyl foam strips that allow fastener penetration without foam displacement, 1/8 inch thick, in width to suit steel stud size.

PART 3 - EXECUTION

3.1 EXAMINATION

- A. Examine areas and substrates, with Installer present, and including welded hollow-metal frames, cast-in anchors, and structural framing, for compliance with requirements and other conditions affecting performance of the Work.
- B. Proceed with installation only after unsatisfactory conditions have been corrected.

3.2 PREPARATION

- A. Suspended Assemblies: Coordinate installation of suspension systems with installation of overhead structure to ensure that inserts and other provisions for anchorages to building structure have been installed to receive hangers at spacing required to support the Work and that hangers will develop their full strength.
1. Furnish concrete inserts and other devices indicated to other trades for installation in advance of time needed for coordination and construction.

3.3 INSTALLATION, GENERAL

- A. Installation Standard: ASTM C 754.
1. Portland Cement Plaster Assemblies: Also comply with requirements in ASTM C 1063 that apply to framing installation.
 2. Gypsum Board Assemblies: Also comply with requirements in ASTM C 840 that apply to framing installation.
- B. Install framing and accessories plumb, square, and true to line, with connections securely fastened.
- C. Install supplementary framing, and blocking to support fixtures, equipment services, heavy trim, grab bars, toilet accessories, furnishings, or similar construction.
- D. Install bracing at terminations in assemblies.
- E. Do not bridge building control and expansion joints with non-load-bearing steel framing members. Frame both sides of joints independently.

3.4 INSTALLING FRAMED ASSEMBLIES

- A. Install framing system components according to spacings indicated, but not greater than spacings required by referenced installation standards for assembly types.
- B. Where studs are installed directly against exterior masonry walls or dissimilar metals at exterior walls, install isolation strip between studs and exterior wall.
- C. Install studs so flanges within framing system point in same direction.
- D. Install tracks at floors and overhead supports. Extend framing full height to structural supports or substrates above suspended ceilings except where partitions are indicated to terminate at suspended ceilings. Continue framing around ducts that penetrate partitions above ceiling.
 - 1. Slip-Type Head Joints: Where framing extends to overhead structural supports, install to produce joints at tops of framing systems that prevent axial loading of finished assemblies.
 - 2. Door Openings: Screw vertical studs at jambs to jamb anchor clips on door frames; install track section (for cripple studs) at head and secure to jamb studs.
 - a. Install two studs at each jamb unless otherwise indicated.
 - b. Install cripple studs at head adjacent to each jamb stud, with a minimum 1/2 inch clearance from jamb stud to allow for installation of control joint in finished assembly.
 - 3. Fire-Resistance-Rated Partitions: Install framing to comply with fire-resistance-rated assembly indicated and support closures and to make partitions continuous from floor to underside of solid structure.
 - a. Firestop Track: Where indicated, install to maintain continuity of fire-resistance-rated assembly indicated.
 - 4. Sound-Rated Partitions: Install framing to comply with sound-rated assembly indicated.
- E. Direct Furring:
 - 1. Attach to concrete or masonry with stub nails, screws designed for masonry attachment, or powder-driven fasteners spaced 24 inches o.c.
- F. Z-Shaped Furring Members:
 - 1. Except at exterior corners, securely attach narrow flanges of furring members to wall with concrete stub nails, screws designed for masonry attachment, or powder-driven fasteners spaced 24 inches o.c.
 - 2. At exterior corners, attach wide flange of furring members to wall with short flange extending beyond corner; on adjacent wall surface, screw-attach short flange of furring channel to web of attached channel. At interior corners, space second member no more than 12 inches from corner and cut insulation to fit.
- G. Installation Tolerance: Install each framing member so fastening surfaces vary not more than 1/8 inch from the plane formed by faces of adjacent framing.

END OF SECTION

SECTION 092900
GYPSUM BOARD

PART 1 - GENERAL

1.1 SUMMARY

- A. Section Includes: Interior gypsum board.

1.2 ACTION SUBMITTALS

- A. Product Data: For each type of product.

1.3 DELIVERY, STORAGE AND HANDLING

- A. Store materials inside under cover and keep them dry and protected against weather, condensation, direct sunlight, construction traffic, and other potential causes of damage. Stack panels flat and supported on risers on a flat platform to prevent sagging.

1.4 FIELD CONDITIONS

- A. Environmental Limitations: Comply with ASTM C 840 requirements or gypsum board manufacturer's written instructions, whichever are more stringent.
- B. Do not install paper-faced gypsum panels until installation areas are enclosed and conditioned.
- C. Do not install panels that are wet, moisture damaged, and mold damaged.
 - 1. Indications that panels are wet or moisture damaged include, but are not limited to, discoloration, sagging, or irregular shape.
 - 2. Indications that panels are mold damaged include, but are not limited to, fuzzy or splotchy surface contamination and discoloration.

PART 2 - PRODUCTS

2.1 PERFORMANCE REQUIREMENTS

- A. Fire-Resistance-Rated Assemblies: For fire-resistance-rated assemblies, provide materials and construction identical to those tested in assembly indicated according to ASTM E 119 by an independent testing agency.
- B. STC-Rated Assemblies: For STC-rated assemblies, provide materials and construction identical to those tested in assembly indicated according to ASTM E 90 and classified according to ASTM E 413 by an independent testing agency.

2.2 GYPSUM BOARD, GENERAL

- A. Size: Provide maximum lengths and widths available that will minimize joints in each area and that correspond with support system indicated.

2.3 INTERIOR GYPSUM BOARD

- A. Manufacturers:
1. American Gypsum.
 2. Certainteed; SAINT-GOBAIN.
 3. National Gypsum Company.
 4. PABCO Gypsum.
 5. USG Corporation.
- B. Gypsum Board, Type X: ASTM C 1396/C 1396M.
1. Thickness: 5/8 inch.
 2. Long Edges: Tapered.
 3. Acceptable products and manufacturers: Equivalent to Sheetrock Brand SW, Firecode Gypsum Panels by United States Gypsum (USG).

2.4 ACCESSORIES

- A. Interior Trim: ASTM C 1047.
1. Material: Galvanized or aluminum-coated steel sheet or rolled zinc.
 2. Shapes:
 - a. Cornerbead.
 - b. LC-Bead: J-shaped; exposed long flange receives joint compound.
 - c. L-Bead: L-shaped; exposed long flange receives joint compound.
 - d. U-Bead: J-shaped; exposed short flange does not receive joint compound.
 - e. Expansion (control) joint.

2.5 JOINT TREATMENT MATERIALS

- A. General: Comply with ASTM C 475/C 475M.
- B. Joint Tape:
1. Interior Gypsum Board: Paper.
- C. Joint Compound for Interior Gypsum Board: For each coat, use formulation that is compatible with other compounds applied on previous or for successive coats.
1. Prefilling: At open joints and damaged surface areas, use setting-type taping compound.
 2. Embedding and First Coat: For embedding tape and first coat on joints, fasteners, and trim flanges, use setting-type taping or drying-type, all-purpose compound.
 - a. Use setting-type compound for installing paper-faced metal trim accessories.
 3. Fill Coat: For second coat, use setting-type, sandable topping or drying-type, all-purpose compound.
 4. Finish Coat: For third coat, use setting-type, sandable topping or drying-type, all-purpose compound.

2.6 AUXILIARY MATERIALS

- A. General: Provide auxiliary materials that comply with referenced installation standards and manufacturer's written instructions.
- B. Laminating Adhesive: Adhesive or joint compound recommended for directly adhering gypsum panels to continuous substrate.
- C. Steel Drill Screws: ASTM C 1002 unless otherwise indicated.
1. Use screws complying with ASTM C 954 for fastening panels to steel members from 0.033 to 0.112 inch thick.

- D. Closed-Cell Tape Sponge Neoprene: Press-on Products, No. P-8200 or P-8100, or approved equal.
- E. Foam Backer Rod: Closed cell polyethylene, ASTM C962: by ITP, Nomeco, or approved equal.

PART 3 - EXECUTION

3.1 EXAMINATION

- A. Examine areas and substrates including welded hollow-metal frames and support framing, with Installer present, for compliance with requirements and other conditions affecting performance of the Work.
- B. Examine panels before installation. Reject panels that are wet, moisture damaged, and mold damaged.
- C. Proceed with installation only after unsatisfactory conditions have been corrected.

3.2 PREPARATION

- A. Sprayed Fire-Resistive Materials: Coordinate with gypsum board shaft wall assemblies so both elements of Work remain complete and undamaged. Patch or replace sprayed fire-resistive materials removed or damaged during installation of shaft wall assemblies to comply with requirements specified in Section 078100 "Applied Fire Protection."

3.3 APPLYING AND FINISHING PANELS, GENERAL

- A. Comply with ASTM C 840.
- B. Install ceiling panels across framing to minimize the number of abutting end joints and to avoid abutting end joints in central area of each ceiling. Stagger abutting end joints of adjacent panels not less than one framing member.
- C. Install panels with face side out. Butt panels together for a light contact at edges and ends with not more than 1/16 inch of open space between panels. Do not force into place.
- D. Locate edge and end joints over supports, except in ceiling applications where intermediate supports or gypsum board back-blocking is provided behind end joints. Do not place tapered edges against cut edges or ends. Stagger vertical joints on opposite sides of partitions. Do not make joints other than control joints at corners of framed openings.
- E. Form control and expansion joints with space between edges of adjoining gypsum panels.
- F. Cover both faces of support framing with gypsum panels in concealed spaces (above ceilings, etc.), except in chases braced internally.
 - 1. Unless concealed application is indicated or required for sound, fire, air, or smoke ratings, coverage may be accomplished with scraps of not less than 8 sq. ft.in area.
 - 2. Fit gypsum panels around ducts, pipes, and conduits.
 - 3. Where partitions intersect structural members projecting below underside of floor/roof slabs and decks, cut gypsum panels to fit profile formed by structural members; allow 1/4- to 3/8-inch-wide joints to install sealant.

- G. Isolate perimeter of gypsum board applied to non-load-bearing partitions at structural abutments. Provide 1/4- to 1/2-inch- wide spaces at these locations and trim edges with edge trim where edges of panels are exposed. Seal joints between edges and abutting structural surfaces with acoustical sealant.
- H. Attachment to Steel Framing: Attach panels so leading edge or end of each panel is attached to open (unsupported) edges of stud flanges first.

3.4 APPLYING INTERIOR GYPSUM BOARD

- A. Single-Layer Application:
 - 1. On ceilings, apply gypsum panels before wall/partition board application to greatest extent possible and at right angles to framing unless otherwise indicated.
 - 2. On partitions/walls, apply gypsum panels vertically (parallel to framing) or horizontally (perpendicular to framing) unless otherwise indicated or required by fire-resistance-rated assembly, and minimize end joints.
 - a. Stagger abutting end joints not less than one framing member in alternate courses of panels.
 - b. At stairwells and other high walls, install panels horizontally unless otherwise indicated or required by fire-resistance-rated assembly.
 - 3. On Z-shaped furring members, apply gypsum panels vertically (parallel to framing) with no end joints. Locate edge joints over furring members.
 - 4. Fastening Methods: Apply gypsum panels to supports with steel drill screws.
- B. Multilayer Application:
 - 1. On ceilings, apply gypsum board indicated for base layers before applying base layers on walls/partitions; apply face layers in same sequence. Apply base layers at right angles to framing members and offset face-layer joints one framing member, 16 inches minimum, from parallel base-layer joints, unless otherwise indicated or required by fire-resistance-rated assembly.
 - 2. On partitions/walls, apply gypsum board indicated for base layers and face layers vertically (parallel to framing) with joints of base layers located over stud or furring member and face-layer joints offset at least one stud or furring member with base-layer joints unless otherwise indicated or required by fire-resistance-rated assembly. Stagger joints on opposite sides of partitions.
 - 3. On Z-shaped furring members, apply base layer vertically (parallel to framing) and face layer either vertically (parallel to framing) or horizontally (perpendicular to framing) with vertical joints offset at least one furring member. Locate edge joints of base layer over furring members.
 - 4. Fastening Methods: Fasten base layers and face layers separately to supports with screws.
- C. Laminating to Substrate: Where gypsum panels are indicated as directly adhered to a substrate (other than studs, joists, furring members, or base layer of gypsum board), comply with gypsum board manufacturer's written instructions and temporarily brace or fasten gypsum panels until fastening adhesive has set.

3.5 INSTALLING TRIM ACCESSORIES

- A. General: For trim with back flanges intended for fasteners, attach to framing with same fasteners used for panels. Otherwise, attach trim according to manufacturer's written instructions.
- B. Control Joints: Install control joints at locations indicated on Drawings, according to ASTM C 840 and in specific locations approved by Project Director/COR for visual effect.

3.6 FINISHING GYPSUM BOARD

- A. General: Treat gypsum board joints, interior angles, edge trim, control joints, penetrations, fastener heads, surface defects, and elsewhere as required to prepare gypsum board surfaces for decoration. Promptly remove residual joint compound from adjacent surfaces.
- B. Prefill open joints, rounded or beveled edges, and damaged surface areas.
- C. Apply joint tape over gypsum board joints, except for trim products specifically indicated as not intended to receive tape.
- D. Gypsum Board Finish Levels: Finish panels to levels indicated below and according to ASTM C 840:
 - 1. Level 1: Ceiling plenum areas, concealed areas, and where indicated.
 - 2. Level 2: Panels that are substrate for tile, except remove toll marks and ridges.
 - 3. Level 4: At panel surfaces that will be exposed to view unless otherwise indicated.
 - a. Primer and its application to surfaces are specified in Section 099000 "Painting."

3.7 PROTECTION

- A. Protect adjacent surfaces from drywall compound and promptly remove from floors and other non-drywall surfaces. Repair surfaces stained, marred, or otherwise damaged during drywall application.
- B. Protect installed products from damage from weather, condensation, direct sunlight, construction, and other causes during remainder of the construction period.
- C. Remove and replace panels that are wet, moisture damaged, and mold damaged.
 - 1. Indications that panels are wet or moisture damaged include, but are not limited to, discoloration, sagging, or irregular shape.
 - 2. Indications that panels are mold damaged include, but are not limited to, fuzzy or splotchy surface contamination and discoloration.

END OF SECTION

SECTION 134900
RADIATION PROTECTION

PART 1 - GENERAL

1.1 SUMMARY

- A. Section Includes: Lead-lined gypsum board.

1.2 DEFINITIONS

- A. Lead Equivalence: The thickness of lead that provides the same attenuation (reduction of radiation passing through) as the material in question under the specified conditions.
 - 1. Lead equivalence specified for materials used in diagnostic x-ray rooms is as measured at 100 kV unless otherwise indicated.

1.3 ACTION SUBMITTALS

- A. Product Data: For each type of product.
- B. Samples: For units with factory-applied color finishes.

1.4 QUALITY ASSURANCE

- A. Installer Qualifications: Fabricator of products.

1.5 DELIVERY, STORAGE, AND HANDLING

- A. Lead-Lined Gypsum Panels: Store inside under cover, and keep dry and protected against weather, condensation, direct sunlight, construction traffic, and other potential causes of damage. Stack panels flat and supported on risers on a flat platform to prevent sagging.

1.6 FIELD CONDITIONS

- A. Environmental Limitations: Do not deliver or install radiation protection until spaces are enclosed and weathertight, wet work in spaces is complete and dry, and temporary HVAC system is operating and maintaining ambient temperature and humidity conditions at occupancy levels during the remainder of the construction period.

PART 2 - PRODUCTS

2.1 PERFORMANCE REQUIREMENTS

- A. Provide materials and workmanship, including joints and fasteners, that maintain continuity of radiation protection at all points and in all directions equivalent to materials specified in thicknesses and locations indicated.
- B. Materials, thicknesses, and configurations of radiation protection products indicated are based on radiation protection design prepared by Owner's radiation health physicist. This design is available to Contractor upon request.

-
- C. Lead-Lined Assemblies: Unless otherwise indicated, provide lead thickness in lead-lined assemblies of not less than lead thickness indicated for assemblies in which they are installed.

2.2 LEAD-LINED GYPSUM BOARD

- A. Lead-Lined Gypsum Board: 5/8-inch-thick gypsum board complying with Section 092900 "Gypsum Board," of width and length required for support spacing and to prevent cracking during handling, and with a single sheet of lead laminated to the back of the board.
 - 1. Lead Sheet Lining: Full width of board and length necessary to extend from floor to 84 inches above floor.
 - 2. Furnish 2-inch- wide lead strips for backing joints.
 - 3. Furnish finishing materials, accessories, and trim for lead-lined gypsum board complying with Section 092900 "Gypsum Board."

2.3 MISCELLANEOUS MATERIALS

- A. Accessories and Fasteners: Manufacturer's standard fasteners and accessories as required for installation, maintaining same lead equivalence as rest of system.
- B. Asphalt Coating: Cold-applied asphalt emulsion complying with ASTM D1187/D1187M.
- C. Asphalt Felt: ASTM D226/D226M.

PART 3 - EXECUTION

3.1 EXAMINATION

- A. Examine substrates with Installer present for compliance with requirements, installation tolerances, and other conditions affecting performance of radiation protection.
- B. Proceed with installation only after unsatisfactory conditions have been corrected.

3.2 INSTALLATION OF LEAD-LINED GYPSUM BOARD

- A. Install and finish lead-lined gypsum board in accordance with Section 092900 "Gypsum Board."
- B. Install lead-lined gypsum board panels with long edge parallel to supports and lead lining facing supports. Provide blocking at end joints.
- C. Install lead-lined gypsum board panels in sequence, so lead lining that extends beyond edge of gypsum board is covered by next panel installed.
- D. At joints where lead lining does not extend beyond edge of gypsum board panels, install lead strips 2 inches wide and same thickness as lead lining to face of framing and blocking. Secure lead strips with construction adhesive.
- E. Provide shims at face of supports and blocking, where lead lining does not overlap, to provide a uniform plane across panel surfaces.
- F. Fasten lead-lined gypsum board to framing, with steel drill screws spaced as recommended in writing by lead-lined gypsum board manufacturer.

- G. Two-Layer System: Apply a facing sheet of gypsum board vertically over base sheet, using laminating adhesive recommended in writing by gypsum board manufacturer. Offset joints in finish layer from joints in base layer, and fasten at top and bottom of sheet to support finish panel until adhesive has set.
- H. Openings: Extend lead-lined gypsum board into frames of openings, lapping lead lining with lead frames or frame linings at least 1 inch. Arrange board around openings, so neither horizontal nor vertical joints occur at corners of openings.
- I. Install control and expansion joints where indicated, with appropriate trim accessories. Install lead strip on face of framing, extending across joint, and lap with lead lining of gypsum board.


3.3 INSTALLATION OF PENETRATING ITEMS

- A. At penetrations of lead linings, provide lead shields to maintain continuity of protection.
- B. Provide lead linings, sleeves, shields, and other protection in thickness of not less than that required in assembly being penetrated.
- C. Secure shields at penetrations using adhesive or wire ties but not penetrating fasteners unless indicated on Drawings.
- D. Outlet Boxes and Conduit: Cover or line with lead sheet lapped over adjacent lead lining at least 1 inch. Wrap conduit with lead sheet for a distance of not less than 10 inches from box.
- E. Duct Openings: Unless otherwise indicated, line or wrap ducts with lead sheet for distance from partition/ceiling equal to 3 times the largest opening dimension. Lap lead sheet with adjacent lead lining at least 1 inch.
- F. Piping: Unless otherwise indicated, wrap piping with lead sheet for a distance of not less than 10 inches from point of penetration.

3.4 FIELD QUALITY CONTROL

- A. Testing Agency: Owner will engage a qualified testing agency to perform tests and inspections after radiology equipment has been installed and placed in operating condition.
- B. Correct deficiencies in or remove and replace radiation protection that inspection reports indicate does not comply with specified requirements.

END OF SECTION

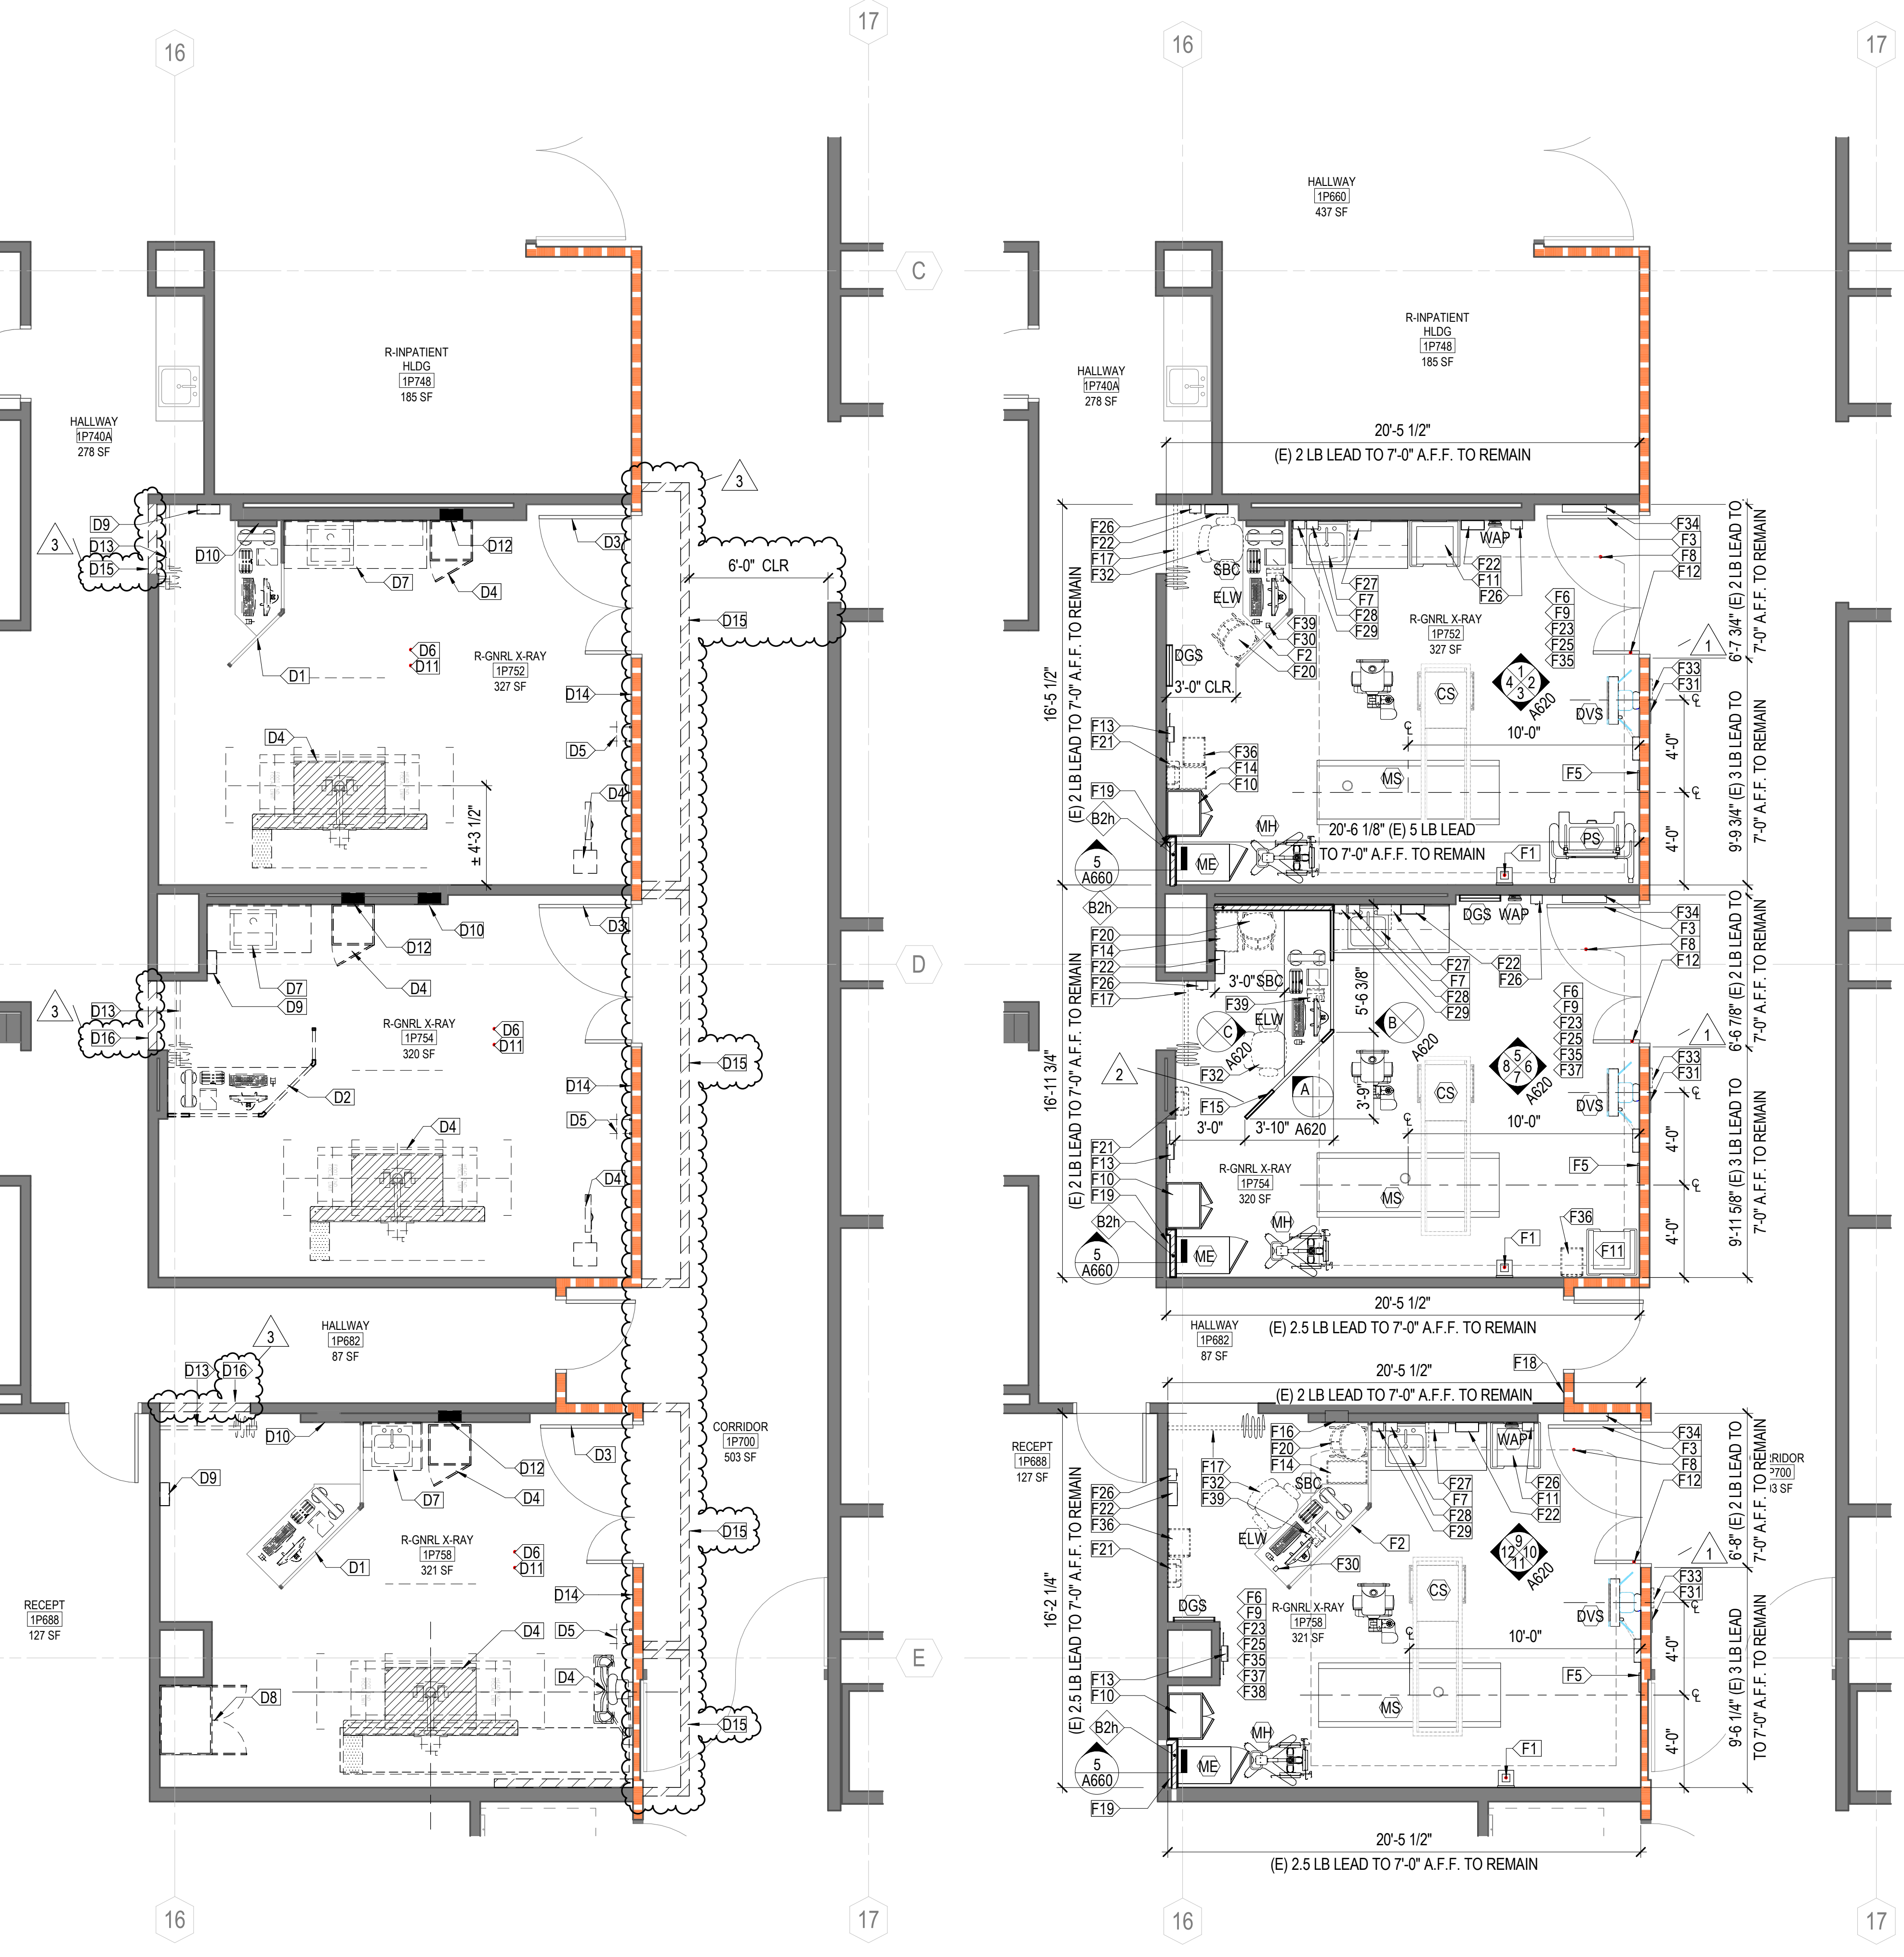

1 DEMOLITION PLAN - LEVEL 01
1/4" = 1'-0"

2 FLOOR PLAN - LEVEL 01 PROPOSED
1/4" = 1'-0"

EQUIPMENT LEGEND

SEE FULL EQUIPMENT SCHEDULE ON SHEET A202 FOR MORE INFORMATION.

TAG	DESCRIPTION
(MS)	(N) PHILIPS DIGITALDIAGNOST TH/TH2 TABLE
(DVS)	(N) PHILIPS BUCKYDIAGNOST VS DIGITAL
(CS)	(N) PHILIPS CSM3 OVERHEAD X-RAY TUBE
(ME)	(N) PHILIPS GENERATOR M-CABINET CXA
(ELW)	(N) PHILIPS ELEVA WORKSPOT
(SBC)	(N) PHILIPS SKYPLATE BATTERY CHARGER
(WAP)	(N) PHILIPS WI-FI ACCESS POINT, MOUNT MIN. 80" ABOVE FINISH FLOOR
(MH)	(N) PHILIPS SKYPLATE MOBILE HOLDER
(PS)	(N) PHILIPS PATIENT SUPPORT, TO BE SHARED BETWEEN ALL X-RAY ROOMS
(DGS)	(N) PHILIPS WALL-MOUNTED DETECTOR & GRID STORAGE

GENERAL NOTES - DEMOLITION PLAN

- A. COORDINATE EXTENT OF DEMOLITION WITH REQUIREMENTS FOR NEW WORK.
- B. REMOVE EXISTING CONSTRUCTION INCLUDING, BUT NOT LIMITED TO, FLOOR FINISHES, WALLS, CEILING, WALL BASE, AND OTHER EXISTING CONSTRUCTION AS INDICATED OR REQUIRED FOR NEW WORK, UNLESS NOTED OTHERWISE.
- C. REMOVE WALLS INCLUDING WALL MATERIALS INCLUDING INTEGRAL BASES, DOORS, DOOR FRAMES AND ASSOCIATED HARDWARE AND THRESHOLDS, UNLESS OTHERWISE INDICATED.
- D. REMOVE PARTITIONS COMPLETELY TO UNDERSIDE OF STRUCTURAL COMPONENTS ABOVE AND TO TOP OF FLOOR STRUCTURAL COMPONENTS AT BASE. DO NOT LEAVE SECTIONS OR MATERIALS OF WALL ASSEMBLIES IN PLACE.
- E. AT SIDES OF WALLS, THAT ABUT WALLS TO REMAIN, CUT BACK AT LEAST 1 INCH (25 MM) BEYOND FACE OF FINISH OF WALL TO REMAIN TO FACILITATE SUBSEQUENT PATCHING AND NEW CONSTRUCTION.
- F. COMPLETELY REMOVE FINISHES, SUBBASE MATERIALS AND STRUCTURAL FRAMING MATERIALS TO LINES INDICATED OR REQUIRED FOR NEW WORK.
- G. EXISTING ITEMS TO BE SALVAGED FOR REUSE IN NEW WORK:
 - A. THE UNIVERSITY DEPARTMENT STAFF ARE RESPONSIBLE FOR REMOVING ALL MISC. ITEMS NOT AFFIXED TO THE WALLS, FLOOR, OR CEILING.
 - B. CONTRACTOR TO REMOVE ALL ACCESSORIES & SMALL EQUIPMENT AFFIXED TO THE WALLS, FLOOR, OR CEILING AND COORDINATE WITH THE UNIVERSITY PRIOR TO DISPOSAL FOR POSSIBLE SALVAGE AND RE-USE.
- H. EXISTING ITEMS TO BE SALVAGED FOR DELIVERY TO OWNER:
 - A. (E) X-RAY EQUIPMENT TO BE SAFFED-OFF, ANCHORINGS TO BE REMOVED BY CONTRACTOR, AND THEN THE UNIVERSITY WILL REMOVE ALL EQUIPMENT FOR SALVAGE.
 - B. CONTRACTOR TO REMOVE ALL ACCESSORIES & SMALL EQUIPMENT AFFIXED TO THE WALLS, FLOOR, OR CEILING AND COORDINATE WITH THE UNIVERSITY PRIOR TO DISPOSAL FOR POSSIBLE SALVAGE AND RE-USE.
- I. EXISTING UTILITY SERVICES AND MECHANICAL/ELECTRICAL SYSTEMS ARE TO REMAIN, UNLESS INDICATED OTHERWISE.
- J. RELOCATE EXISTING WORK SERVING OCCUPIED PORTIONS OF THE BUILDING AS REQUIRED TO MAINTAIN SERVICE TO OCCUPIED AREAS AND TO ACCOMMODATE NEW WORK.
- K. REMOVE AND CAP PORTIONS OF EXISTING UTILITIES INDICATED TO BE DEMOLISHED AS REQUIRED TO ACCOMMODATE NEW WORK, INCLUDING SURFACE-MOUNTED ELECTRICAL CONDUIT, DEVICES AND LIGHT FIXTURES, RADIATORS, RADIATOR COVERS, PLUMBING FIXTURES AND ASSOCIATED PIPING.
- L. REMOVE CEILINGS INDICATED TO BE DEMOLISHED INCLUDING INTEGRAL HANGERS, SUPPORTS, ANCHORS AND MATERIALS OR ASSEMBLIES ATTACHED TO CEILING CONSTRUCTION.
- M. REMOVE SUSPENDED CEILINGS TO UNDERSIDE OF STRUCTURE OR ORIGINAL PLASTER OR GYPSUM BOARD CEILING SURFACES.
- N. MAINTAIN EGRESS FROM EXISTING OCCUPIED SPACES AND SURROUNDING BUILDING AREAS AS INDICATED AND AS REQUIRED BY AUTHORITIES HAVING JURISDICTION MAINTAIN EGRESS FROM EXISTING OCCUPIED SPACES AND SURROUNDING BUILDING AREAS AS INDICATED AND AS REQUIRED BY AUTHORITIES HAVING JURISDICTION.
- O. PROVIDE AND MAINTAIN FIRE EXTINGUISHERS IN AREA OF WORK, IN ACCORDANCE WITH REQUIREMENTS OF AUTHORITIES HAVING JURISDICTION.
- P. COORDINATE UTILITY INTERRUPTIONS WITH OWNER. PROVIDE AT LEAST 48 HOURS WRITTEN NOTICE TO OWNER BEFORE UTILITY INTERRUPTIONS OBTAIN OWNER'S WRITTEN APPROVAL OF INTERRUPTIONS BEFORE PROCEEDING.
- Q. COORDINATE OPERATIONS THAT MAY RESULT IN HIGH LEVELS OF NOISE AND VIBRATION, ODORS, OR OTHER DISTURBANCES TO OCCUPANCY WITH OWNER. OBTAIN OWNER'S WRITTEN PERMISSION BEFORE PROCEEDING.
- R. PROVIDE TEMPORARY BARRIERS AND ENCLOSURES AS REQUIRED TO PROTECT MATERIALS AND PEOPLE. PREVENT DUST, FUMES, AND ODORS FROM ENTERING OCCUPIED AREAS. MAINTAIN AND RELOCATE TEMPORARY BARRIERS AND ENCLOSURES AS REQUIRED BY THE PROGRESS OF THE WORK. REMOVE TEMPORARY BARRIERS AND ENCLOSURES AT COMPLETION OF WORK.
- S. PRIOR TO STARTING DEMOLITION, VERIFY EXISTING CONDITIONS AND DIMENSIONS. COORDINATE EXTENT OF DEMOLITION WORK AND EXISTING CONSTRUCTION TO REMAIN WITH NEW WORK. NOTIFY ARCHITECT OF CONFLICTS OR DISCREPANCIES.
- T. REFER TO DISCIPLINE-SPECIFIC DRAWINGS FOR RELATED FIRE SUPPRESSION, PLUMBING, HEATING VENTILATION AND AIR CONDITIONING, ELECTRICAL, COMMUNICATIONS, AND ELECTRONIC SAFETY AND SECURITY SYSTEM DEMOLITION WORK.

KEYNOTES

#	DESCRIPTION
D1	(E) BARRIER, MIN. 2 LB/FT AND 7'-0" HEIGHT MIN., & DESK TO REMAIN.
D2	REMOVE (E) LEAD EQUIVALENT X-RAY BARRIER / MODULAR WALL SYSTEM AND (E) DESK SURFACE. RELOCATE (E) POWER & DATA OUTLETS TO NEW DESK LOCATION.
D3	(E) LEAD LINED DOOR AND FRAME TO REMAIN. SEE UC DAVIS HEALTH SHIELDING DESIGN REPORT ON SHEETS A011 & A012 FOR MORE INFO.
D4	REMOVE (E) GENERAL RADIOLOGY EQUIPMENT. GC TO SAFE-OFF AND REMOVE ANCHORING. UNIVERSITY TO REMOVE EQUIPMENT.
D5	RELOCATE (E) MED GAS OUTLETS. SEE FLOOR PLAN AND PLUMBING PLANS FOR MORE INFO.
D6	REMOVE (E) FLOORING & BASE. CLEAN AND PREPARE SURFACE FOR NEW FLOORING INSTALLATION.
D7	REMOVE (E) COUNTER, SINK AND BASE CABINET.
D8	REMOVE (E) METAL CABINET. IF SET ON RAISED BASE, REMOVE BASE AND CLEAN AND PREPARE FLOOR SURFACE FOR NEW FLOORING.
D9	REMOVE (E) EQUIPMENT, COORDINATE WITH UNIVERSITY PRIOR TO DISPOSAL. REPLACE WITH (N) EQUIPMENT AS INDICATED ON PLANS. COORDINATE WITH DEPARTMENT.
D10	(E) ELECTRICAL PANEL TO REMAIN.
D11	REMOVE (E) WALL PROTECTION AND CORNER GUARDS. CLEAN AND REPAIR WALL SURFACE FOR NEW WALL PROTECTION AND CORNER GUARD INSTALLATION.
D12	REMOVE (E) X-RAY GENERATOR WALL BOX. PATCH & REPAIR WALL AS NEEDED.
D13	REMOVE (E) PRIVACY CURTAIN AND TRACK.
D14	REMOVE (E) LEADED GYPSUM BOARD AND INSTALL BACKING IN WALL PER MANUF. REQUIREMENTS FOR NEW X-RAY BUCKY. THEN RE-INSTALL LEADED GYPSUM BOARD TO PATCH OPENING PER REQUIREMENTS IN PHYSICISTS REPORT ON SHEETS A011 & A012.
D15	TEMPORARY CONSTRUCTION BARRIER - STARC 1 HOUR RATED WALL SYSTEM PER DETAIL 13/A692. PROVIDE ACCESS DOOR TO MAINTAIN RATING AND VESTIBULE SPACE TO MEET UCDH ICRA STANDARDS. BARRIER TO EXTEND 6" BEYOND AREA WHERE WALL RATING IS IMPACTED BY CONSTRUCTION ACTIVITIES. GC TO COORDINATE LAYOUT AND INSTALLATION WITH FIRE MARITAL BARRIER TO REMAIN WHILE X-RAY ROOM IS UNDER CONSTRUCTION.
D16	TEMPORARY DUST BARRIER - NON RATED INFILL WALL OR PLASTIC BARRIER, FULLY SEALED. NO ACCESS SIGNAGE TO BE POSTED ON HALLWAY SIDE OF THE BARRIER. ENSURE ISOLATION MEETS UCDH ICRA STANDARDS. BARRIER TO REMAIN WHILE X-RAY ROOM IS UNDER CONSTRUCTION.

- F1 (N) PHILIPS WALL MOUNTED X-RAY TUBE CONNECTION, +9'-2" A.F.F. TO CENTER LINE.
- F2 (E) BARRIER, MIN. 2 LB/FT AND 7'-0" HEIGHT MIN.
- F3 (E) LEAD LINED DOOR AND FRAME TO REMAIN.
- F5 RELOCATED MED GAS OUTLETS. FINAL LOCATION TO BE VERIFIED IN FIELD. PATCH AND REPAIR WALL WITH LEADED GYPSUM BOARD TO MATCH EXISTING AFTER RELOCATION.
- F6 (N) FLOOR AND BASE. SEE FINISH PLAN ON A262.
- F7 (N) ACCESSIBLE HANDWASH FIXTURE, COUNTER AND BASE & UPPER CABINETS. PROVIDE 90 DEGREE CLOSURE AT TOP OF UPPER CABINETS AND LIGHTING BELOW.
- F8 AREA OF TRAVEL OF OVERHEAD RAIL & TUBE.
- F9 PATCH, REPAIR & PAINT ALL WALLS AND SOFFITS. SEE FINISH PLAN ON A262.
- F10 (N) FURNITURE CABINET FOR RADIOLOGY ACCESSORY STORAGE.
- F11 RELOCATED ROLLING CRASH CART.
- F12 (E) DOOR STOP FOR SMALL LEAF TO BE ADJUSTED TO PREVENT MOVEMENT BEYOND 90 DEGREES.
- F13 (N) WALL-MOUNTED APRON STORAGE RACK. PROVIDE BACKING IN WALL. PATCH AND REPAIR WALL WITH LEADED GYPSUM BOARD TO MATCH EXISTING.
- F14 (N) TRASH CAN.
- F15 (N) MODULAR SHIELDING PARTITION, MARSHIELD MODULAR BARRIER OR EQUAL. PROVIDE MIN. 2 LB/SQ. FT. LEAD PER UC DAVIS HEALTH SHIELDING DESIGN REPORT FOR SESP ROOM 1P752, 1P754, AND 1P758 DATED JULY 25, 2023.
- F16 (N) ELECTRICAL DISCONNECT, SEE ELECTRICAL PLANS FOR COORDINATION.
- F17 (N) PRIVACY CURTAIN AND TRACK. SEE FINISH SCHEDULE & CURTAIN TRACK DETAIL 15/A672.
- F18 (N) TACTILE EXIT SIGNAGE.
- F19 (N) FURRING WALL/ELECTRICAL CHASE, SEE DETAIL B/A660.
- F20 (N) LINEN HAMPER.
- F21 (N) WALL-MOUNTED SHARPS CONTAINER.
- F22 (N) WALL-MOUNTED GLOVE BOX HOLDER.
- F23 (N) MEDICATION WASTE BLUE BIN. LOCATION TO BE DETERMINED BY STAFF.

GENERAL NOTES - FLOOR PLAN

- A. PLAN DIMENSIONS ARE FROM FACE OF PARTITION TYPE AND DO NOT INCLUDE APPLIED FINISHES, UNLESS NOTED OTHERWISE. PLAN DIMENSIONS INDICATED AS "HOLD" OR "CLEAR" DIMENSIONS ARE FROM FACE OF APPLIED FINISH.
- B. INSTALL WORK STRAIGHT, PLUMB, LEVEL, SQUARE, AND TRUE, IN PROPER ALIGNMENT.
- C. FLATNESS: LEVEL FLOORS TO TRUE PLANE WITHIN 1/4 INCH (6 MM) IN 10'-0" (3 M) WHEN TESTED BY TEN FOOT (3 M) STRAIGHTEDGE PLACED ANYWHERE ON FLOOR IN ANY DIRECTION.
- D. BEFORE PROCEEDING WITH PARTITION FRAMING, PROVIDE LAYOUT MARKINGS OF PARTITIONS AND ASSOCIATED IN-WALL ELECTRICAL DEVICES ON SUBFLOOR FOR REVIEW BY ARCHITECT. BEFORE PROCEEDING WITH PARTITION FRAMING, PROVIDE LAYOUT MARKINGS OF PARTITIONS AND ASSOCIATED IN-WALL ELECTRICAL DEVICES ON SUBFLOOR FOR REVIEW BY ARCHITECT.
- E. COORDINATE FURNITURE-RELATED ELECTRICAL LAYOUT WITH FURNITURE VENDOR.
- F. WHERE HANDRAILS, GRAB BARS, CABINETS, WALL-MOUNTED DOOR STOPS, OR OTHER WALL-HUNG ITEMS ARE ATTACHED TO PARTITIONS, INSTALL BACKER PLATES (OR WOOD BLOCKING) ACCURATELY POSITIONED AND FIRMLY SECURED TO METAL STUDS, WHETHER OR NOT SUCH BACKER PLATES OR BLOCKING ARE INDICATED ON DRAWINGS.
- G. WHERE NEW WORK ABUTS, ALIGNS OR ADJOINS EXISTING MATERIALS, MAKE SMOOTH AND EVEN TRANSITION AND ELIMINATE EVIDENCE OF PATCHING AND REFINISHING. FINISH NEW WORK TO MATCH ADJACENT UNDISTURBED SURFACES, UNLESS NOTED OTHERWISE.
- H. CLOSE AND PATCH HOLES AND OPENINGS IN EXISTING FLOOR, WALL AND CEILING WHICH EXIST OR RESULT FROM DEMOLITION OR ALTERATION WORK TO MATCH ADJACENT UNDISTURBED SURFACES.
- I. PRIOR TO CONCEALMENT OF FIRE RESISTIVE MATERIALS BY OTHER WORK, PATCH AND REPAIR AREAS OF REMOVED OR DAMAGED APPLIED FIREPROOFING. COMPLETE PATCHING AND REPAIR TO MAINTAIN EXISTING FIRE-RESISTANCE DESIGN IN ACCORDANCE WITH FIREPROOFING MANUFACTURER'S WRITTEN INSTRUCTIONS FOR CONDITIONS OF EXPOSURE AND INTENDED USE. COORDINATE TESTING AND INSPECTION OF ASSEMBLIES AS REQUIRED BY AUTHORITIES HAVING JURISDICTION.
- J. PROVIDE FIRESTOPPING OF PENETRATIONS AND VOIDS THROUGH FIRE-RATED WALL, FLOOR AND PARTITION ASSEMBLIES (AND ROOF) INCLUDING EMPTY OPENINGS AND OPENINGS CONTAINING CABLES, PIPES, DUCTS, CONDUIT AND OTHER ELEMENTS.
- K. AT SOUND-RATED PARTITION WALLS, PROVIDE CONTINUOUS BEAD OF ACOUSTICAL SEALANT AT JUNCTURE OF BOTH FACES OF RUNNERS OR PLATES WITH FLOOR AND CEILING CONSTRUCTION, AND WHEREVER GYPSUM BOARD ABUTS DISSIMILAR MATERIALS.
 - AT OPENINGS AND CUTOUTS, FILL OPEN SPACES BETWEEN GYPSUM BOARD AND FIXTURES, CABINETS, DUCTS AND OTHER FLUSH OR PENETRATING ITEMS, WITH CONTINUOUS BEAD OF SEALANT.
 - SEAL SIDES AND BACKS OF ELECTRICAL BOXES TO COMPLETELY CLOSE OFF OPENINGS AND JOINTS.
- M. FOR PATCHBACK OF LEAD LINED GYPSUM BOARD, USE A 2" WIDE LEAD RIBBON AT ALL JOINTS.
- N. ROOM CONSTRUCTION SHOULD BE COMPLETED SEQUENTIALLY BEGINNING WITH 1P758, THEN 1P754, THEN 1P752.

KEYNOTES

#	DESCRIPTION
F25	(N) PATIENT CHAIR.
F26	(N) HAND SANITIZER DISPENSER WITH TRAY.
F27	(N) WALL-MOUNTED PAPER TOWEL HOLDER.
F28	(N) WALL-MOUNTED SOAP DISPENSER WITH TRAY.
F29	(N) WALL-MOUNTED LOTION DISPENSER WITH TRAY.
F30	(N) PANIC BUTTON. COORDINATE LOCATION WITH ELECTRICAL PLANS.
F31	(N) ROOM SIGNAGE.
F32	MOBILE (N) CONTROL ROOM CHAIR.
F33	(N) "IN USE" INDICATOR, COORDINATE LOCATION & ELECTRICAL CONNECTION WITH ELECTRICAL PLANS.
F34	(N) TRANSFER BOARD WITH WALL HOLDER.
F35	MOBILE (N) IV POLE 4-HOOK TO BE STORED ELSEWHERE AND BROUGHT IN AS NEEDED.
F36	(N) STEP STOOL.
F37	MOBILE (N) STAIRS FOR STANDING FEET/ANKLE EXAM TO BE STORED ELSEWHERE AND BROUGHT IN AS NEEDED.
F38	MOBILE (N) CHILD IMMOBILIZER TO BE STORED ELSEWHERE AND BROUGHT IN AS NEEDED.
F39	(N) PHONE. COORDINATE POWER & DATA CONNECTIONS WITH ELECTRICAL PLANS.

CONSTRUCTION PLAN LEGEND

SEE A010 FOR ALL GENERAL NOTES, ABBREVIATIONS, AND SYMBOLS

(E) CONSTRUCTION TO REMAIN	(N) CONSTRUCTION	TEMPORARY CONSTRUCTION
——	——	----
——	——	----
——	——	----

EXISTING ASSEMBLY RATING	
0	ZERO HOUR
1	ONE HOUR RATED
2	TWO HOUR RATED
3	THREE HOUR RATED
4	FOUR HOUR RATED

TYPE OF ASSEMBLY	
W	FIRE WALL
B	FIRE BARRIER
P	FIRE PARTITION
E	EXISTING AND RATED
S	SMOKE BARRIER
SP	SMOKE PARTITIONS
ST	RESIST PASSAGE OF SMOKE

EQUIPMENT TAG
SEE EQUIPMENT SCHEDULE AND LEGEND FOR ADDITIONAL INFORMATION

TACTILE EXIT SIGNAGE

HCAI STAMP

INSURANCE HISTORY - THIS SHEET

HGA NO. 1500-148-00

DATE: 08.28.2023

CONSTRUCTION DOCUMENTS

A201



1200 R Street, Suite 100
Sacramento, California 95811
Telephone 916.787.5100

STRUCTURAL ENGINEER

HGA
1200 R ST. SUITE 100
SACRAMENTO, CA 95811
916.787.5100

MECHANICAL/ELECTRICAL/PLUMBING ENGINEER

HGA
1200 R ST. SUITE 100
SACRAMENTO, CA 95811
916.787.5100

INTERIOR ARCHITECT


HGA
1200 R ST. SUITE 100
SACRAMENTO, CA 95811
916.787.5100

UC DAVIS HEALTH

FACILITIES DESIGN & CONSTRUCTION
4800 2nd Avenue Suite 3010
Sacramento, California 95817
(916) 734-7924

9557580
SESP 1P752 - 1P758
X-RAY REPLACEMENT

HCAI # S231373-34-00
HCAI FACILITY ID #: 10619
HCAI STAMP

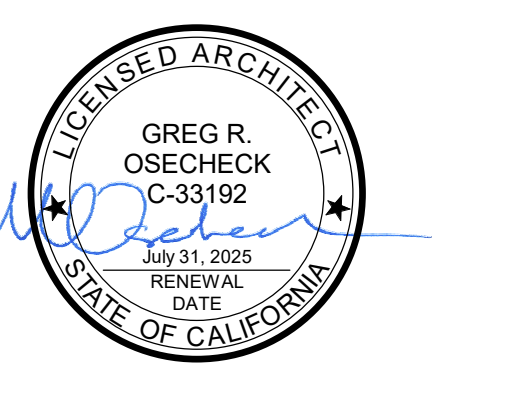

NO	DESCRIPTION	DATE
1	HCAI BACKCHECK RESPONSE 1	11/8/2023
2	HCAI BACKCHECK RESPONSE 2	12/8/2023
3	ACD 01	5/23/2024

DEMO & FLOOR PLAN LEVEL 01

DATE: 08.28.2023
CONSTRUCTION DOCUMENTS

A201

EQUIPMENT SCHEDULE

Table with columns: ROOM NO., EQUIP ID, QTY, SHORT EQUIP NAME, PROVIDED/INSTALLED, MANUF, MODEL, H, D, L, ELECTRICAL PLUG-IN OR HARDWIRED, DATA, COMMENTS. Rows include items like Philips CSM3 Overhead X-Ray Tube, Philips Wall-Mounted Detector & Grid Storage, Philips BuckyDiagnost VS Digital, etc.



1200 R Street, Suite 100
Sacramento, California 95811
Telephone 916.787.5100

STRUCTURAL ENGINEER

HGA
1200 R ST, SUITE 100
SACRAMENTO, CA 95811
916.787.5100

MECHANICAL/ELECTRICAL/
PLUMBING ENGINEER

HGA
1200 R ST, SUITE 100
SACRAMENTO, CA 95811
916.787.5100

INTERIOR ARCHITECT

HGA
1200 R ST, SUITE 100
SACRAMENTO, CA 95811
916.787.5100



FACILITIES DESIGN & CONSTRUCTION
4800 2ND AVENUE SUITE 3010
SACRAMENTO, CALIFORNIA 95817
(916)734-7924

9557580
SESP 1P752 - 1P758
X-RAY REPLACEMENT

HCAI # S231373-34-00
HCAI FACILITY ID #: 10619
HCAI STAMP




Table with columns: NO, DESCRIPTION, DATE. Row 1: 3, ACD 01, 5/23/2024

HGA NO. 1500-148-00

EQUIPMENT SCHEDULE


DATE: 08.28.2023

CONSTRUCTION DOCUMENTS

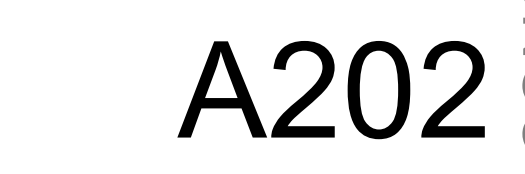


HCAI STAMP


BRIDGING IS REQUIRED AT 4'-0" VERTICALLY OC MAX WHERE SHEATHING DOES NOT OCCUR ON BOTH SIDES OF STUDS & @ PARTIAL HEIGHT WALL SHEATHING CONDITIONS WHERE DISTANCE BTW TOP OF SHTG & TOP OF WALL STUD IS GREATER THAN 3'-6". SEE DETAILS OR 1662

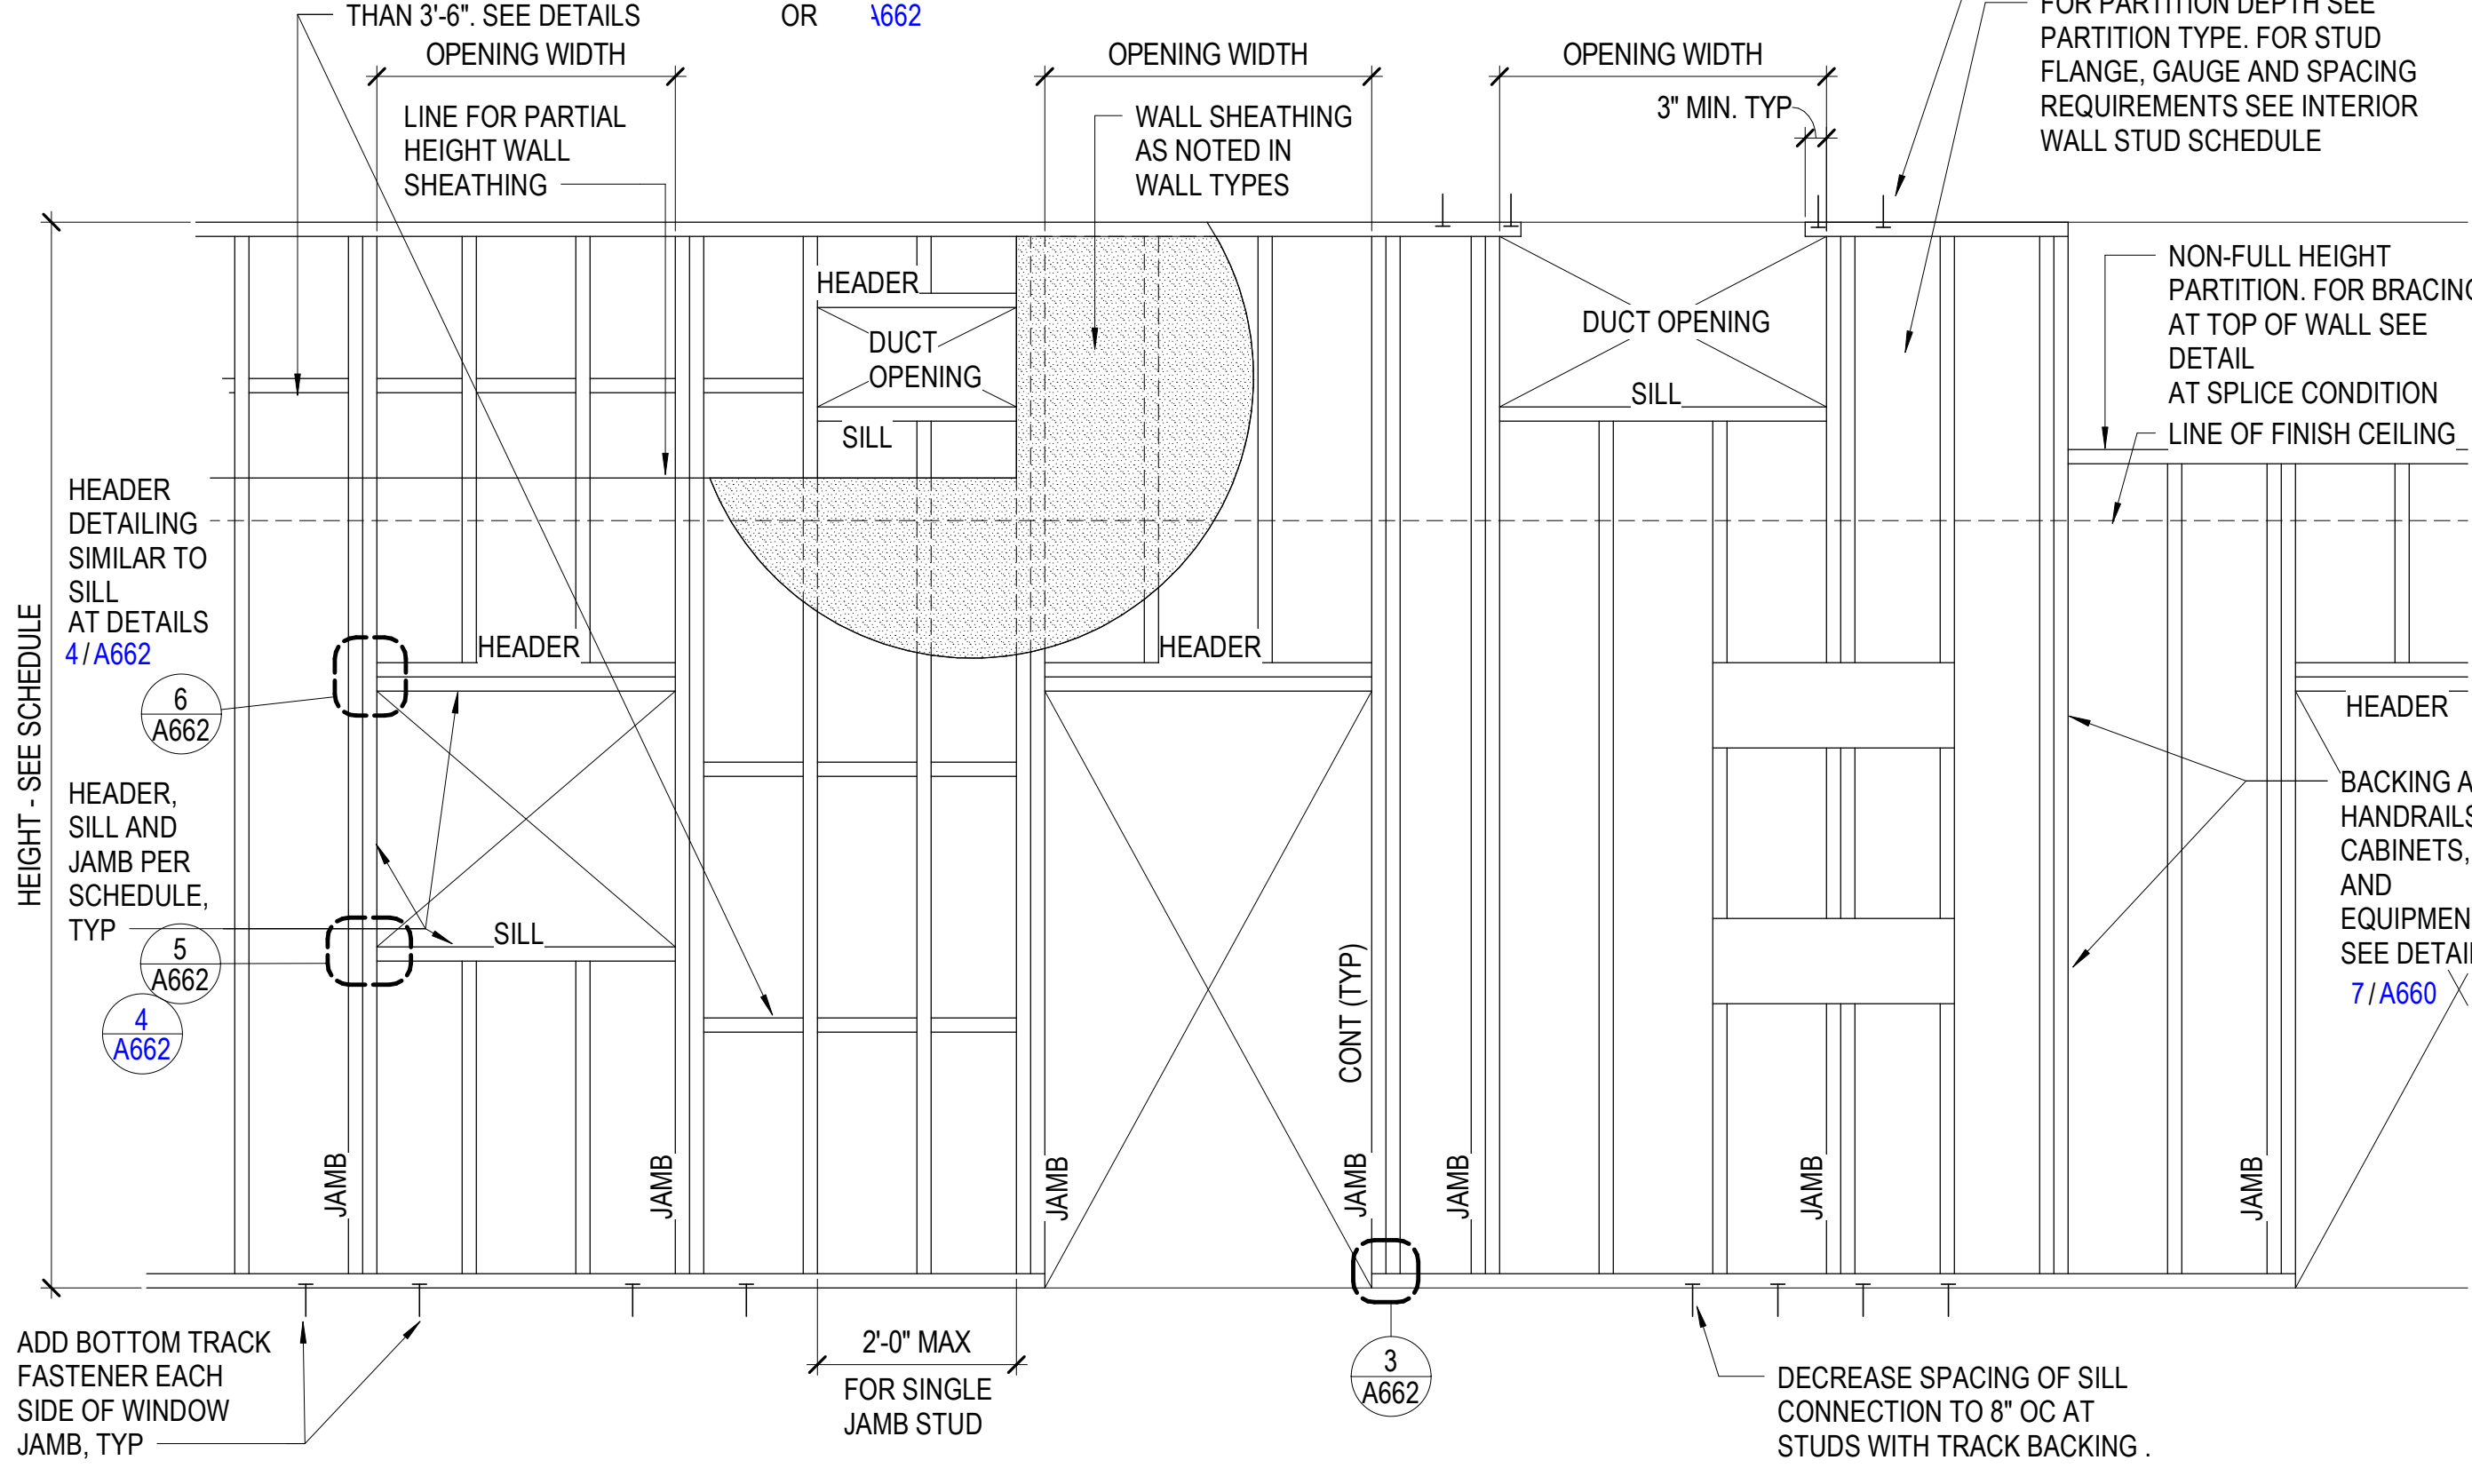


1 TYPICAL FRAMING ELEVATION
1/2" = 1'-0"

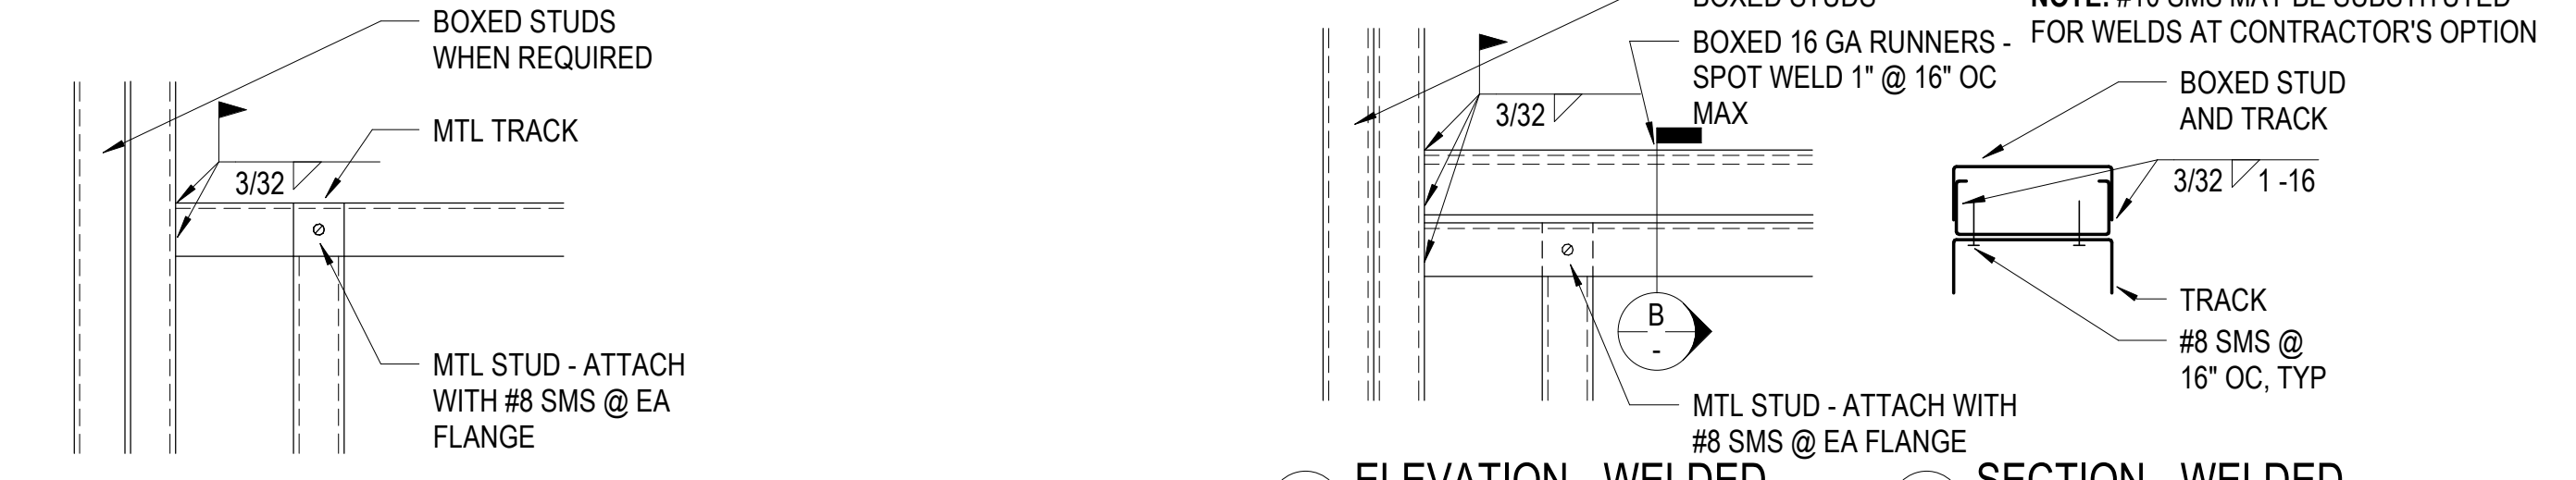


2 INTERIOR WALL OPENING FRAMING SCHEDULE
1/2" = 1'-0"

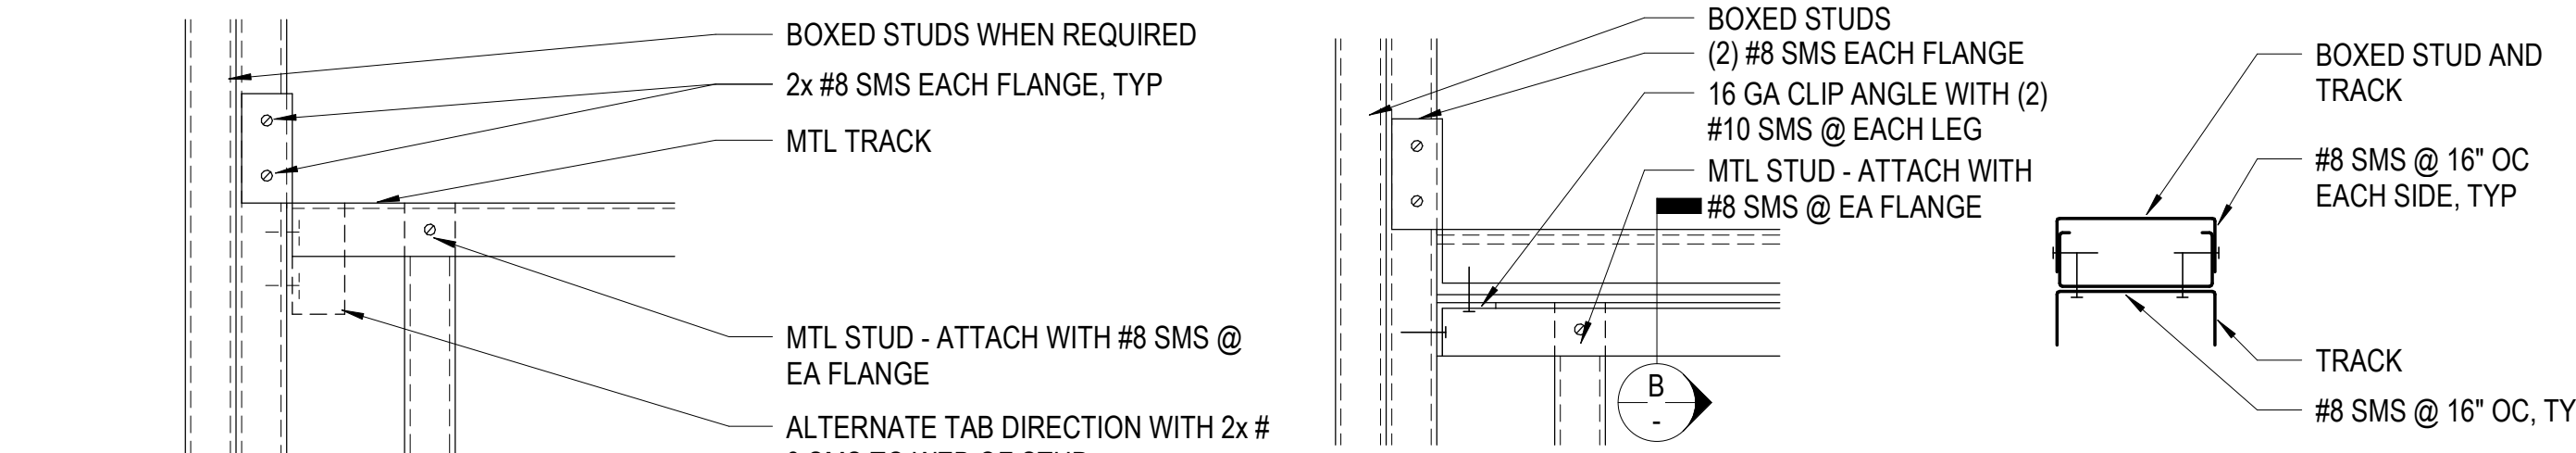


3 JAMB DETAIL
3" = 1'-0"

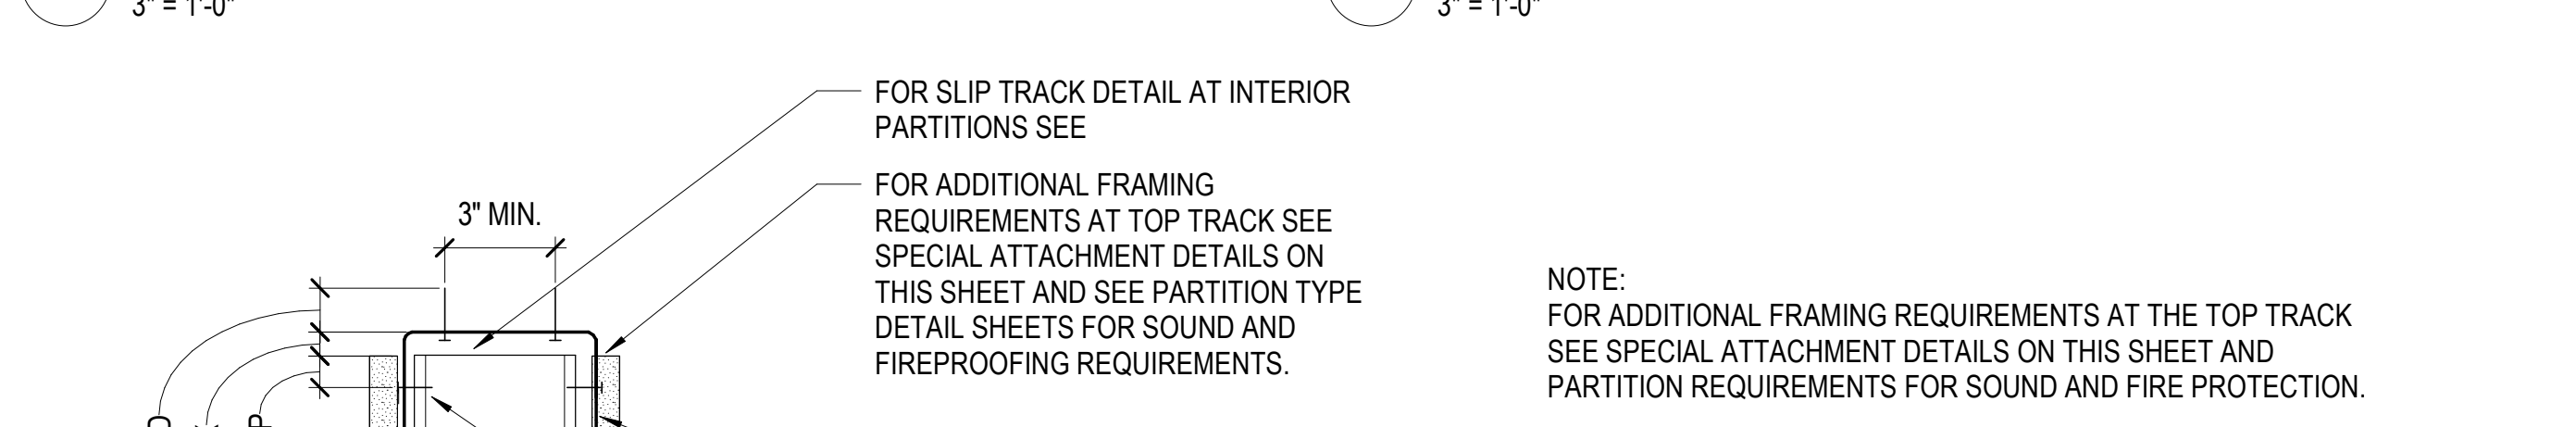

4 ELEVATION - WELDED
FOR 16 GA AND HEAVIER

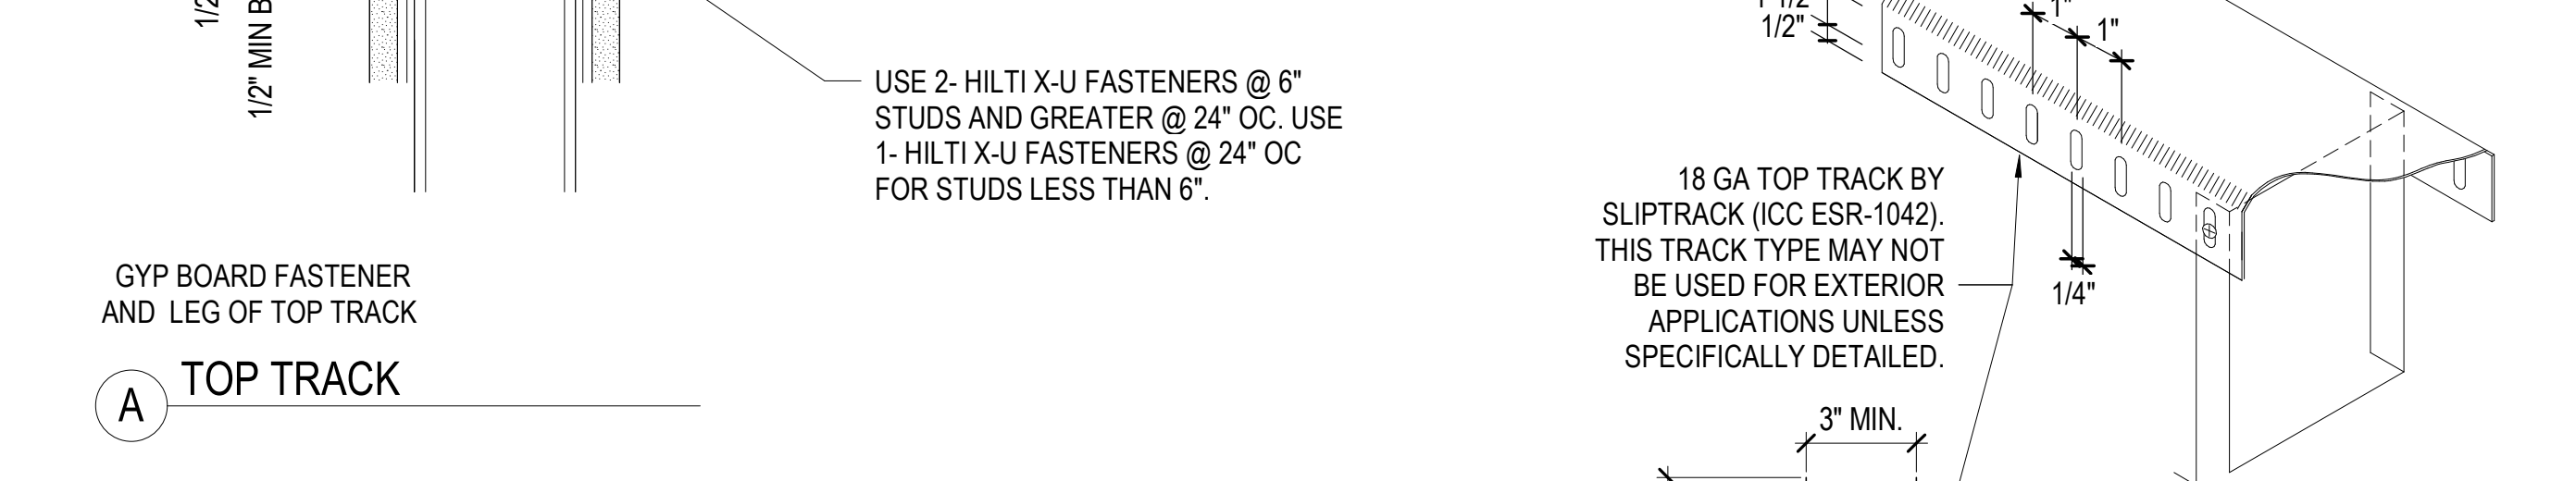

5 ELEVATION - WELDED
FOR 16 GA AND HEAVIER

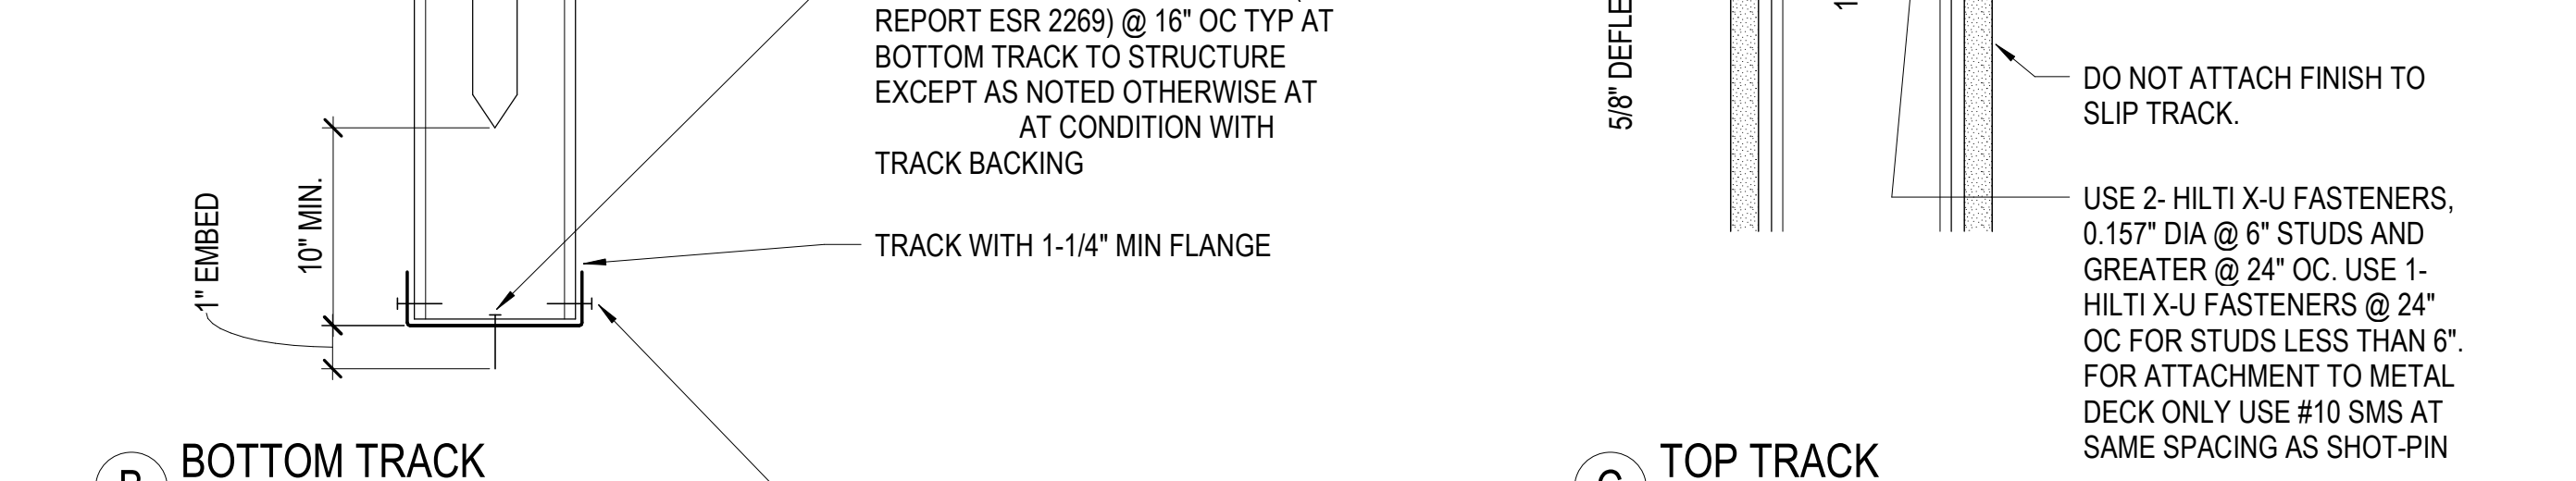

6 ELEVATION - WELDED
FOR 16 GA AND HEAVIER




7 STUD TO TRACK CONNECTION
3" = 1'-0"


MAX OPNG	MIN STUD DEPTH	MAX WALL HEIGHT	JAMB			ALTERNATE JAMB SECTION	HEADER			SILL		
			DETAIL NO	MIN STUD SIZE	SECTION		DETAIL NO	MIN STUD SIZE	SECTION	DETAIL NO	MIN STUD SIZE	SECTION
2'-10"	3 5/8"	15'-6"	3/A662	362S162-33		4/A662	NONE		4/A662	NONE		
3'-6"	3 5/8"	15'-6"	3/A662	362S162-43		4/A662	NONE		4/A662	NONE		
5'-6"	3 5/8"	15'-6"	3/A662	(2)-362S162-54		362S200-43	5/A662	362S162-43	5/A662	362S162-43		
10'-0"	3 5/8"	15'-6"	3/A662	(2)-362S162-54		362S200-43	6/A662	(2) 600S162-43 (3) 362T150-43	5/A662	362S162-43	(2) 362T150-43	

NOTES:
1. FOR STUD PROPERTIES SEE DETAIL 9/A662 INTERIOR WALL STUD SCHEDULE
2. AT HEADER AND SILL ASSEMBLIES USE SECTIONS WITH NO MFR PUNCHED OPENINGS


2 INTERIOR WALL OPENING FRAMING SCHEDULE
1/2" = 1'-0"

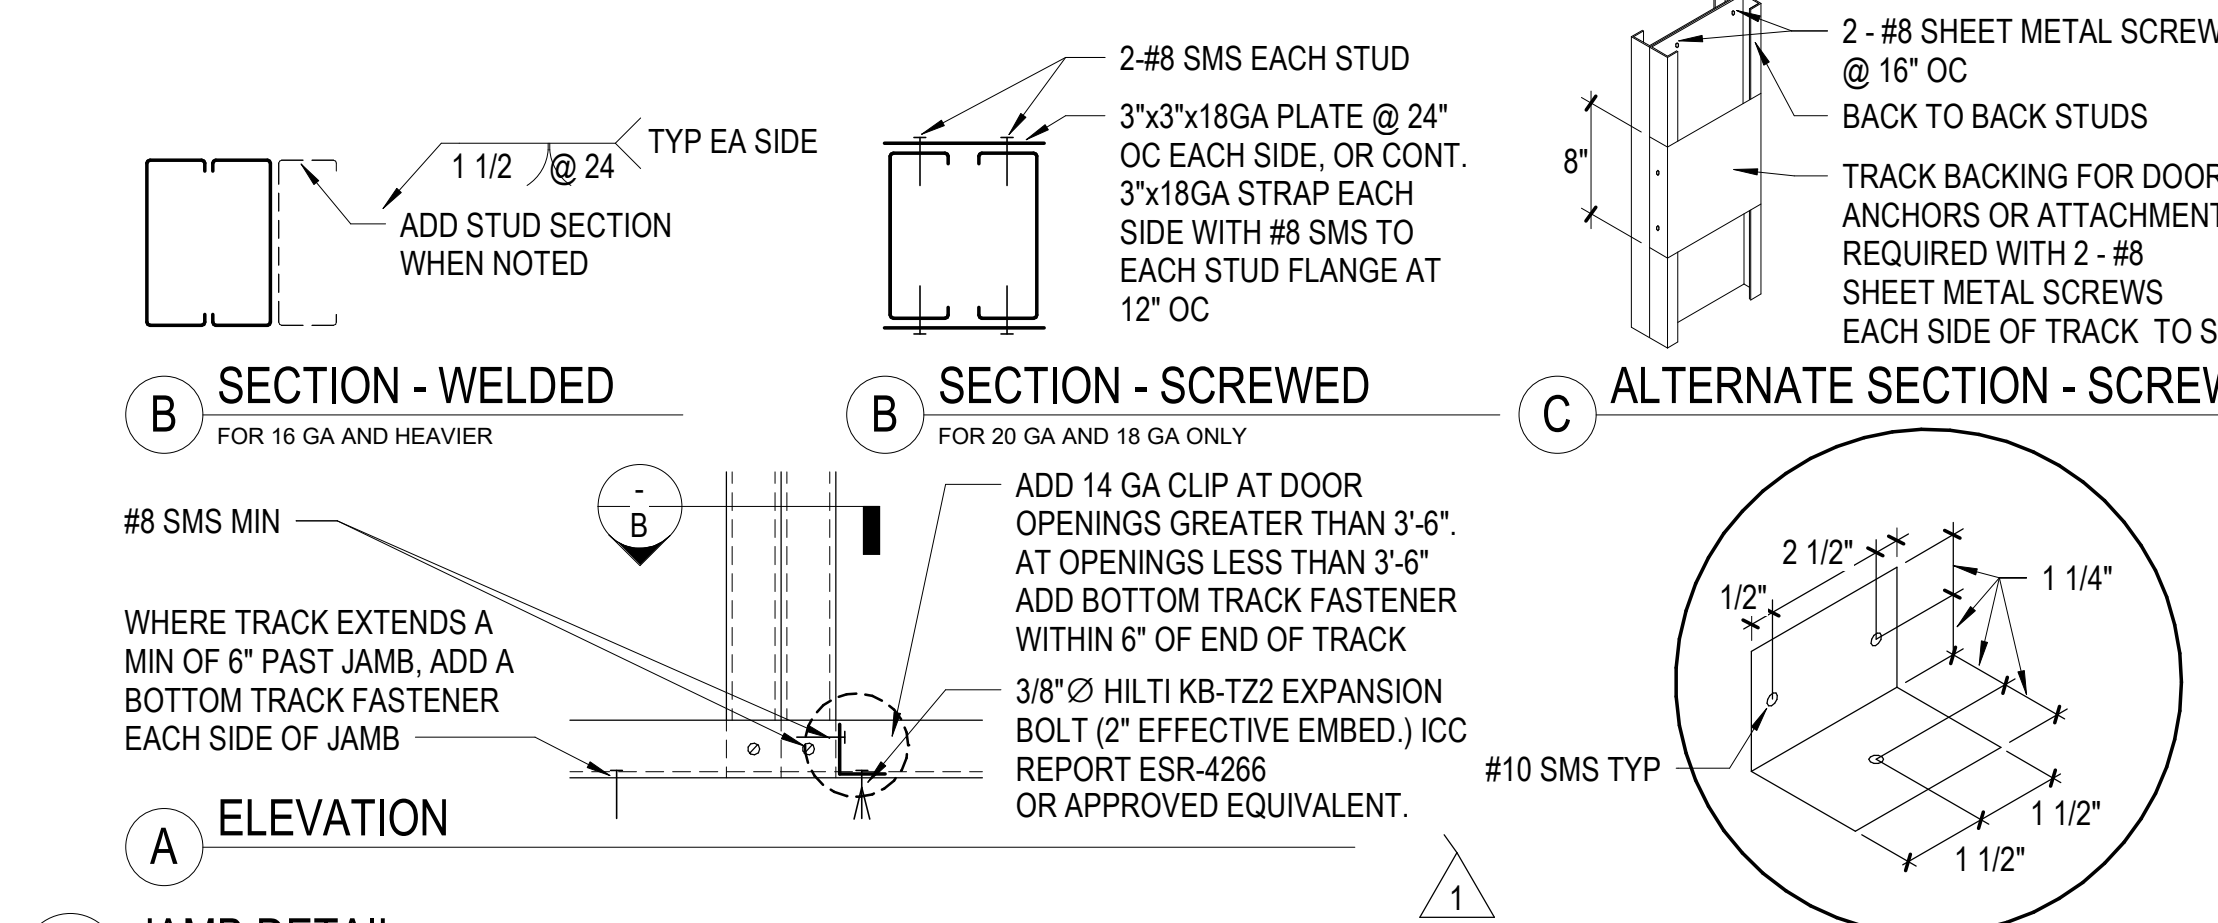


3 ELEVATION - WELDED
FOR 16 GA AND HEAVIER

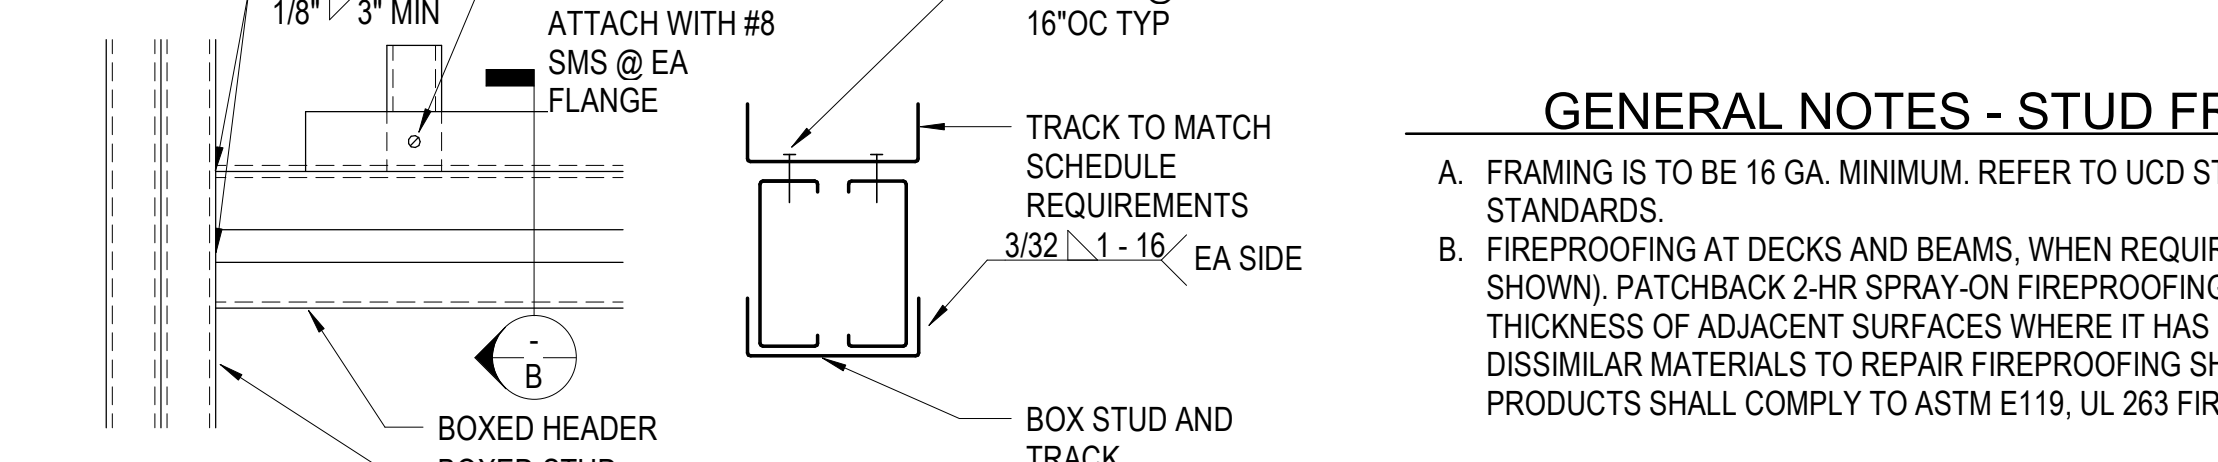


4 ELEVATION - WELDED
FOR 16 GA AND HEAVIER

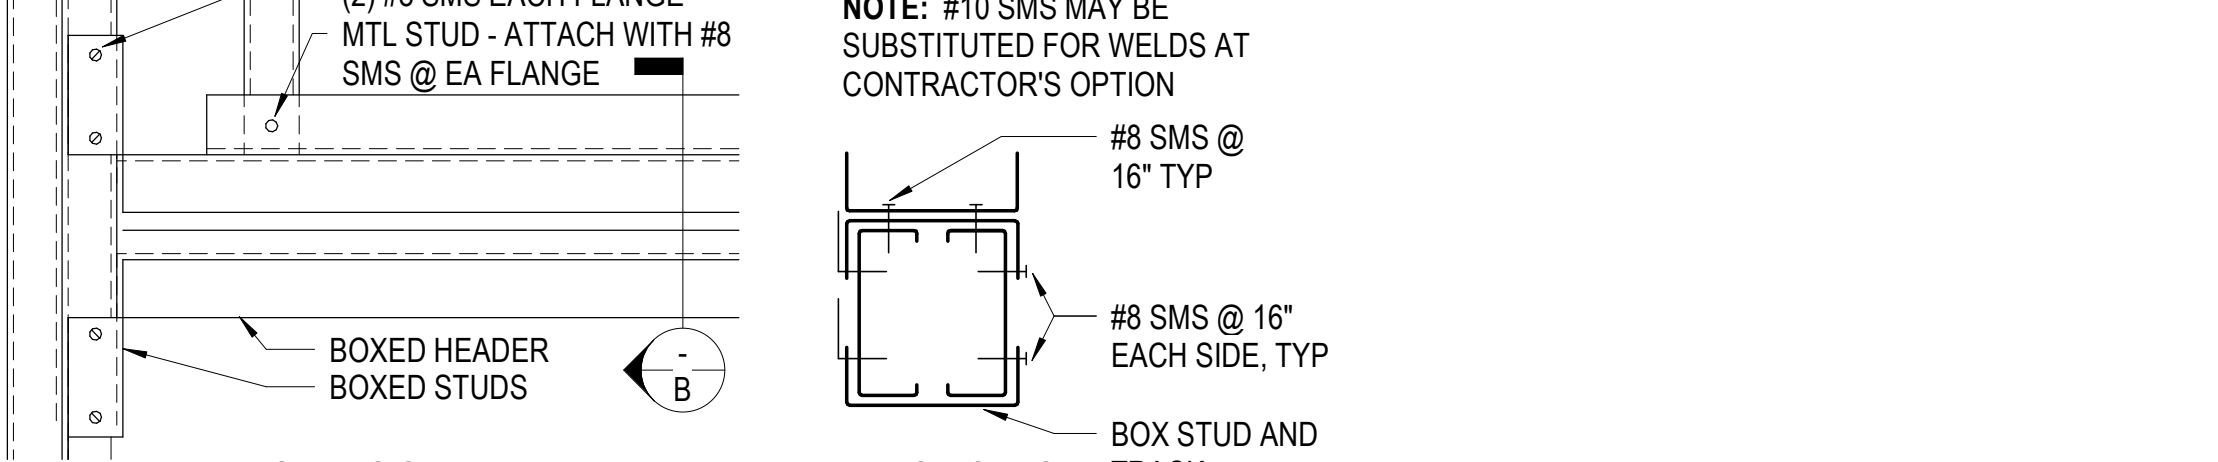

5 ELEVATION - WELDED
FOR 16 GA AND HEAVIER

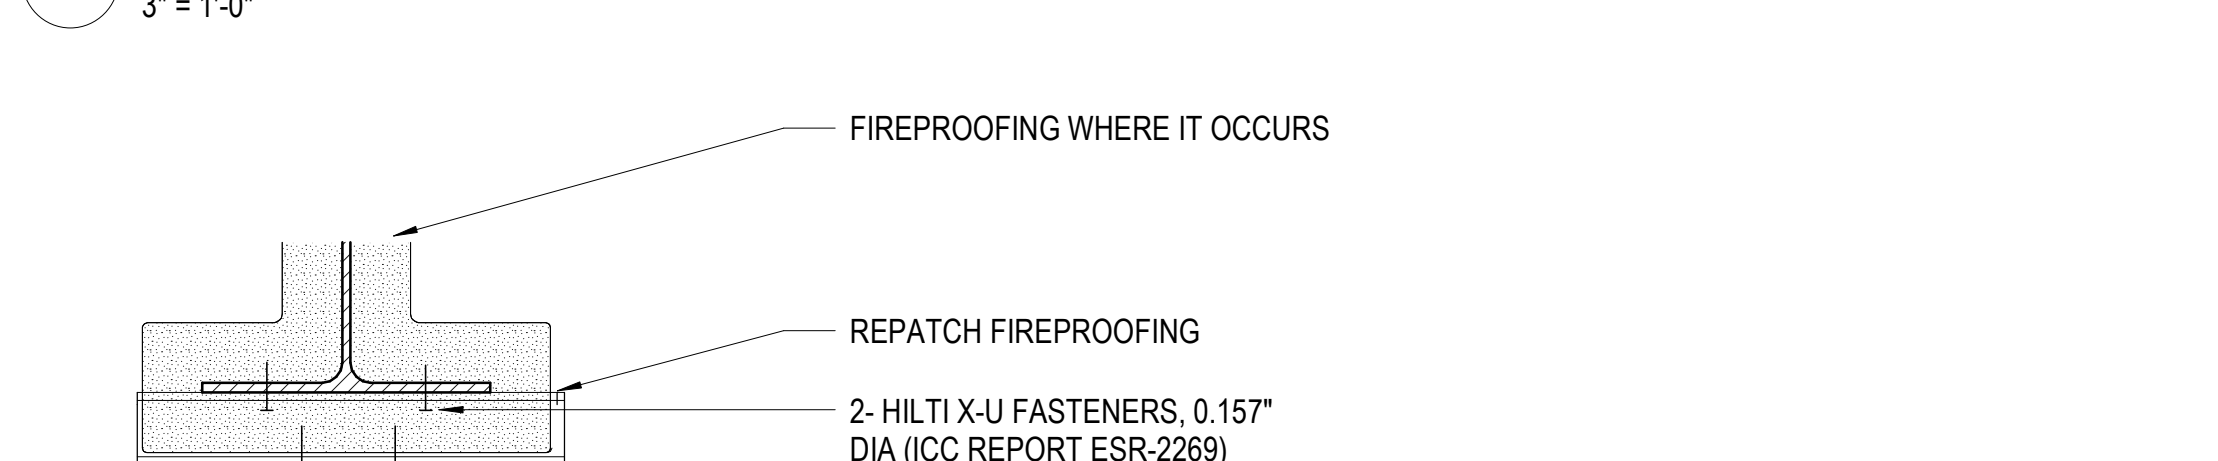


6 ELEVATION - WELDED
FOR 16 GA AND HEAVIER

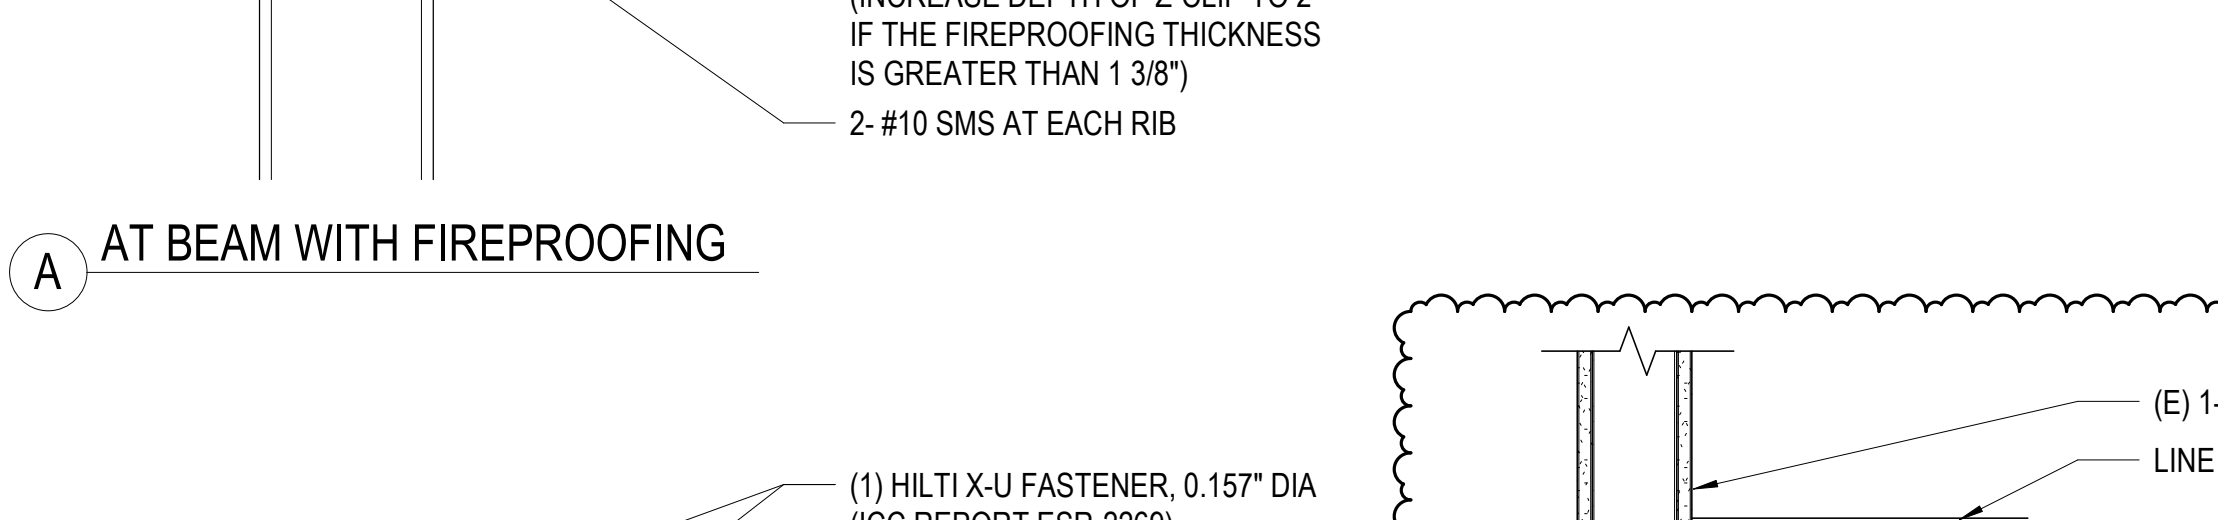

7 ELEVATION - WELDED
FOR 16 GA AND HEAVIER



8 ELEVATION - WELDED
FOR 16 GA AND HEAVIER

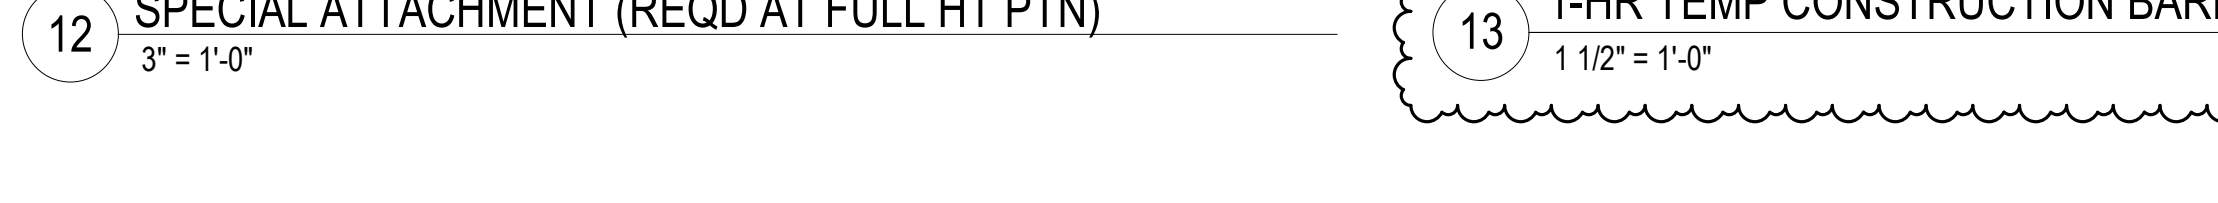


9 ELEVATION - WELDED
FOR 16 GA AND HEAVIER


STUD SECTION	SPACING	MAX HEIGHT	DEFLECTION LIMITS (1),(2)	
			COND. 1	COND. 2
250S162-54	16" OC	15'-6"	L/180	NA
362S162-33	16" OC	15'-6"	L/180	NA
362S162-43	16" OC	15'-6"	L/240	L/240
362S162-43	16" OC	20'-0"	L/180	NA
600S162-33	16" OC	20'-0"	L/240	L/240
600S162-43	16" OC	30'-0"	L/180	NA
800S162-43	16" OC	35'-0"	L/240	L/240

NOTES:
1. THE STUD CAPACITIES AND DEFLECTIONS ARE BASED ON THE FOLLOWING LOADING CONDITIONS: (NA IN SCHEDULE INDICATES STUD SECTION IS "NOT APPLICABLE" FOR LOADING CONDITION)
COND. 1: BASED ON THE FOLLOWING THREE LOAD COMBINATIONS
UNIFORM LOAD= 5psf FOR MINIMUM LOADS
SEISMIC LOAD IS BASED ON WALL WITH TWO LAYERS OF GYP BOARD EACH SIDE WITH Sds=0.498 and Ip=1.5 WHICH INCLUDES A 100 PLF CABINET WEIGHT AND A 200LB CEILING BRACING WIRE LOAD AT 10 FEET SHARED BETWEEN TWO STUDS. SEE STRUCTURAL PLANS FOR ADDITIONAL INFORMATION.
200 POUND HANDRAIL LOAD APPLIED 36-INCHES ABOVE THE FLOOR. DEFLECTION MAY SLIGHTLY EXCEED LISTED DEFLECTION LIMIT ON THE ASSUMPTION THAT ALL OF THE HANDRAIL LOAD WILL NOT BE RESISTED BY ONE STUD. FOR SEISMIC LOADING DEFLECTION LIMIT IS L/120
COND. 2: 250 POUND GRAB BAR LOAD APPLIED 36-INCHES ABOVE THE FLOOR. DEFLECTION MAY SLIGHTLY EXCEED LISTED DEFLECTION LIMIT ON THE ASSUMPTION THAT ALL OF THE GRAB BAR LOAD WILL NOT BE RESISTED BY ONE STUD.


2 INTERIOR WALL STUD SCHEDULE
1/2" = 1'-0"

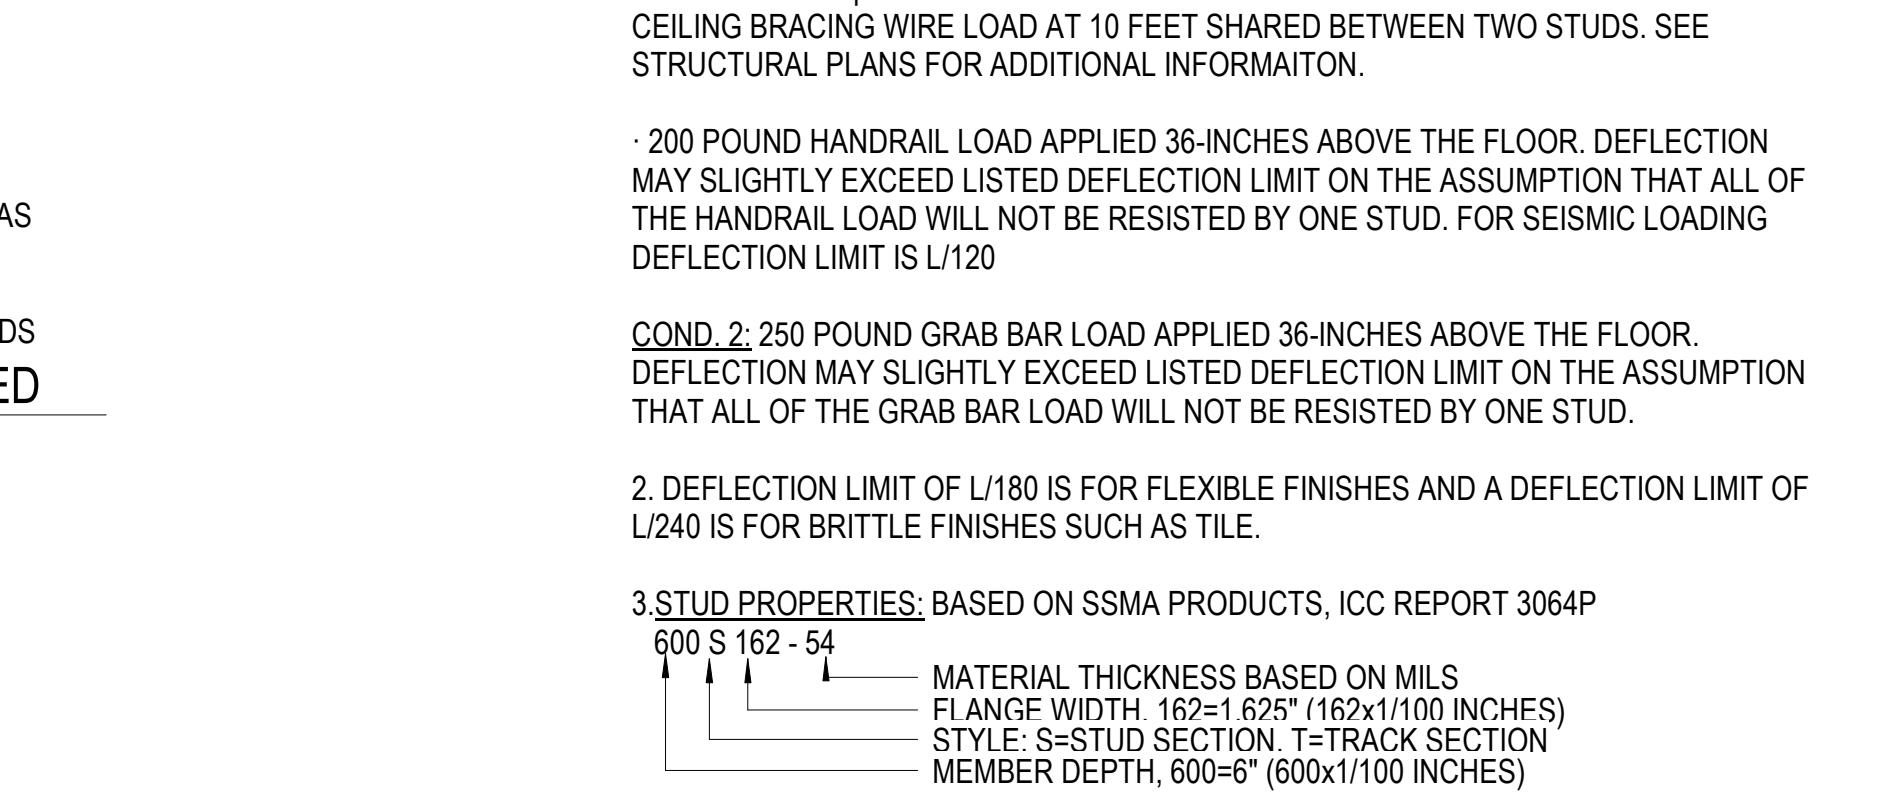


3 DESIGN THICKNESS AND DESIGN STIFFENED LIP

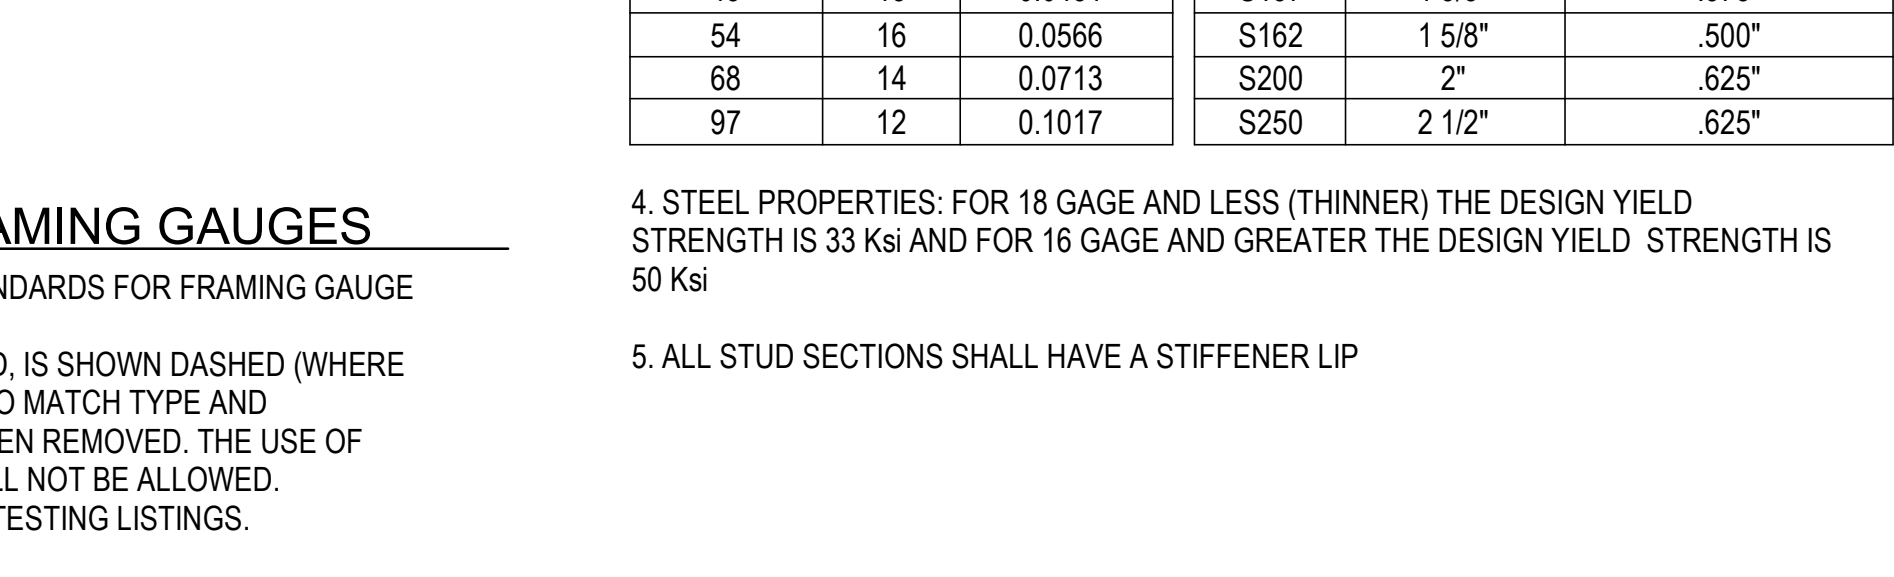


4 STEEL PROPERTIES FOR 18 GAGE AND LESS (THINNER)

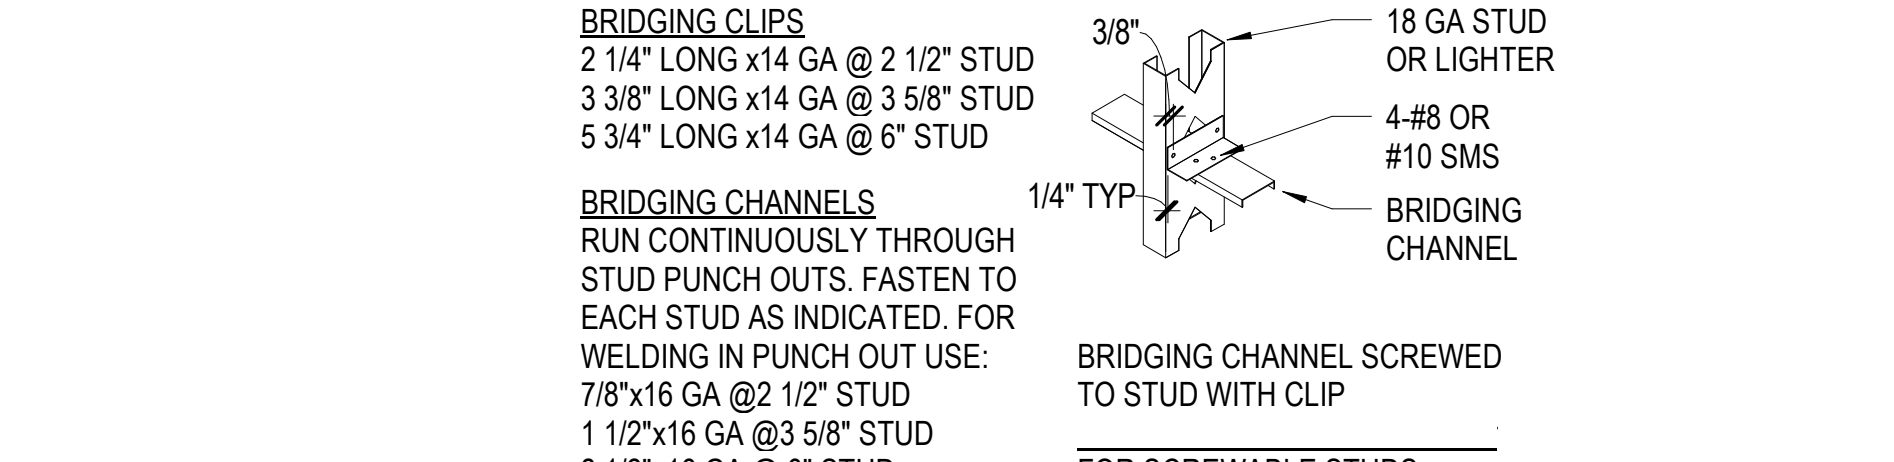


5 INTERIOR WALL STUD FRAMING SCHEDULE
1/2" = 1'-0"

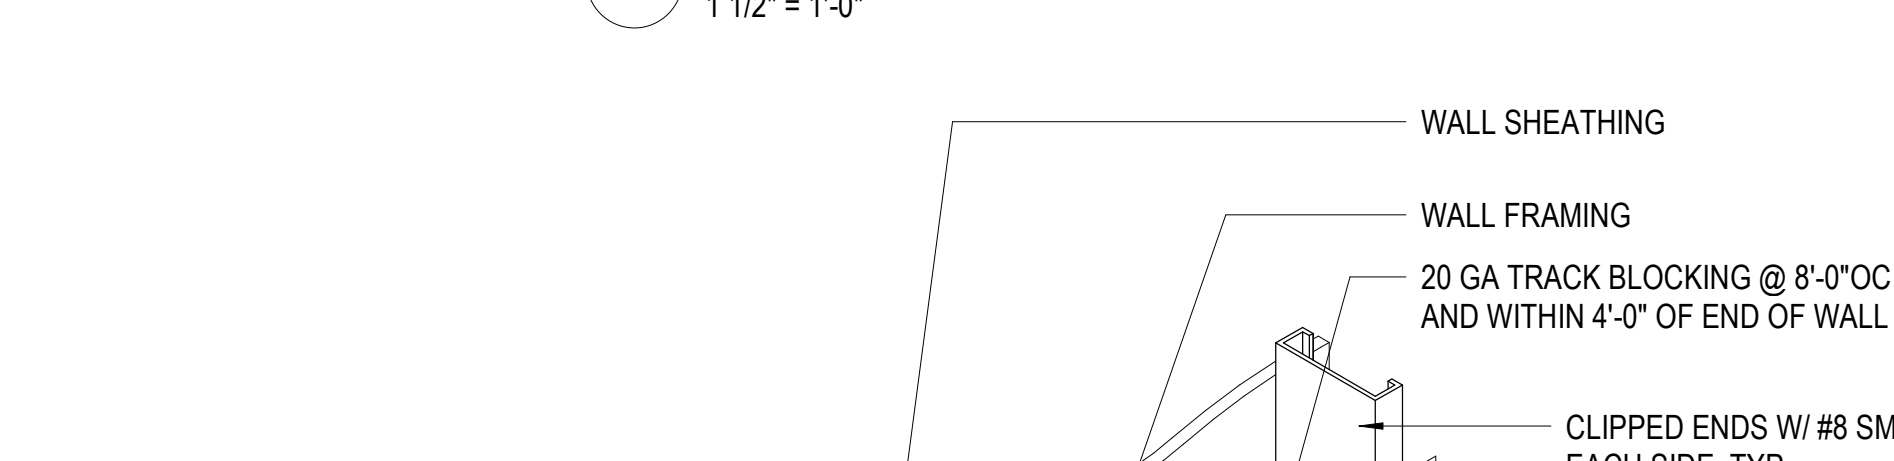

6 TYPICAL BRIDGING ATTACHMENT
1/2" = 1'-0"

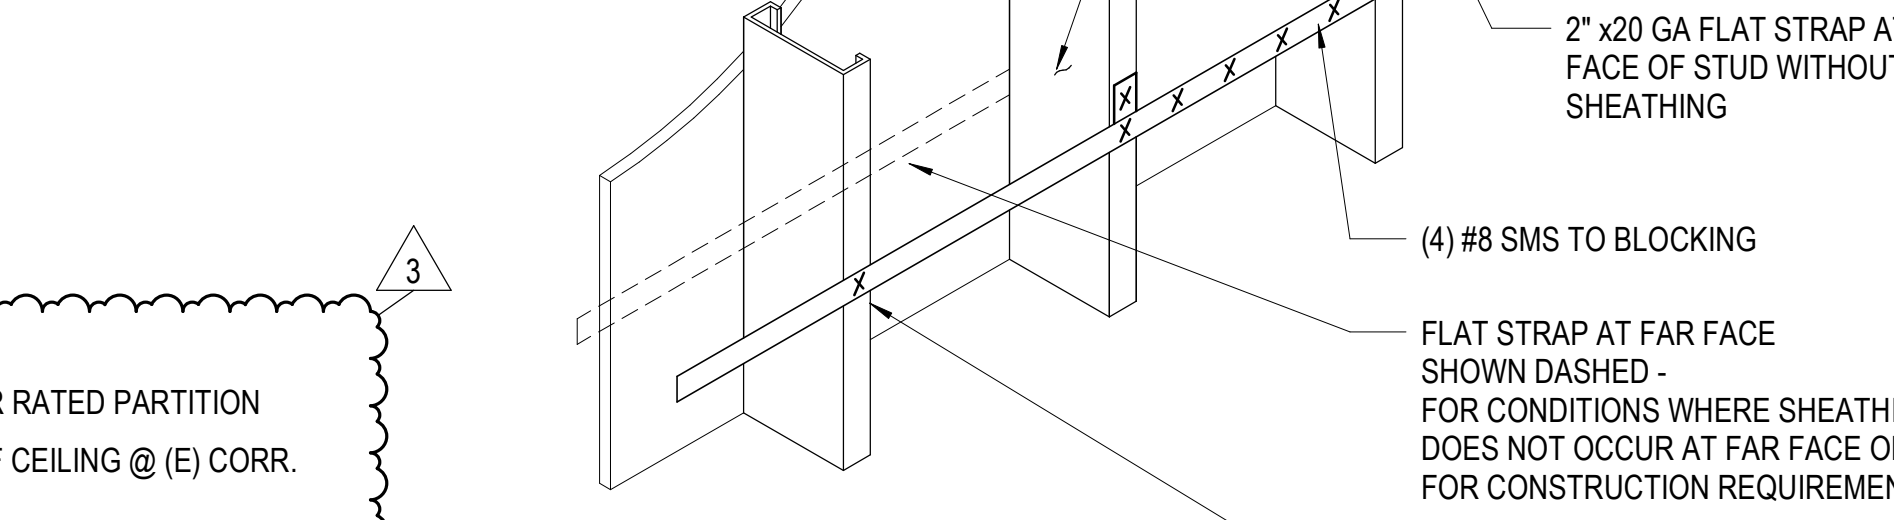

7 AT BEAM WITH FIREPROOFING

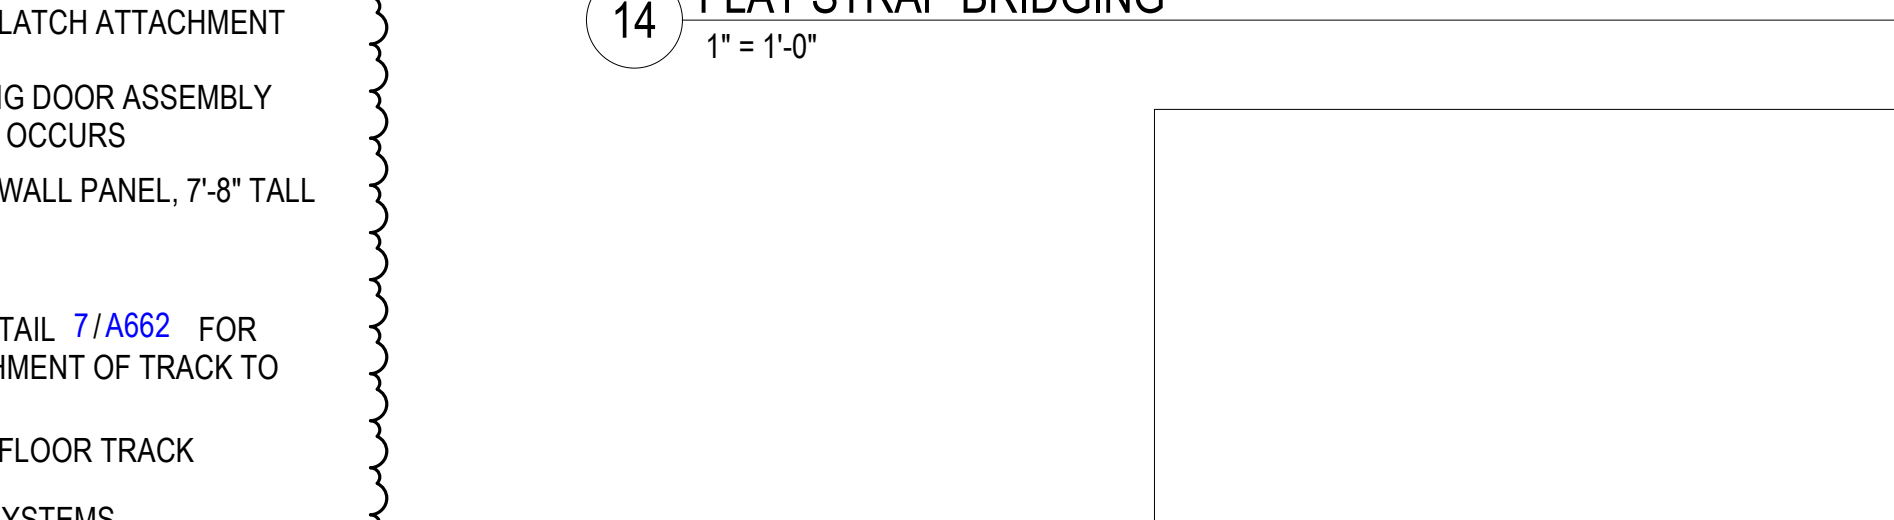

8 BETWEEN DECK RIBS



9 1-HR TEMP CONSTRUCTION BARRIER - STARC
1 1/2" = 1'-0"

STRUCTURAL ENGINEER
HGA
1200 R ST. SUITE 100
SACRAMENTO, CA 95811
916.787.5100

MECHANICAL/ELECTRICAL/
PLUMBING ENGINEER
HGA
1200 R ST. SUITE 100
SACRAMENTO, CA 95811
916.787.5100

INTERIOR ARCHITECT
HGA
1200 R ST. SUITE 100
SACRAMENTO, CA 95811
916.787.5100

UC DAVIS HEALTH
FACILITIES DESIGN & CONSTRUCTION
4800 2ND AVENUE SUITE 3010
SACRAMENTO, CALIFORNIA 95817
(916)734-7924

9557580
SESP 1P752 - 1P758
X-RAY REPLACEMENT

HCAI # S231373-34-00
HCAI FACILITY ID #: 10619
HCAI STAMP

LICENSED ARCHITECT
GREG R. OSBACH
C-33192
RENEWAL DATE: 08/31/2025
STATE OF CALIFORNIA

NO	DESCRIPTION	DATE
1	HCAI BACKCHECK RESPONSE 1	11/8/2023
3	ACD 01	5/23/2024

ISSUANCE HISTORY - THIS SHEET
HGA NO: 1500-148-00

INTERIOR METAL STUD FRAMING DETAILS
DATE: 08.28.2023
CONSTRUCTION DOCUMENTS

A662

METAL SUSPENSION SYSTEMS NOTES



1200 R Street, Suite 100
Sacramento, California 95811
Telephone 916.787.5100

STRUCTURAL ENGINEER

HGA
1200 R ST, SUITE 100
SACRAMENTO, CA 95811
916.787.5100

MECHANICAL/ELECTRICAL/
PLUMBING ENGINEER

HGA
1200 R ST, SUITE 100
SACRAMENTO, CA 95811
916.787.5100

INTERIOR ARCHITECT


HGA
1200 R ST, SUITE 100
SACRAMENTO, CA 95811
916.787.5100



FACILITIES DESIGN & CONSTRUCTION
4800 2ND AVENUE SUITE 3010
SACRAMENTO, CALIFORNIA 95817
916.787.2924

9557580
SESP 1P752 - 1P758
X-RAY REPLACEMENT

HCAI # S231373-34-00
HCAI FACILITY ID # 10619
HCAI STAMP

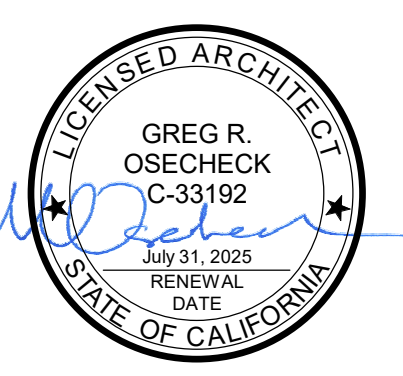














NO	DESCRIPTION	DATE
1	HCAI BACKCHECK RESPONSE 1	11/8/2023
3	ACD 01	5/23/2024

HGA NO. 1500-148-00

CEILING DETAILS

DATE: 08.28.2023

CONSTRUCTION DOCUMENTS

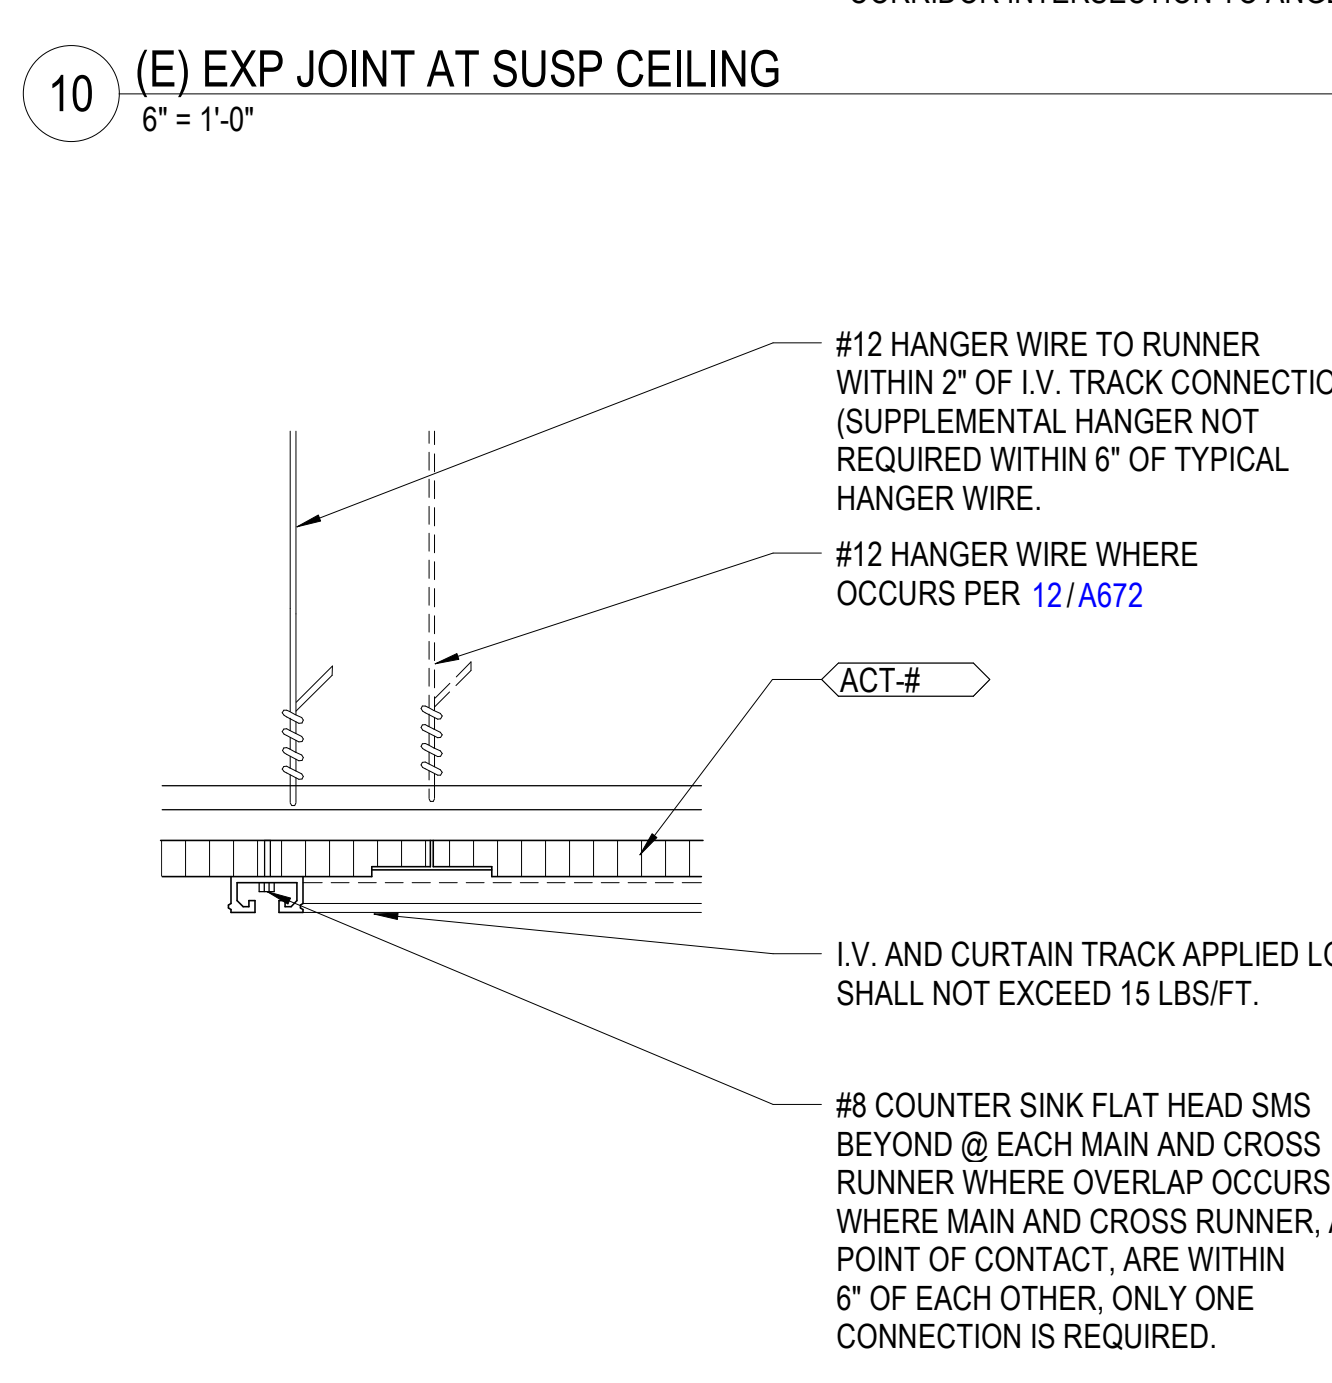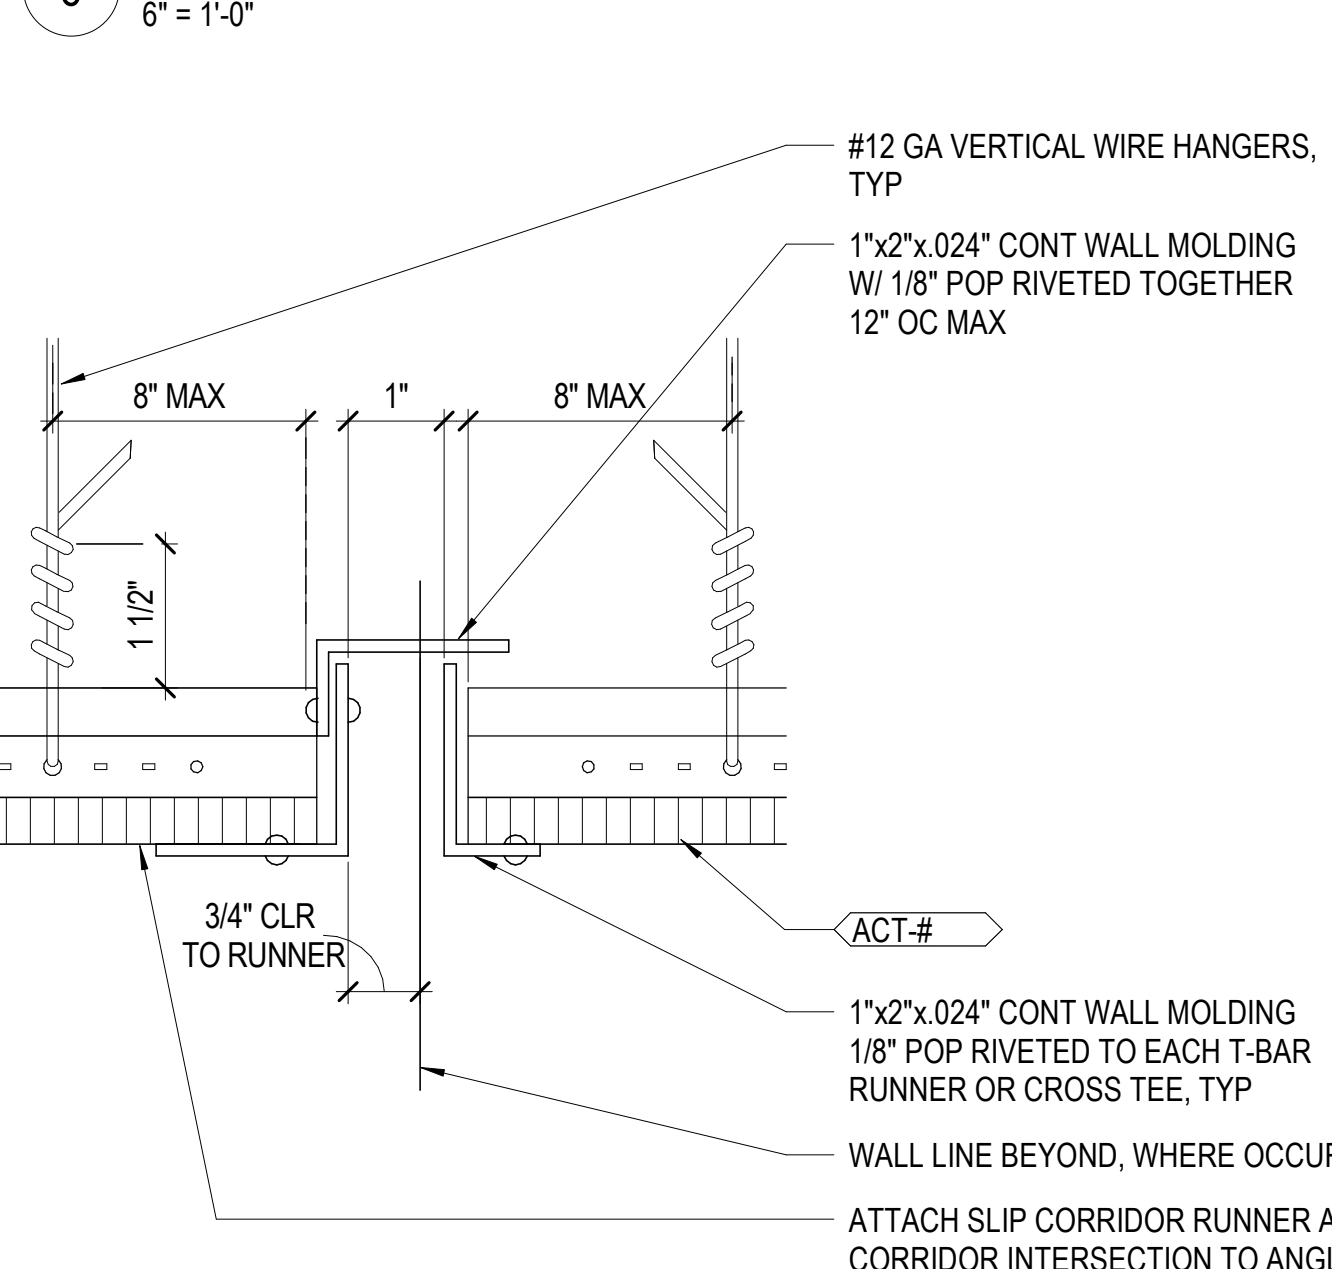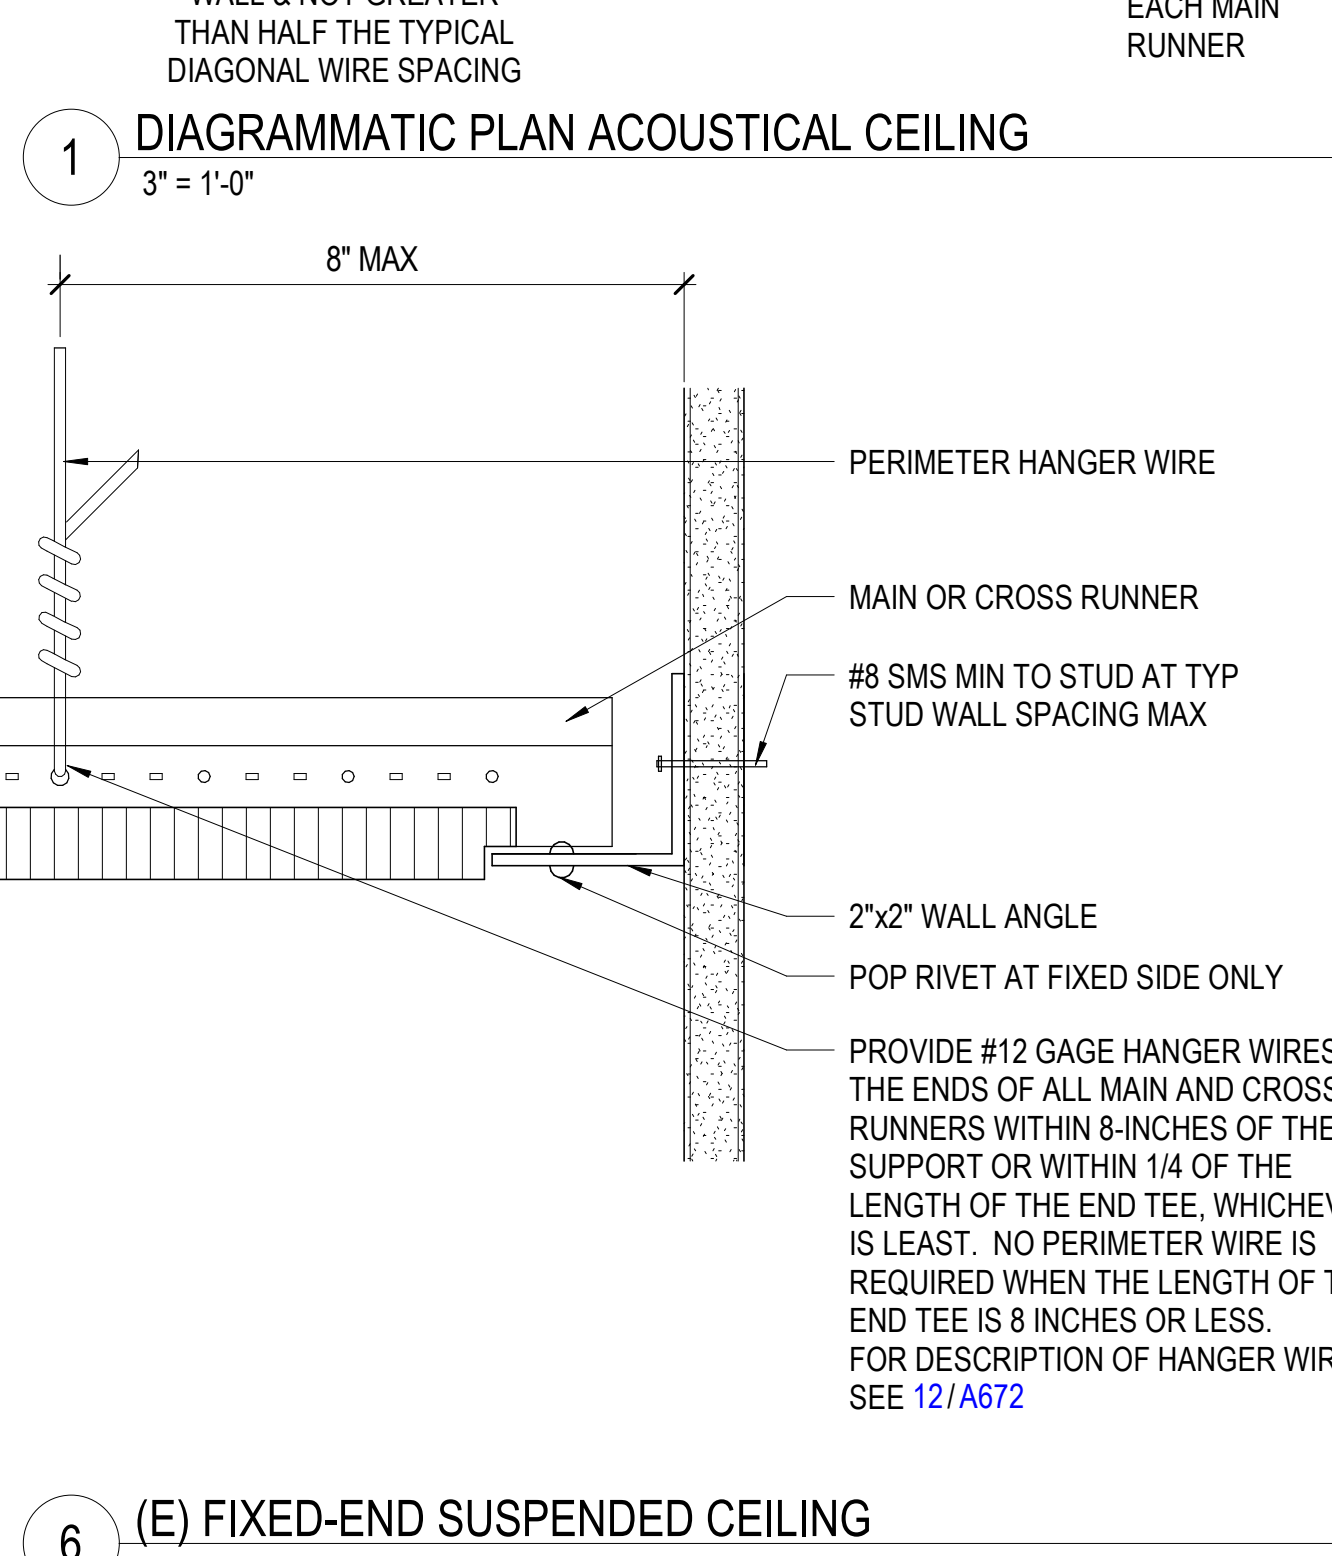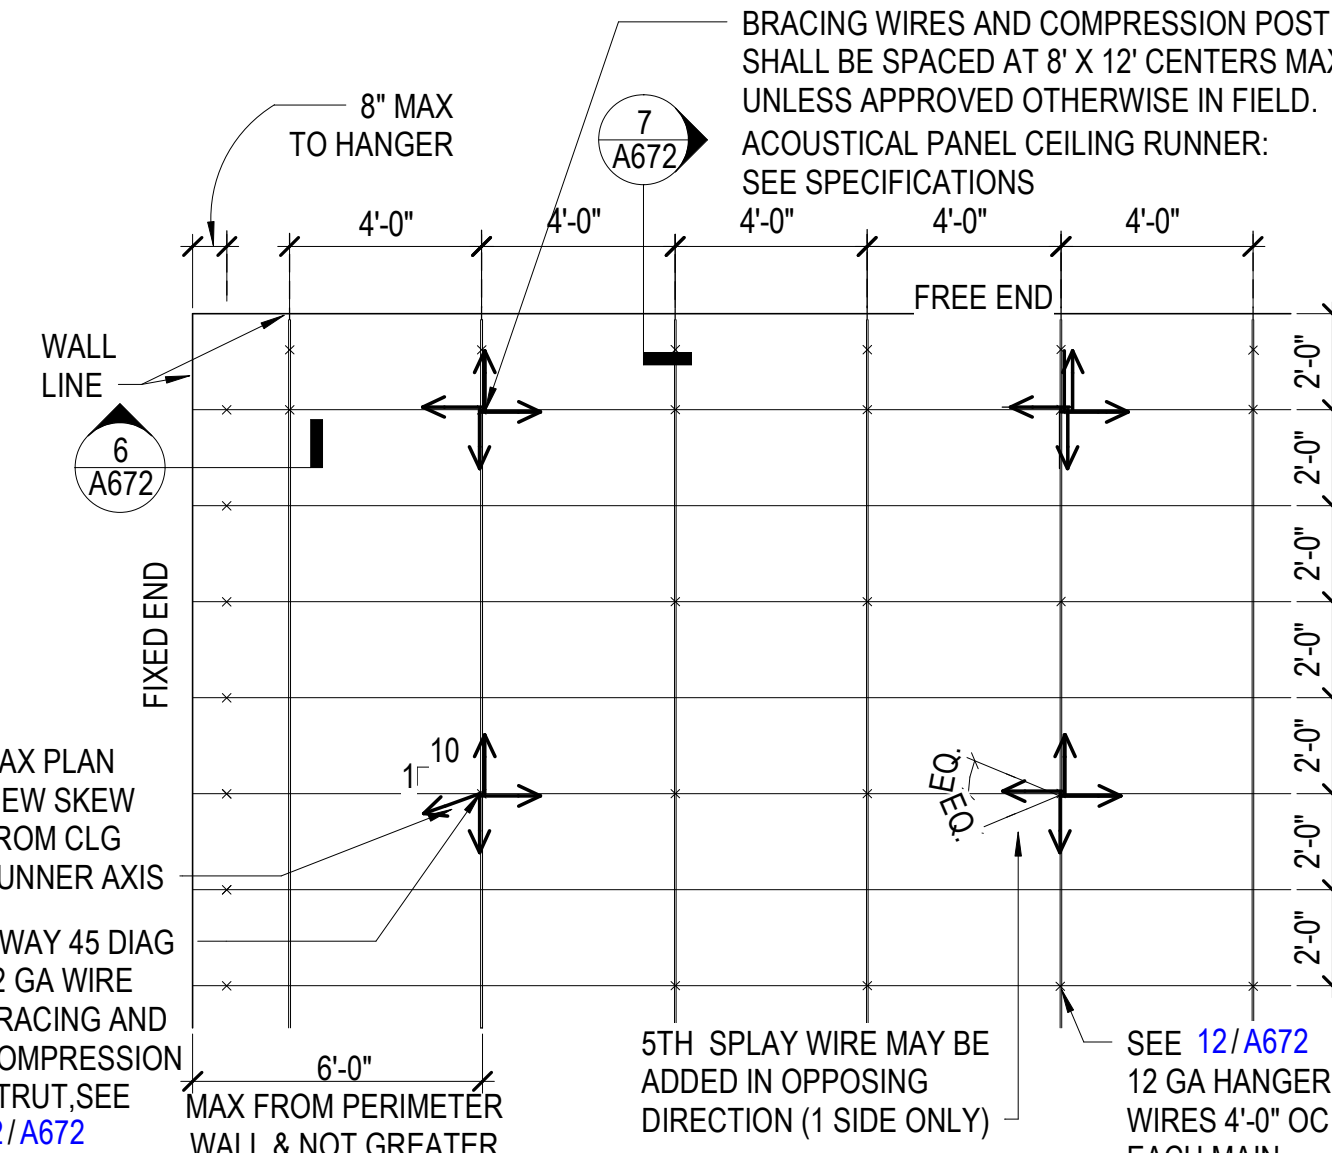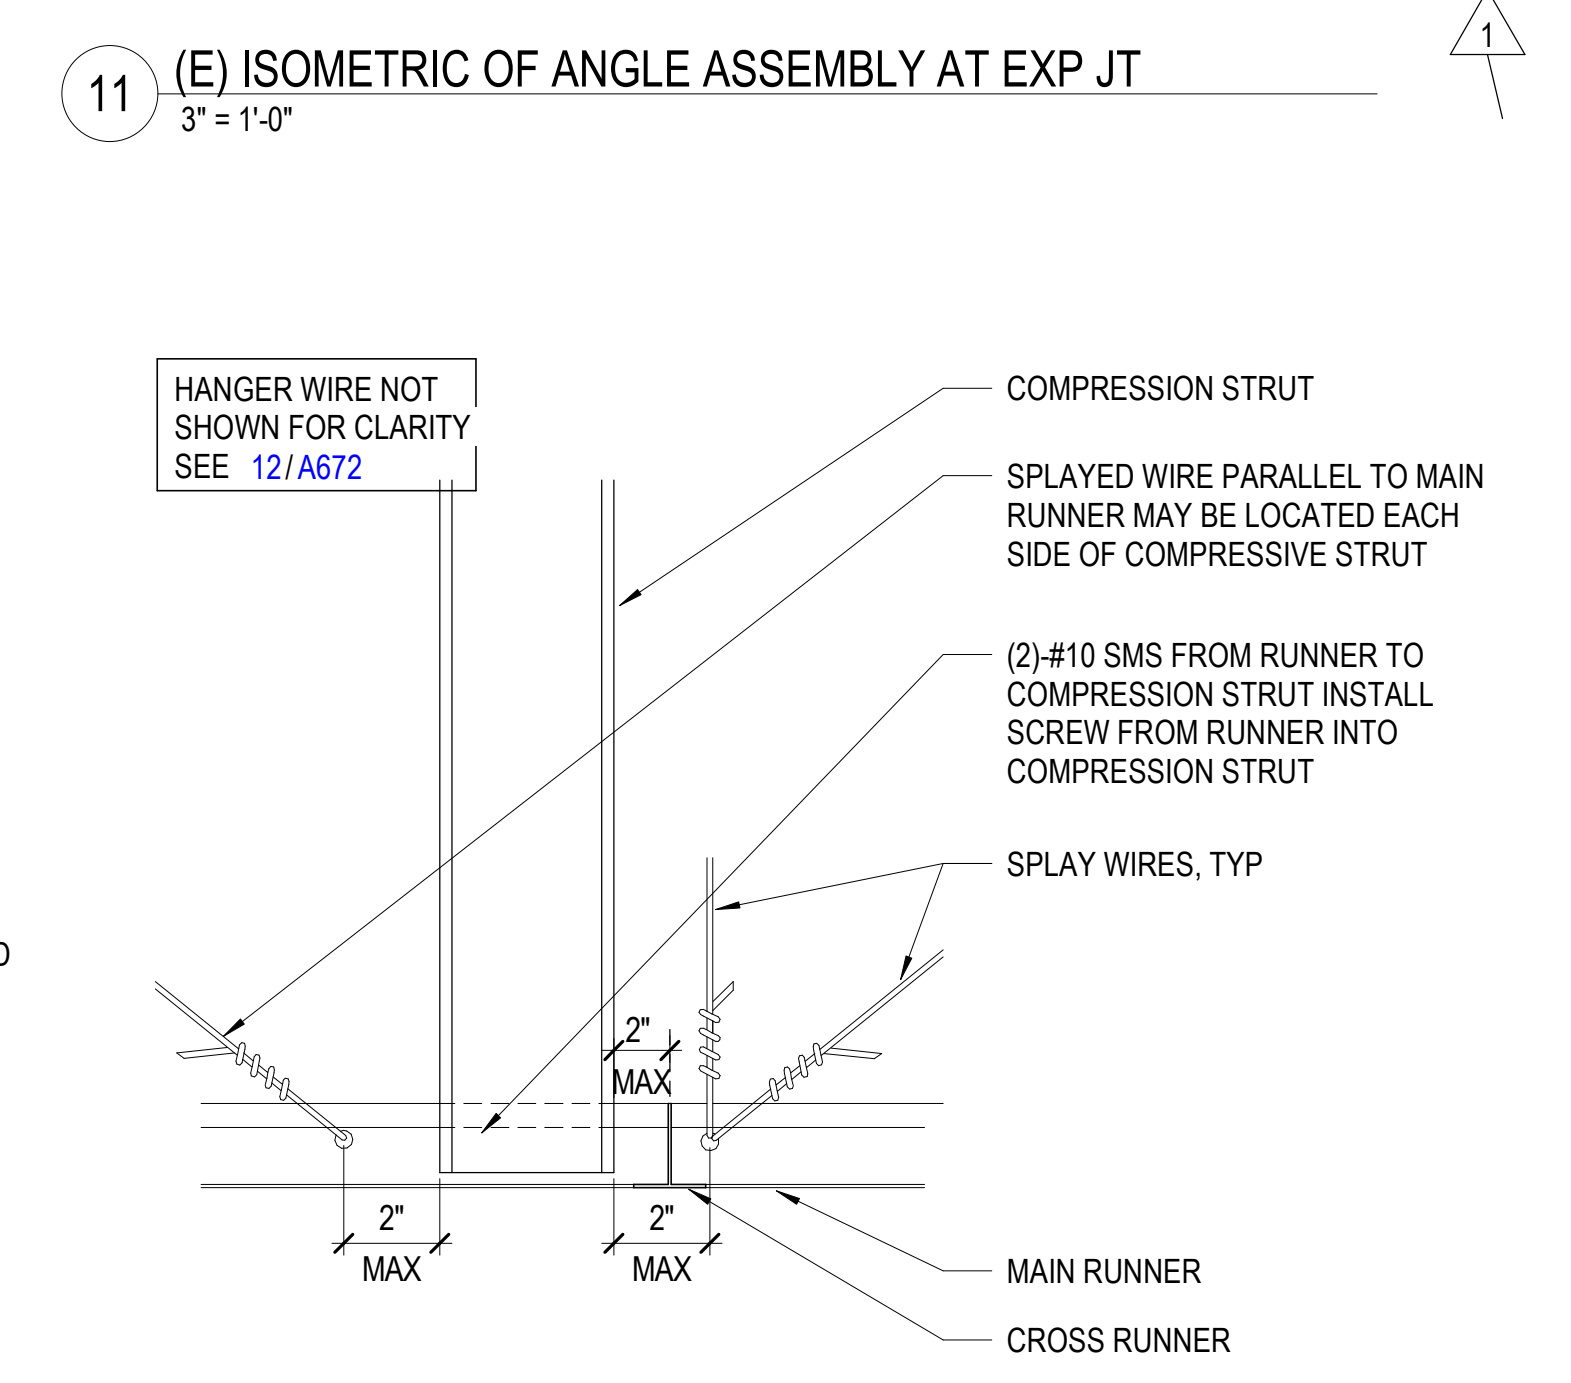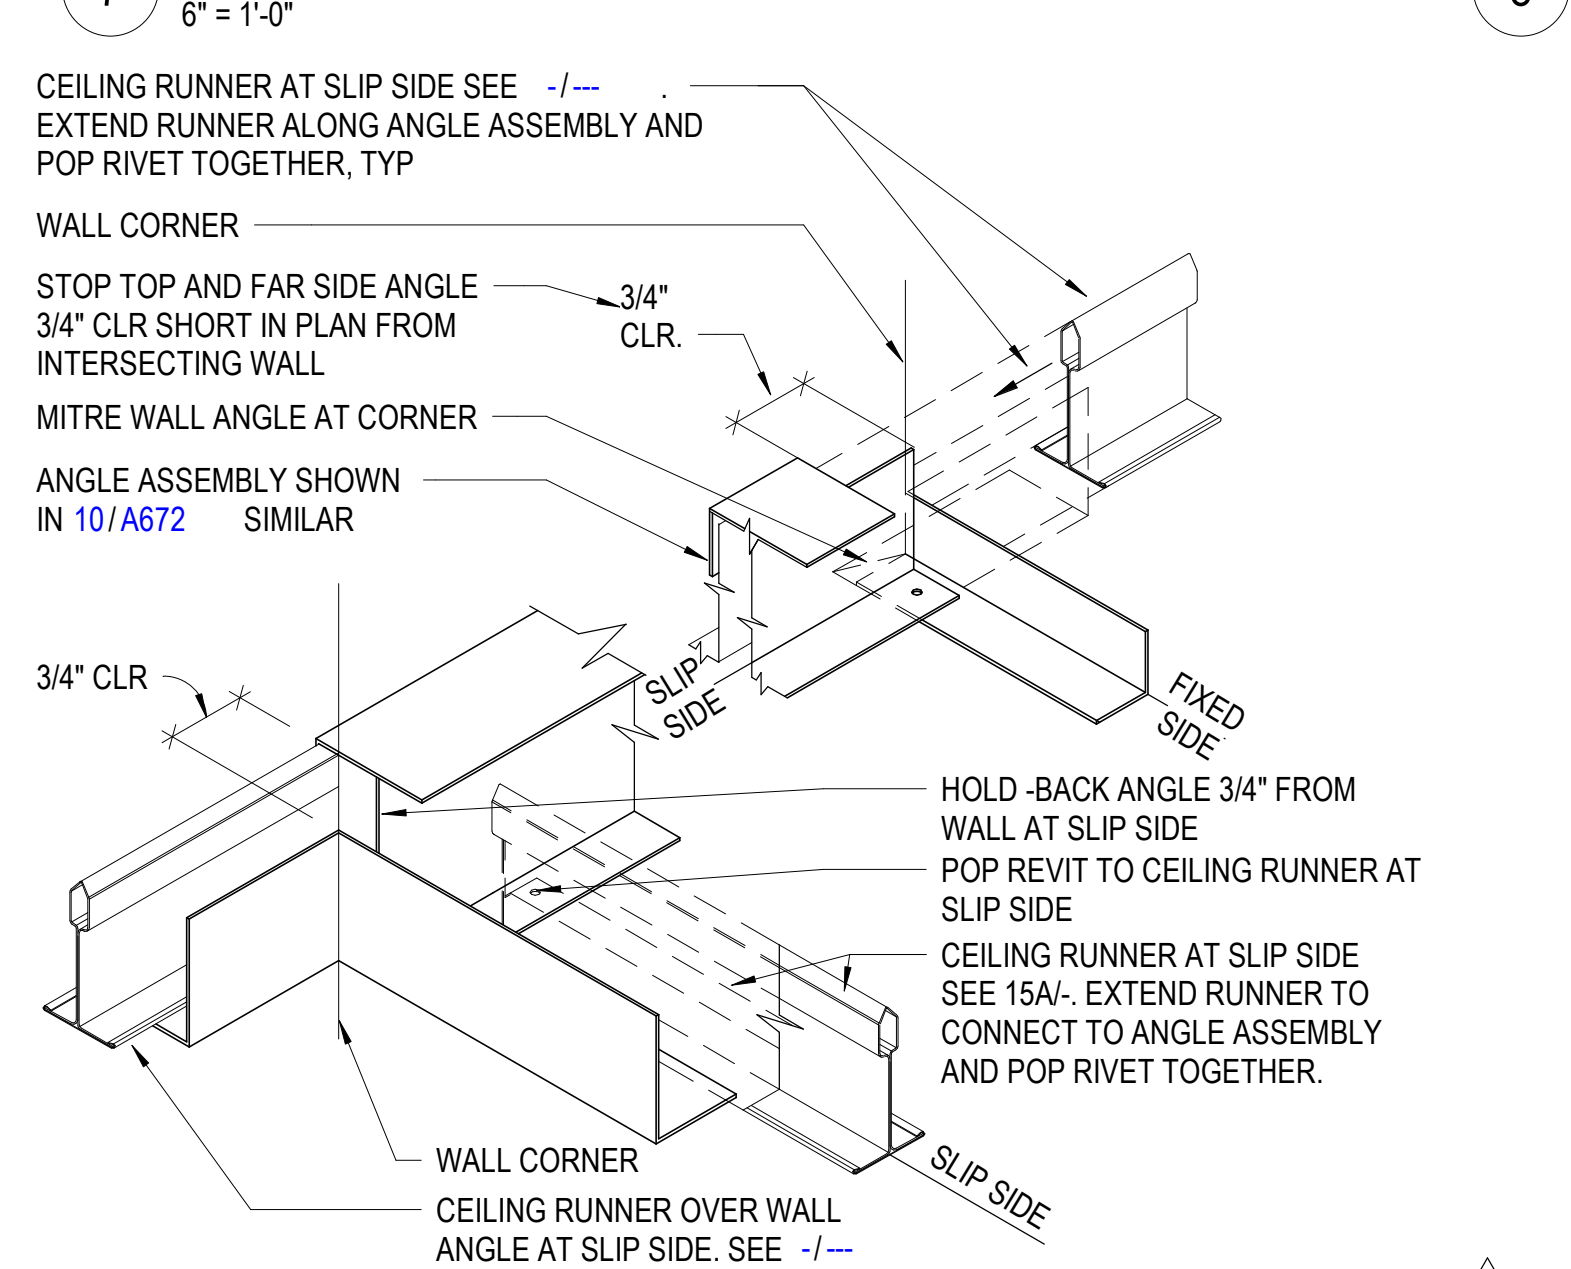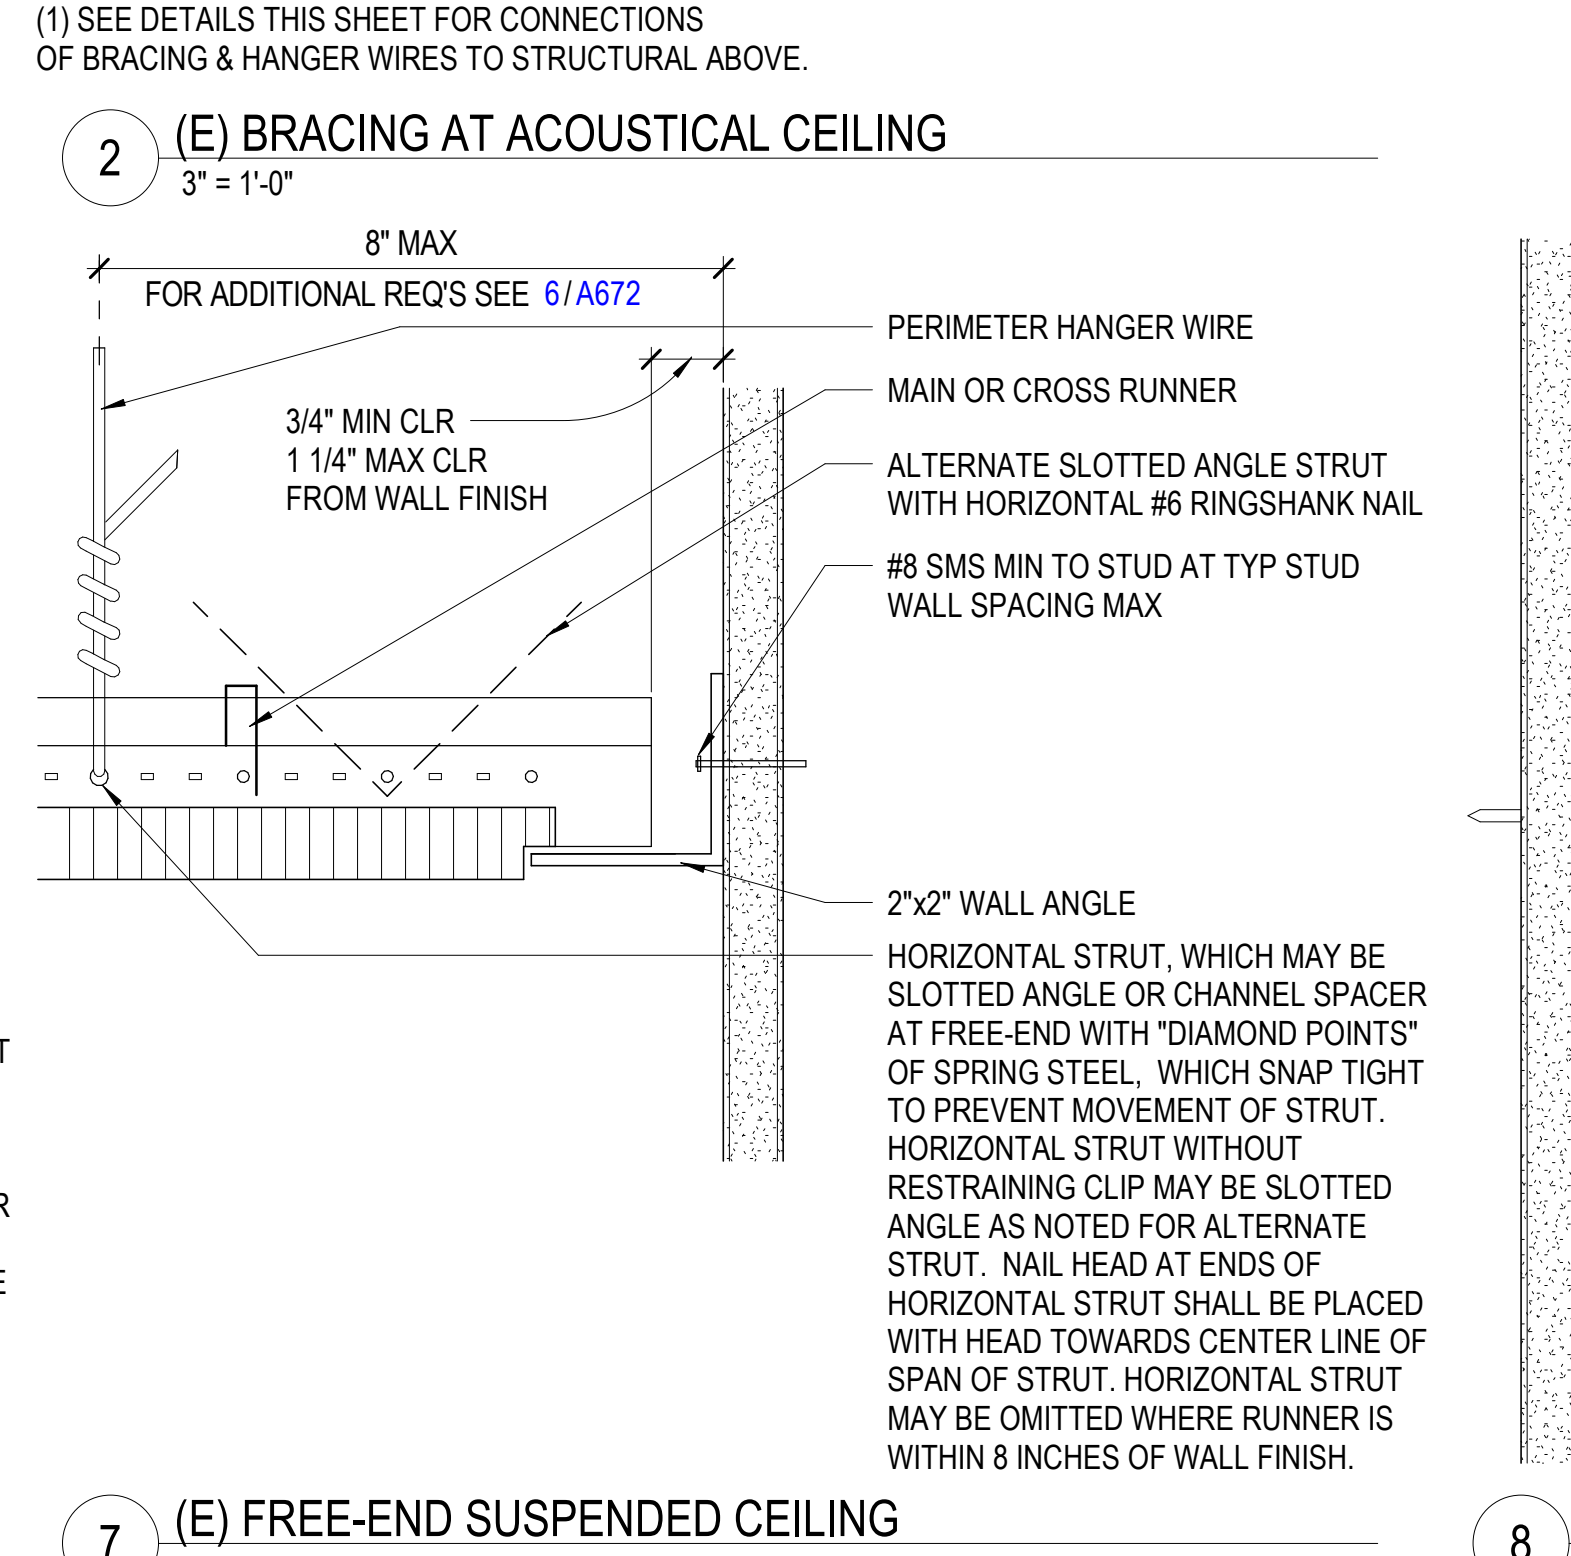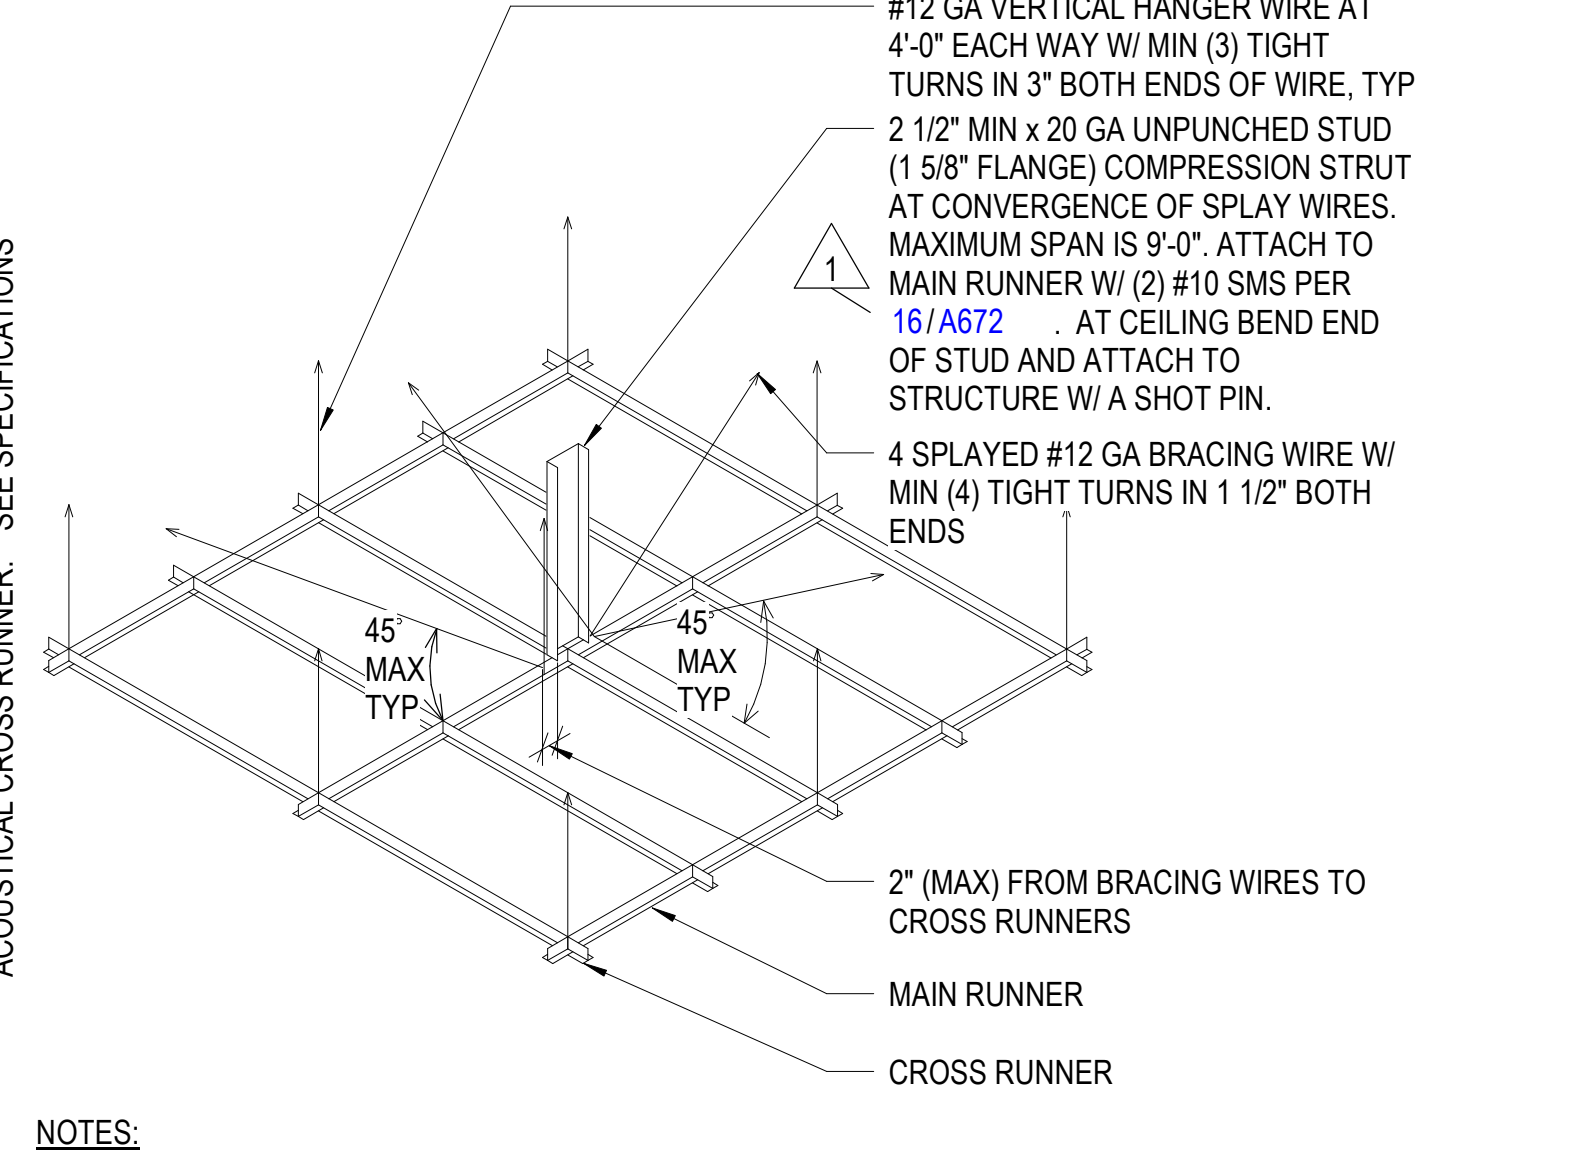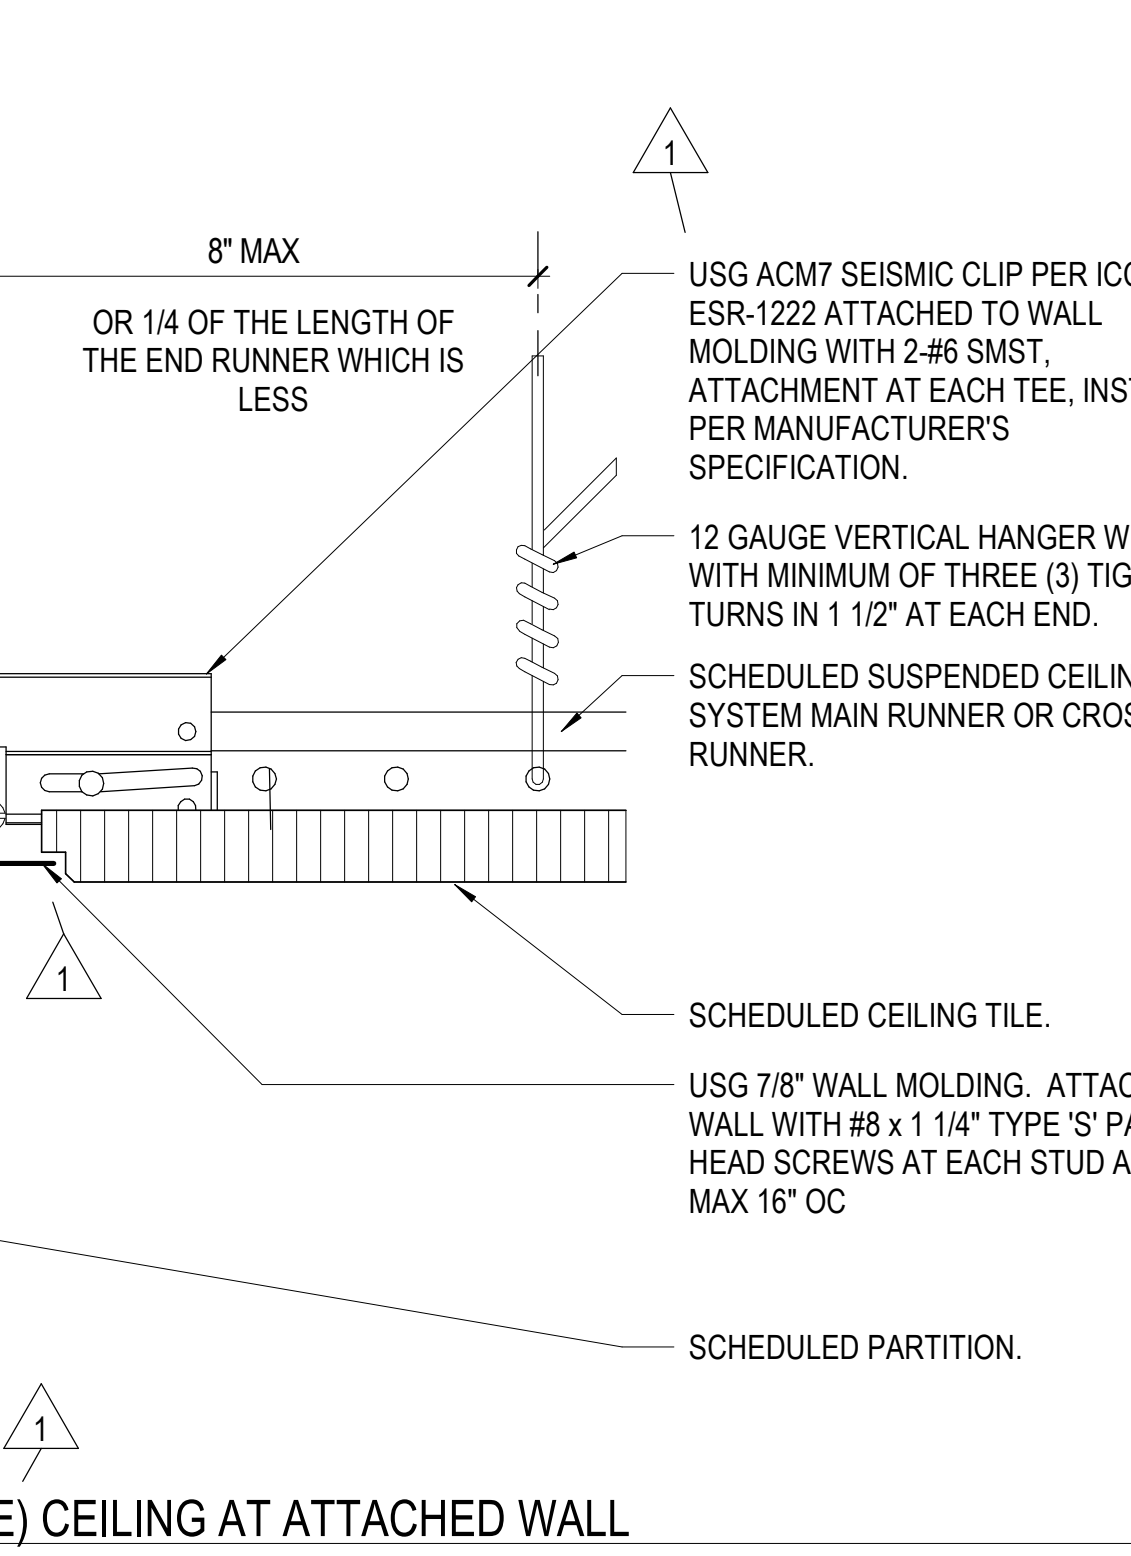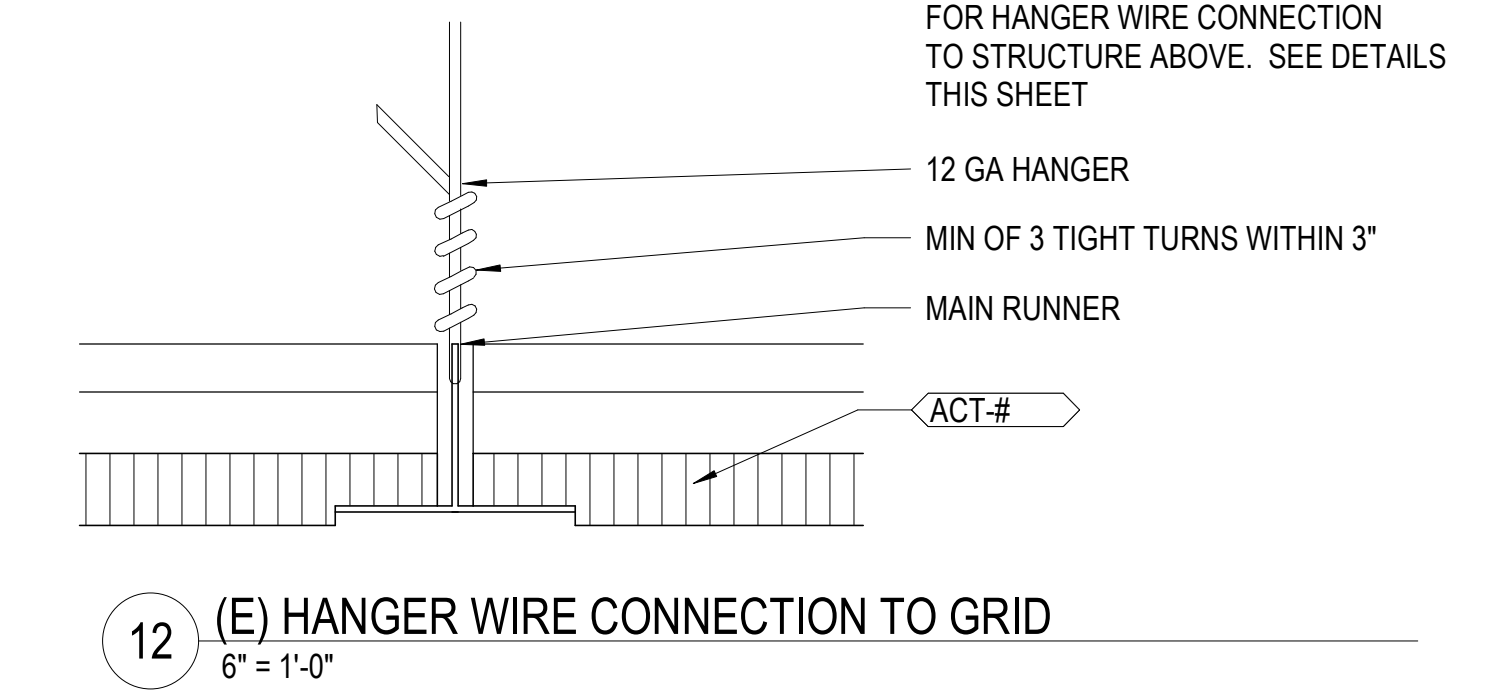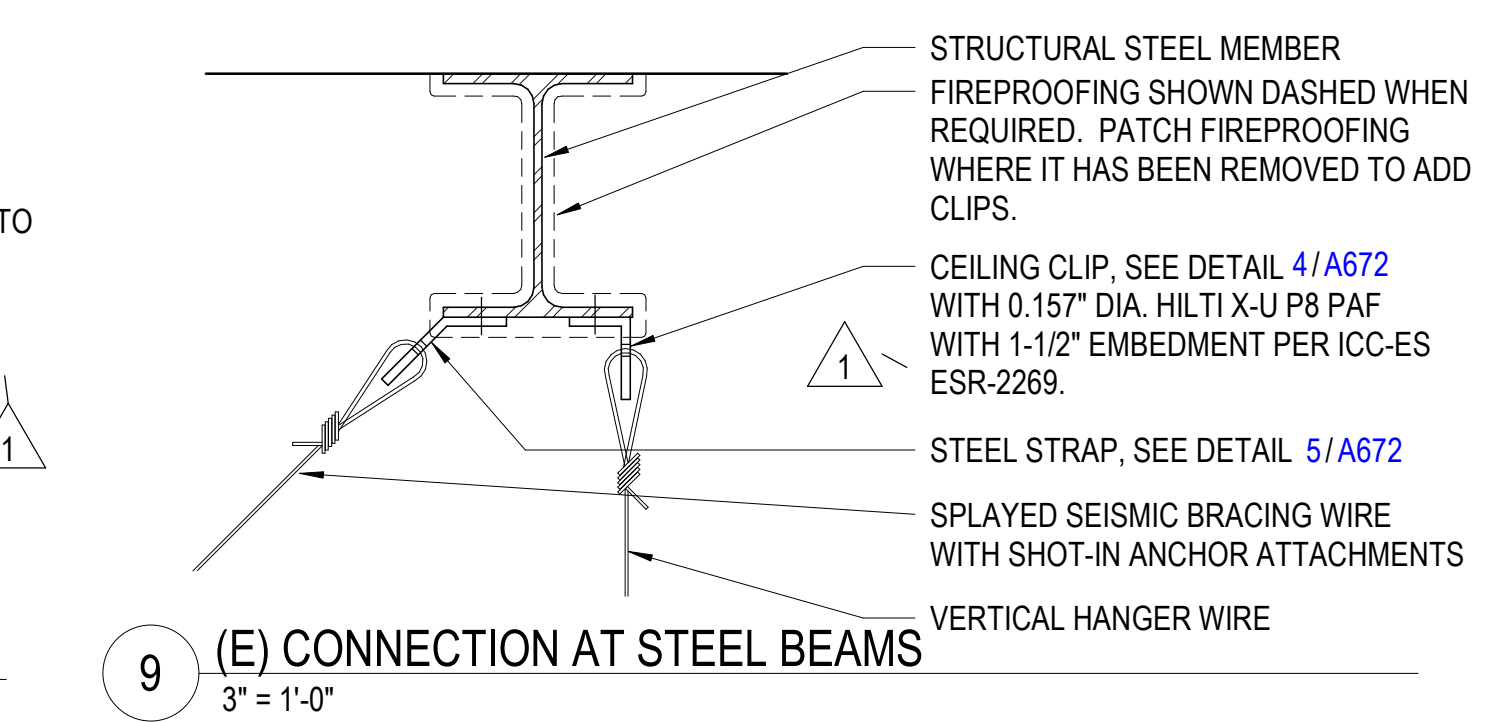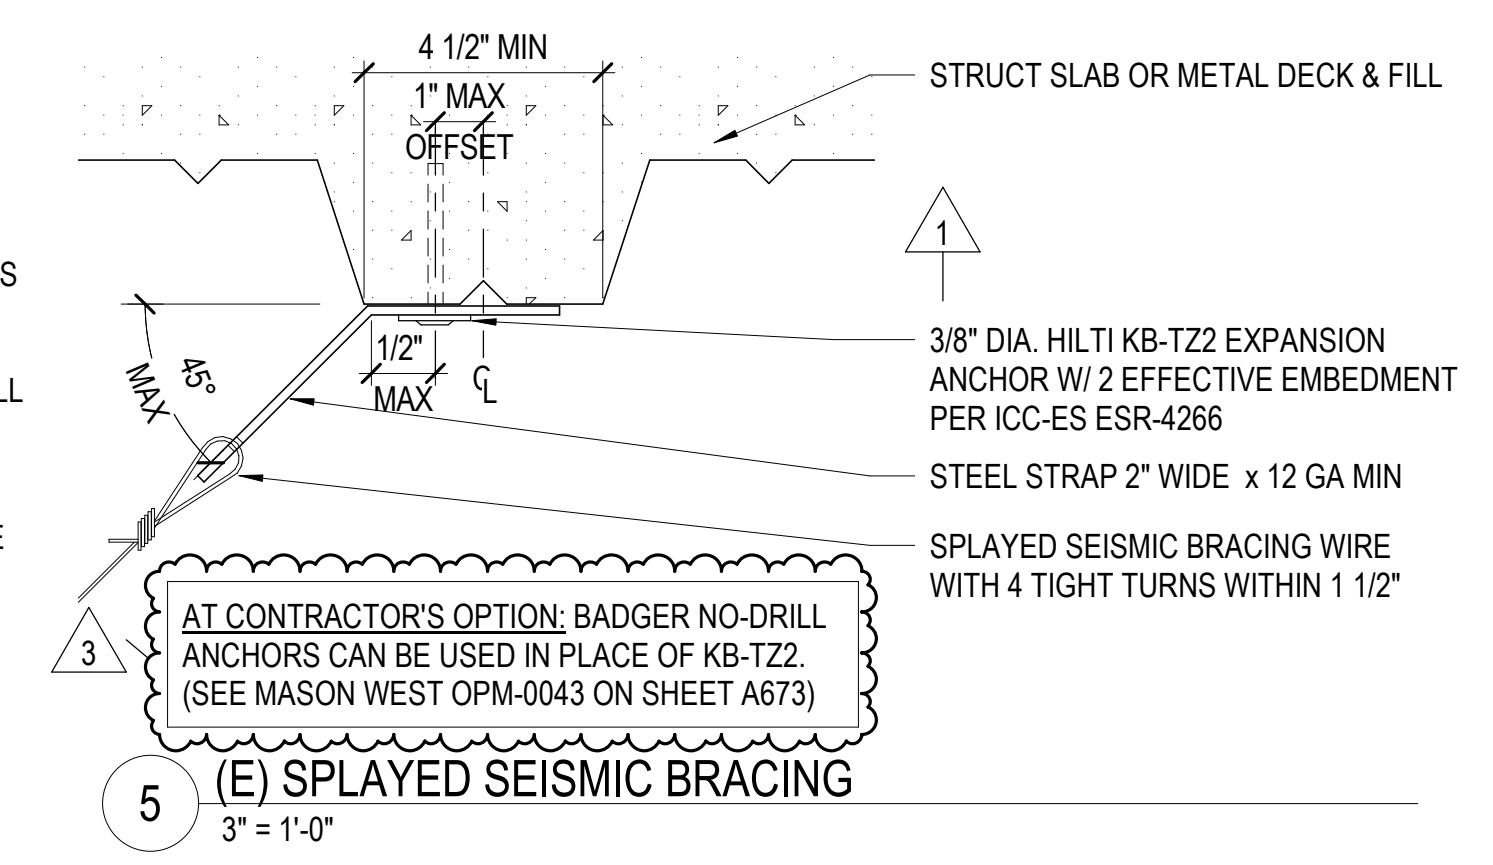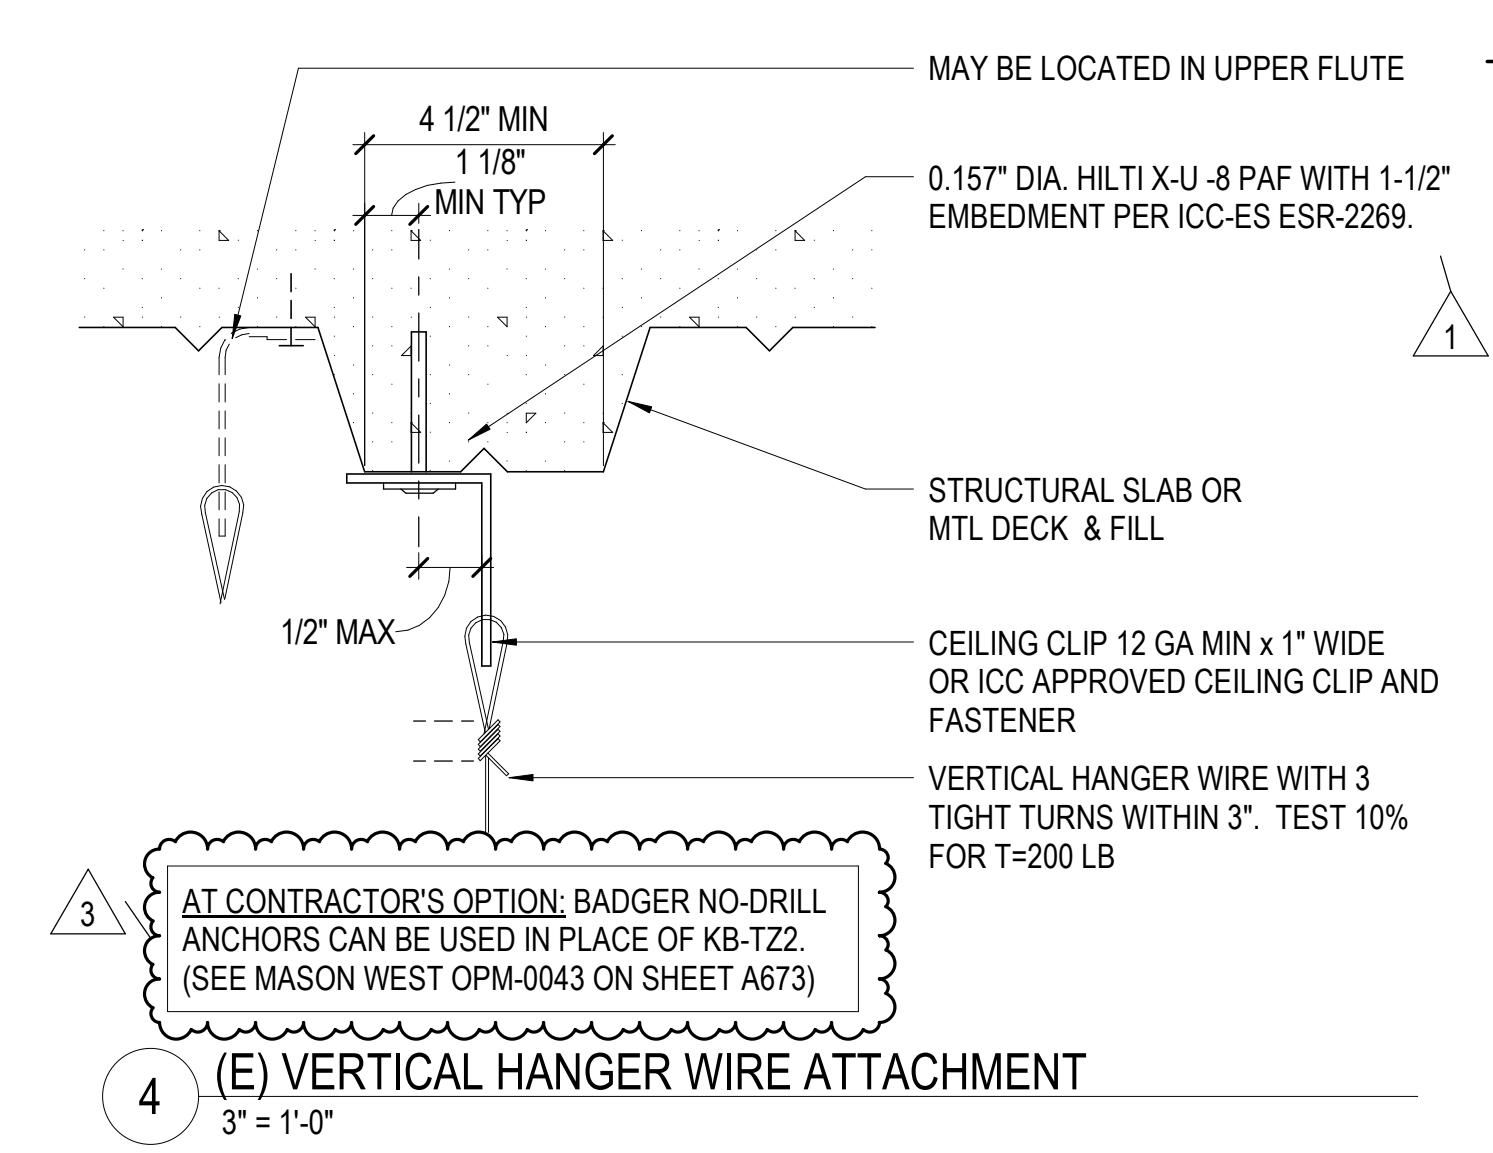

Author: 5/22/2024, 1:12:17 PM C:\Users\cmahill\OneDrive\Documents\HCAI Local Files\A672-UCDA Health Replacement\65014600_schematic.rvt

HANGER ATTACHMENT TO CONCRETE FILLED METAL DECK WITH (1) BADGER INDUSTRIES MDH NO-DRILL™ HANGER

ATR SHALL BE EXPOSED AT TOP, BUT SHALL NOT CONTACT METAL DECKING. 3/8" BOLT TO PROPER HOLE, ONLY ONE ATR SHALL BE INSTALLED PER HANGER. FOR LOCATIONS WHERE MRL CANNOT BE SATISFIED, SEE DETAIL M2.121 FOR OPTION WITH (2) MDH HANGERS AND STRUT SPANNER. PROJECT APPROVED HANGER, TRAPEZE, OR SEISMIC SUPPORT.

MIN. 20 GA VERC0 W3 OR PLW3 STEEL DECK W/ MIN. 3000 PSI NWC OR SLWC. FOR USE IN VERC0 W2 OR PLW2 DECK, SEE NOTE 4. FOR PROPER INSTALLATION, FLAT SURFACE SHALL FACE DOWN.

BADGER INDUSTRIES MDH NO-DRILL™ HANGER. SEE DETAIL B.

THREADED SHAFT WITH CHISEL POINT. TORQUE-OFF HEX NUT. THREADED BARREL W/ LOCK WASHER. FULLY TAPPED THROUGH HOLE. END OF CONCRETE FILLED METAL DECK. 1" GAP WHEN SPACED AT "Smin".

GRAVITY ONLY	GRAVITY & SEISMIC	ATR HANGER DIA. INCH	MIN. ROD LENGTH INCH	MDH SIZE	MIN. END DIST. INCH	MIN. END DIST. INCH
HANGER CONNECTION TYPE	HANGER CONNECTION TYPE					
38A TO 38C	38A TO 38E	400	3/8	MDH3812	2	6
58A TO 58C	58A TO 58E	400	3/8	MDH3812	2	6
58A TO 58D	58A TO 58G	600	3/8	MDH1258	3	6
58A TO 58D	58A TO 58G	600	3/8	MDH1258	3	6

INSTALLATION OF MULTIPLE INDEPENDENT SUPPORTS

1. SEE DETAIL M0.00 FOR SECTION NOTES.
 2. WHEN USED FOR "GRAVITY & SEISMIC" LOADING, THE GRAVITY DEMAND SHALL NOT EXCEED THE "GRAVITY ONLY" ALLOWABLE LOAD.
 3. PROXIMITY OR SPACING OF NEW OR EXISTING CONCRETE INSERTS OR DRILLED HOLE ANCHORS TO THE MDH DOES NOT IMPACT THE LISTED MDH CAPACITIES.
 4. INSTALLATION: CLEAN METAL DECKING GROOVES TO EXPOSE PLATED DECKING METAL. PRIOR TO PLACEMENT OF THE MDH HANGER, ACCURATELY PLACE MDH HANGER CHISEL POINT ENDS INTO METAL DECKING GROOVES WITH FLAT SURFACE FACING DOWNWARDS AND WITH THE LENGTH OF THE MDH BODY BEING PERPENDICULAR TO THE DECKING GROOVES. WHILE HOLDING THE BODY CHISEL POINT END TIGHT INTO METAL DECKING GROOVE, TIGHTEN TORQUE-OFF HEX NUT UNTIL BOTH CHISEL POINT ENDS ARE TIGHT AND SECURELY WEDGED INTO THE OPPOSING METAL DECKING GROOVES. WHILE HOLDING THE MDH HANGER BODY IN PLACE, TIGHTEN THE TORQUE-OFF HEX NUT WITH AN OPEN END WRENCH UNTIL THE HEX NUT HAS BROKEN AWAY FROM THE THREADED BARREL, LEAVING THE LOCK WASHER COMPRESSED AND THE HEX NUT LOOSE ON THE THREADED SHAFT. FOR REFERENCE, A MINIMUM OF 15 FT-LBS OF TORQUE IS REQUIRED FOR THE MDH3812 AND A MINIMUM OF 20 FT-LBS OF TORQUE IS REQUIRED FOR THE MDH1258.

MASON WEST
1601 E. Miraloma Ave. Placentia, CA 92870
TEL (714) 630-0701, www.masonwest.com

Jiefu "Jeff" Zhang, SE
California SE No. 55270

PAGE M2.120

HANGER ATTACHMENT TO CONCRETE FILLED METAL DECK WITH (1) BADGER INDUSTRIES MDH NO-DRILL™ HANGER

BOLT SHALL BE EXPOSED AT TOP, BUT SHALL NOT CONTACT METAL DECKING. 1x1x1/2GA, 1" LG. ANGLE MAY BE ROTATED TO ANY ANGLE IN PLAN. 3/8" BOLT W/ WELDING WASHER TO PROPER HOLE, ONLY ONE BOLT SHALL BE INSTALLED PER HANGER.

MIN. 20 GA VERC0 W3 OR PLW3 STEEL DECK W/ MIN. 3000 PSI NWC OR SLWC. FOR PROPER INSTALLATION, FLAT SURFACE SHALL FACE DOWN.

BADGER INDUSTRIES MDH NO-DRILL™ HANGER. SEE DETAIL B.

MIN. 12GA ASTM A641 WIRE OR AIRCRAFT CABLE TIED W/ MIN. (4) TWISTS WITHIN 1/2" TYP. WIRE OR CABLE HANGER SHALL BE FOR TENSION LOADS ONLY.

THREADED SHAFT WITH CHISEL POINT. TORQUE-OFF HEX NUT. THREADED BARREL W/ LOCK WASHER. FULLY TAPPED THROUGH HOLE. END OF CONCRETE FILLED METAL DECK. 1" GAP WHEN SPACED AT "Smin".

GRAVITY ONLY	ALLOWABLE VERTICAL LOAD LBS	MDH SIZE	MIN. END DIST. INCH	MIN. END DIST. INCH
HANGER CONNECTION TYPE				
38A TO 38C	180	MDH3812	2	6

INSTALLATION OF MULTIPLE INDEPENDENT SUPPORTS

1. SEE DETAIL M0.00 FOR SECTION NOTES.
 2. WHEN USED FOR "GRAVITY & SEISMIC" LOADING, THE GRAVITY DEMAND SHALL NOT EXCEED THE "GRAVITY ONLY" ALLOWABLE LOAD.
 3. PROXIMITY OR SPACING OF NEW OR EXISTING CONCRETE INSERTS OR DRILLED HOLE ANCHORS TO THE MDH DOES NOT IMPACT THE LISTED MDH CAPACITIES.
 4. INSTALLATION: CLEAN METAL DECKING GROOVES TO EXPOSE PLATED DECKING METAL. PRIOR TO PLACEMENT OF THE MDH HANGER, ACCURATELY PLACE MDH HANGER CHISEL POINT ENDS INTO METAL DECKING GROOVES WITH FLAT SURFACE FACING DOWNWARDS AND WITH THE LENGTH OF THE MDH BODY BEING PERPENDICULAR TO THE DECKING GROOVES. WHILE HOLDING THE BODY CHISEL POINT END TIGHT INTO METAL DECKING GROOVE, TIGHTEN TORQUE-OFF HEX NUT UNTIL BOTH CHISEL POINT ENDS ARE TIGHT AND SECURELY WEDGED INTO THE OPPOSING METAL DECKING GROOVES. WHILE HOLDING THE MDH HANGER BODY IN PLACE, TIGHTEN THE TORQUE-OFF HEX NUT WITH AN OPEN END WRENCH UNTIL THE HEX NUT HAS BROKEN AWAY FROM THE THREADED BARREL, LEAVING THE LOCK WASHER COMPRESSED AND THE HEX NUT LOOSE ON THE THREADED SHAFT. FOR REFERENCE, A MINIMUM OF 15 FT-LBS OF TORQUE IS REQUIRED FOR THE MDH3812 AND A MINIMUM OF 20 FT-LBS OF TORQUE IS REQUIRED FOR THE MDH1258.

MASON WEST
1601 E. Miraloma Ave. Placentia, CA 92870
TEL (714) 630-0701, www.masonwest.com

Jiefu "Jeff" Zhang, SE
California SE No. 55270

PAGE M2.120.1

HANGER ATTACHMENT TO CONCRETE FILLED METAL DECK WITH (2) BADGER INDUSTRIES MDH NO-DRILL™ HANGERS

BOLT SHALL BE EXPOSED AT TOP, BUT SHALL NOT CONTACT METAL DECKING. 3/8" BOLT TO PROPER HOLE, ONLY ONE BOLT SHALL BE INSTALLED PER HANGER. JAM OR HEX NUT NOT REQ'D. 1/2" x 1/2" GA SINGLE STRUT (SOLID, PUNCHED, OR SLOTTED) OR B-LINE B2000 STRUT NUT. MIN. 3/8" x 1/2" x 1/2" ASTM A36 STRUT WASHER AND REG. NUT (SEE TABLE FOR TORQUE REQ). 3/8" TO 3/4" DIA. ATR HANGER.

MIN. 20 GA VERC0 W3 OR PLW3 STEEL DECK W/ MIN. 3000 PSI NWC OR SLWC. FOR PROPER INSTALLATION, FLAT SURFACE SHALL FACE DOWN.

BADGER INDUSTRIES MDH NO-DRILL™ HANGER. SEE DETAIL B.

THREADED SHAFT WITH CHISEL POINT. TORQUE-OFF HEX NUT. THREADED BARREL W/ LOCK WASHER. FULLY TAPPED THROUGH HOLE. END OF CONCRETE FILLED METAL DECK. 1" GAP WHEN SPACED AT "Smin".

GRAVITY ONLY	ALLOWABLE VERTICAL LOAD LBS	GRAVITY & SEISMIC	ALLOWABLE VERTICAL LOAD LBS	ATR HANGER DIA. INCH	MDH SIZE	MIN. END DIST. INCH	MIN. END DIST. INCH
HANGER CONNECTION TYPE		HANGER CONNECTION TYPE					
38A TO 38D	300	38A TO 38G	600	3/8	MDH3812	2	6
58A TO 58D	300	58A TO 58G	600	3/8	MDH3812	2	6
58A TO 58D	300	58A TO 58G	600	3/8	MDH3812	2	6
58A TO 58F	450	58A TO 58H	900	3/8	MDH1258	3	6
58A TO 58F	450	58A TO 58H	900	3/8	MDH1258	3	6
78A TO 78F	450	78A TO 78H	900	3/8	MDH1258	3	6

FASTENER WITH STRUT NUT

DIA. INCH	TORQUE REQ'D FT-LBS
3/8	19
1/2	50

INSTALLATION OF MULTIPLE INDEPENDENT SUPPORTS

1. SEE DETAIL M0.00 FOR SECTION NOTES.
 2. WHEN USED FOR "GRAVITY & SEISMIC" LOADING, THE GRAVITY DEMAND SHALL NOT EXCEED THE "GRAVITY ONLY" ALLOWABLE LOAD.
 3. PROXIMITY OR SPACING OF NEW OR EXISTING CONCRETE INSERTS OR DRILLED HOLE ANCHORS TO THE MDH DOES NOT IMPACT THE LISTED MDH CAPACITIES.
 4. INSTALLATION: CLEAN METAL DECKING GROOVES TO EXPOSE PLATED DECKING METAL. PRIOR TO PLACEMENT OF THE MDH HANGER, ACCURATELY PLACE MDH HANGER CHISEL POINT ENDS INTO METAL DECKING GROOVES WITH FLAT SURFACE FACING DOWNWARDS AND WITH THE LENGTH OF THE MDH BODY BEING PERPENDICULAR TO THE DECKING GROOVES. WHILE HOLDING THE BODY CHISEL POINT END TIGHT INTO METAL DECKING GROOVE, TIGHTEN TORQUE-OFF HEX NUT UNTIL BOTH CHISEL POINT ENDS ARE TIGHT AND SECURELY WEDGED INTO THE OPPOSING METAL DECKING GROOVES. WHILE HOLDING THE MDH HANGER BODY IN PLACE, TIGHTEN THE TORQUE-OFF HEX NUT WITH AN OPEN END WRENCH UNTIL THE HEX NUT HAS BROKEN AWAY FROM THE THREADED BARREL, LEAVING THE LOCK WASHER COMPRESSED AND THE HEX NUT LOOSE ON THE THREADED SHAFT. FOR REFERENCE, A MINIMUM OF 15 FT-LBS OF TORQUE IS REQUIRED FOR THE MDH3812 AND A MINIMUM OF 20 FT-LBS OF TORQUE IS REQUIRED FOR THE MDH1258.

MASON WEST
1601 E. Miraloma Ave. Placentia, CA 92870
TEL (714) 630-0701, www.masonwest.com

Jiefu "Jeff" Zhang, SE
California SE No. 55270

PAGE M2.121

HANGER ATTACHMENT TO CONCRETE FILLED METAL DECK WITH (2) BADGER INDUSTRIES MDH NO-DRILL™ HANGERS

BOLT SHALL BE EXPOSED AT TOP, BUT SHALL NOT CONTACT METAL DECKING. REG. NUT, TYP. MIN. 3/8" x 1/2" x 1/2" ASTM A36 STRUT WASHER, TYP. 3/8" BOLT TO PROPER HOLE, TYP. SNUG. TIGHTEN EVENLY UNTIL STRUT MEMBER IS IN CONTACT FLAT TO PLATE WITH STEEL DECKING. 1/2" x 1/2" GA SINGLE STRUT (SOLID, PUNCHED, OR SLOTTED) MAY BE ROTATED TO ANY ANGLE IN PLAN. B-LINE B2000 STRUT NUT. MIN. 3/8" x 1/2" x 1/2" ASTM A36 STRUT WASHER AND REG. NUT (SEE TABLE FOR TORQUE REQ). 3/8" TO 3/4" DIA. ATR HANGER.

MIN. 20 GA VERC0 W3, PLW2 OR PLW3 STEEL DECK W/ MIN. 3000 PSI NWC OR SLWC. FOR PROPER INSTALLATION, FLAT SURFACE SHALL FACE DOWN.

BADGER INDUSTRIES MDH3812 NO-DRILL™ HANGER. TYP. SEE DETAIL B.

THREADED SHAFT WITH CHISEL POINT. TORQUE-OFF HEX NUT. THREADED BARREL W/ LOCK WASHER. FULLY TAPPED THROUGH HOLE. END OF CONCRETE FILLED METAL DECK. 1" GAP WHEN SPACED AT "Smin".

GRAVITY ONLY	ALLOWABLE VERTICAL LOAD LBS	GRAVITY & SEISMIC	ALLOWABLE VERTICAL LOAD LBS	ATR HANGER DIA. INCH	MDH SIZE	MIN. END DIST. INCH	MIN. END DIST. INCH
HANGER CONNECTION TYPE		HANGER CONNECTION TYPE					
38A TO 38E	400	38A TO 38G	600	3/8	MDH3812	2	6
58A TO 58E	400	58A TO 58G	600	3/8	MDH3812	2	6
58A TO 58E	400	58A TO 58G	600	3/8	MDH3812	2	6

FASTENER WITH STRUT NUT

DIA. INCH	TORQUE REQ'D FT-LBS
3/8	19
1/2	50

INSTALLATION OF MULTIPLE INDEPENDENT SUPPORTS

1. SEE DETAIL M0.00 FOR SECTION NOTES.
 2. WHEN USED FOR "GRAVITY & SEISMIC" LOADING, THE GRAVITY DEMAND SHALL NOT EXCEED THE "GRAVITY ONLY" ALLOWABLE LOAD.
 3. PROXIMITY OR SPACING OF NEW OR EXISTING CONCRETE INSERTS OR DRILLED HOLE ANCHORS TO THE MDH DOES NOT IMPACT THE LISTED MDH CAPACITIES.
 4. INSTALLATION: CLEAN METAL DECKING GROOVES TO EXPOSE PLATED DECKING METAL. PRIOR TO PLACEMENT OF THE MDH HANGER, ACCURATELY PLACE MDH HANGER CHISEL POINT ENDS INTO METAL DECKING GROOVES WITH FLAT SURFACE FACING DOWNWARDS AND WITH THE LENGTH OF THE MDH BODY BEING PERPENDICULAR TO THE DECKING GROOVES. WHILE HOLDING THE BODY CHISEL POINT END TIGHT INTO METAL DECKING GROOVE, TIGHTEN TORQUE-OFF HEX NUT UNTIL BOTH CHISEL POINT ENDS ARE TIGHT AND SECURELY WEDGED INTO THE OPPOSING METAL DECKING GROOVES. WHILE HOLDING THE MDH HANGER BODY IN PLACE, TIGHTEN THE TORQUE-OFF HEX NUT WITH AN OPEN END WRENCH UNTIL THE HEX NUT HAS BROKEN AWAY FROM THE THREADED BARREL, LEAVING THE LOCK WASHER COMPRESSED AND THE HEX NUT LOOSE ON THE THREADED SHAFT. FOR REFERENCE, A MINIMUM OF 15 FT-LBS OF TORQUE IS REQUIRED FOR THE MDH3812 AND A MINIMUM OF 20 FT-LBS OF TORQUE IS REQUIRED FOR THE MDH1258.

MASON WEST
1601 E. Miraloma Ave. Placentia, CA 92870
TEL (714) 630-0701, www.masonwest.com

Jiefu "Jeff" Zhang, SE
California SE No. 55270

PAGE M2.122



NO	DESCRIPTION	DATE
3	ACD 01	5/23/2024

STRUCTURAL ENGINEER

HGA
1200 R ST, SUITE 100
SACRAMENTO, CA 95811
916.787.5100

MECHANICAL/ELECTRICAL/ PLUMBING ENGINEER

HGA
1200 R ST, SUITE 100
SACRAMENTO, CA 95811
916.787.5100

INTERIOR ARCHITECT

HGA
1200 R ST, SUITE 100
SACRAMENTO, CA 95811
916.787.5100

GENERAL NOTES

- A. COORDINATE LOCATION AND MOUNTING OF DEVICES WITH MILLWORK AND CASEWORK.
- B. ELECTRICAL & SYSTEMS DEVICES & EQUIPMENT SHOWN AS SCREENED ARE EXISTING TO REMAIN. THE ELECTRICAL CONTRACTOR IS RESPONSIBLE FOR FIELD VERIFYING LOCATIONS OF EXISTING SYSTEMS PRIOR TO CONSTRUCTION AND NOTIFY THE ENGINEER OF ANY DISCREPANCIES WHICH MAY AFFECT ANY WORK UNDER THIS CONTRACT.
- C. REFER TO THE ARCHITECTURAL DETAILS AND ELEVATION DRAWINGS FOR COORDINATION OF ELECTRICAL DEVICES.
- D. DEVICES AND EQUIPMENT SHALL BE CIRCUITED FROM PANELS AS INDICATED.
- E. CONDUIT AND WIRING MAY NOT BE SHOWN GRAPHICALLY ON THE PLANS. HOWEVER IT SHALL BE PROVIDED COMPLETE AS REQUIRED BASED ON IDENTIFICATION OF CIRCUIT NUMBERS, RELAY NUMBERS, SWITCHING IDENTIFICATION, MOTOR EQUIPMENT SCHEDULE, PANEL BOUNDARIES, SPECIFIED MINIMUM CONDUIT SIZE, SPECIFIED MINIMUM CONDUCTOR SIZES, AND/OR SPECIFIED MINIMUM GROUNDING.
- F. REFER TO ONE-LINE DIAGRAMS FOR ADDITIONAL INFORMATION FOR FEEDERS AND ELECTRICAL EQUIPMENT.
- G. REFER TO VENDOR DRAWINGS FOR ADDITIONAL INFORMATION.
- H. REFER TO VENDOR DRAWINGS ON E600 SERIES FOR ADDITIONAL INFORMATION.

KEYNOTES


#	DESCRIPTION
P1	PROVIDE JUNCTION BOX FOR WALL BUCKY. COORDINATE EXACT LOCATION WITH VENDOR PRIOR TO ROUGH-IN.
P2	PROVIDE FLUSH-MOUNTED CEILING BOX CONNECTION FOR CSM3. COORDINATE EXACT LOCATION WITH VENDOR PRIOR TO ROUGH-IN.
P3	REUSE EXISTING CIRCUIT(S) FREED BY DEMOLITION WORK. NO ADDITIONAL EXISTING LOADS TO ACCOUNT FOR BASED OFF OF RECORD DOCUMENTS.
P4	PROVIDE JUNCTION BOX FOR GENERATOR CABINET. COORDINATE EXACT LOCATION WITH VENDOR PRIOR TO ROUGH-IN.
P5	PROVIDE SHUNT TRIP FOR REMOTE CONTROL OF IN-ROOM CIRCUIT BREAKER. COORDINATE EXACT LOCATION WITH OWNER PRIOR TO ROUGH-IN.
P7	IN-ROOM 480V, 3P 50A CIRCUIT BREAKER WITH SHUNT TRIP. INTERCEPT AND EXTEND EXISTING CIRCUIT BREAKER CONNECTION FOR A COMPLETE INSTALLATION. RUN POWER FROM BREAKER TO GENERATOR CABINET, LEAVING AN 8" TAIL. COORDINATE EXACT LOCATION WITH OWNER PRIOR TO ROUGH-IN.
P8	PROVIDE JUNCTION BOX FOR WALL RACEWAY. COORDINATE EXACT LOCATION WITH VENDOR PRIOR TO ROUGH-IN.
P9	PROVIDE JUNCTION BOX FOR WIRELESS ACCESS POINT. COORDINATE EXACT LOCATION WITH VENDOR PRIOR TO ROUGH-IN.
P10	PROVIDE POWER CONNECTION FOR DOOR SWITCH. COORDINATE EXACT LOCATION WITH VENDOR PRIOR TO ROUGH-IN.
P11	NEW MED GAS OUTLET LOCATION. INTERCEPT AND EXTEND EXISTING CONNECTION TO MEDICAL GAS ALARM PANEL AS NEEDED FOR A COMPLETE INSTALLATION. COORDINATE WITH ARCHITECT PRIOR TO ROUGH-IN.
P12	JUNCTION BOX FOR TEMPORARY POWER. REMOVE AFTER CONSTRUCTION HAS BEEN COMPLETED.

UCDAVIS HEALTH SYSTEM

FACILITIES DESIGN & CONSTRUCTION
4800 2ND AVENUE, SUITE 3010
SACRAMENTO, CALIFORNIA 95817
916.475.4754

M055565
SESP 1P752, 1P754 &
1P758 ED X-RAY
REPLACEMENT

HCAI #: S23 -34-00
HCAI FACILITY ID #: 10619
HCAI STAMP

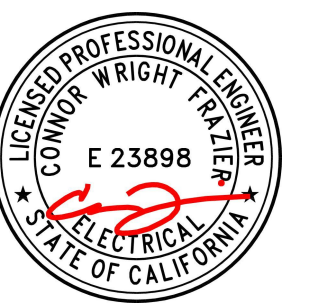

NO	DESCRIPTION	DATE
1	HCAI BACKCHECK RESPONSE 1	11/8/2023
3	ACD 01	5/23/2024

ISSUANCE HISTORY - THIS SHEET

HGA NO: 1500-148-00


POWER PLAN - LEVEL 01

DATE: 08.28.2023

CONSTRUCTION DOCUMENTS

E301

CONSTRUCTION DOCUMENTS

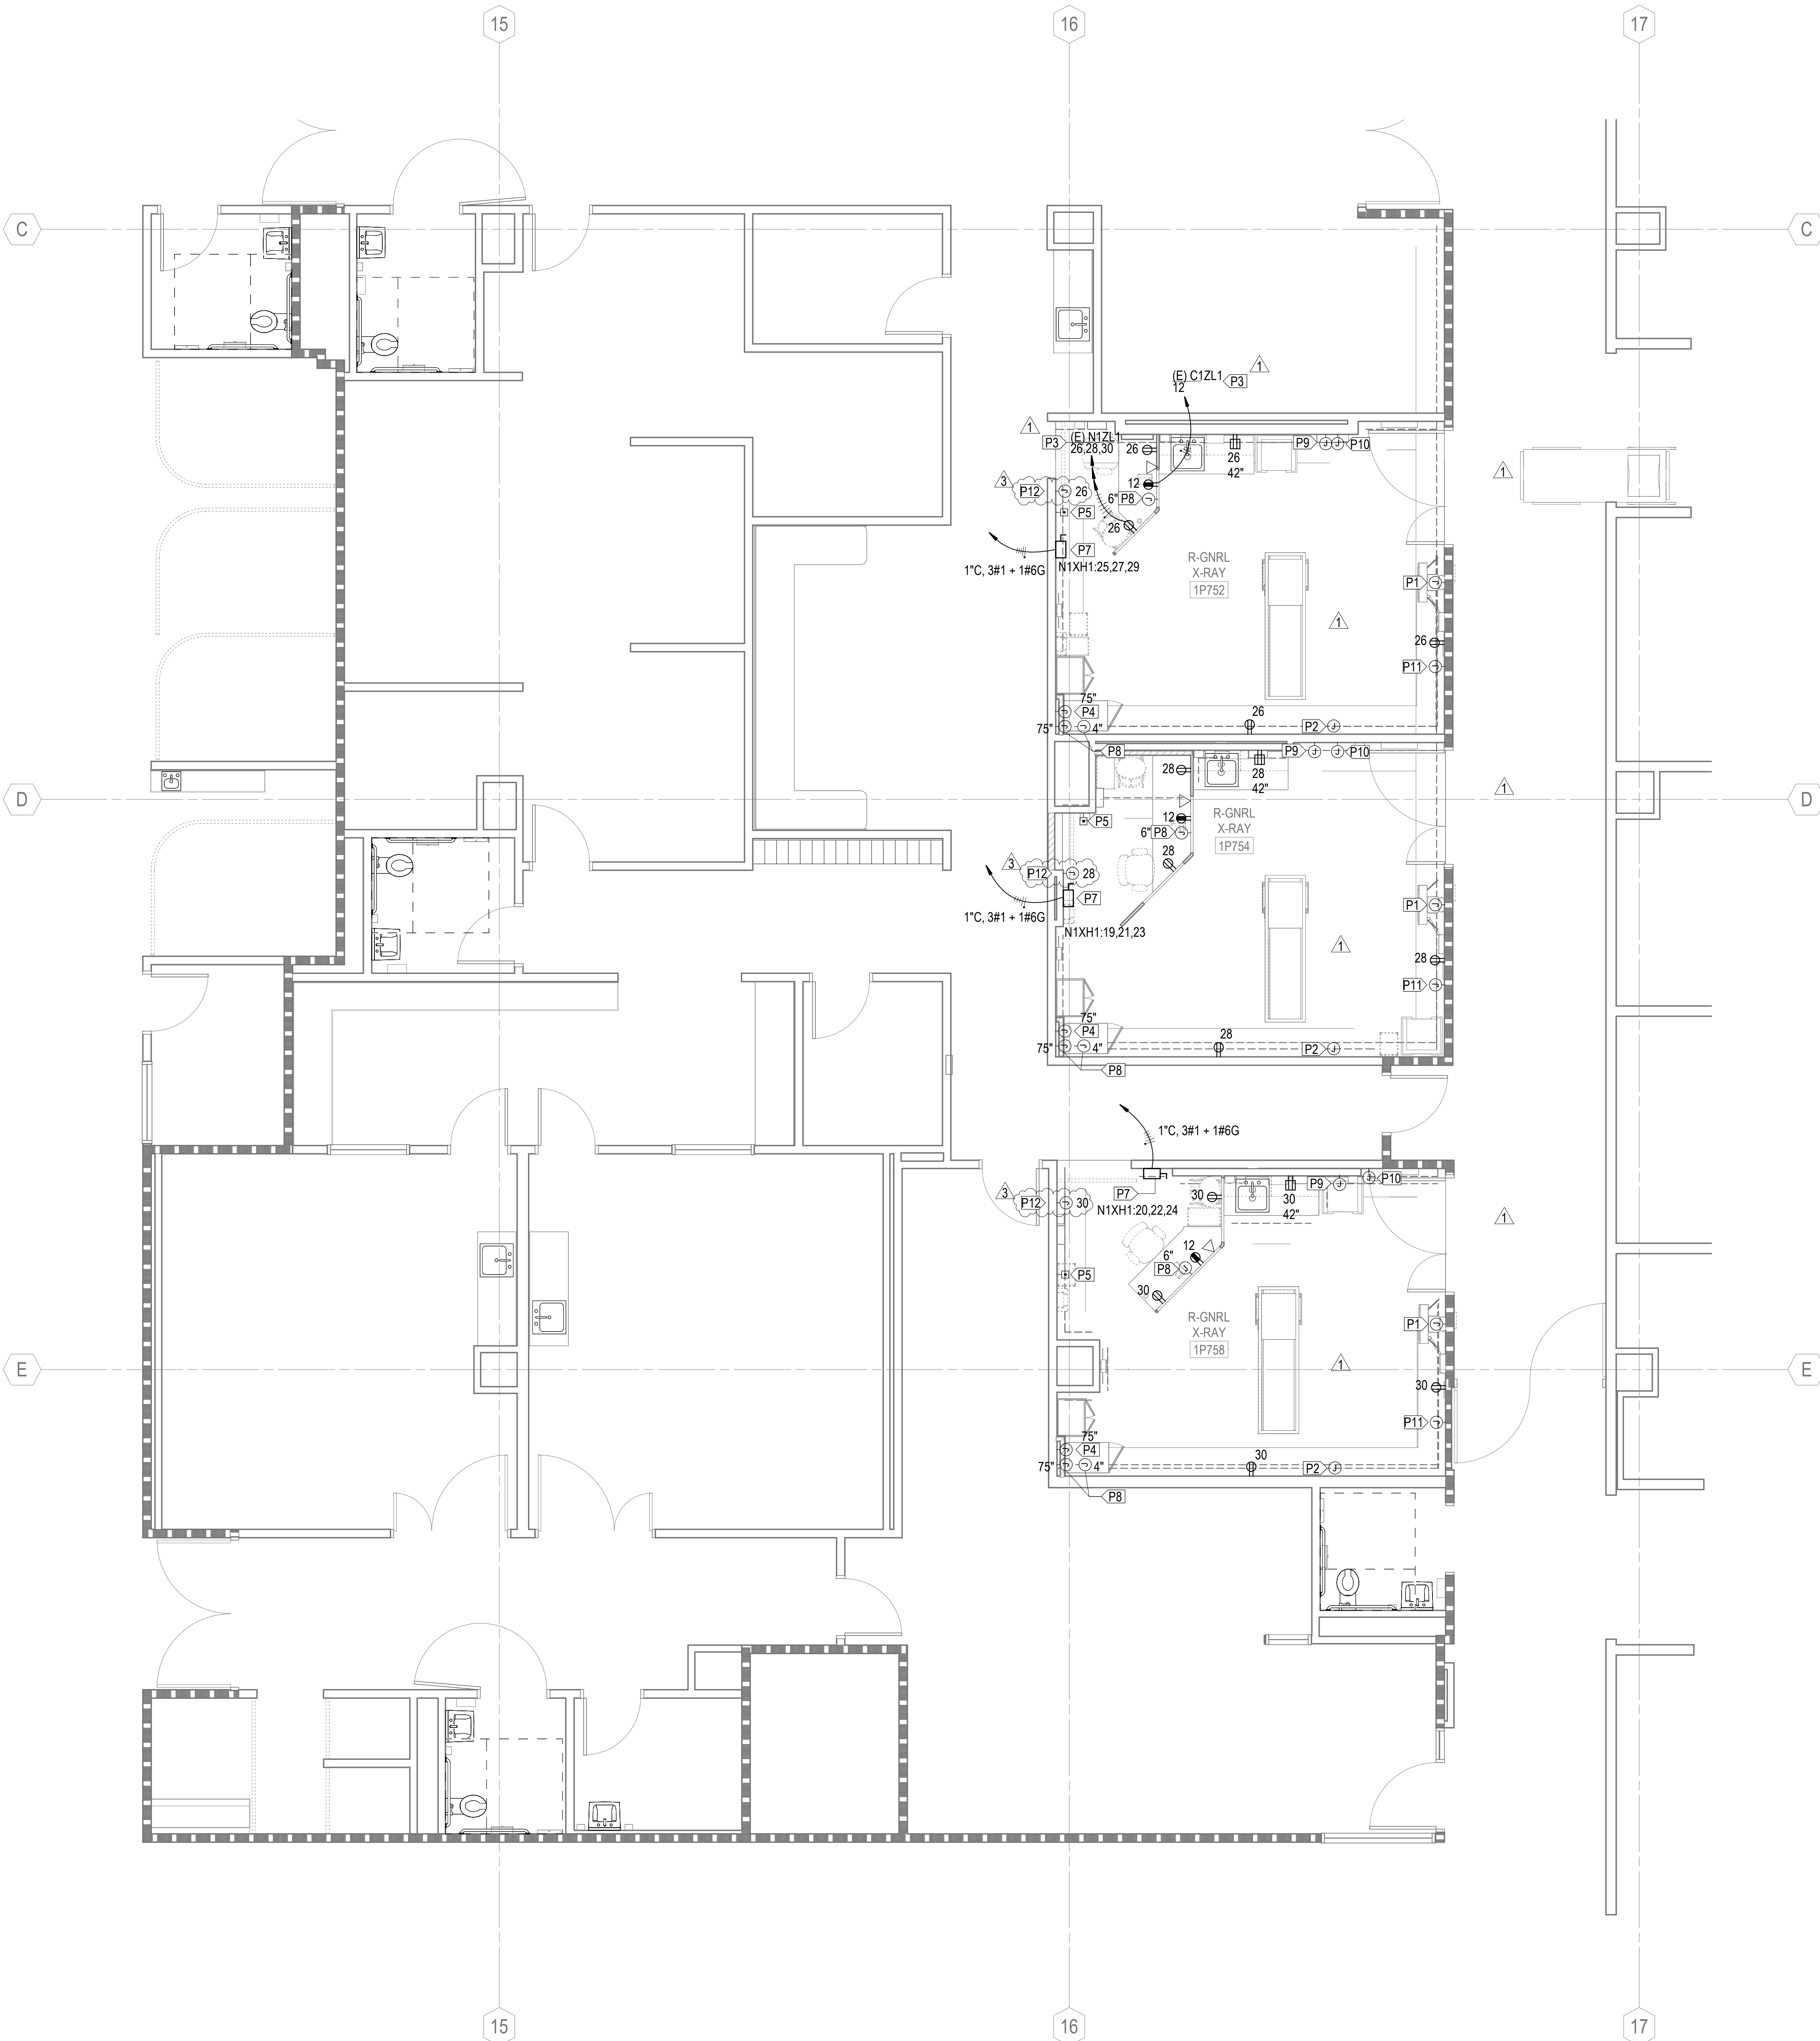

1 POWER PLAN - LEVEL 01
1/4" = 1'-0"

HCAI STAMP

Author: 5/23/2024 4:33:53 PM C:\Users\slm\my Documents\Revit Local Files\E23-UCD1 Gen Real Equip Replacement 1500 14801 - mng\gsa08\ACD1.rvt