# UCDH PROJECT #9557740 SESP 1P742 1P745 CT SCANNER REPLACEMENT

UNIVERSITY OF CA DAVIS, MEDICAL CENTER

2315 STOCKTON BLVD.
SACRAMENTO, CALIFORNIA 95817

100% CONSTRUCTION DOCUMENTS

HCAI BUILDING NO:

CONSTRUCTION TYPE:

FIRE PROTECTION NOTES:

ACCESS TO THE BUILDING, CBC 2022.

SPC RATING: HCAI NPC RATING:

OCCUPANCY:

EXISTS & EXIT

TRAVEL DISTANCE:

AREA OF WORK:

BLD-02841

2,450 SQ FT

NO NEW SQUARE FOOTAGE ADDED, TENANT IMPROVEMENT ONLY

I-2 (EXISTING UNCHANGED)

EXISTING UNCHANGED

2. FLAME SPREAD CLASS OF INTERIOR SURFACES SHALL COMPLY WITH TABLE 8-B.

1-A FULLY SPRINKLERED (EXISTING UNCHANGED)

1. A "KONX" BRAND KEY BOX SHALL BE INSTALLED ON THE PREMISES TO FACILITATE EMERGENCY



FIRE ALARM

ATTACHMENTS FOR EQUIPMENT WITH HAZARDOUS CONTENTS TO BE SHOWN ON CONSTRUCTION

2. ALL EQUIPMENT REQUIRED ANCHORAGE WHETHER INSTALLED BY CONTRACTOR OR BY THE OWNER SHALL BE

ANCHORED, SUPPORTED AND BRACED IN ACCORDANCE WITH CBC 2022 TITLE 24, TABLE 16A HORIZONTAL FORCE


FACTORS


3. NON-MERCURY CONTAINING RELAYS, SWITCHES, THERMOSTATS AND OTHER SIMILAR COMPONENTS SHALL BE USED

DOCUMENTS RESPECTIVE OF WEIGHTS.

THROUGH OUT PROJECT.

### **VICINITY MAP GENERA** PROJECT LOCATION -SURGERY AND EMERGENCY A632 SERVICES PAVILION, 1ST FLOOR 2315 STOCKTON BLVD, SACRAMENTO, CA 95817 PROJECT TEAM UCDH MEDICAL CENTER R&A ENGINEERING SOLUTIONS, INC. 2315 STOCKTON BOULEVARD 601 UNIVERSITY AVENUE, SUITE 255 SACRAMENTO, CA 95817 SACRAMENTO, CA 95825 (916) 920-5965 CONTACT: ZACH PRICE CONTACT: SCOTT CROSBY NACHT & LEWIS ARCHITECTS **EDGE ELECTRICAL CONSULTING** 600 Q STREET, SUITE 100 400 R STREET, SUITE 333 SACRAMENTO, CA 95811 SACRAMENTO, CA 95811 (916) 329-4000 (916) 256-2460 CONTACT: JOHN FLATH **CONTACT: GORDON WONG** 600 Q STREET, SUITE 200 SACRAMENTO, CA 95811 (916) 443-0303 CONTACT: JASON PASSALACQUA P602 PROJECT DATA PROJECT LOCATION: SURGERY AND EMERGENCY SERVICES PAVILION, 1ST FLOOR SACRAMENTO, CA 95817 GENERAL SCOPE OF WORK REMODEL OF THE EXISTING CLASS 1 DIAGNOSTIC CT SPACE 1P742 ON THE FIRST FLOOR OF THE SURGERY AND EMERGENCY SERVICES PAVILION (SESP), BUILDING 101 TO PREPARE FOR TWO NEW CT ROOMS THAT E7.01 WILL RECEIVE NEW GE REVOLUTION APEX CT EQUIPMENT E7.02 E7.03 THE PROJECT ALSO INCLUDES A NEW SHARED CONTROL AREA 1P740. UPDATED PATIENT TOILET 1P741 FOR E7.04 ACCESSIBILITY, UPDATED EXISTING READING ROOM 1P743, UPDATED EXISTING DX QC 1P40B WORK AREA, UPDATE TO PATIENT DRESSING 1P715 AND UPDATED STAFF LOCKERS 1P706. WORK INCLUDES BUT IS NOT E7.06 LIMITED TO NON-BEARING PARTITIONS, LEAD SHIELDING, FINISHES, CASEWORK, FURNITURE SYSTEM. E7.07 EQUIPMENT ANCHORAGE, FLOOR SLAB CUTTING AND PATCHING, AND MODIFICATION TO MECHANICAL PLUMBING, AND ELECTRICAL SYSTEMS. 1ST FLOOR (GROUND FLOOR) SURGERY AND EMERGENCY SERVICES PAVILION LOCATION: FACILITY NO:

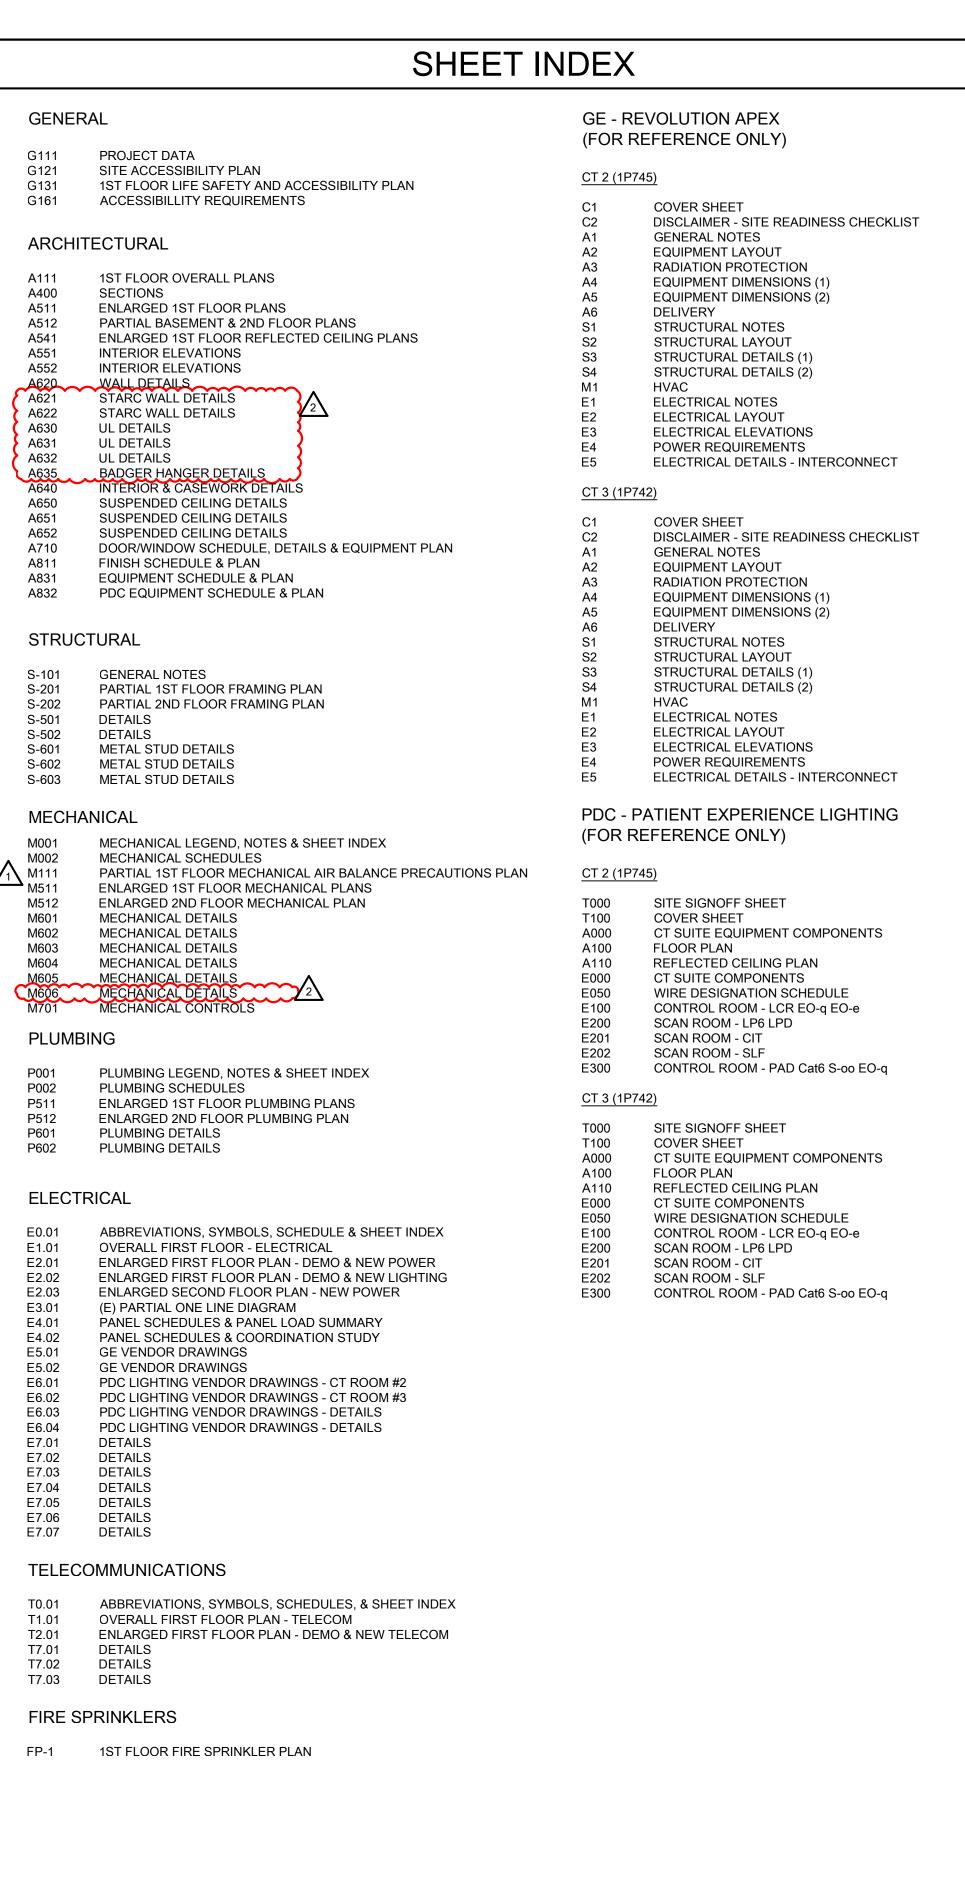

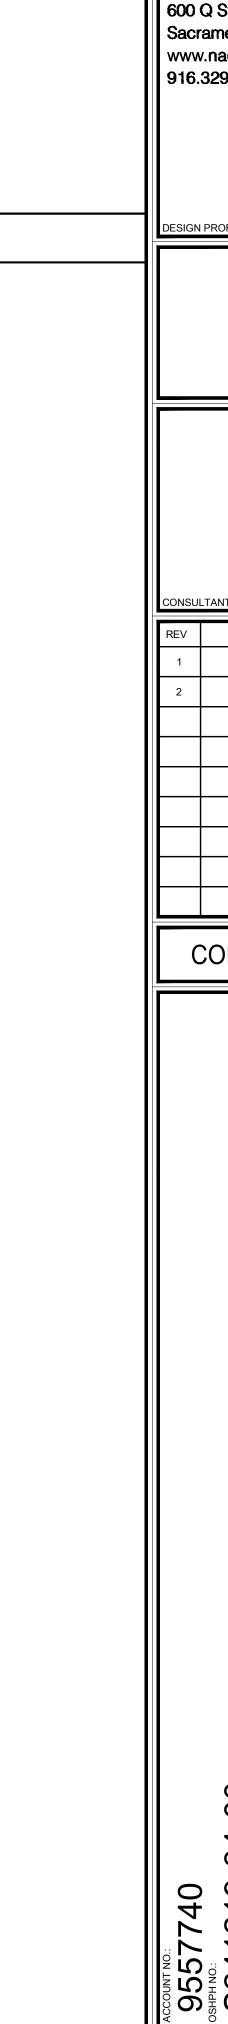

nacht&lewis

600 Q Street, Suite 100 Sacramento, CA 95811 www.nachtlewis.com 916.329.4000

SIGN PROFESSIONALS OF RECORD:

## UC**DAVIS**HEALTH

FACILITIES DESIGN & CONSTRUCTION 4800 2ND AVENUE SUITE 3010 SACRAMENTO, CALIFORNIA 95817

ONSULTANT LOGO:

REV REVISION DESCRIPTION DATE

1 HCAI BACKCHECK 01 11/01/2024

2 ADDENDUM 1 (ACD-001) 10/17/2025

CONSTRUCTION DOCUMENTS

740 219-34-00 02841 - SURGERY AND EMERGENCY SERVICES PAN FLOOR 1P742 1P745 CT SCANNER ACEMENT

ARCH.\ENGR. FD&C JOB NO.


E. TIEN 9557740

JCDMC PROJECT MANAGER SCALE

Z. Price AS SHOWN


DESIGNED BY DATE


NLA 
DRAWN BY CAD FILE SHEET OF

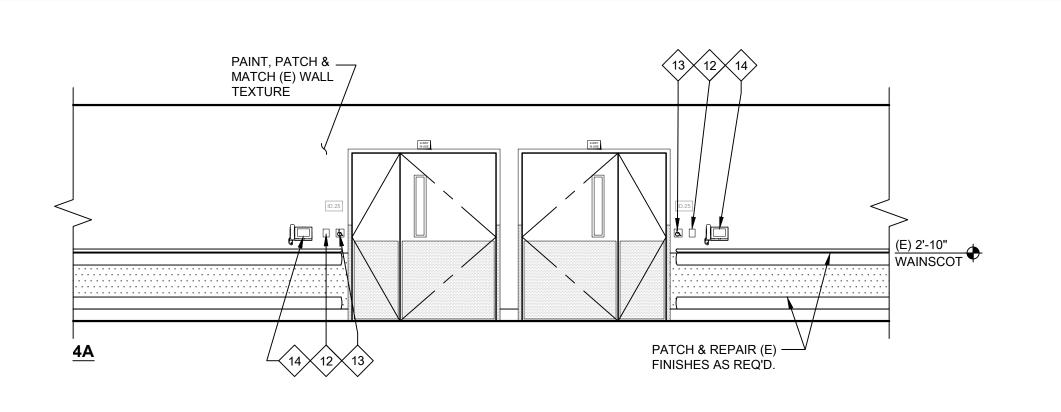


### (E) CORR (1P900)

SCALE: 1/4" = 1'-0"

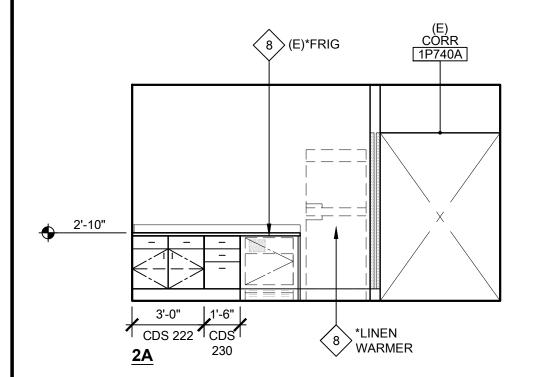


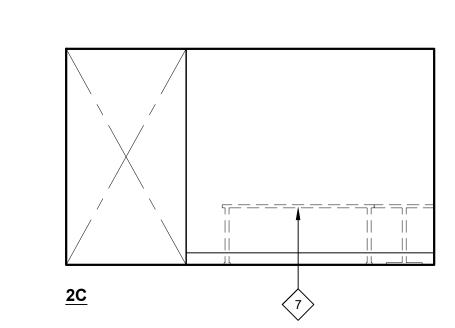


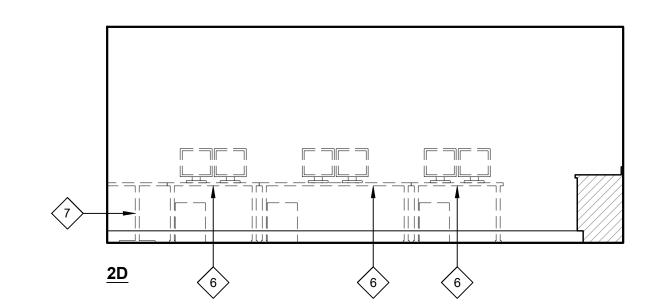


### WORK AREA (1P740B)

SCALE: 1/4" = 1'-0"

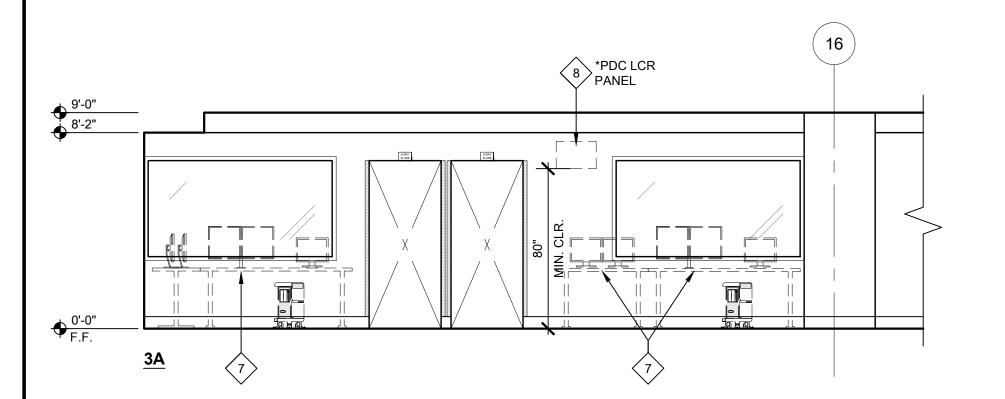


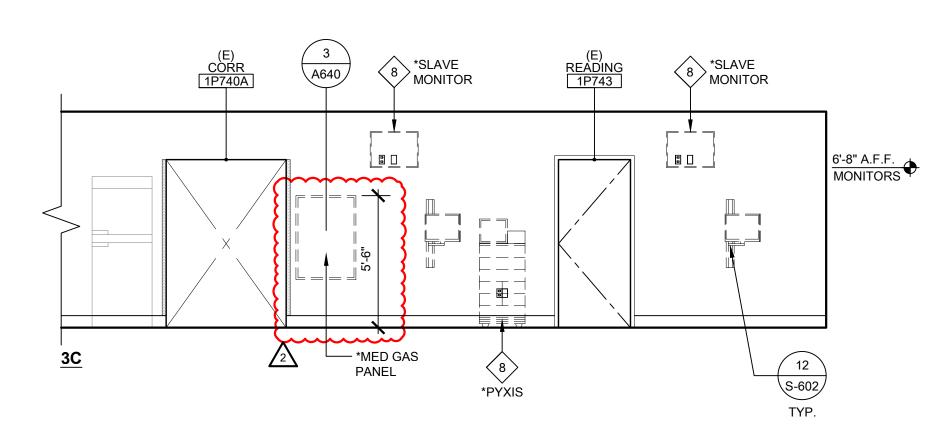


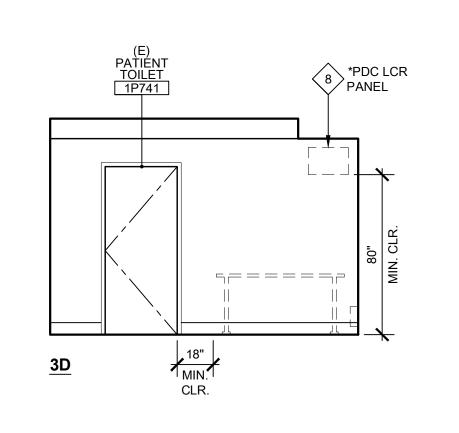



### CONTROL (1P740)

SCALE: 1/4" = 1'-0"

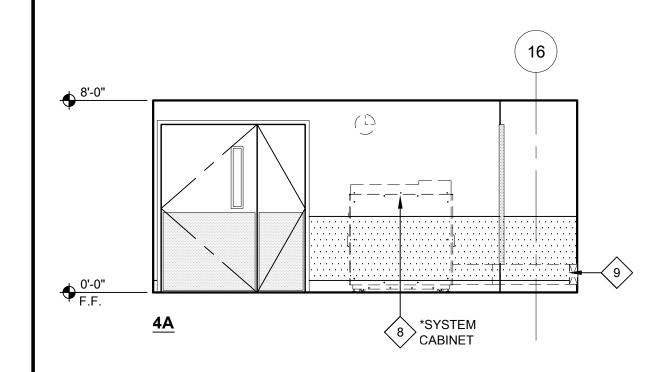

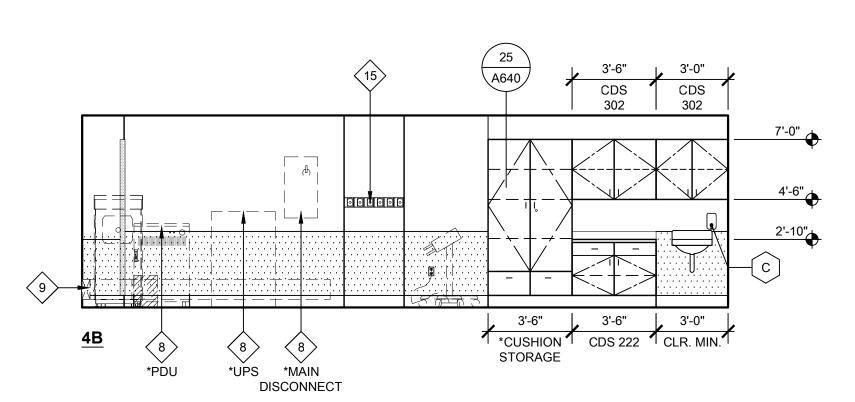


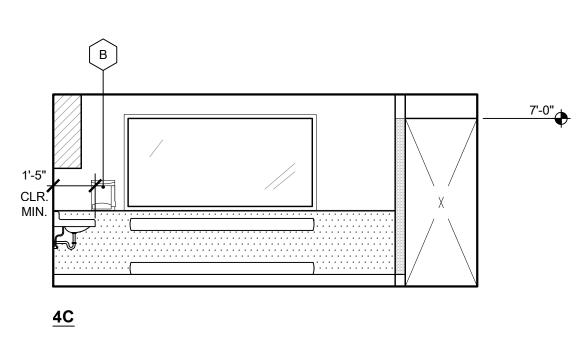


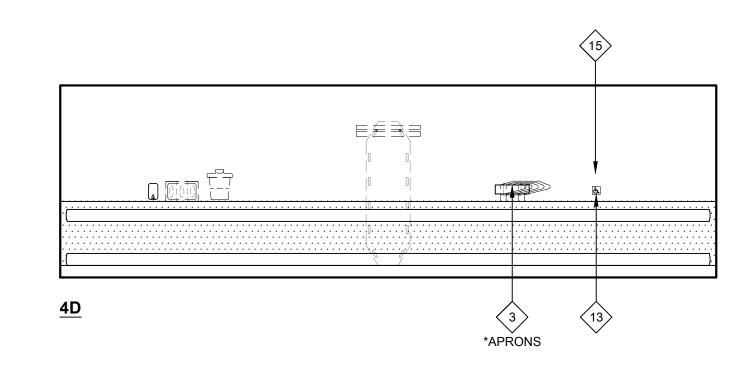



## CT 2 (1P725)

SCALE: 1/4" = 1'-0"

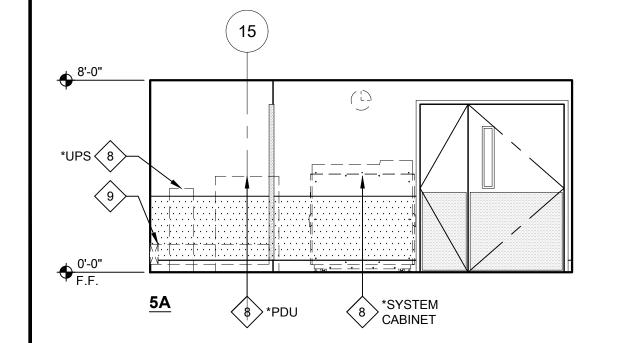

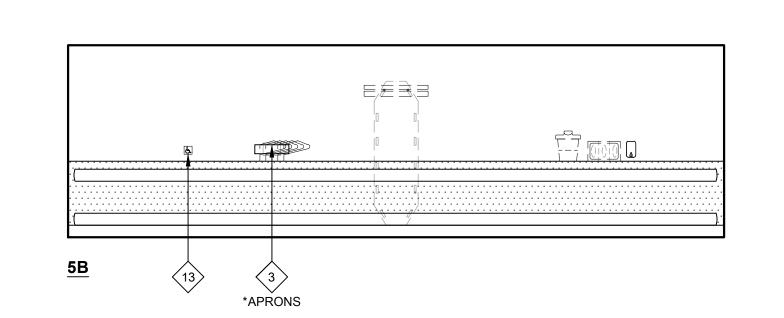

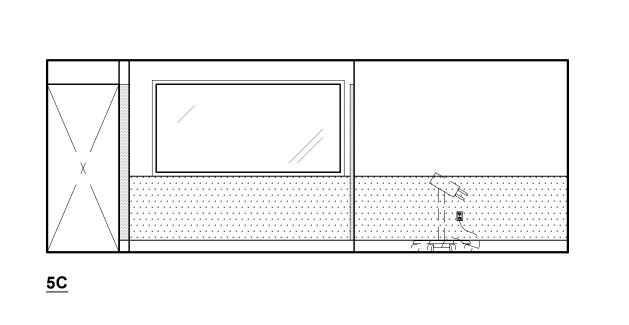

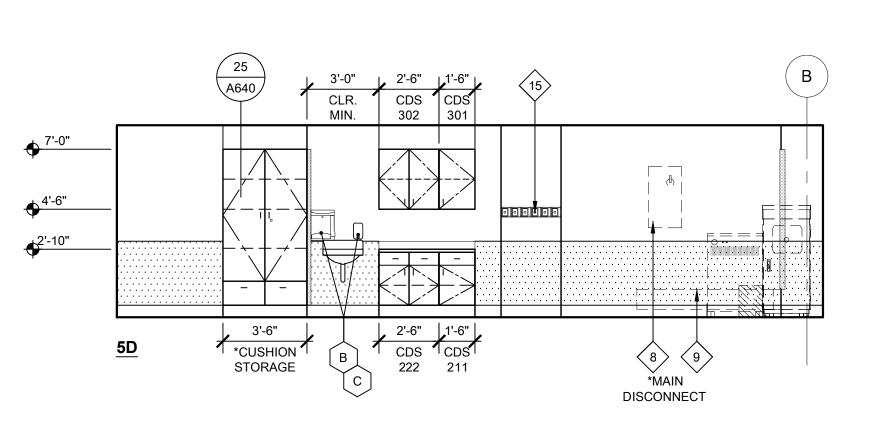

GENERAL SHEET NOTES:

THESE SHEET NOTES APPLY TO THIS SHEET ONLY.

- . THE CONTRACTOR IS RESPONSIBLE FOR ALL INCIDENTAL WORK NECESSARY TO COMPLETE THE INSTALLATION OF NEW WORK. THIS INCLUDES, BUT IS NOT LIMITED TO THE REMOVAL OF EXISTING PORTIONS OF CONSTRUCTION WHETHER SHOWN OR NOT.
- TEMPORARY CONSTRUCTION BARRIER WALLS WILL BE REQUIRED AT VARIOUS TIMES DURING THE STAGES OF WORK. COORDINATE WITH FACILITY ENGINEER
  - TO DETERMINE THE TIMING OR SEQUENCE OF WHEN THE BARRIER WALLS WILL BE REQUIRED IN RELATIONSHIP TO THE STAGING OF WORK. 3. COORDINATE WITH THE FACILITY ENGINEER FOR ESTABLISHING TEMPORARY

DUST BARRIERS BETWEEN AREAS BEING RENOVATED AND THOSE AREAS

- REMAINING OCCUPIED DURING RENOVATION WORK. 4. SEE SHEET A811 FOR FLOOR FINISH PLAN AND FINISH SCHEDULE.
- 5. SEE SHEETS A831 FOR EQUIPMENT PLAN AND SCHEDULE.

### **KEYNOTES:**

NOT ALL KEYNOTES APPLY TO THIS SHEET.

HANDWASH FIXTURE W/ HOT & COLD MIXING FAUCET, SEE PLUMB. DWGS.

- SEE DTLS. 11&12/A640 AND PLUMB. DWG'S. F.A.I. 3 COUNTERTOP
- 4 TYPICAL CASEWORK, SEE SHEET A640 F.A.I.
- 5 WALL PROTECTION, SEE FINISH PLAN & SCHEDULE F.A.I.
- 6 ADJUSTABLE HEIGHT DESK, N.I.C., O.F.V.I.
- ⟨ 7 ⟩ FURNITURE, N.I.C., O.F.V.I.
- EQUIPMENT, PROVIDE STRUCT. FRAMING / BACKING / SEISMIC BRACING AS
- FLUSH MOUNT ELECTRICAL RACEWAY, SEE ELEC. DWGS. AND MFR. DWGS. 9 FOR ADD'L. INFO.
- (10) RELOCATED MEDGAS ZONE VALVE BOX, SEE DTL. 3/A640
- (11) FIRE EXTINGUISHER CABINET, SEE DTL. 2/A640
- CARD READER, PROVIDE CLEAR SPACE OF 30" x 48" WITH A MAXIMUM REACH OF 48" AFF.
- (13) DOOR ACTIVATION PUSH PLATE
- (14) AI PHONE / MONITOR
- (15) MEDGAS OUTLETS, SEE PLUMB. DWGS. F.A.I.

### MISC. TOILET ACCESSORIES (CFCI, UON):

NOT ALL KEYNOTES APPLY TO THIS SHEET

- (A) COAT HOOK, B-7672
- B PAPER TOWEL DISPENSER
- C SOAP DISPENSERS O.F.O.I.
- D 18" x 54" MIRROR

DEPARTMENT OF HEALTHCARE ACCESS AND INFORMATION:

600 Q Street, Suite 100 Sacramento, CA 95811 www.nachtlewis.com 916.329.4000



DESIGN PROFESSIONALS OF RECORD:

### **UCDAVIS** HEALTH

FACILITIES DESIGN & CONSTRUCTION 4800 2ND AVENUE SUITE 3010 SACRAMENTO, CALIFORNIA 95817 (916)734-7024

CONSULTANT LOGO:


REVISION DESCRIPTION DATE ADDENDUM 1 (ACD-001) 10/17/2025


### CONSTRUCTION DOCUMENTS


ACCOUNT NO.:
9557740
OSHPH NO.:
\$241219-34-(
BUILDING:
BLD-02841 FLOORWING:
1ST FLOOR


9557740 0SHPH NO:	SCTITLE:	EPLACE	INTERIOR ELEVATIONS	
ARCH.\ENGR.	FD&C JOB NO.	SHEE	T NO.	
E. TIEN	9557740			
UCDMC PROJECT MANAGER	SCALE	A551		
Z. Price	AS SHOWN	HUUN		
DESIGNED BY	DATE			
NLA	-			
DRAWN BY	CAD FILE	SHEET	OF	
NLA NLA				


CT 3 (1P742) SCALE: 1/4" = 1'-0"

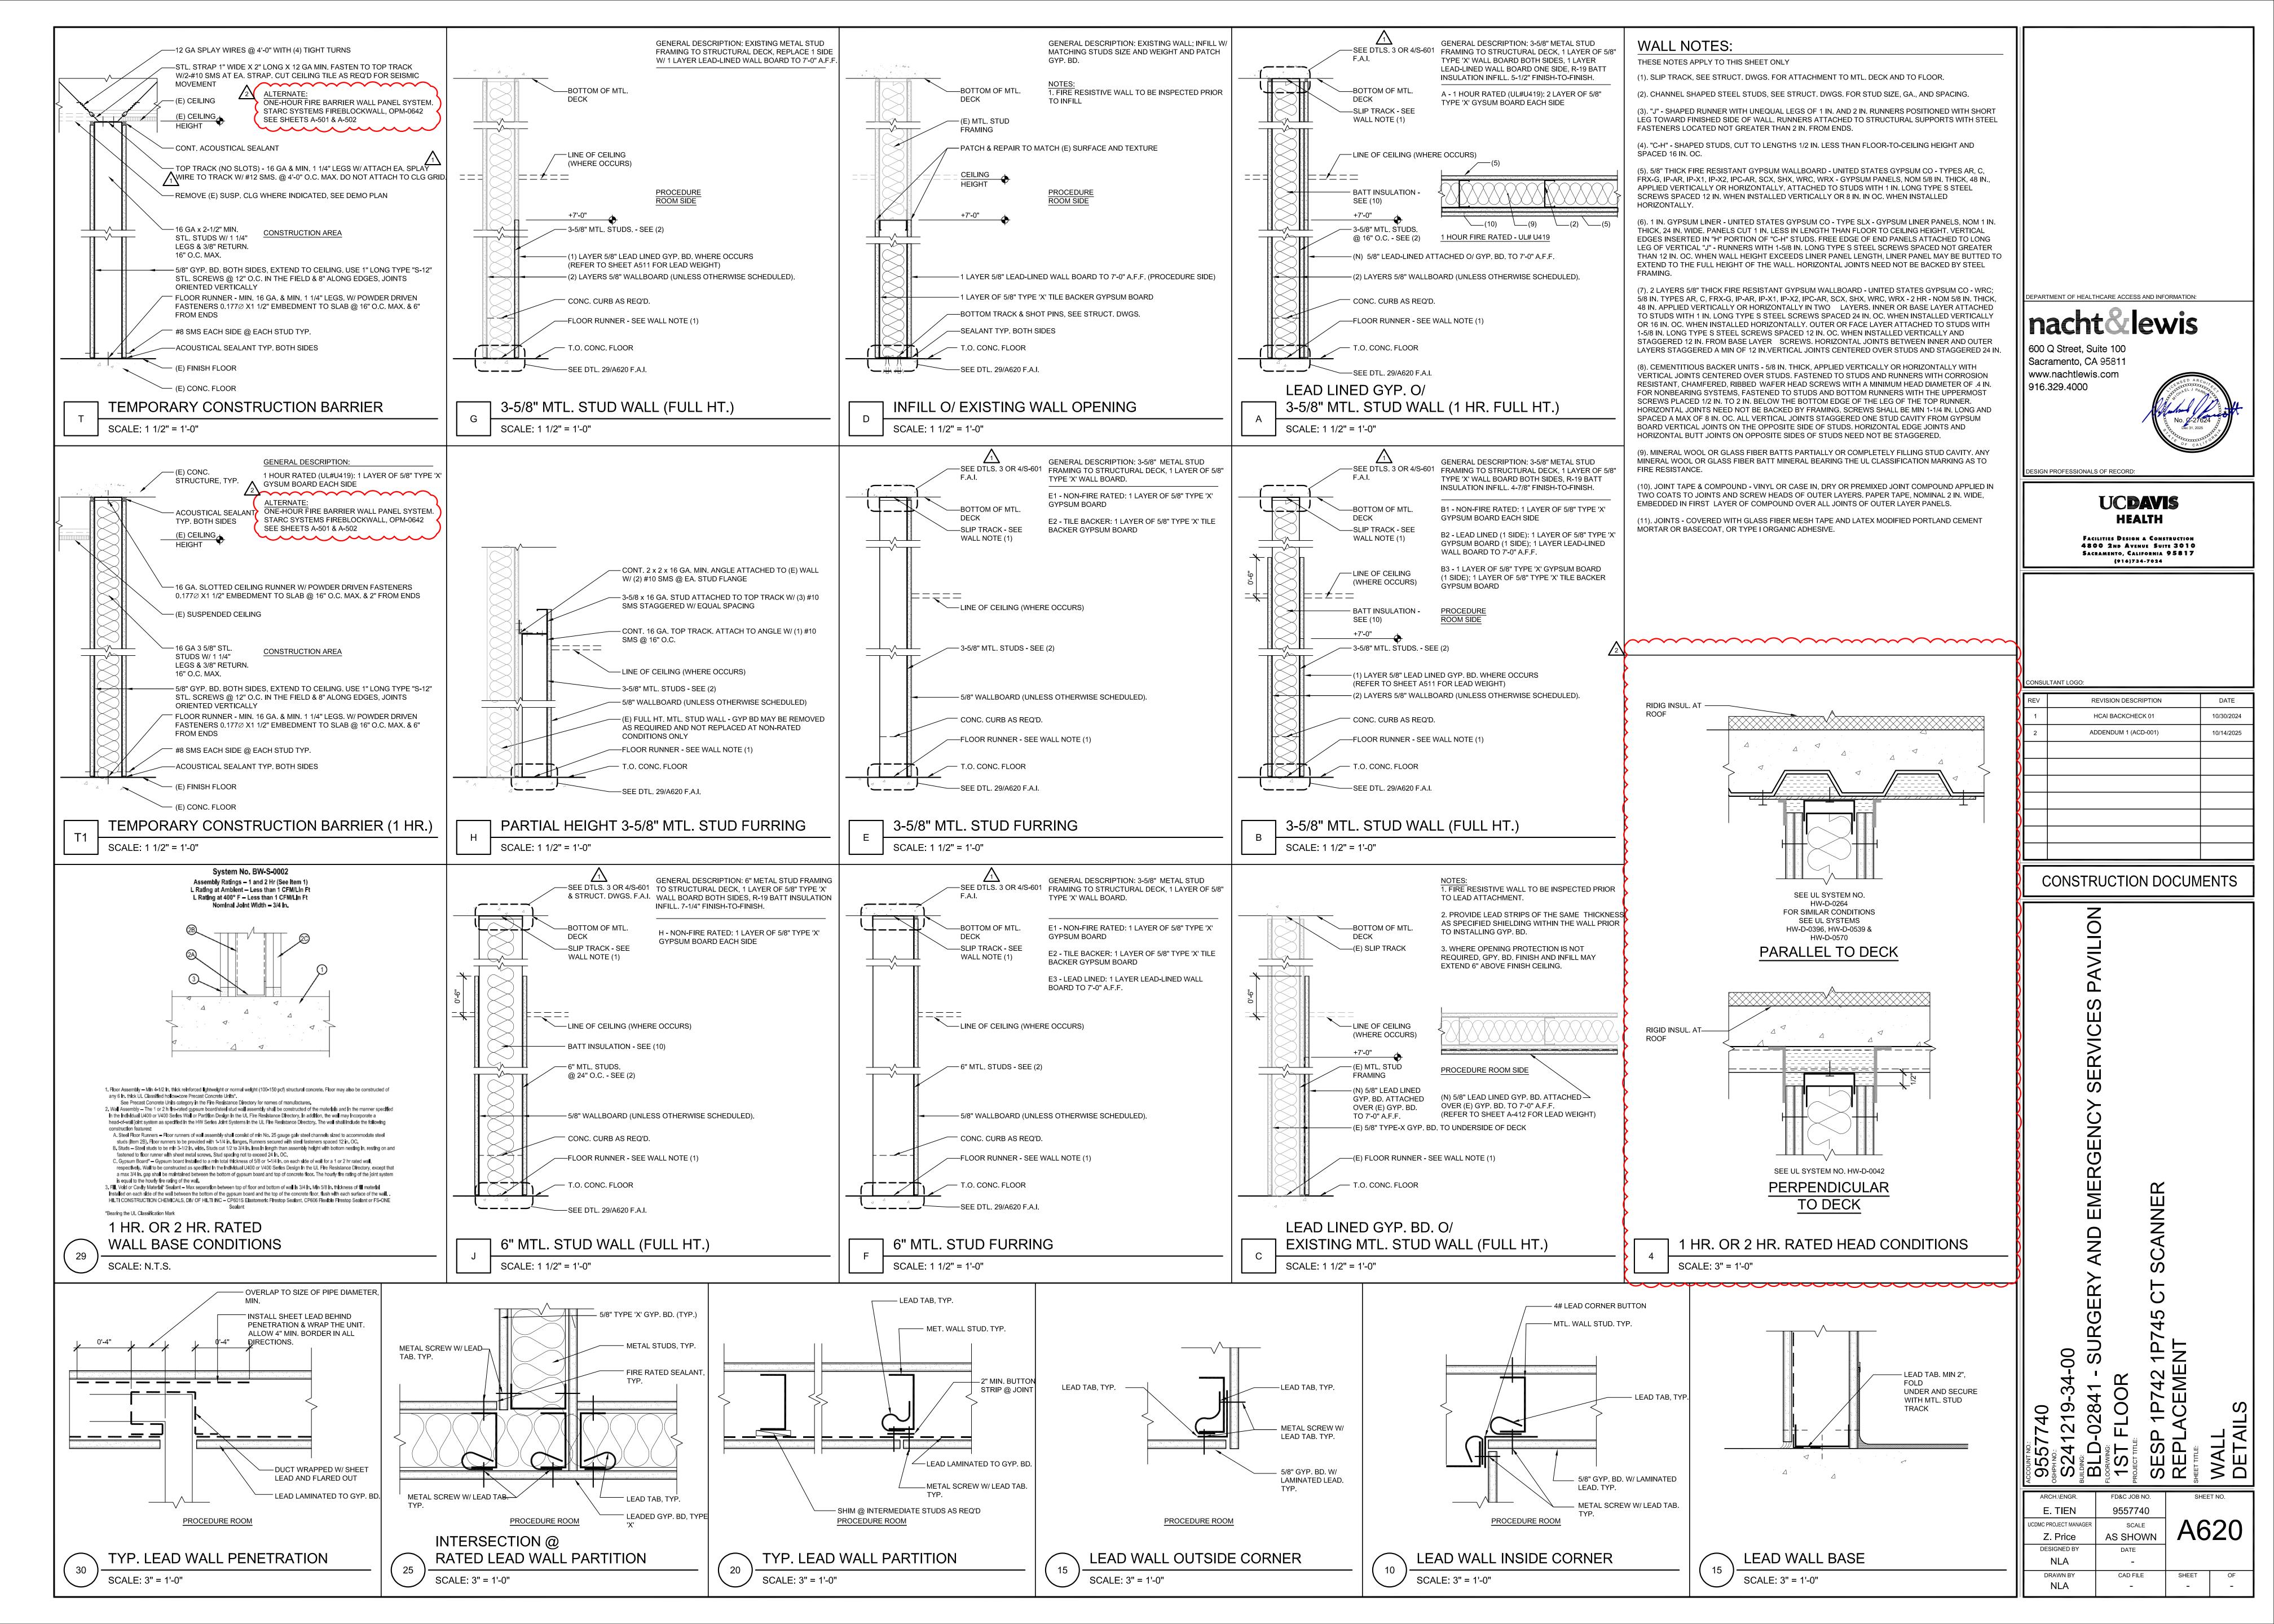


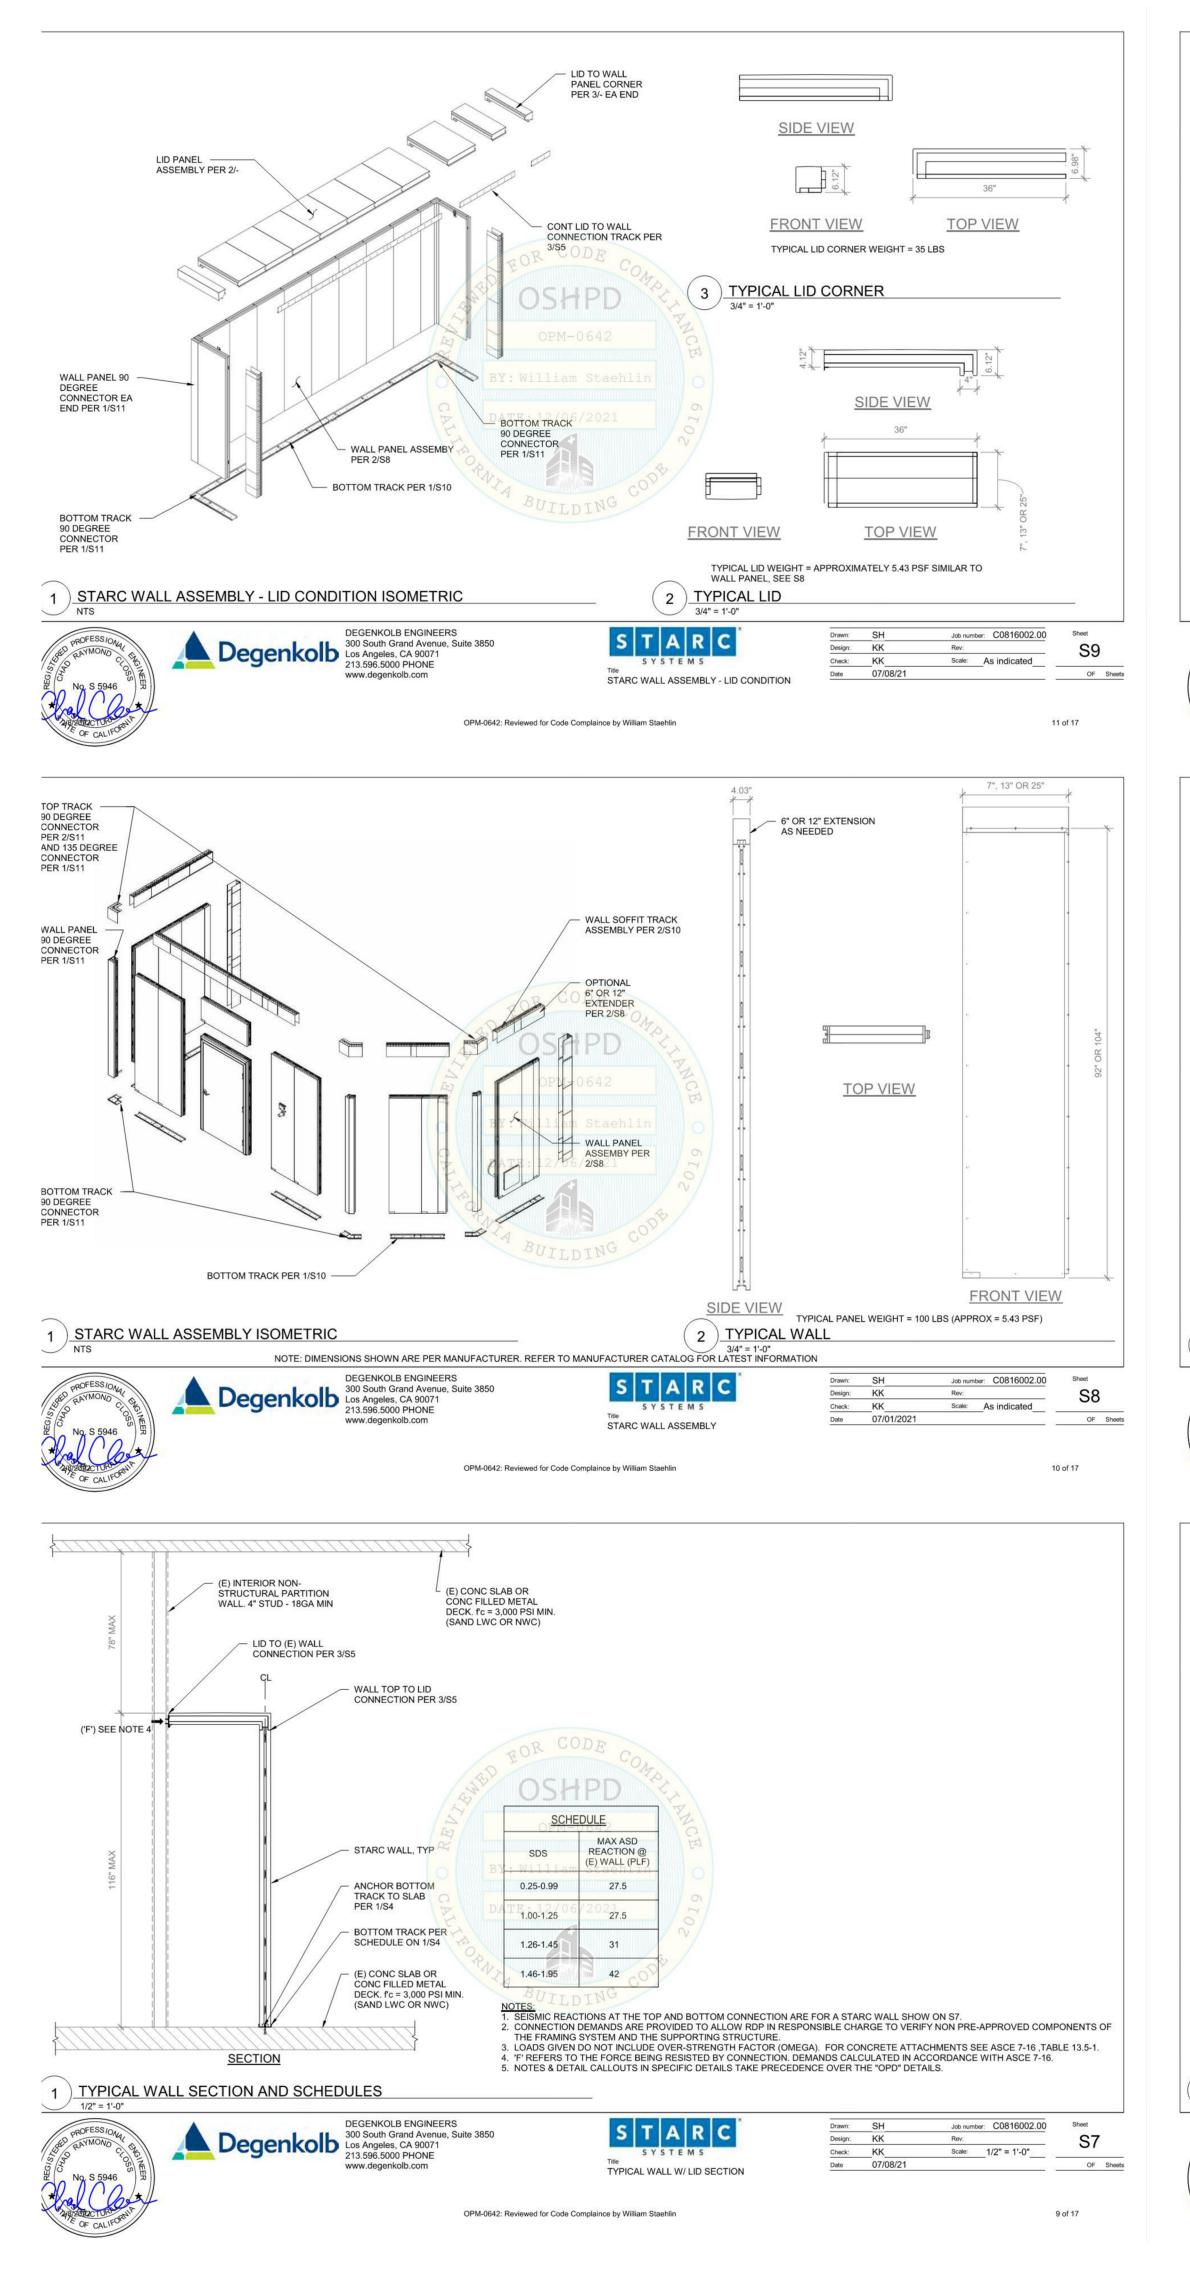


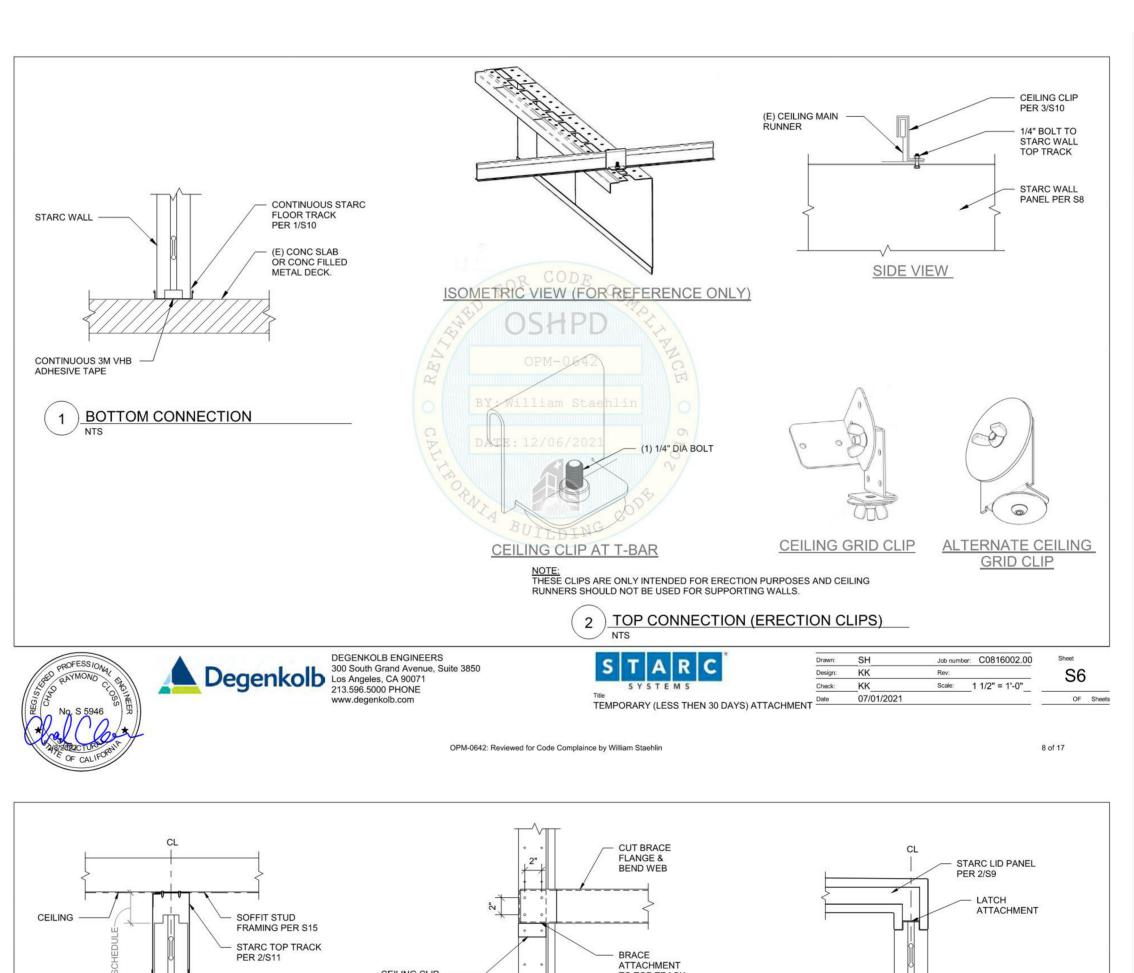

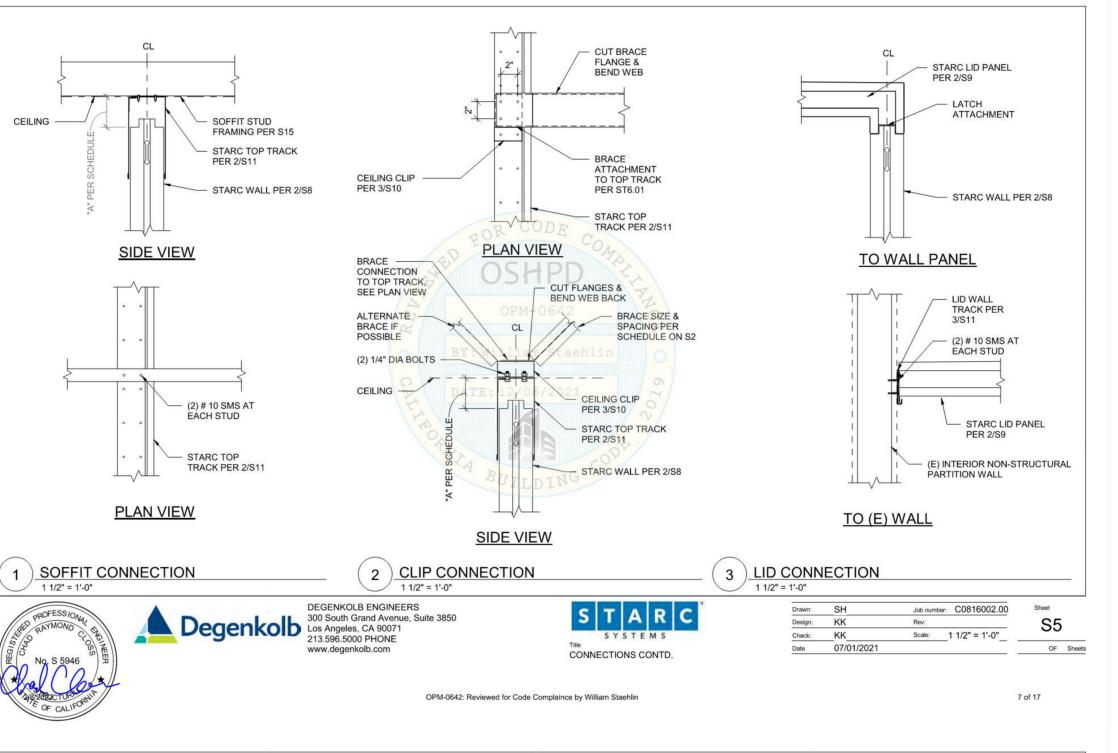

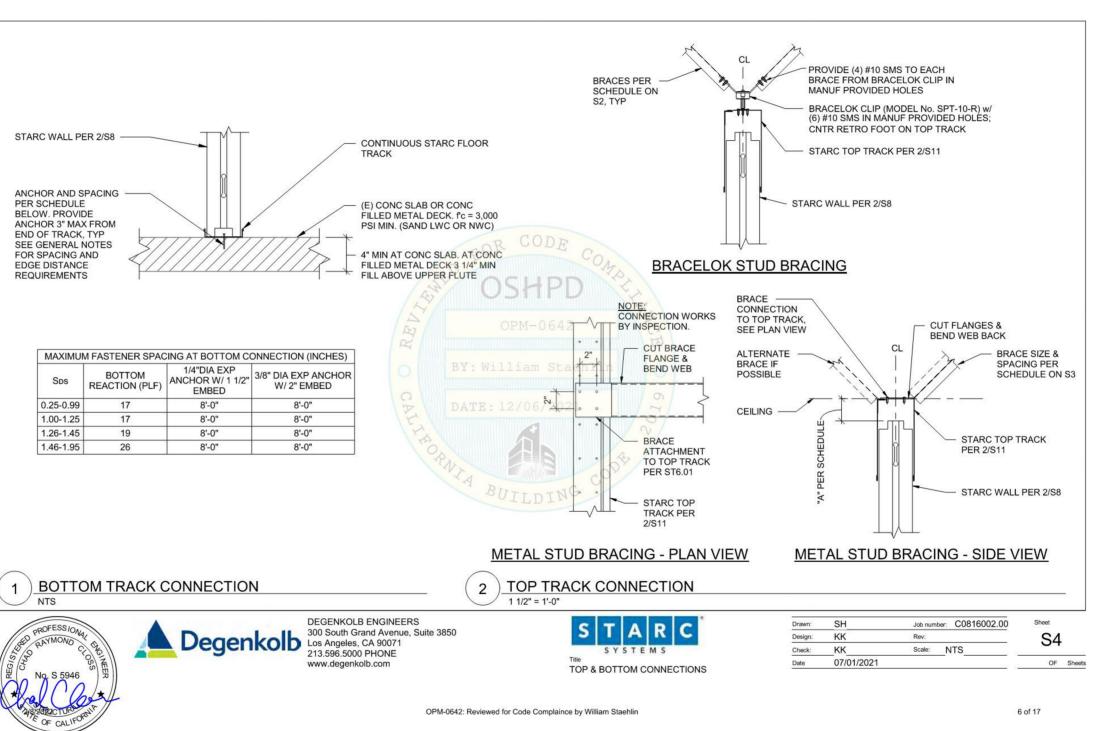

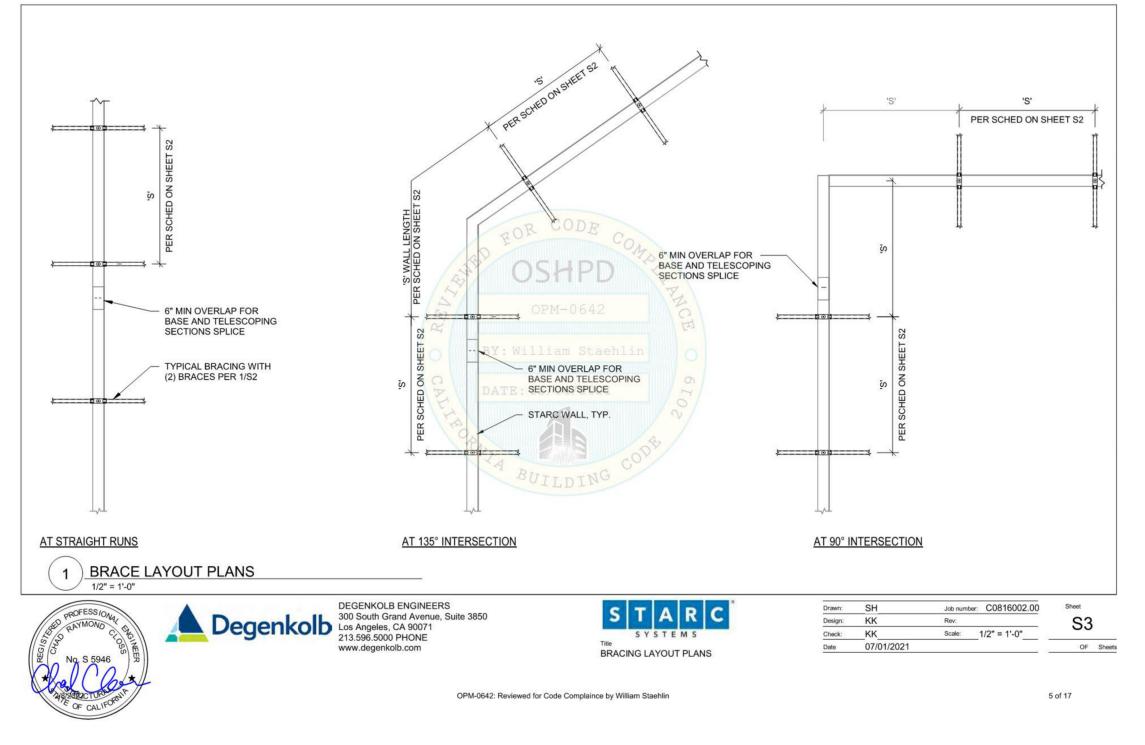

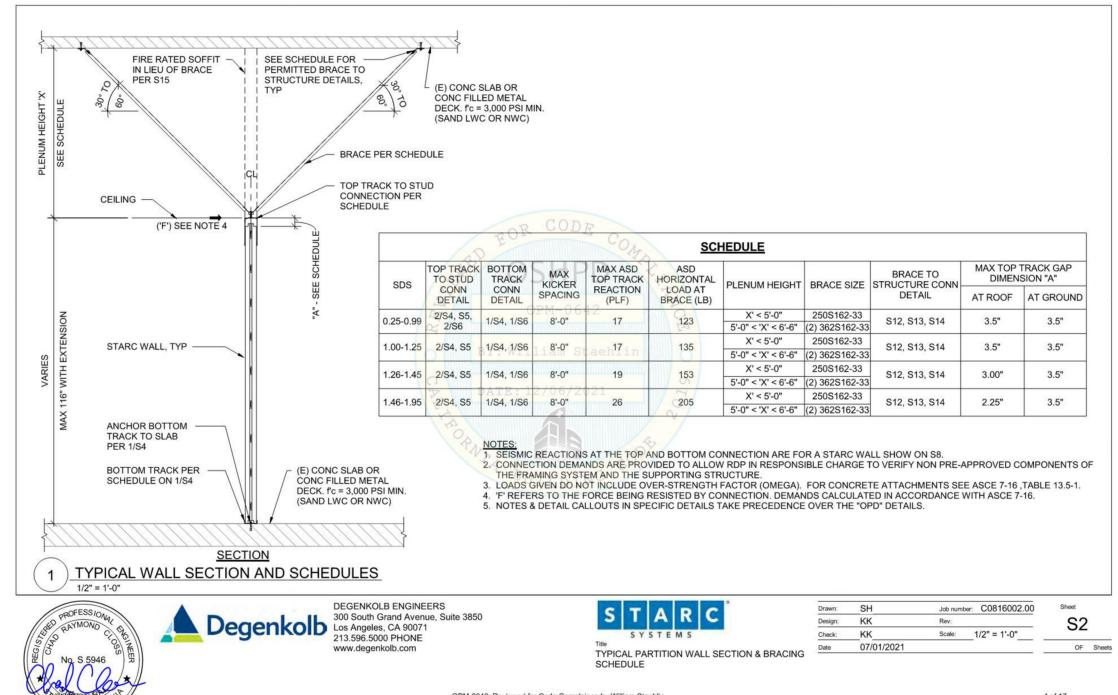



GENERAL NOTES


OPM-0642: Reviewed for Code Complaince by William Staehlin

DEGENKOLB ENGINEERS

213.596.5000 PHONE www.degenkolb.com

Degenkolb 300 South Grand Avenu

300 South Grand Avenue. Suite 3850

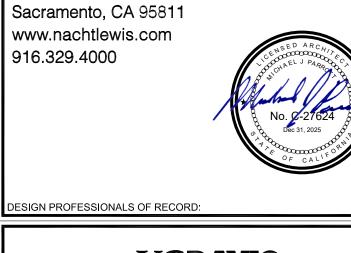

EPARTMENT OF HEALTHCARE ACCESS AND INFORMATION:

600 Q Street, Suite 100

UCDAVIS
HEALTH
FACILITIES DESIGN & CONSTRUCTION

4800 2nd Avenue Suite 3010 SACRAMENTO, CALIFORNIA 95817

(916)734-7024

CONSULTANT LOGO:

REV REVISION DESCRIPTION D.

2 ADDENDUM 1 (ACD-001) 10/1-

REV	REVISION DESCRIPTION	DATE
2	ADDENDUM 1 (ACD-001)	10/14/2025

### CONSTRUCTION DOCUMENTS

URGERY AND EMERGENCY SERVICES PAVILION P745 CT SCANNER


Job number: C0816002.00 Sheet

Check: KK 07/01/2021

Rev: S1
Scale: NTS OF Sheets

3 of 17

			S D
ARCH.\ENGR.	FD&C JOB NO.	SHEE	T NO.
E. TIEN	9557740	2	
CDMC PROJECT MANAGER	SCALE	TXX	71
Z. Price	AS SHOWN	(AU	
DESIGNED BY	DATE		
NLA	-		
DRAWN BY	CAD FILE	SHEET	OF

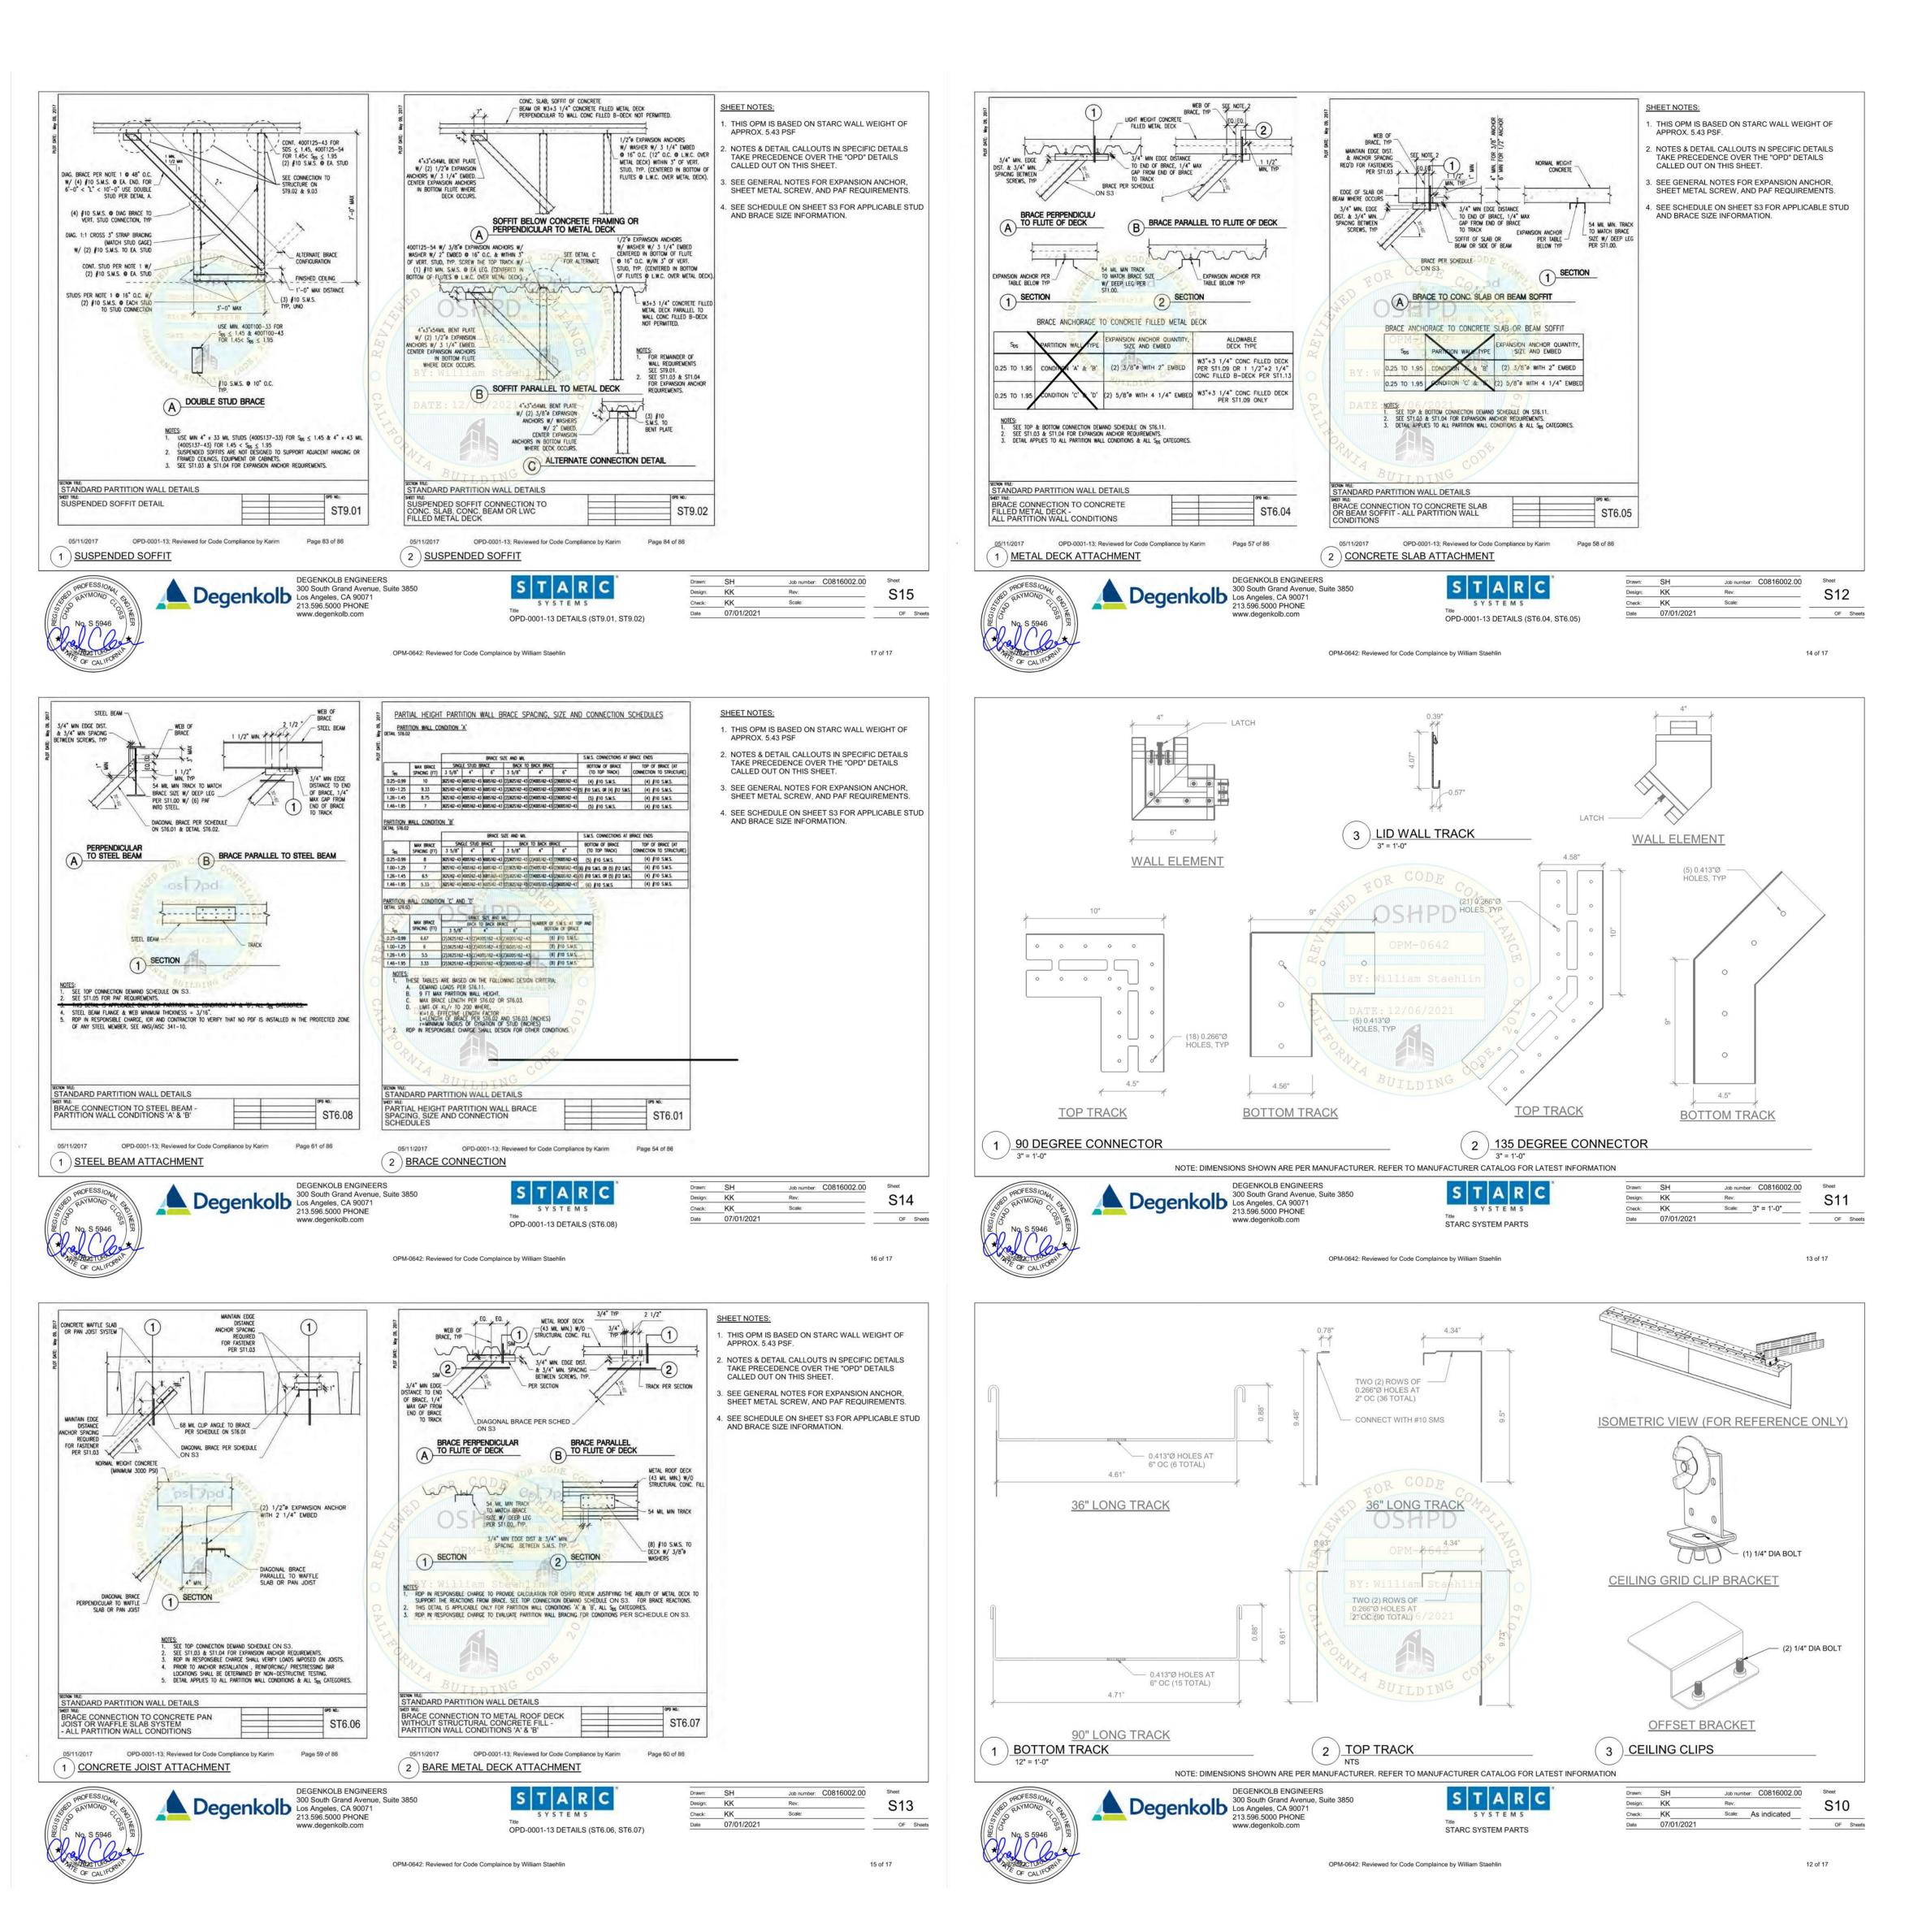

DEPARTMENT OF HEALTHCARE ACCESS AND INFORMATION:

600 Q Street, Suite 100 Sacramento, CA 95811 www.nachtlewis.com 916.329.4000

DESIGN PROFESSIONALS OF RECORD:

**UCDAVIS** HEALTH FACILITIES DESIGN & CONSTRUCTION 4800 2nd Avenue Suite 3010


SACRAMENTO, CALIFORNIA 95817

(916)734-7024

CONSULTANT LOGO: DATE REVISION DESCRIPTION ADDENDUM 1 (ACD-001) 10/14/2025

**CONSTRUCTION DOCUMENTS** RG

ARCH.\ENGR. FD&C JOB NO. E. TIEN 9557740 UCDMC PROJECT MANAGER Z. Price AS SHOWN DESIGNED BY NLA DRAWN BY SHEET

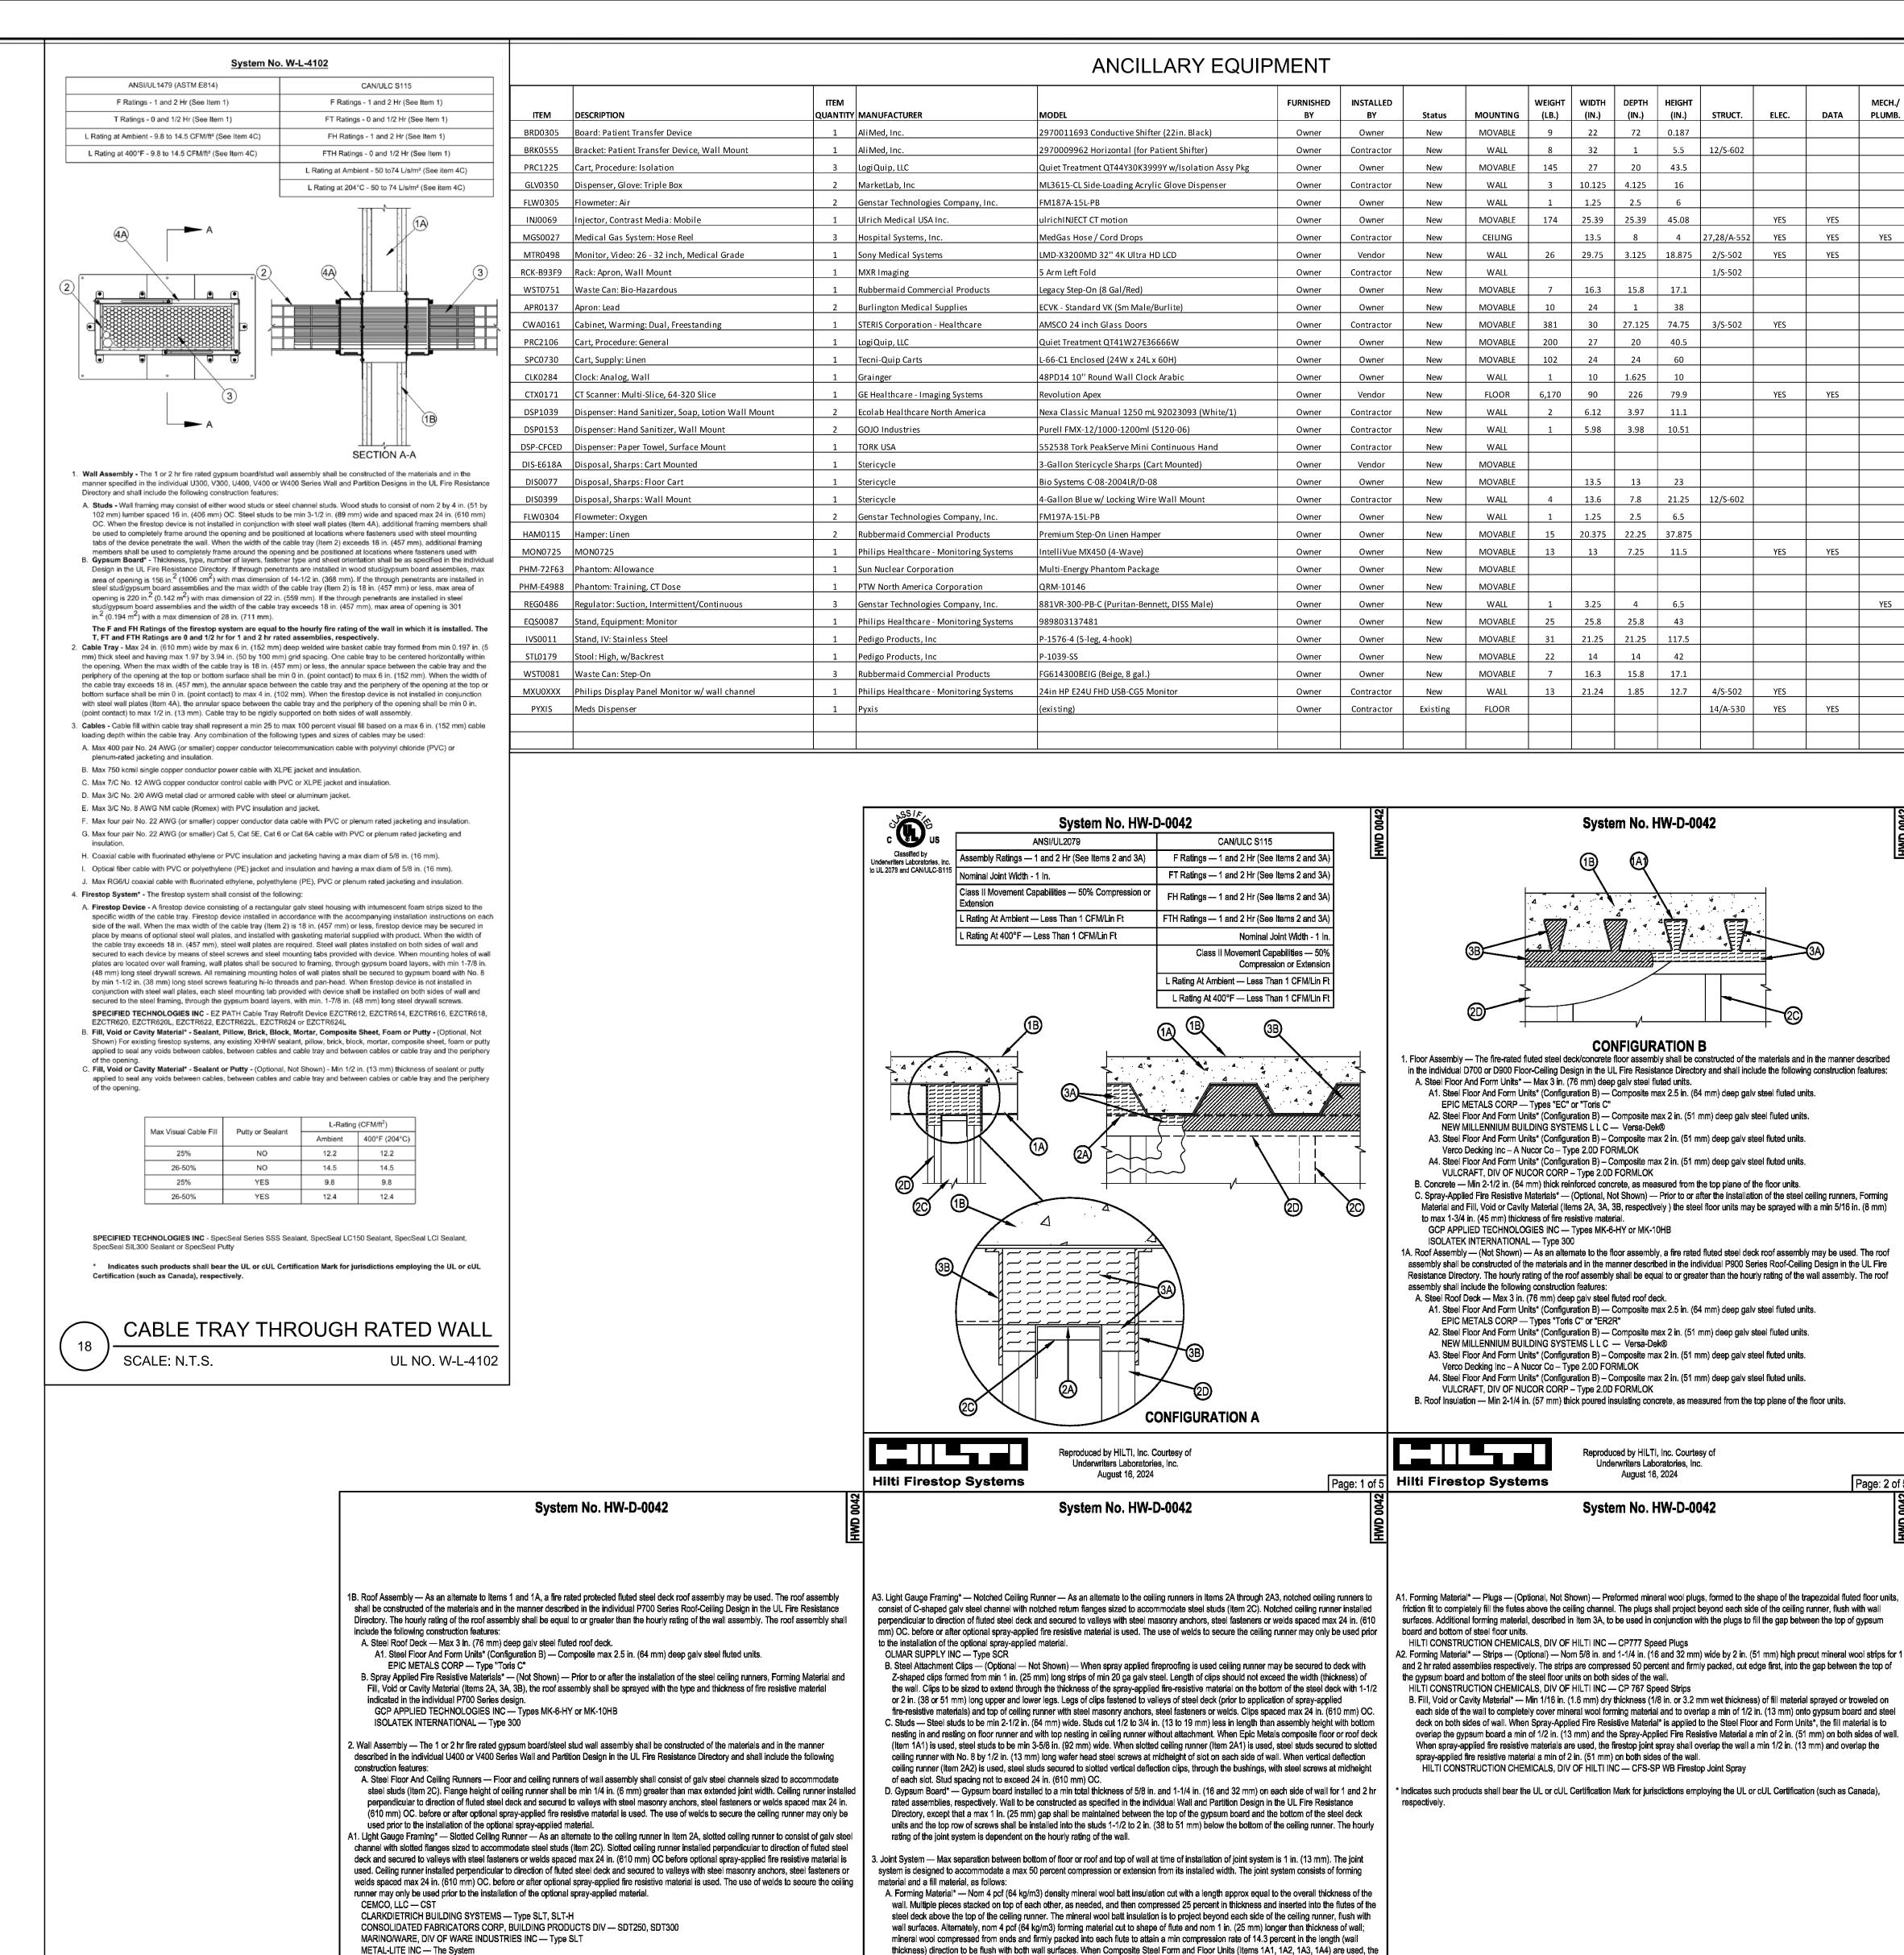

916.329.4000 DESIGN PROFESSIONALS OF RECORD: **UCDAVIS** HEALTH FACILITIES DESIGN & CONSTRUCTION 4800 2nd Avenue Suite 3010 SACRAMENTO, CALIFORNIA 95817 (916)734-7024 CONSULTANT LOGO: REVISION DESCRIPTION HCAI BACKCHECK 01 ADDENDUM 1 (ACD-001) **CONSTRUCTION DOCUMENTS** 

DATE

10/30/2024

10/14/2025

DEPARTMENT OF HEALTHCARE ACCESS AND INFORMATION:

600 Q Street, Suite 100

Sacramento, CA 95811

www.nachtlewis.com

DATA

PLUMB.

Ž

Page: 2 of 5

Page: 5 of 5

eproduced by HILTI, Inc. Courtesy of

Underwriters Laboratories, Inc.

August 16, 2024

Page: 4 of 5 Hilti Firestop Systems

E. TIEN 9557740 **AS SHOWN** DRAWN BY

UL System No.: HW-D-0042

OLMAR SUPPLY INC — STT250, STT300

SCAFCO STEEL STUD MANUFACTURING CO

installation of the optional spray-applied material.

**Hilti Firestop Systems** 

TELLING INDUSTRIES L L C — True-Action Deflection Track

THE STEEL NETWORK INC — VertiTrack VTD250, VTD362, VTD400, VTD600 and VTD800

A2. Light Gauge Framing\* — Vertical Deflection Ceiling Runner — When the nom joint width is less than or equal to 3/4 in. (19 mm), vertical

galy steel channel with slotted vertical deflection clips mechanically fastened within runner. Slotted clips provided with step bushings for

deflection ceiling runner may be used as an alternate to the ceiling runners in Items 2A and 2A1. Vertical deflection ceiling runner to consist of

permanent fastening of steel studs. Flanges sized to accommodate steel studs (Item 2C). Vertical deflection ceiling runner installed perpendicular

Reproduced by HILTI, Inc. Courtesy of

Underwriters Laboratories, Inc.

August 16, 2024

to direction of fluted steel deck and secured to valleys with steel masonry anchors, steel fasteners or welds spaced max 24 in. (610 mm) OC.

before or after optional spray-applied fire resistive material is used. The use of welds to secure the ceiling runner may only be used prior to the

R & P SUPPLY — SCT250, SCT300

RAM SALES L L C - RAM Slotted Track

UL NO. HW-D-0218

| Page: 3 of 5 | Hilti Firestop Systems

the steel deck on both sides of the wall.

ROCKWOOL - SAFE

INDUSTRIAL INSULATION GROUP L L C — MinWool-1200 Safing

ROCK WOOL MANUFACTURING CO — Delta- Board

THERMAFIBER/OWENS CORNING — Type SAF

mineral wool is to be tightly packed into the inverted flutes to the full thickness of the wall. In addition, for the Epic Metals "Toris C" deck, the

mineral wool is to be packed to min 25% compression within the recessed indentations immediately above the ceiling runners. For the New

Millennium Versa-Dek, pieces of mineral wool shall be packed to the maximum depth possible to fill any embossments within the valleys of

the fluted deck. Additional 5/8 in. and 1-1/4 in. (16 and 32 mm) wide strips for 1 and 2 hr rated assemblies, respectively, of nom 4 pcf (64

kg/m3) mineral wool batt insulation are to be cut to fill the gap between the top of the gypsum board and bottom of the steel deck. The strips

of mineral wool are compressed 50 percent and tightly packed, cut edge first, into the gap between the top of the gypsum board and bottom of

produced by HILTI, Inc. Courtesy of

Underwriters Laboratories, Inc.


August 16, 2024

CDMC PROJECT MANAGER Z. Price DESIGNED BY

PER HCAI PIN 62, THE DETAILS ON THIS SHEET ARE LIMITED TO: A. SEISMIC DESIGN OF SUPPORTS AND ATTACHMENTS FOR

NONSTRUCTURAL COMPONENTS. B. SEISMIC BRACING OF DISTRIBUTION SYSTEMS (HVAC DUCTS,

PIPES AND ELECTRICAL RACEWAYS). C. INTERIOR PARTITION WALLS AND SUSPENDED CEILINGS SEISMIC BRACING EQUIVALENT TO THOSE APPROVED THROUGH OSHPD PREAPPROVED DETAILS (OPDS).

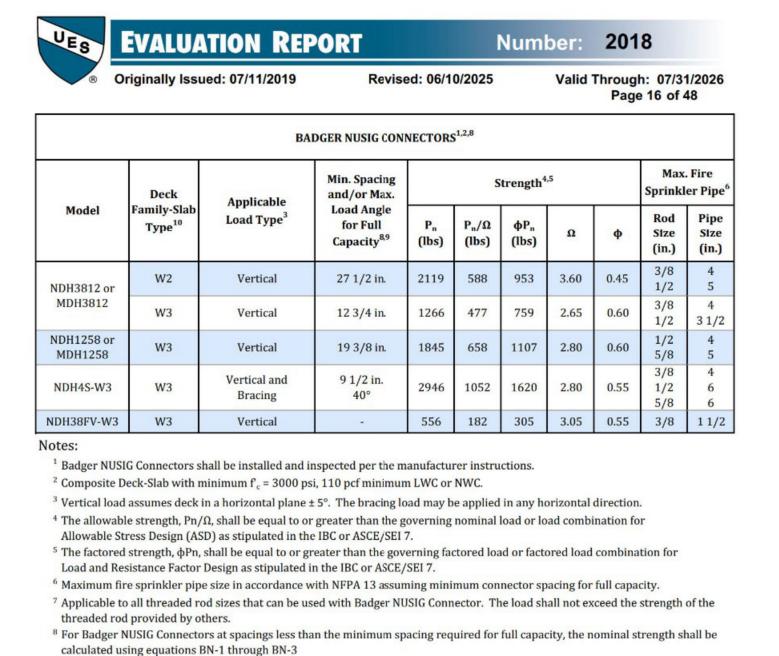

For NDH3812 or MDH3812 in W2 deck-slabs  $P_n = 2119 \cdot \alpha_S$   $\alpha_S = 0.014 \cdot S + 0.601 \le 1$   $\Omega = 3.60$   $\varphi = 0.45$  [BN-1]

For NDH3812 or MDH3812 in W3 deck-slabs  $P_n = 1266 \cdot \alpha_S$   $\alpha_S = 0.013 \cdot S + 0.833 \le 1$   $\Omega = 2.65$   $\phi = 0.60$  [BN-2]

For NDH1258 or MDH1258 in W3 deck-slabs  $P_n = 1845 \cdot \alpha_S \quad \alpha_S = 0.016 \cdot S + 0.690 \le 1 \quad \Omega = 2.80 \quad \varphi = 0.60 \quad [BN-3]$ 

For NDH4S-W3 installed in W3 deck-slabs  $P_n = 2946 \cdot \alpha_S \cdot \alpha_\Theta$   $\alpha_S = 0.030 \cdot S + 0.714 \le 1$   $\Omega = 2.80$   $\varphi = 0.55$  [BN-4]

 $\alpha_{\Theta} = 0.506 \cdot \cos\theta + 0.612 \le 1$ 

NDH4S-W3

NDH38FV-W3

9 For Badger NUSIG Connectors at spacings less than the minimum spacing required and/or the maximum load application angle

from vertical for full capacity, the nominal strength shall be calculated using equation BN-4


 $\theta$  = load application angle from the axis of the threaded rod (deg),  $\leq 60^{\circ}$ 


P<sub>n</sub> = Nominal Strength of Badger NUSIG Connector


S = Badger NUSIG Connector spacing (in.)


NDH3812 or MDH3812 NDH1258 or MDH1258


<sup>10</sup> Applicable to deck manufactured after 06/21/2022

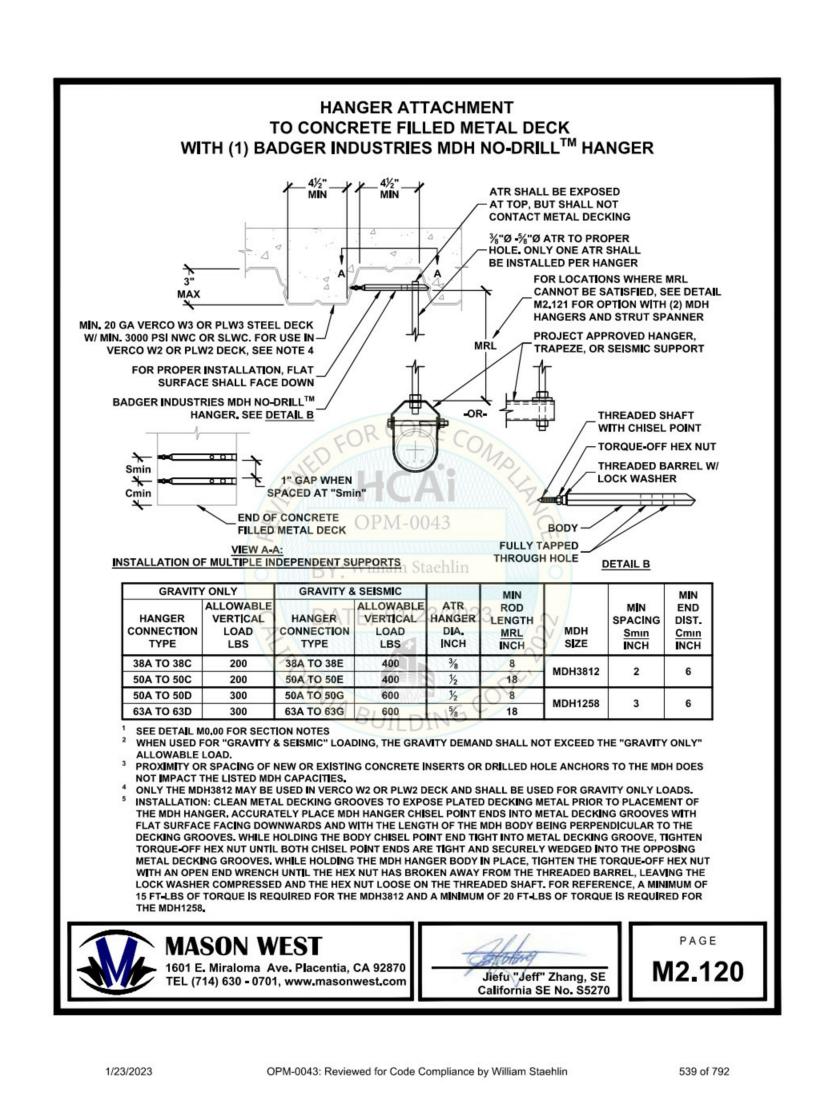


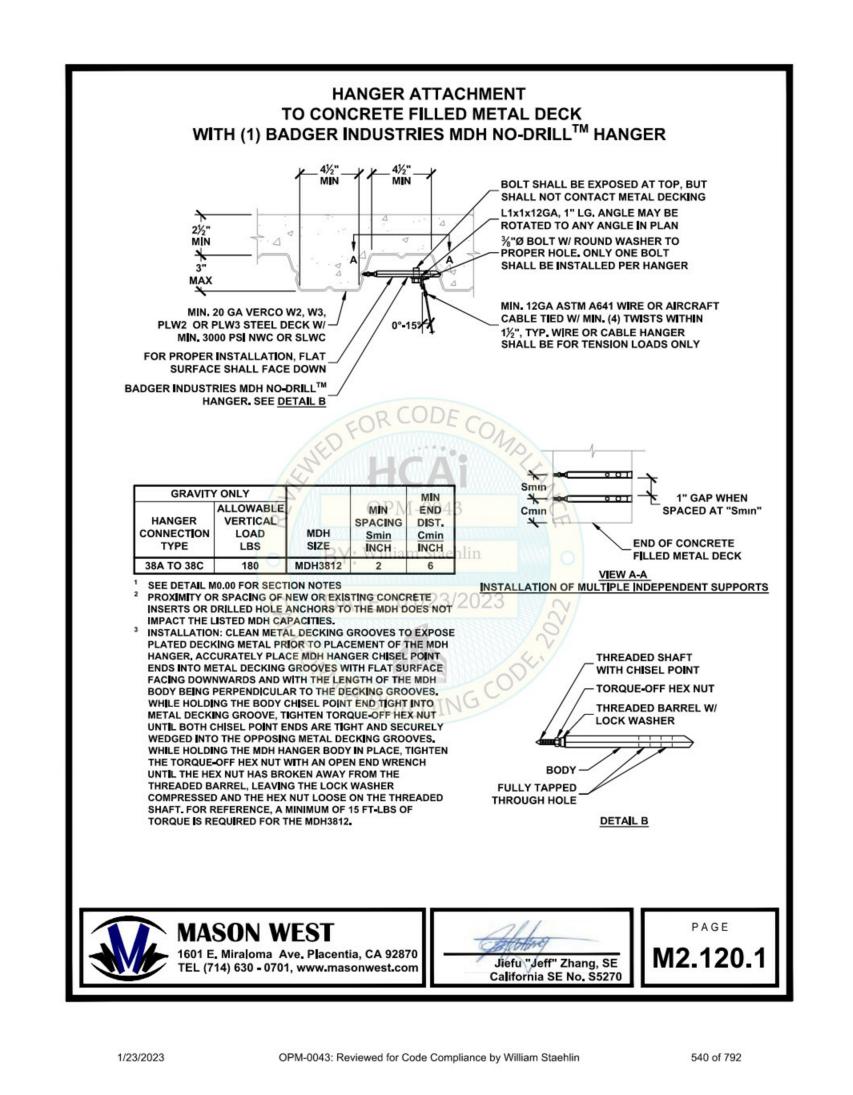


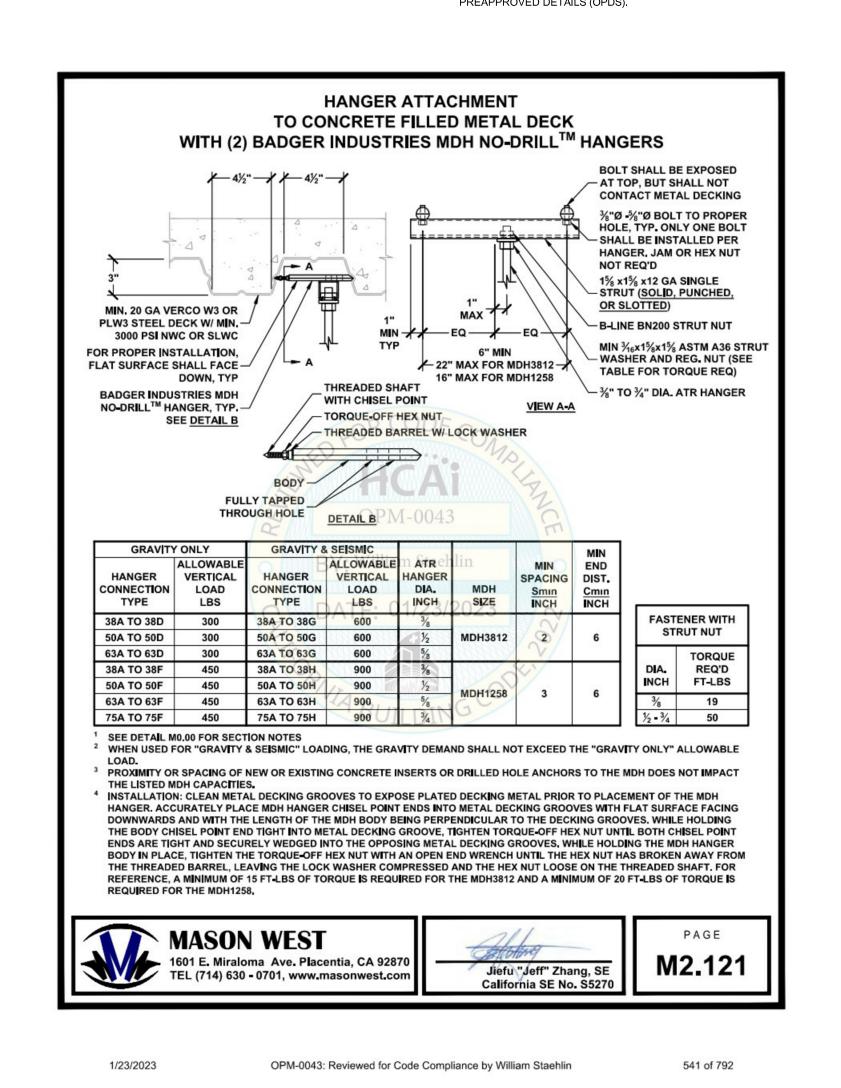


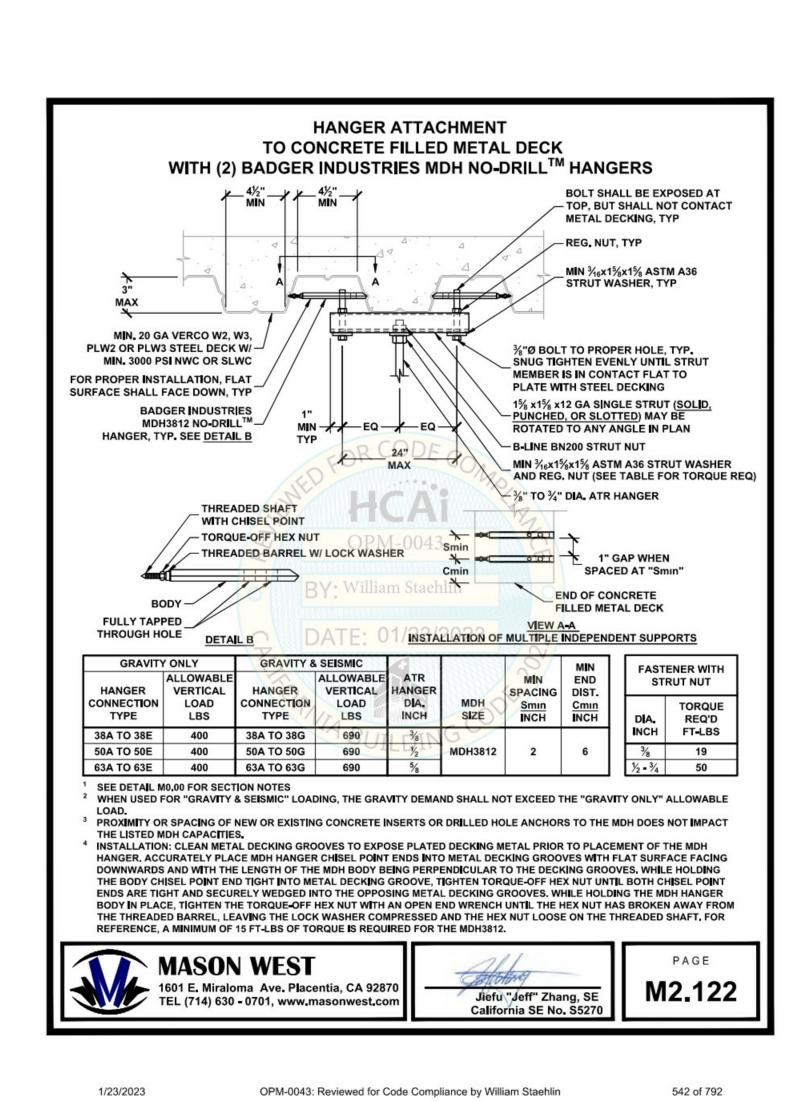

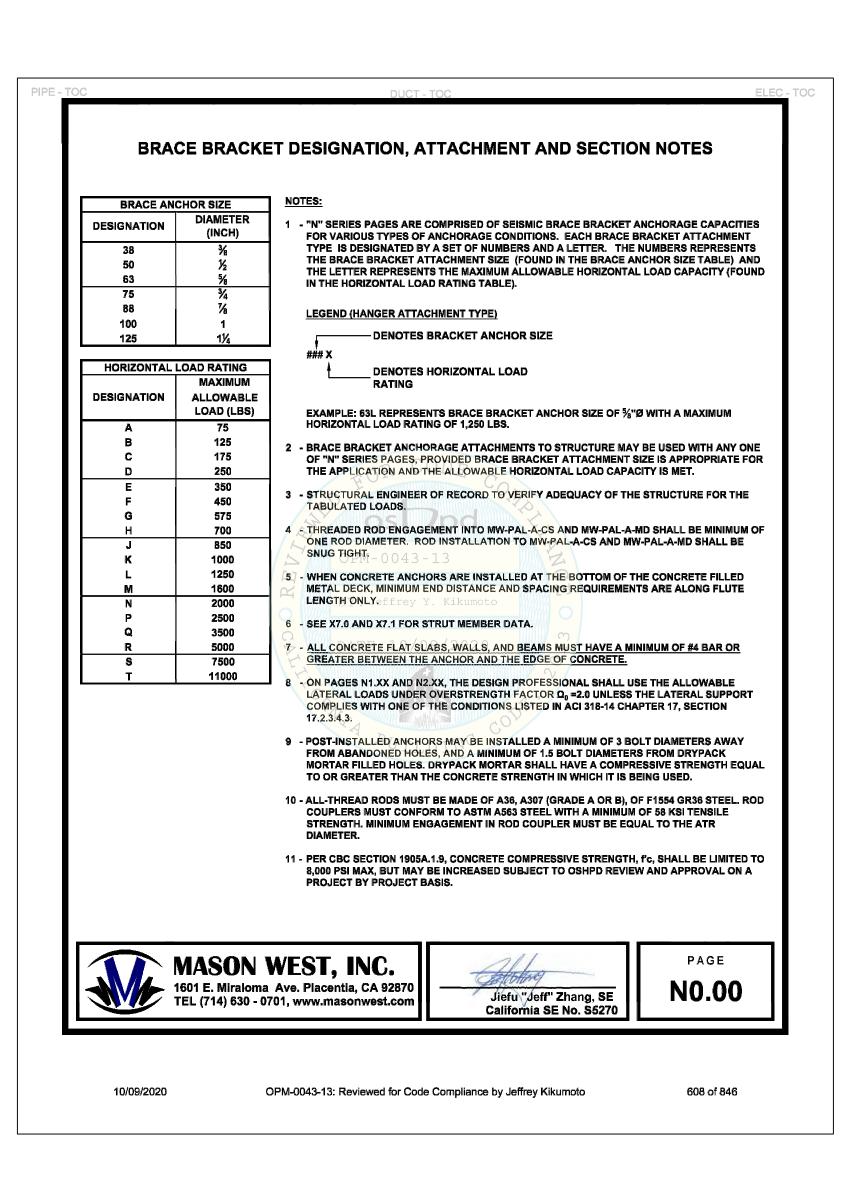

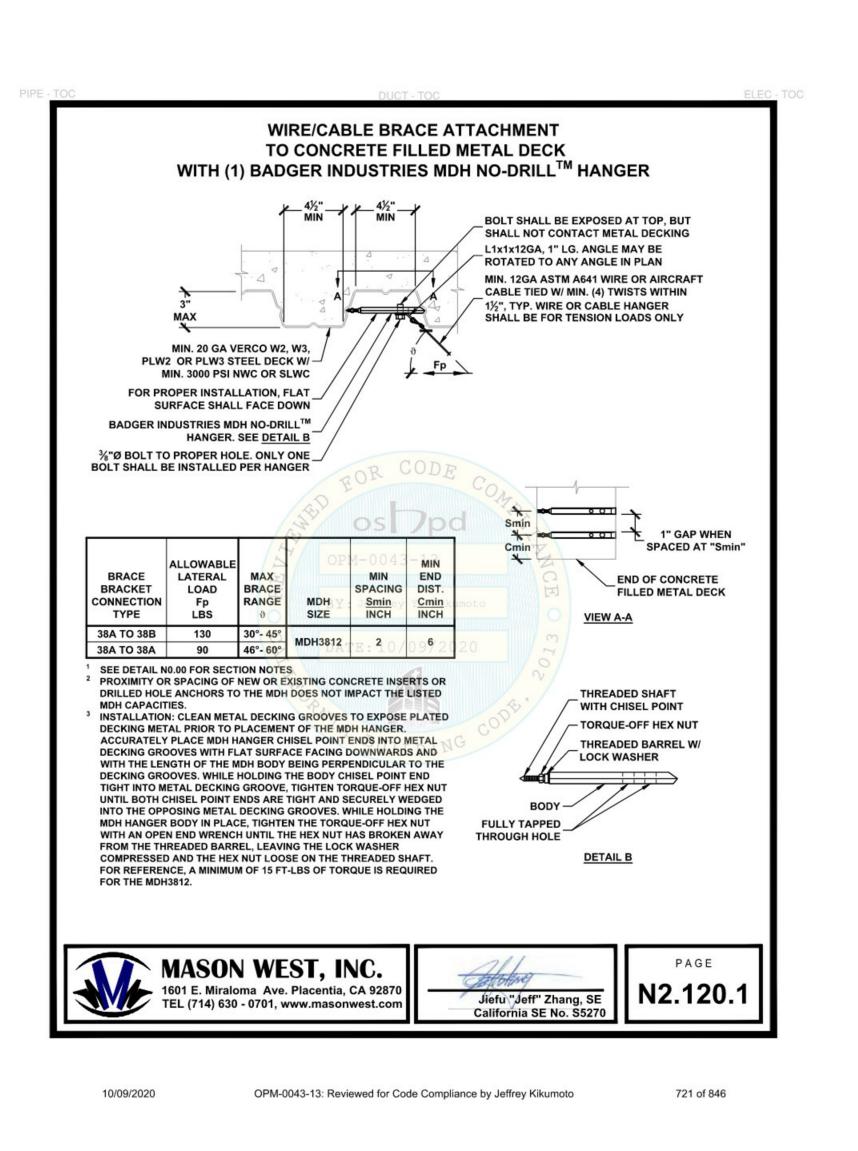

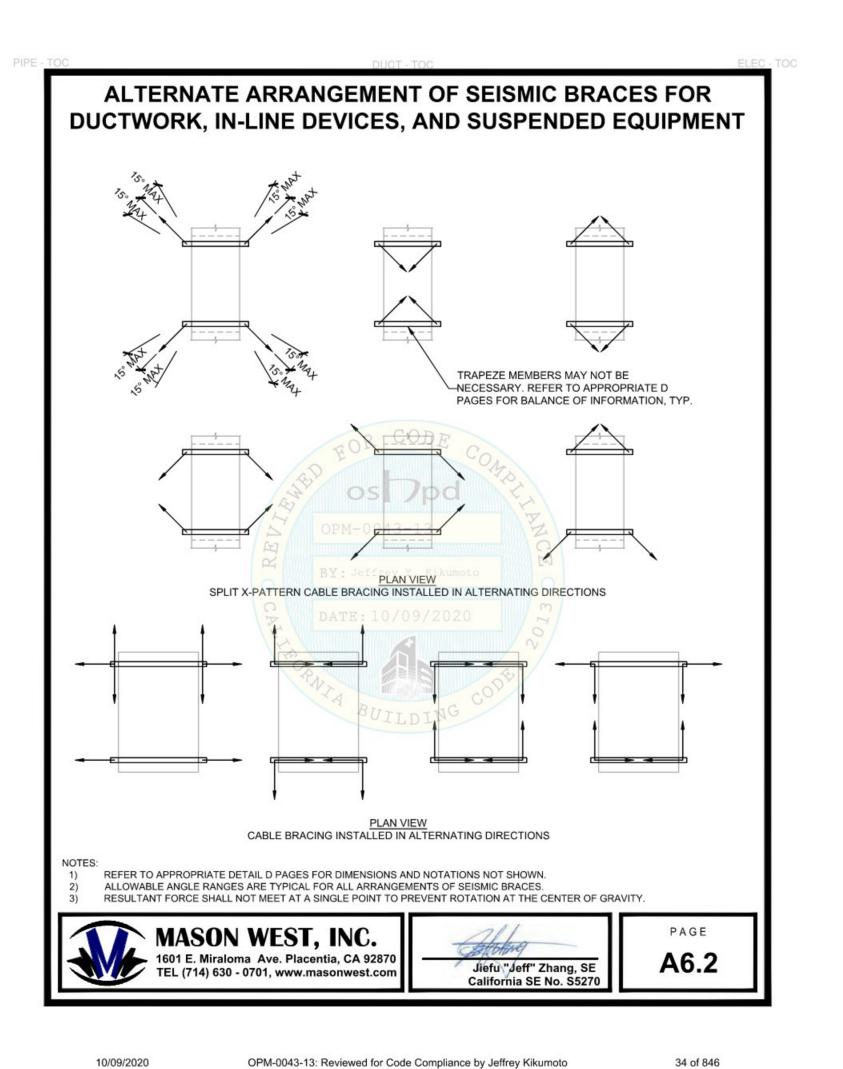

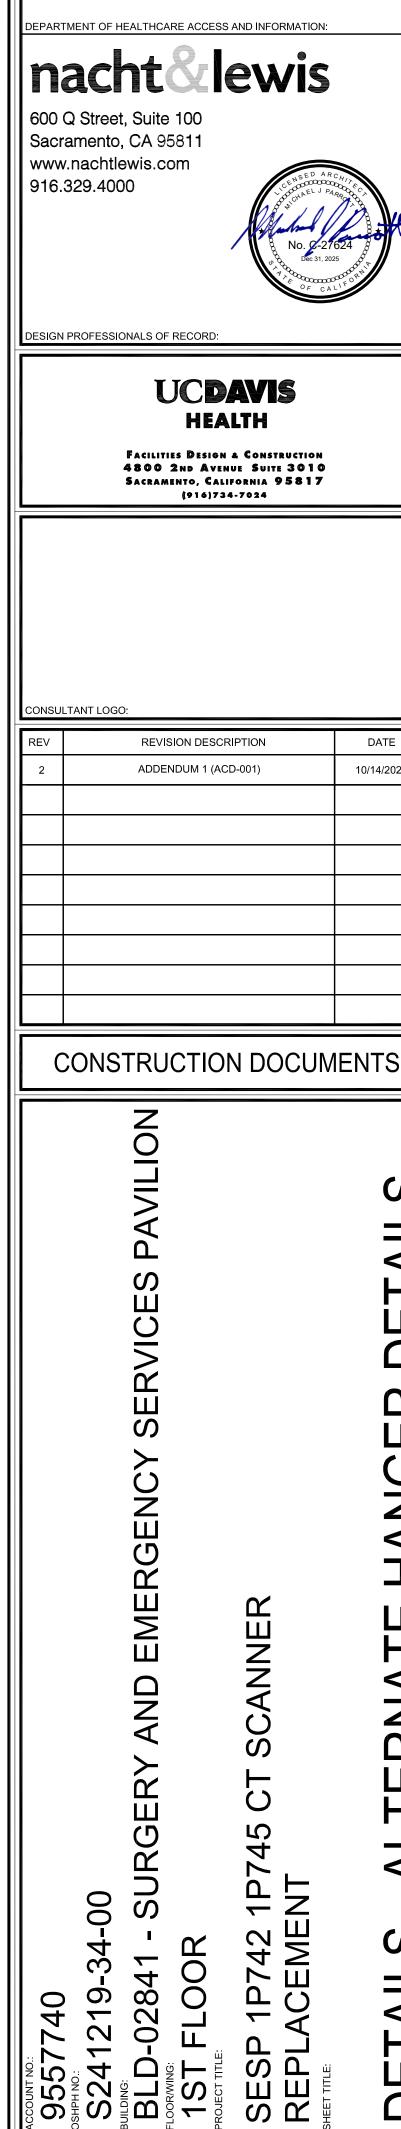

ARCH.\ENGR


SHEET


DATE

10/14/2025

BADGER HANGER SYSTEM OPM DETAILS

E. TIEN 9557740 JCDMC PROJECT MANAGER SCALE Z. Price **AS SHOWN** DESIGNED BY DRAWN BY CAD FILE

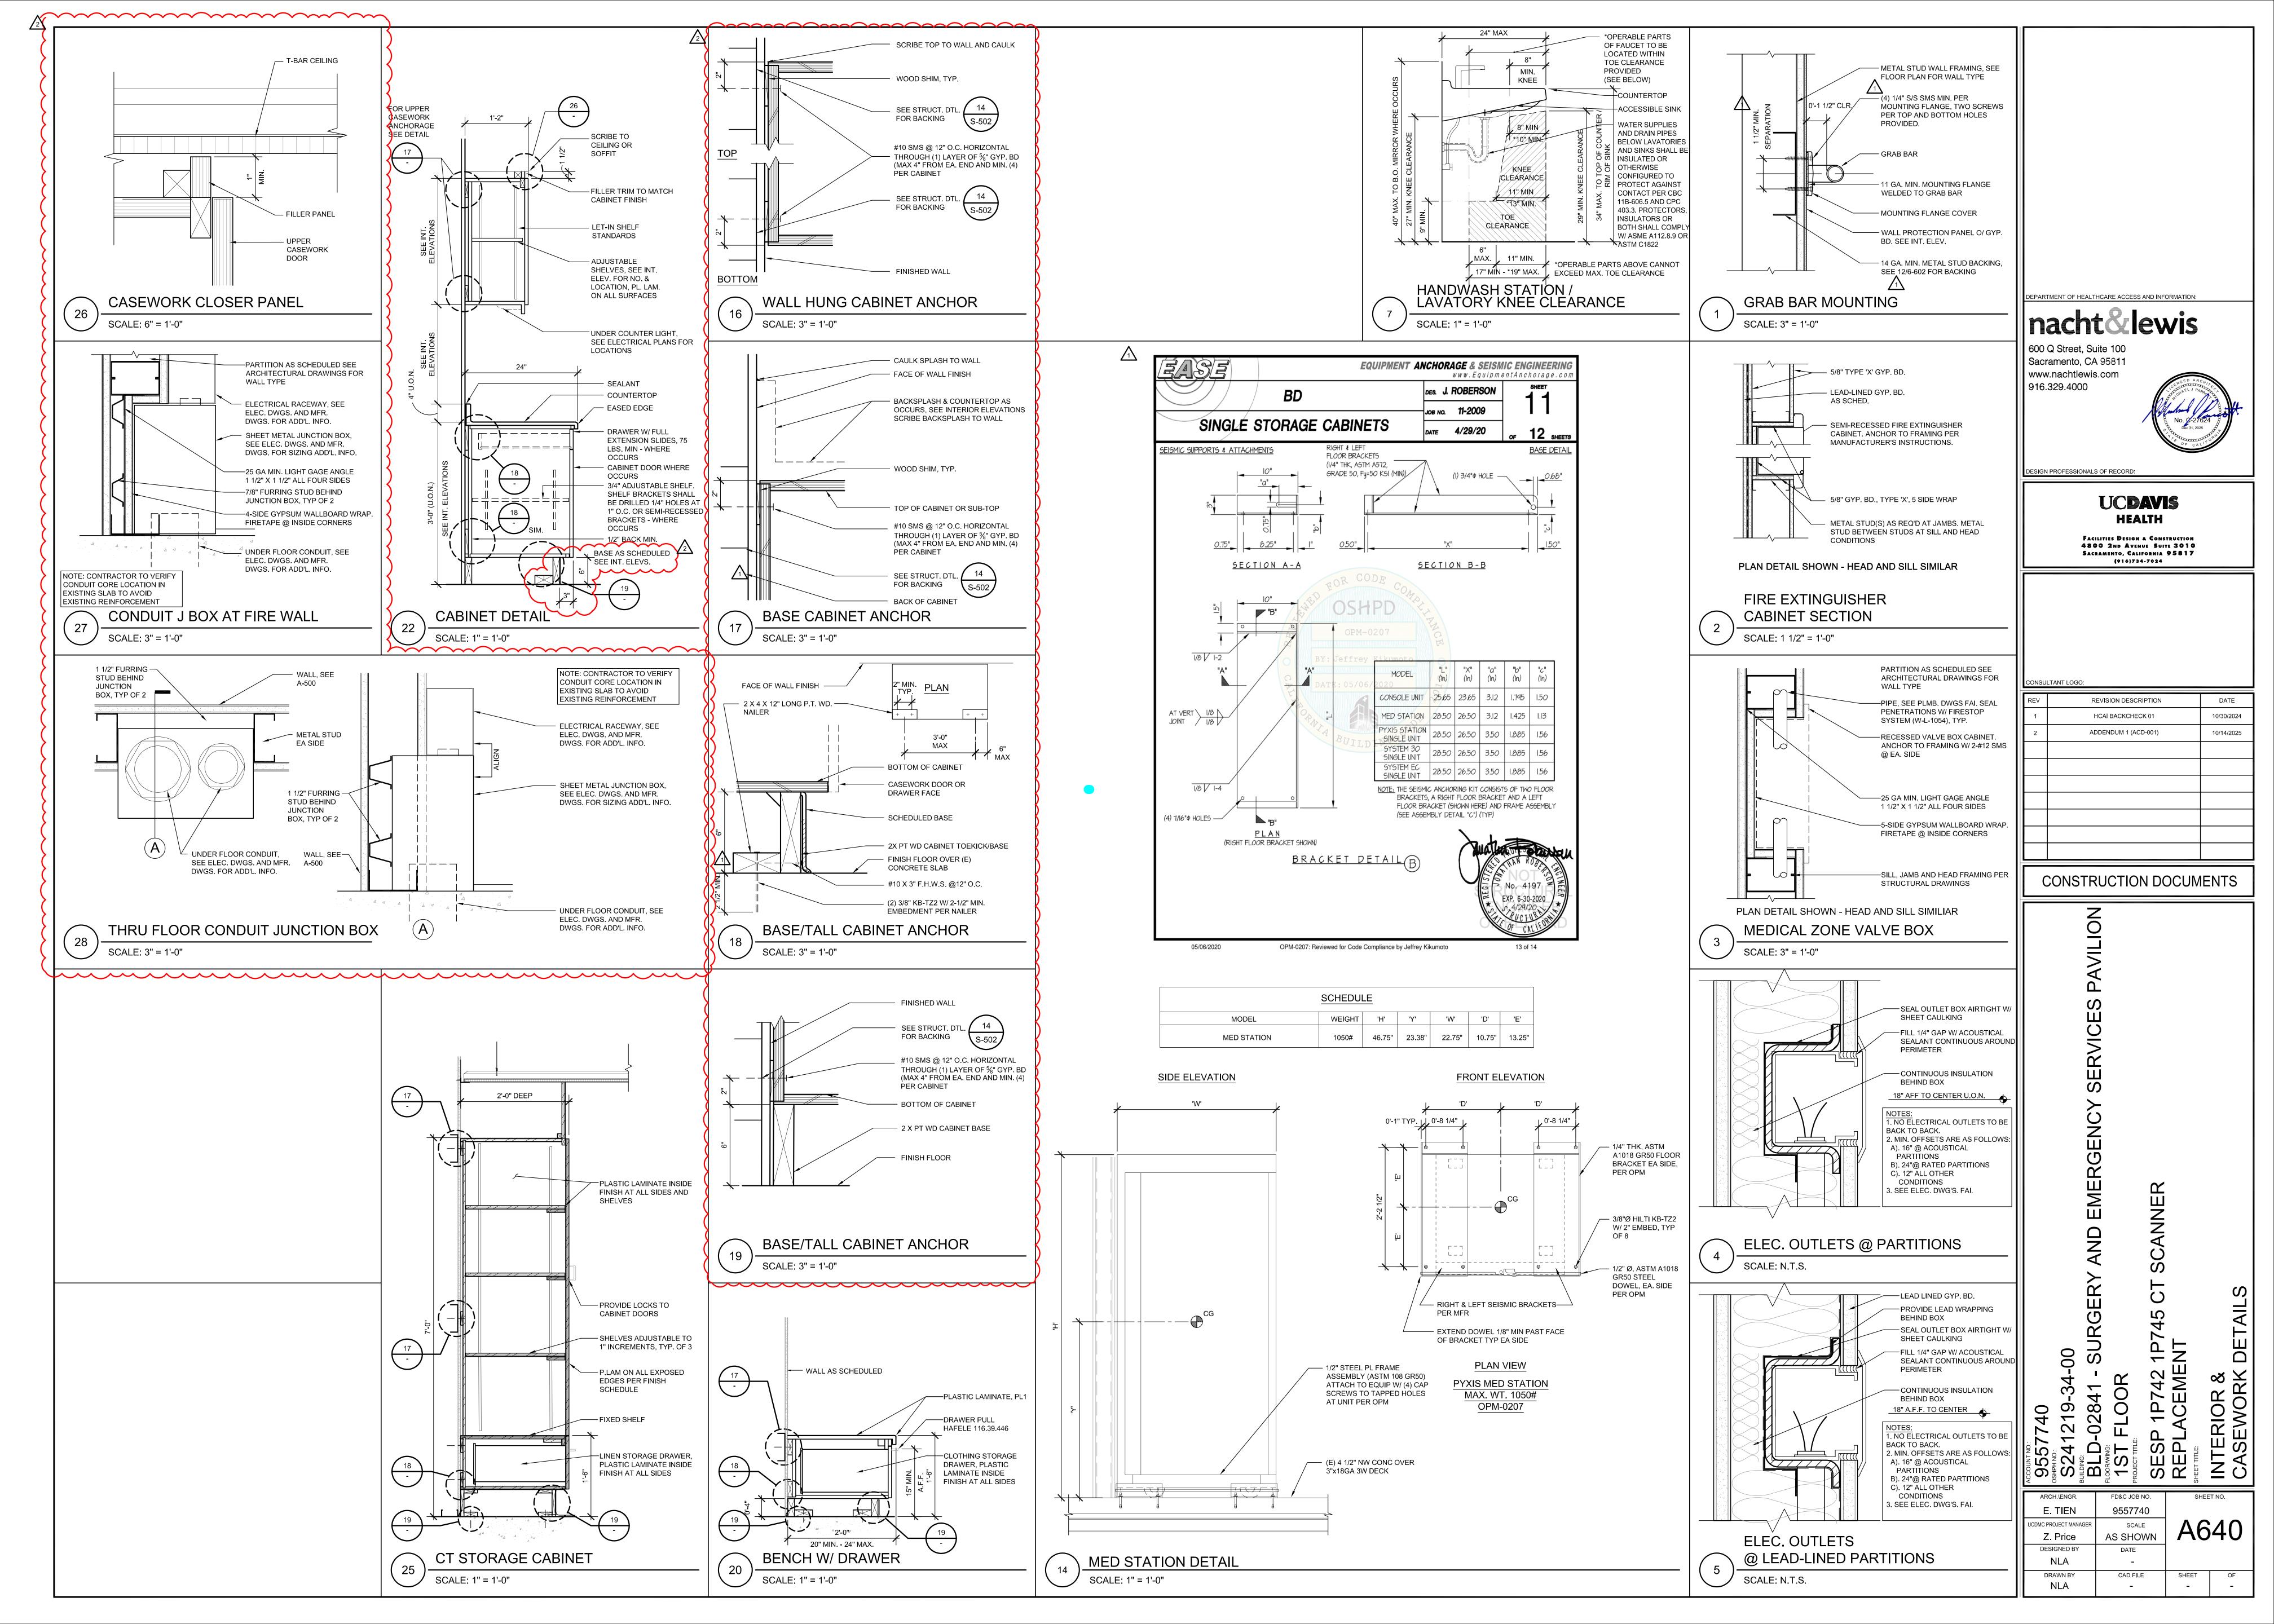

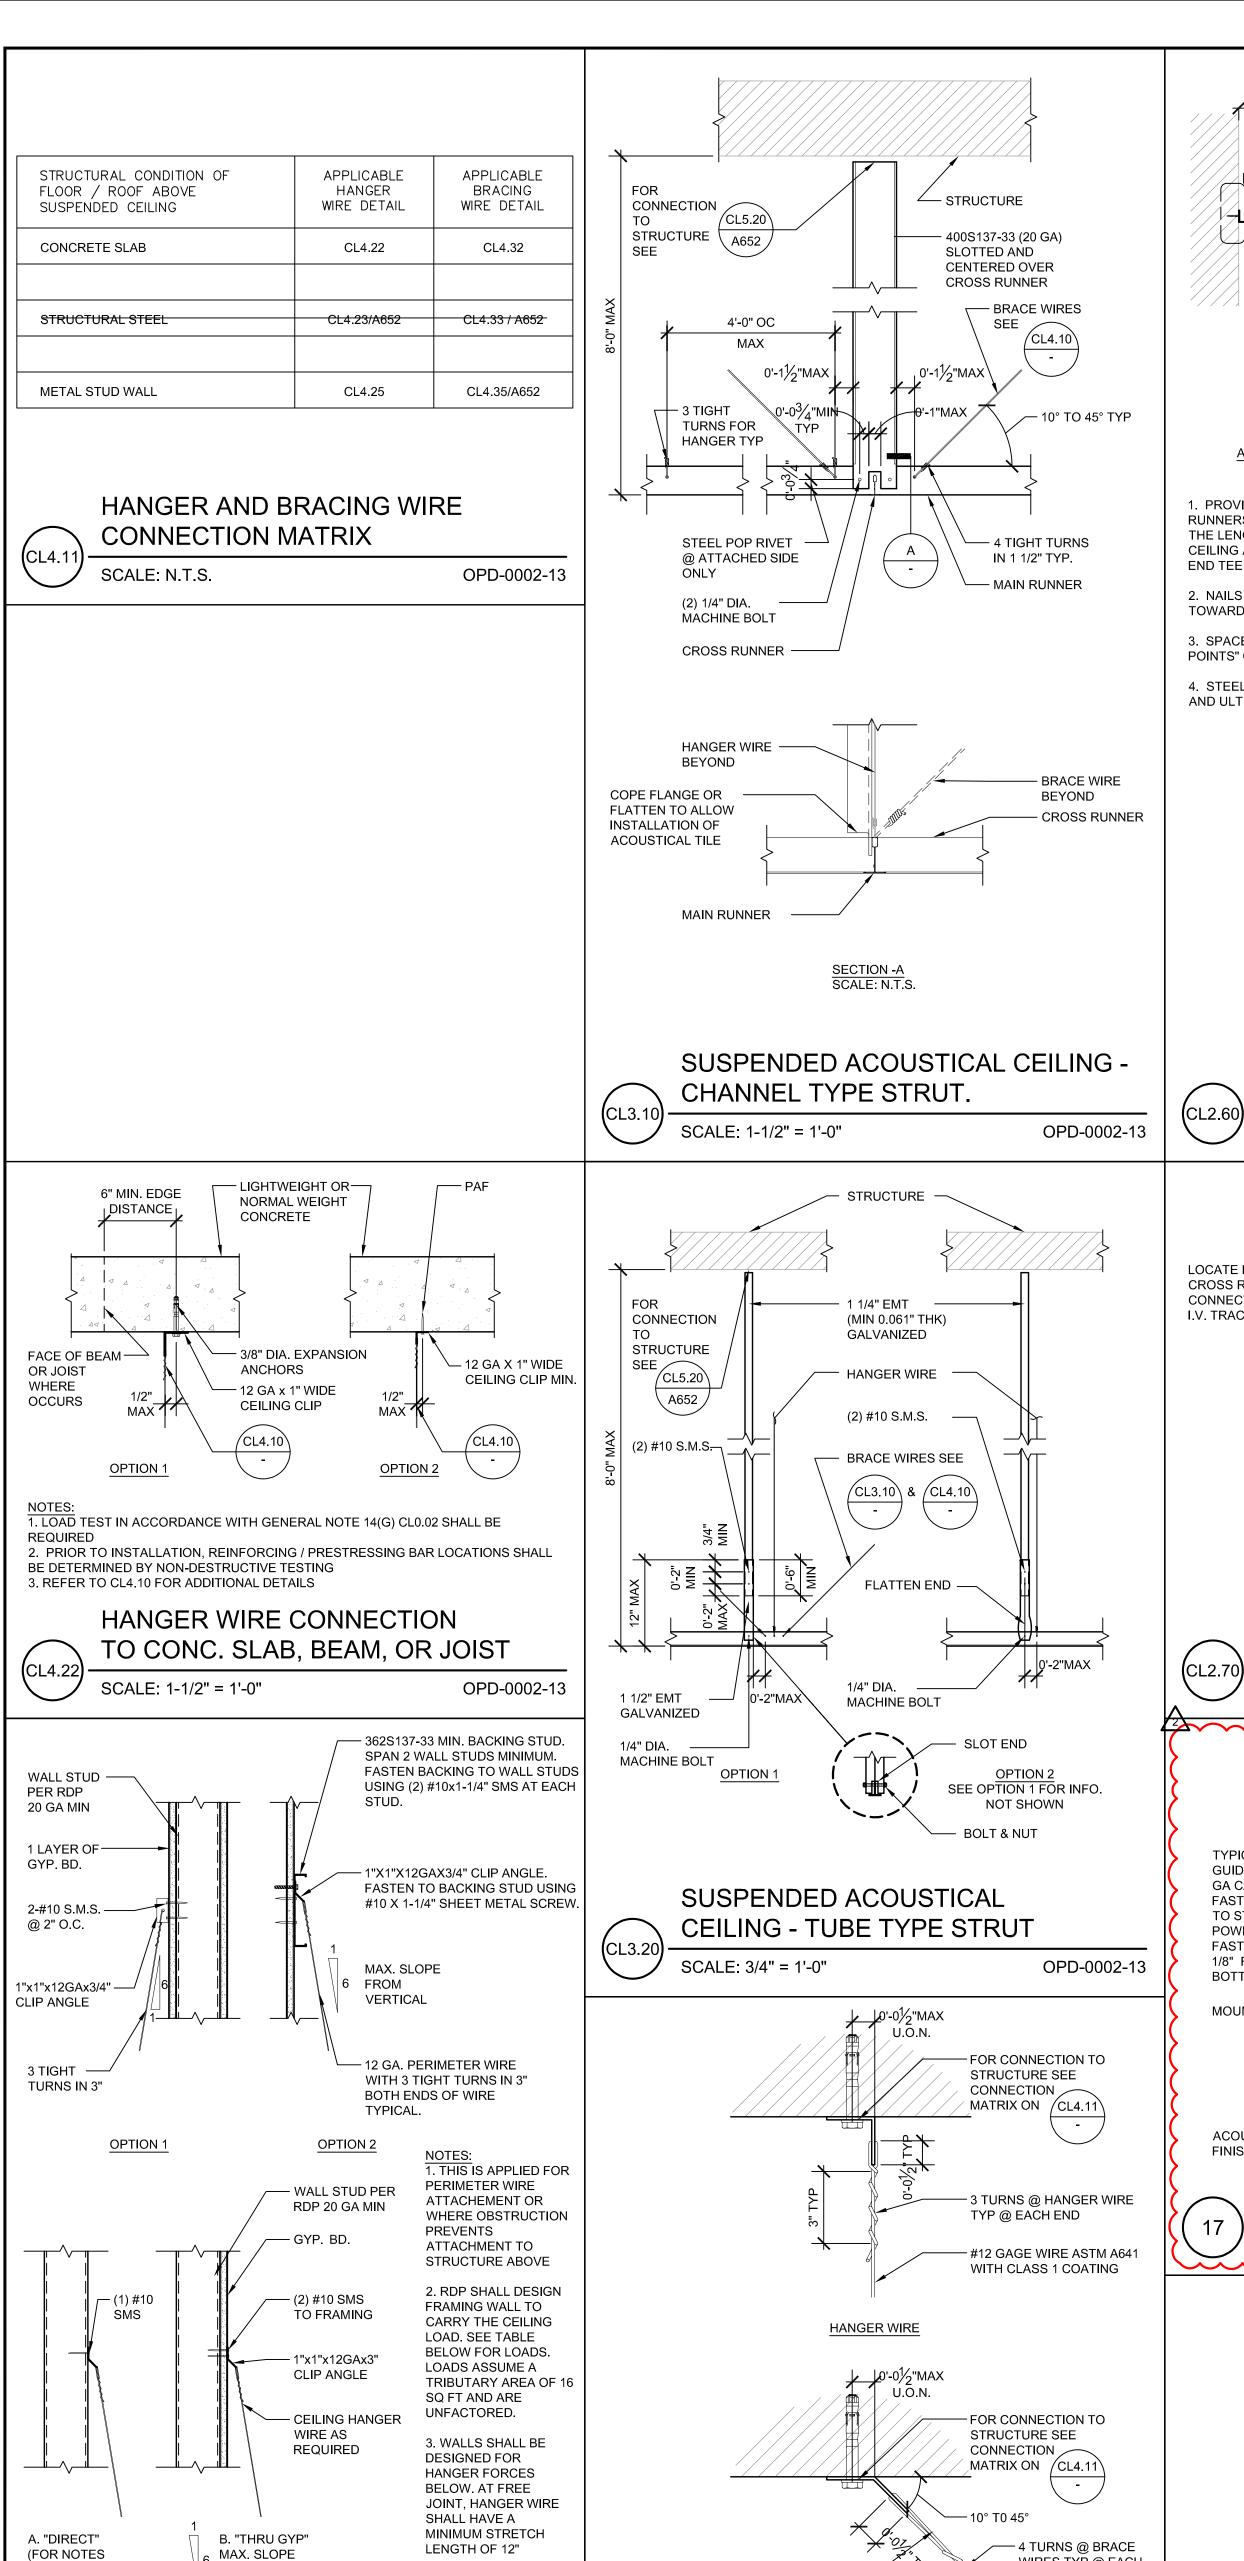

#12 GAGE WIRE ASTM A641

HANGER & BRACING

**WIRE CONNECTION -**

TYP. WIRE TURNS

SCALE: N.T.S.

BRACING WIRE

WITH CLASS 1 COATING

SEE "THRU GYP")

FROM

TO MTL. STUD WALL

SCALE: 1-1/2" = 1'-0"

VERTICAL

EISMIC (0.14Sos Wp

1.15 < Sos <= 1.73

1.73 < Sos <= 2.50

HANGER WIRE CONNECTION

HORIZONTAL

11 LBS

16 LBS

23 LBS


64LBS 11 LBS


2 LBS

3 LBS

4 LBS

OPD-0002-13

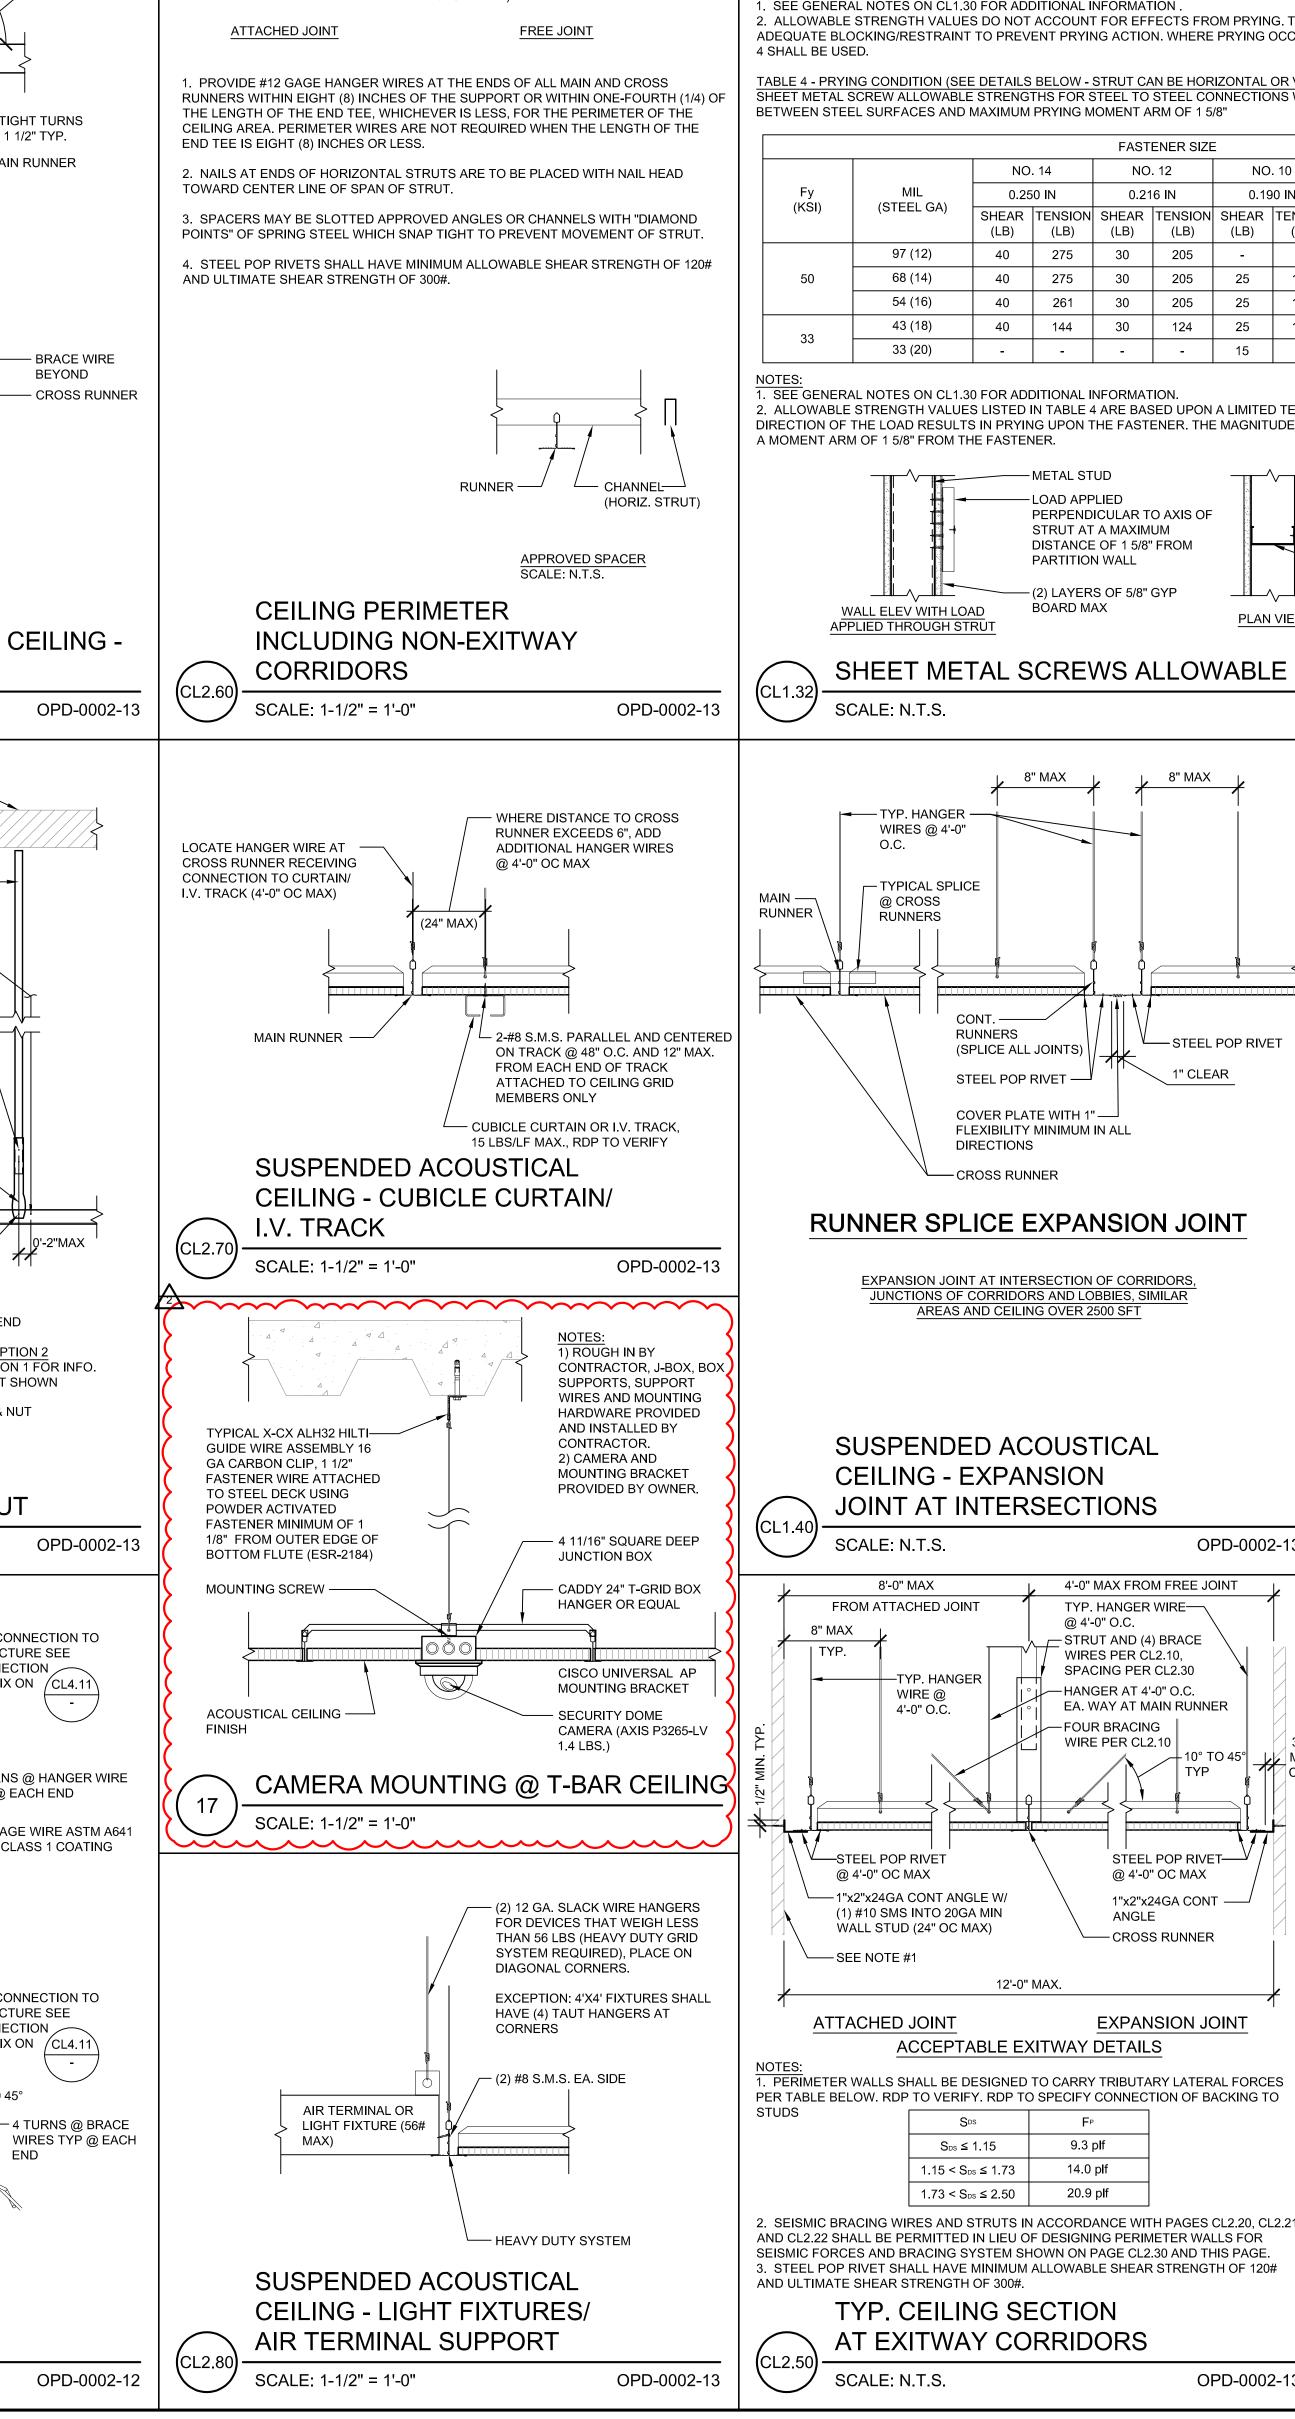

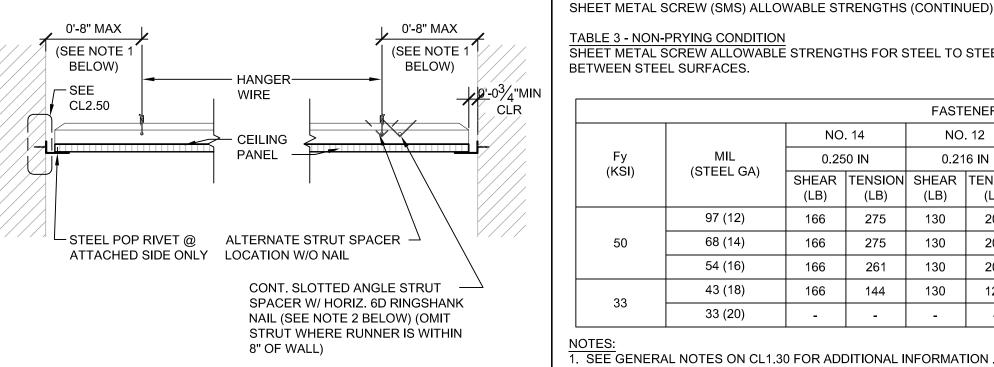


SHEET METAL SCREW ALLOWABLE STRENGTHS FOR STEEL TO STEEL CONNECTIONS WITH TWO LAYERS OF 5/8" GYP BOARD BETWEEN STEEL SURFACES. FASTENER SIZE NO. 14 NO. 10 NO. 8 0.250 IN (STEEL GA) SHEAR |TENSION| SHEAR |TENSION| SHEAR |TENSION| SHEAR |TENSION| (LB) (LB) (LB) (LB) 68 (14) 159 100 159 43 (18) 100 | 109 | 33 33 (20)

> 1. SEE GENERAL NOTES ON CL1.30 FOR ADDITIONAL INFORMATION 2. ALLOWABLE STRENGTH VALUES DO NOT ACCOUNT FOR EFFECTS FROM PRYING. THE RDP IN RESPONSIBLE CHARGE TO PROVIDE ADEQUATE BLOCKING/RESTRAINT TO PREVENT PRYING ACTION. WHERE PRYING OCCURS, THE VALUES AND CONSTRAINTS OF TABLE

> TABLE 4 - PRYING CONDITION (SEE DETAILS BELOW - STRUT CAN BE HORIZONTAL OR VERTICAL SHEET METAL SCREW ALLOWABLE STRENGTHS FOR STEEL TO STEEL CONNECTIONS WITH ONE OR TWO LAYERS OF 5/8" GRP BOARD BETWEEN STEEL SURFACES AND MAXIMUM PRYING MOMENT ARM OF 1 5/8"

FASTENER SIZE												
Fy (KSI)		NO. 14		NO	NO. 12		NO. 10		). 8	NO. 6		
	MIL (STEEL CA)	0.250 IN		0.216 IN		0.190 IN		0.164 IN		0.138 IN		
	(STEEL GA)	SHEAR (LB)	TENSION (LB)									
	97 (12)	40	275	30	205	-	-	-	-	-	-	
50	68 (14)	40	275	30	205	25	159	-	-	-	-	
	54 (16)	40	261	30	205	25	159	20	118	-	-	
33	43 (18)	40	144	30	124	25	109	20	94	10	79	
	33 (20)	-	-	-	-	15	84	15	72	10	61	

. SEE GENERAL NOTES ON CL1.30 FOR ADDITIONAL INFORMATION. 2. ALLOWABLE STRENGTH VALUES LISTED IN TABLE 4 ARE BASED UPON A LIMITED TEST ASSEMBLY WHERE THE ORIGIN AND DIRECTION OF THE LOAD RESULTS IN PRYING UPON THE FASTENER. THE MAGNITUDE OF THIS PRYING EFFECT SHALL BE LIMITED TO A MOMENT ARM OF 1 5/8" FROM THE FASTENER.

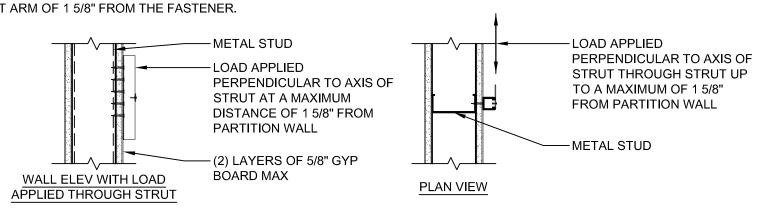

SHEET METAL SCREWS ALLOWABLE STRENGTHS (2 OF 2) SCALE: N.T.S.

OPD-0002-13

4'-0" MAX FROM FREE JOINT

TYP. HANGER WIRE-

- STRUT AND (4) BRACE

WIRES PER CL2.10,

SPACING PER CL2.30

-HANGER AT 4'-0" O.C.

—FOUR BRACING

WIRE PER CL2.10

EA. WAY AT MAIN RUNNER

STEEL POP RIVET-

1"x2"x24GA CONT —

**EXPANSION JOINT** 

OPD-0002-13

@ 4'-0" OC MAX

— CROSS RUNNER

ANGLE

12'-0" MAX.

ACCEPTABLE EXITWAY DETAILS

 $S_{DS} \le 1.15$ 

 $1.15 < S_{DS} \le 1.73$ 

 $1.73 < S_{DS} \le 2.50$ 

TYP. CEILING SECTION

AT EXITWAY CORRIDORS

9.3 plf

14.0 plf

20.9 plf

@ 4'-0" O.C.

I 8" MAX I 8" MAX I

WIRES @ 4'-0"

TYPICAL SPLICE

RUNNERS

DIRECTIONS

SUSPENDED ACOUSTICAL

JOINT AT INTERSECTIONS

**CEILING - EXPANSION** 

SCALE: N.T.S.

8'-0" MAX

FROM ATTACHED JOINT

-TYP. HANGER

4'-0" O.C

-1"x2"x24GA CONT ANGLE W/

(1) #10 SMS INTO 20GA MIN

WALL STUD (24" OC MAX)

@ 4'-0" OC MAX

---- SEE NOTE #1

ATTACHED JOINT

SCALE: N.T.S.

(SPLICE ALL JOINTS)

COVER PLATE WITH 1" ---

FLEXIBILITY MINIMUM IN ALL

STEEL POP RIVET -

**RUNNER SPLICE EXPANSION JOINT** 

**EXPANSION JOINT AT INTERSECTION OF CORRIDORS** 

JUNCTIONS OF CORRIDORS AND LOBBIES, SIMILAR

AREAS AND CEILING OVER 2500 SFT

@ CROSS

RUNNERS

OPD-0002-13

CL2.60

JOINT |

FREE JOINT

8'-0"

MAX

96 SQ FT

MAX

I. BRACING WIRES AND COMP. STRUT SHALL OCCUR

2. RDP MAY ELECT TO SPECIFY TIGHTER SPACING BETWEEN BRACING WIRES AND

COMP. STRUTS TO ALLOW SMALLER ANCHORS PER SCHEDULES ON SHEETS CL4.31 8

TYP. CEILING PLANS FOR

144 SQ

FT MAX

- FREE JOINT

. BRACING WIRES AND COMP. STRUT SHALL OCCUR

AT EVERY 144 SQ. FT. MAX. IN ROOMS OVER 144 SQ. FT.

SCALE: 1/8" = 1'-0"

2. RDP MAY ELECT TO SPECIFY TIGHTER SPACING BETWEEN BRACING WIRES AND

TYP. CEILING PLANS FOR

SDS ≤1.15 AND z/h<=1.0

COMP. STRUTS TO ALLOW SMALLER ANCHORS PER SCHEDULES ON SHEETS CL4.31 8

1.15<SDS≤1.73 AND z/h<=1.0

AT EVERY 64 SQ. FT. MAX. IN ROOMS OVER 64 SQ. FT.

SCALE: 1/8" = 1'-0"

NO. 6

0.138 IN

SHEAR |TENSION| SHEAR |TENSION| SHEAR |TENSION| SHEAR |TENSION (LB) | (LB) | (LB) | (LB) 275 68 (14) 159 | 303 | 118 54 (16) 405 43 (18) 263 109 | 244 | 94 | 165 124 33 (20) 177 84 | 164 | 72 | 151

FASTENER SIZE

NO. 8

NO. 6

0.138 IN

EPARTMENT OF HEALTHCARE ACCESS AND INFORMATION:

600 Q Street, Suite 100 Sacramento, CA 95811

www.nachtlewis.com

ESIGN PROFESSIONALS OF RECORD:

**UCDAVIS** 

HEALTH

FACILITIES DESIGN & CONSTRUCTION

4800 2ND AVENUE SUITE 3010

(916)734-7024

REVISION DESCRIPTION

ADDENDUM 1 (ACD-001)

CONSTRUCTION DOCUMENTS

SACRAMENTO, CALIFORNIA 95817

DATE

10/14/2025

916.329.4000

CONSULTANT LOGO:

NO. 12

. SEE GENERAL NOTES ON CL1.30 FOR ADDITIONAL INFORMATION .  $2.\,$  WHERE ONE OR TWO LAYERS OF GYP BOARD OCCURS BETWEEN STEEL SURFACES, THE ALLOWABLE VALUES OF TABLE 2~&~3~3. ALLOWABLE STRENGTH VALUES DO NOT ACCOUNT FOR EFFECTS FROM PRYING. THE RDP IN RESPONSIBLE CHARGE OF THE PROJECT SHALL PROVIDE ADEQUATE BLOCKING/RESTRAINT TO PREVENT PRYING ACTION. WHERE PRYING OCCURS, THE VALUES

SHEET METAL SCREW ALLOWABLE STRENGTHS FOR STEEL TO STEEL CONNECTIONS.

WITH ONE LAYED OF 5/8" CVD DOADD DETWEEN STEEL SLIDEACES

SHEET METAL SCREW ALLOWABLE STRENGTHS FOR STEEL TO STEEL CONNECTIONS.

SHEET METAL SCREW (SMS) ALLOWABLE STRENGTHS

(STEEL GA)

AND CONSTRAINTS OF TABLE 4 SHALL BE USED.

SCALE: N.T.S.

ATTACHED

MAX 1

ATTACHED

CL2.60 ATTACHE

<del></del> H⊢ MAIN RUNNERS

CROSS TEES OR

FREE

/ JOINT

- BRACING WIRE

LOCATION, TYP

STRUTS 8" MAX

FROM WALL TYP

OPD-0002-13

— ATTACHED

JOINT

CL2.60

ATTACHED

JOINT

- CROSS

— MAIN

TYP

STABILIZER BARS

**CROSS TEES OR** 

STRUTS 8" MAX

OPD-0002-13

FREE FROM WALL TYP.

JOINTS

JOINT ALONG FREE

RUNNERS

RUNNERS

LOCATION

**ATTACHED** 

CL2.60

MAX

ALONG FREE

JOINTS

STABILIZER BARS

JOINT

JOINT

JOINT

				FAST	ENER SIZE						
Fy		NO	NO. 14		. 12	NO. 10		NO. 8		NO. 6	
	MIL	0.25	0.250 IN		0.216 IN		0.190 IN		0.164 IN		0.138 IN
(KSI)	(STEEL GA)	SHEAR (LB)	TENSION (LB)								
	97 (12)	226	275	180	205	-	-	-	-	-	-
50	68 (14)	226	275	180	205	140	159	-	-	-	-
	54 (16)	226	261	180	205	140	159	120	118	-	-
22	43 (18)	226	144	180	124	140	109	120	94	60	79
33	33 (20)	-	-	-	-	100	84	80	72	60	61

1. SEE GENERAL NOTES ON CL1.30 FOR ADDITIONAL INFORMATION . 2. ALLOWABLE STRENGTH VALUES DO NOT ACCOUNT FOR EFFECTS FROM PRYING. THE RDP IN RESPONSIBLE CHARGE OF THE PROJECT SHALL PROVIDE ADEQUATE BLOCKING/RESTRAINT TO PREVENT PRYING ACTION. WHERE PRYING OCCURS. THE VALUES AND CONSTRAINTS OF TABLE 4 SHALL BE USED.

SHEET METAL SCREWS ALLOWABLE STRENGTHS (1 OF 2) OPD-0002-13

SHEET METAL SCREW (SMS) GENERAL NOTES THE ALLOWABLE STRENGTHS ARE BASED UPON THE AISI S100-16 AND ARE LIMITED BY ACTUAL TESTED STRENGTH OF THE SCREWS IN TENSION AND SHEAR.

THE ALLOWABLE STRENGTHS ARE BASED UPON THE LEAST OF THE AVERAGE TESTED TENSILE AND SHEAR STRENGTHS TABULATED FROM ICC ESR'S 1976, 2196, 1730, 1408, AND THE STEEL STUD MANUFACTURER'S ASSOCIATION (SSMA). FASTENER TYPES AND SIZES APPLY TO NON PROPRIETARY FASTENER TYPES AND SIZES, AND DOES NOT ENDORSE A SPECIFIC MANUFACTURER. WHERE PROPRIETARY FASTENERS ARE SPECIFIED, NO EXCEPTIONS ARE TAKEN TO THE USE OF MANUFACTURER SPECIFIC VALUES THAT ARE BASED UPON THE AISI S100-16. SECTION E4. ALL SCREW FASTENERS SHALL SATISFY ICC-ES AC118 ACCEPTANCE CRITERIA FOR SELF TAPPING SCREW FASTENERS.

TABLE 1 REPRESENTS ALLOWABLE TENSION AND SHEAR STRENGTHS FOR NON-PROPRIETARY SHEET METAL SCREWS FOR STEEL TO STEEL CONNECTIONS.

TABLES 2 AND 3 REPRESENT ALLOWABLE TENSION AND SHEAR STRENGTHS THAT INCORPORATE THE EFFECTS OF EITHER ONE (1) OR TWO (2) LAYERS OF 5/8" GYPSUM BOARD BETWEEN FASTENER HEAD AND CONNECTING ŚTEEL MATÉRIAL. IN ORDER TO USE THE VALUES IN TABLES 1, 2, AND 3, THE ATTACHMENTS SHALL BE DETAILED

IN SUCH A WAY AS TO AVOID PRYING AND THE STUDS MUST BE STABILIZED WITH FULL-DEPTH BLOCKING WITH CONTINUOUS STRAPS ALONG THE FLANGES OR WITH BACKING BARS. PENETRATION OF SCREWS THROUGH JOINED MATERIAL SHOULD NOT BE LESS THAN THREE (3)

STEEL THICKNESSES JOINED ARE ASSUMED TO BE THE SAME. IF DISSIMILAR THICKNESSES ARE BEING CONNECTED, THE VALUE FOR THE THINNER PART JOINED SHALL BE USED.

THE MINIMUM SPACING BETWEEN CENTERS OF FASTENERS SHALL NOT BE LESS THAN 3 X FASTENER DIAMETER. THE MINIMUM EDGE DISTANCE FROM THE CENTER OF A FASTENER TO THE EDGE OF ANY PART SHALL NOT BE LESS THAN 1.5 X FASTENER DIAMETER. WHERE THE END DISTANCE IS PARALLEL TO THE FORCE ON THE FASTENER, THE NOMINAL SHEAR STRENGTH SHALL BE LIMITED BY SECTION E4.3.2 OF THE AISI S100-16.

). GALVANIZED METAL STUDS, TRACK AND SHEET STEEL SHALL CONFORM TO ASTM A653-09A MATERIAL (OR OTHER EQUIVALENT ASTM LISTED MATERIALS IN THE AISI S100-16. SECTION A2.1) WITH A MINIMUM YIELD STRENGTH OF 33 KSI FOR 43 MIL (18 GA) AND LIGHTER, AND MINIMUM YIELD STRENGTH OF 50 KSI FOR 54 MIL (16 GA) & HEAVIER.


). WHERE VALUES ARE NOT GIVEN, SUCH COMBINATIONS OF SCREW SIZES & MATERIAL THICKNESS ARE NOT RECOMMENDED.

IF THE ATTACHMENT DETAILS RESULT IN PRYING WITH A MOMENT ARM NOT TO EXCEED 15/8". THE VALUES IN TABLE 4 MAY BE USED. IF THE ATTACHMENT DETAILS RESULT IN PRYING WITH A MOMENT ARM THAT EXCEEDS 1 5/8", THE REGISTERED DESIGN PROFESSIONAL IN RESPONSIBLE CHARGE OF THE PROJECT SHALL DETERMINE THE ALLOWABLE VALUES AND SUBMIT SUBSTANTIATION FOR THEM TO OSHPD FOR REVIEW. 12. INTERACTION OF SHEAR AND TENSION SHALL BE BASED ON T/T + V/V  $\leq$  1.0.

13. REFER TO NOTE 6A ON CL0.00 FOR ADDITIONAL SHEET METAL SCREW REQUIREMENTS

SHEET METAL SCREWS **GENERAL NOTES** 

SCALE: N.T.S. OPD-0002-13

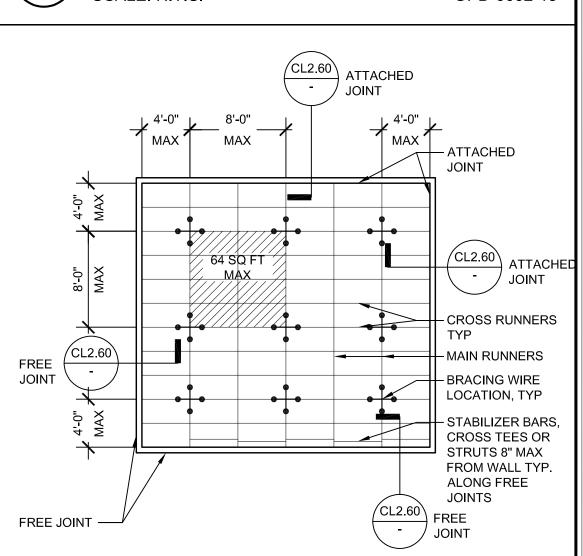


BRACING WIRES AND COMP. STRUT SHALL OCCUR AT EVERY 64 SQ. FT. MAX. IN ROOMS OVER 64 SQ. FT 2. RDP MAY ELECT TO SPECIFY TIGHTER SPACING BETWEEN BRACING WIRES AND COMP. STRUTS TO ALLOW SMALLER ANCHORS PER SCHEDULES ON SHEETS CL4.31 &


OPD-0002-13


TYP. CEILING PLANS FOR 1.73<SoS AND z/h<=1.0


SCALE: 1/8" = 1'-0"


ARCH.\ENGR E. TIEN 9557740 JCDMC PROJECT MANAGER **AS SHOWN** Z. Price DESIGNED BY CAD FILE

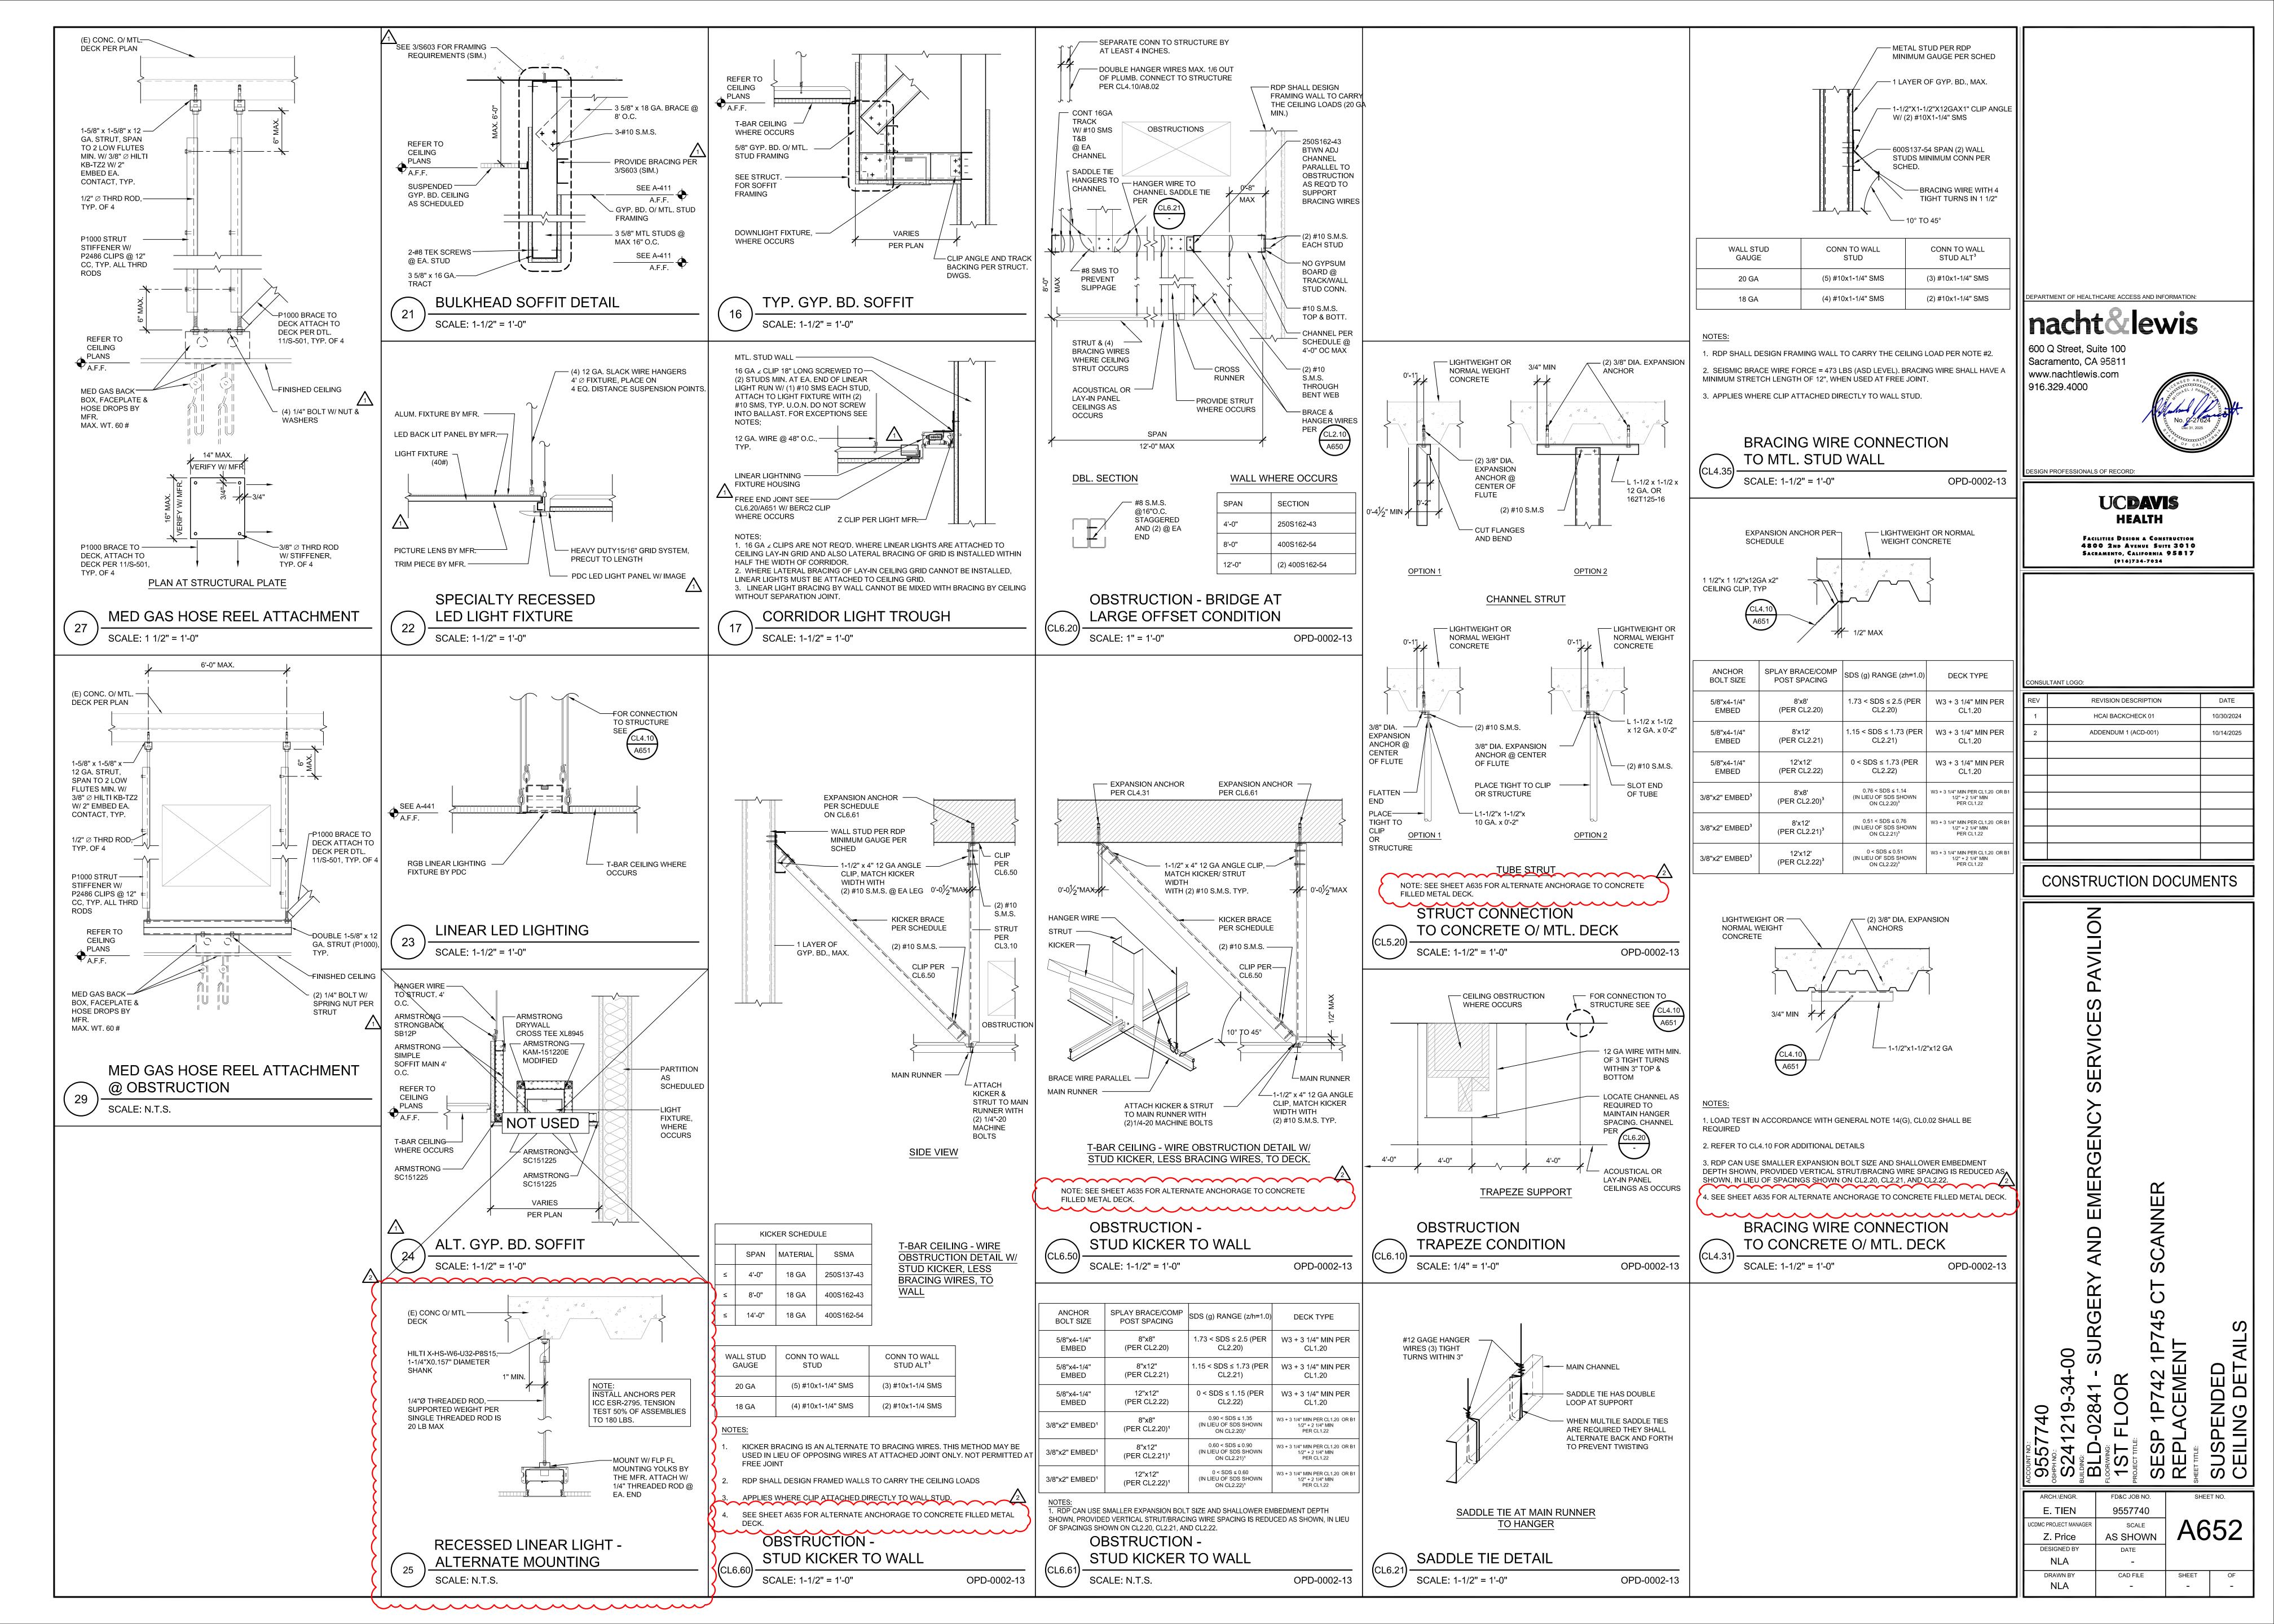

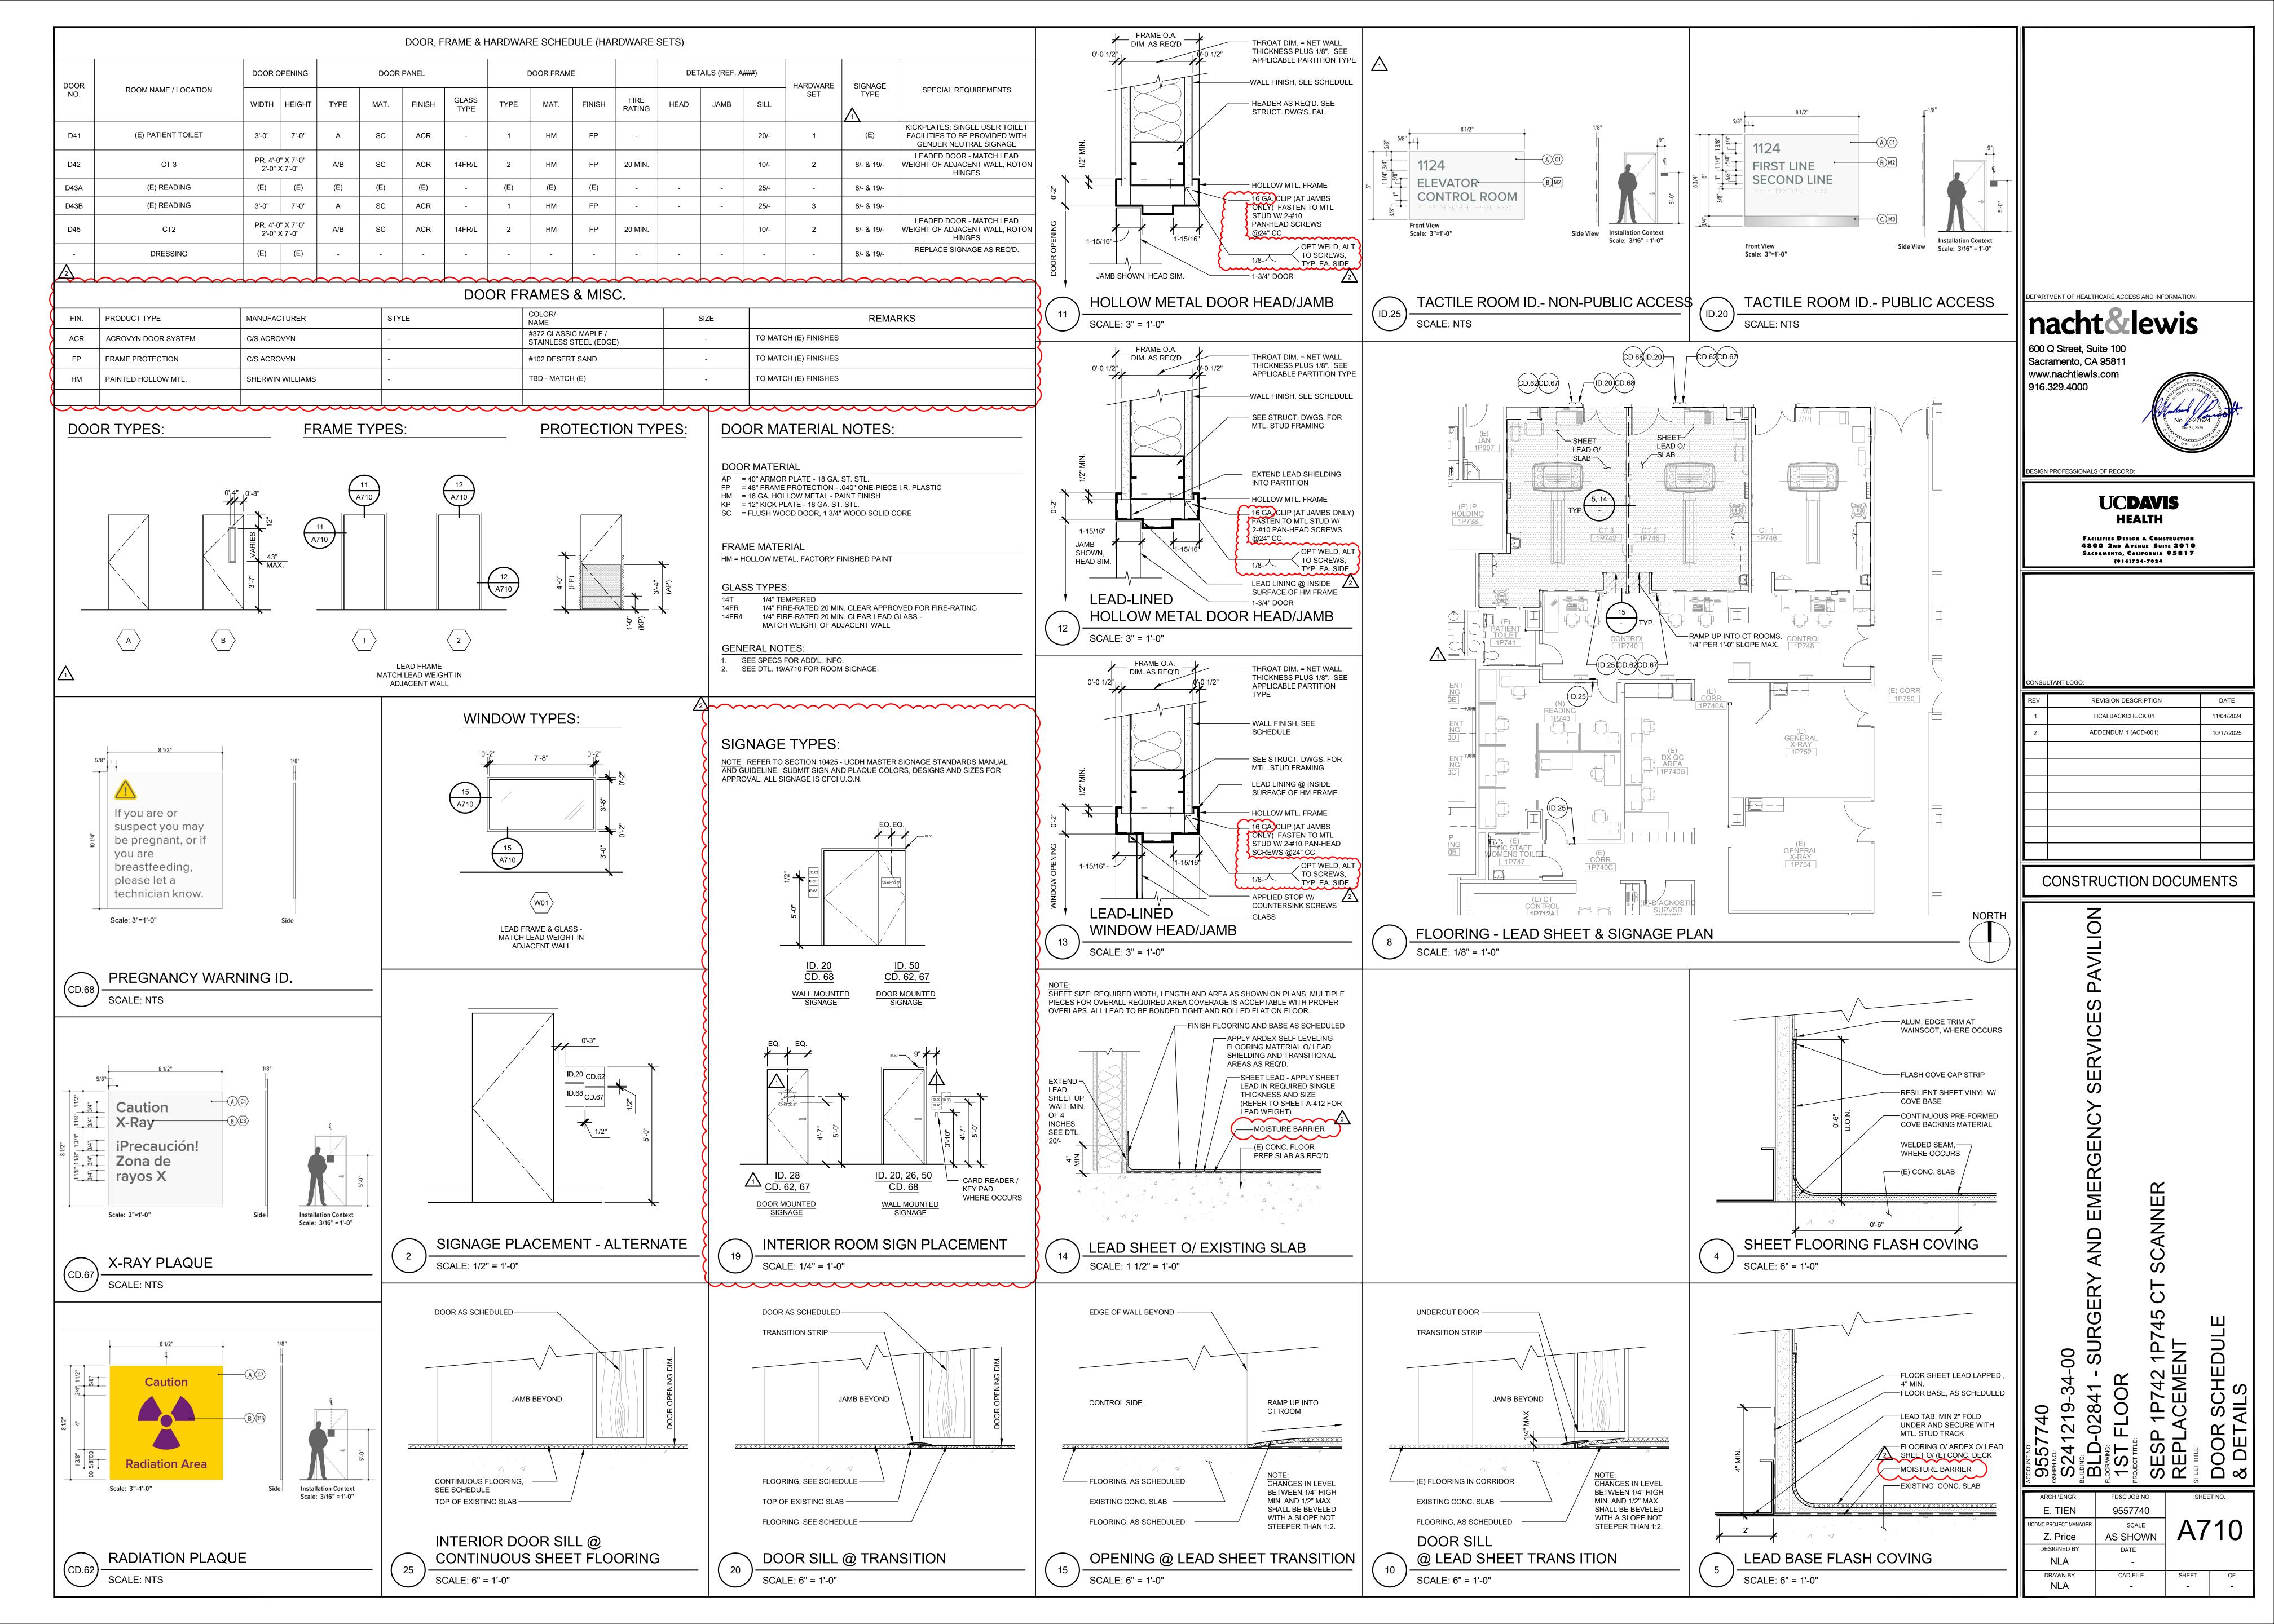

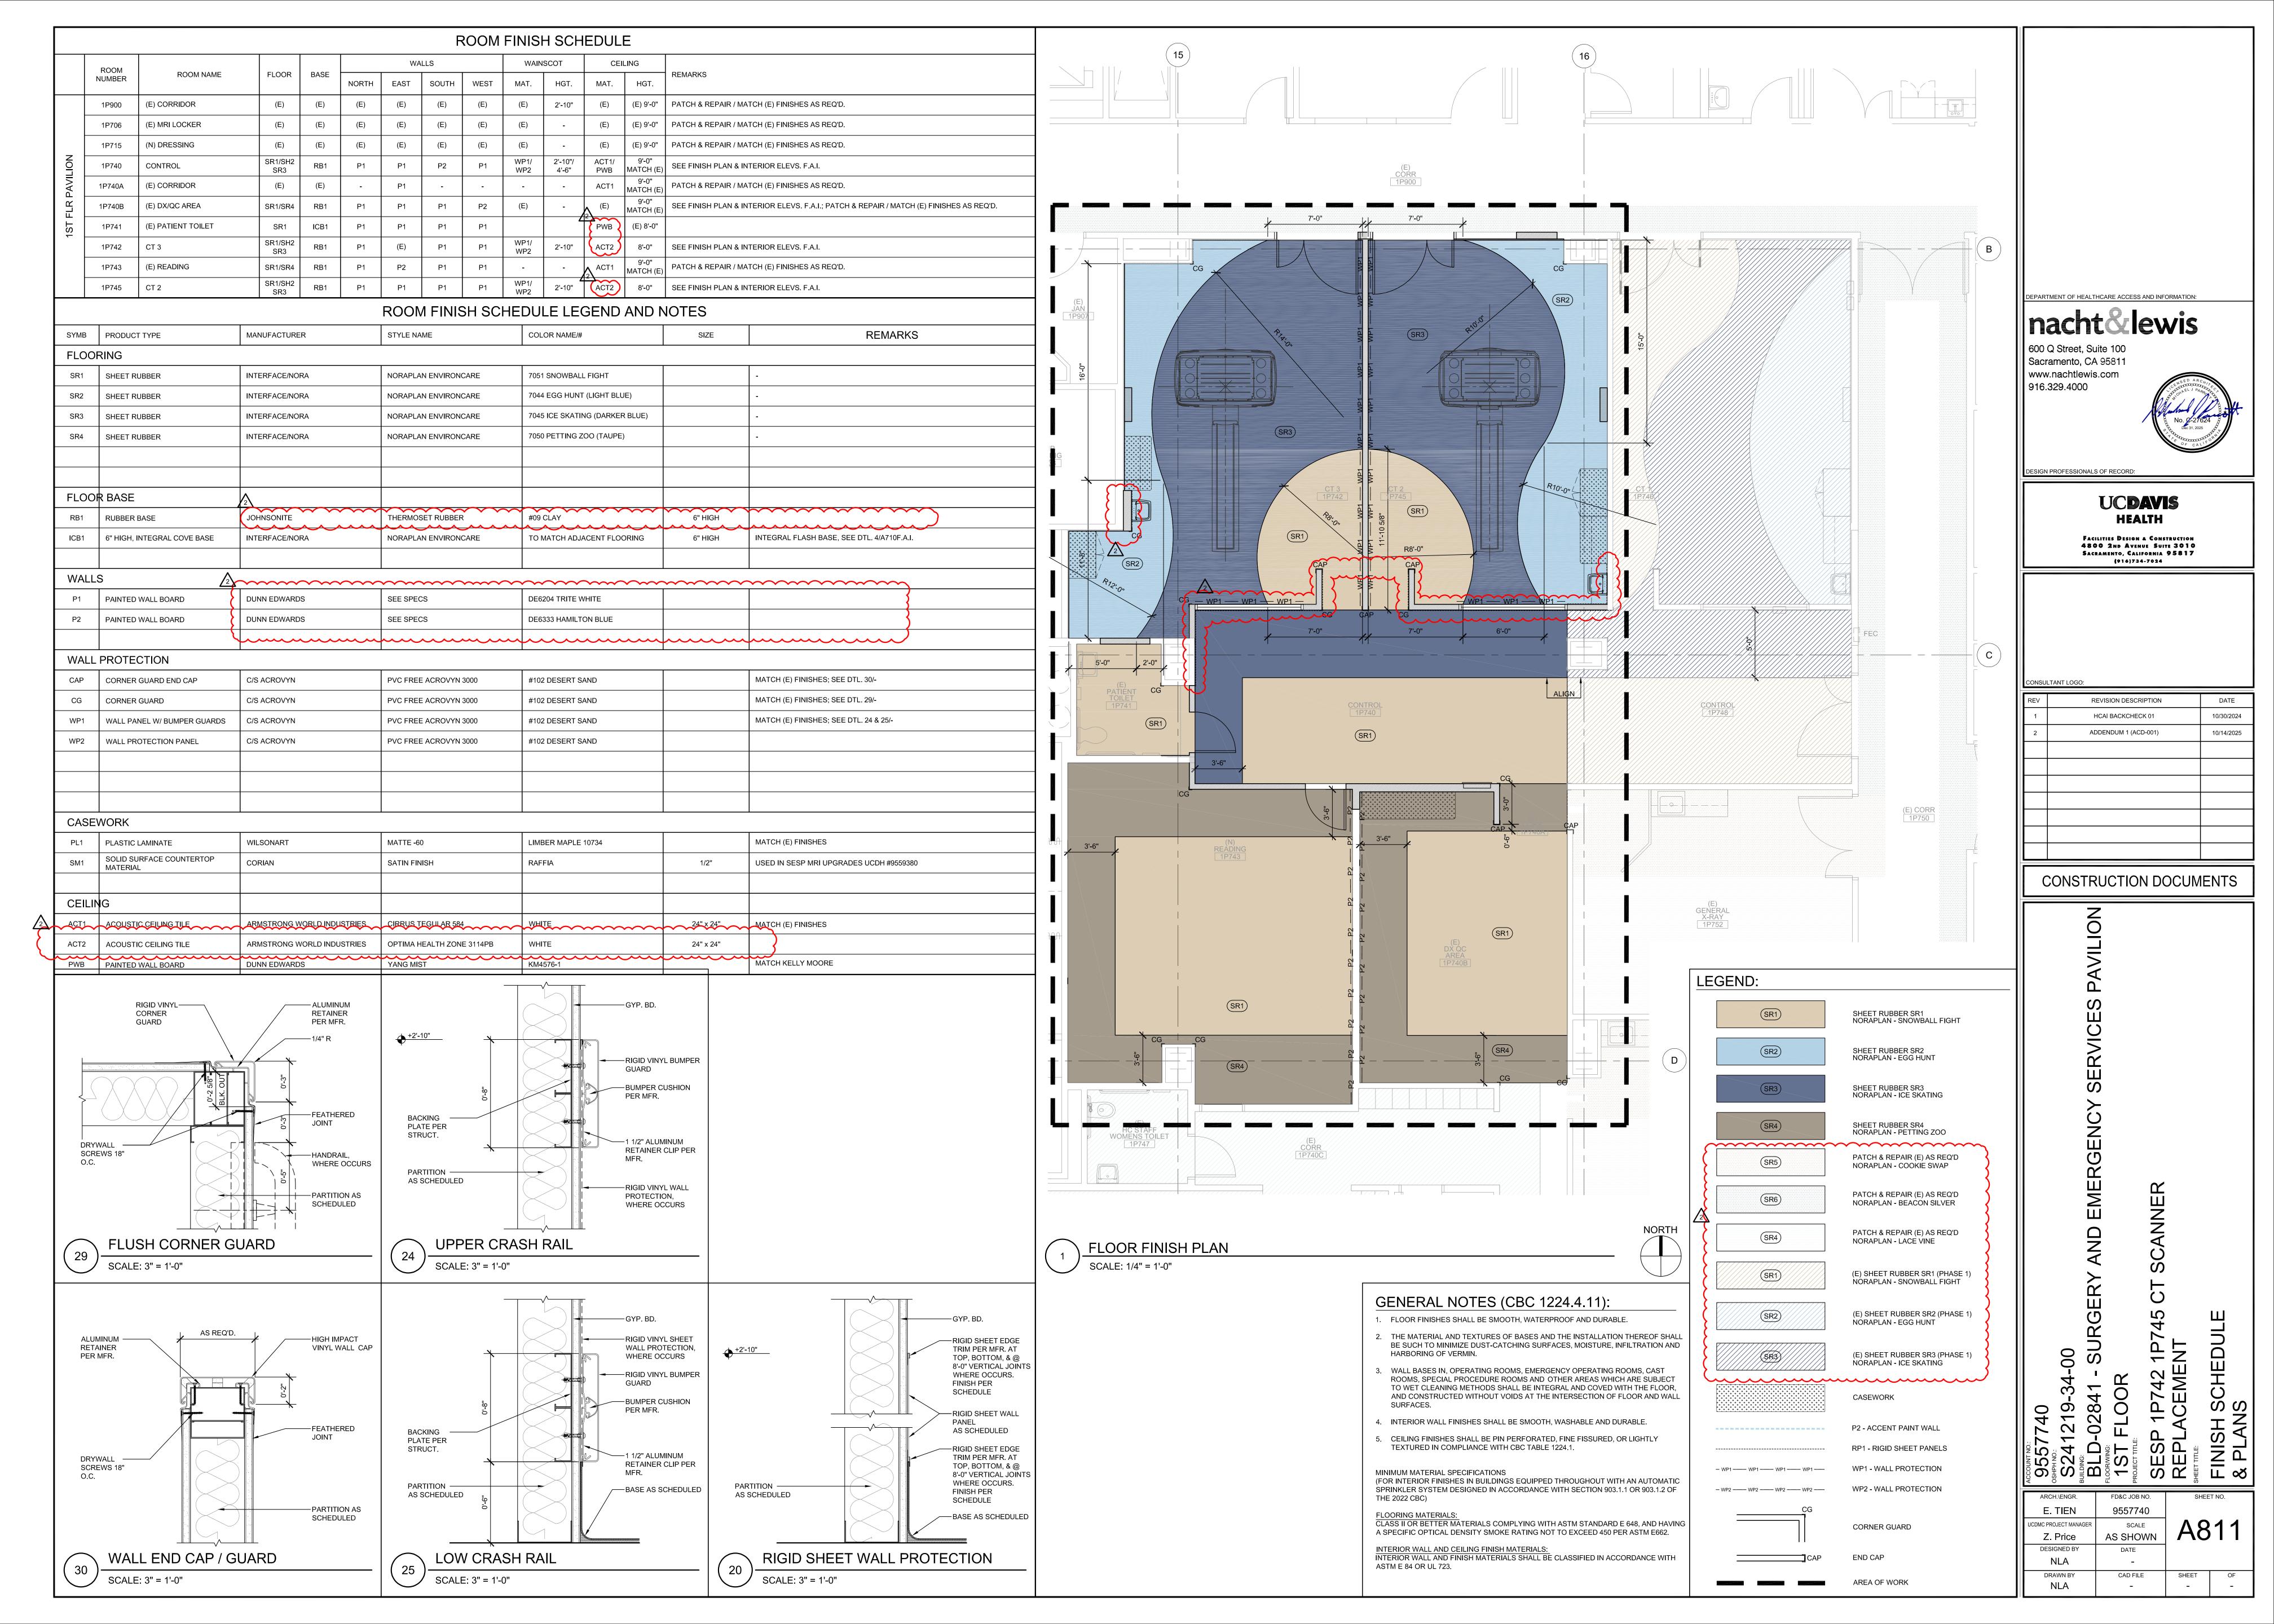


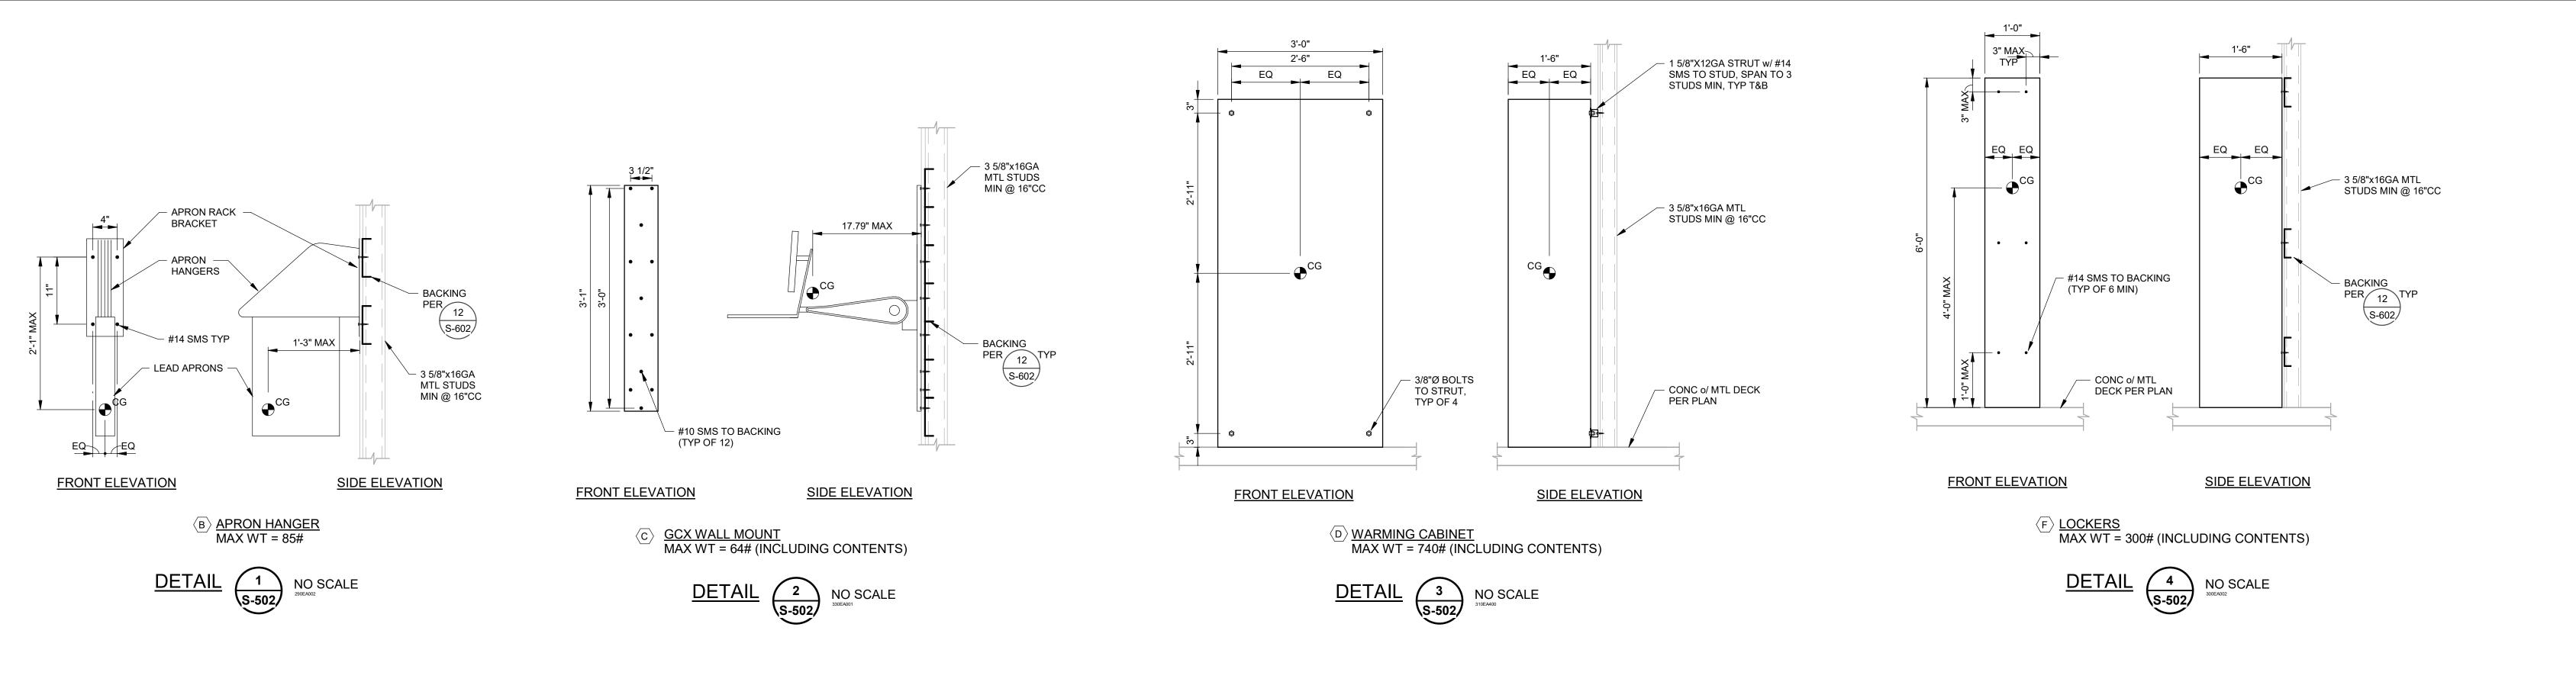

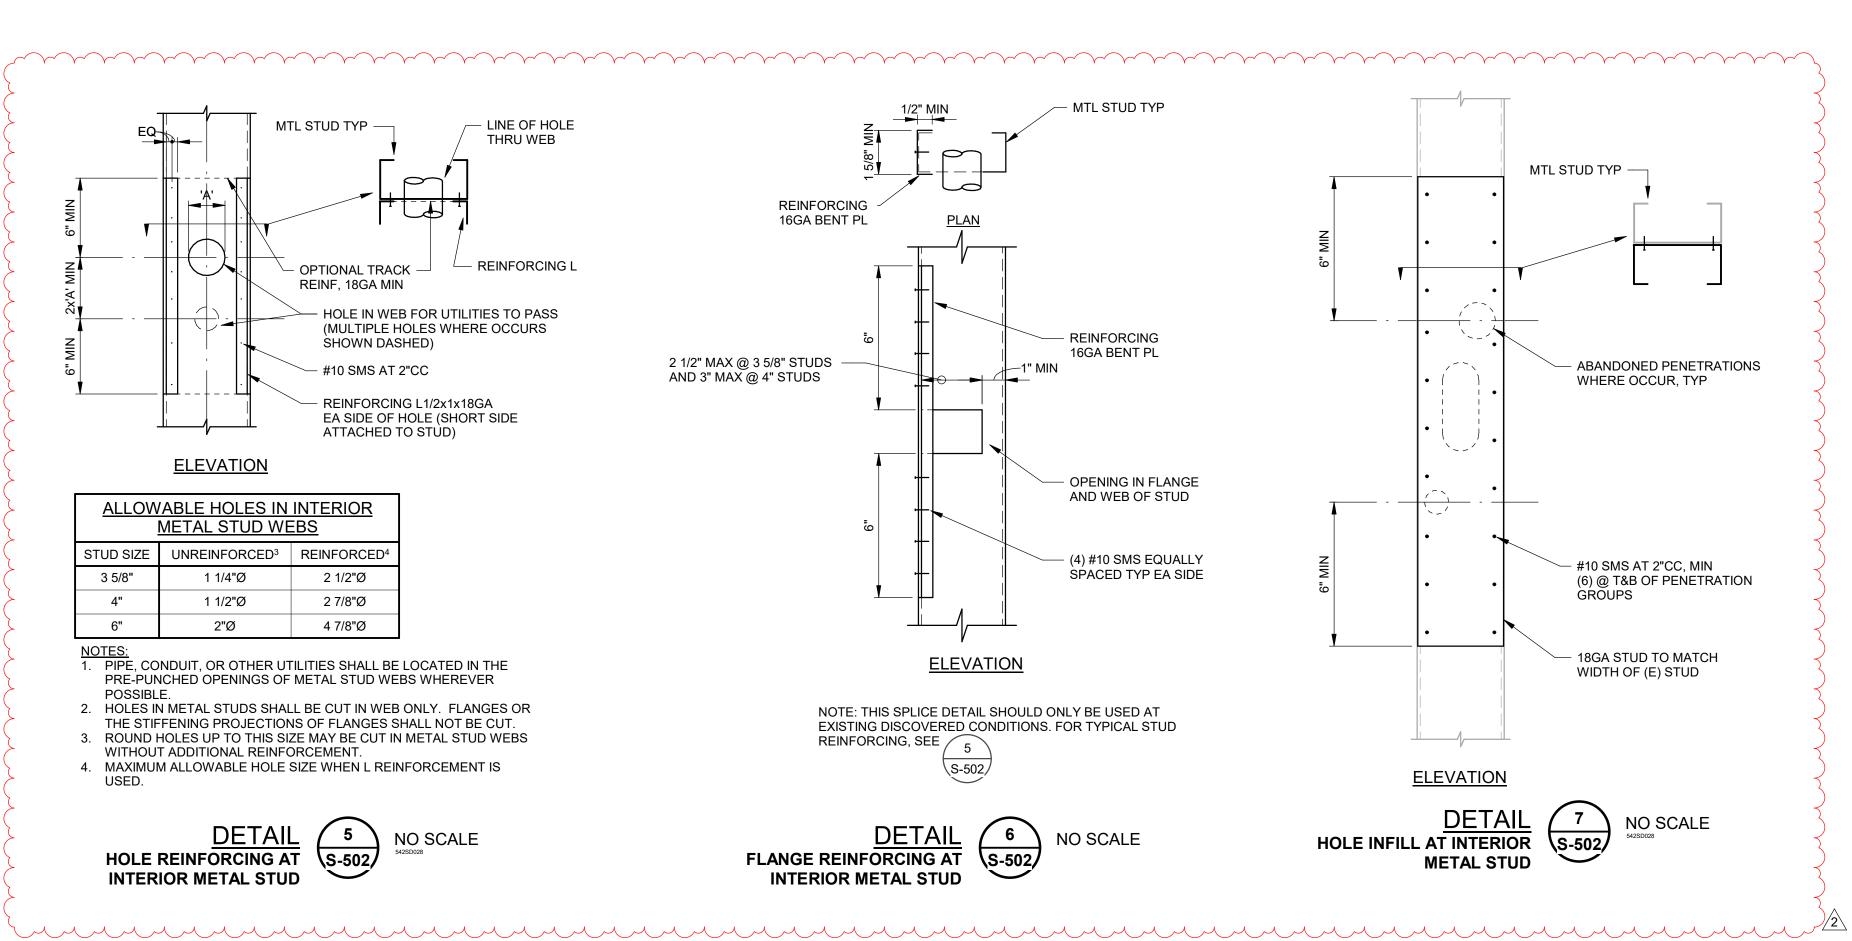

nacht&lewis

600 Q Street, Suite 100 Sacramento, CA 95811 www.nachtlewis.com 916.329.4000

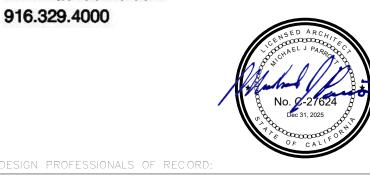

### UC**DAVIS** HEALTH

FACILITIES DESIGN & CONSTRUCTION
4800 2ND AVENUE SUITE 3010
SACRAMENTO, CALIFORNIA 95817
£9161734-7024





	910 443 0303											
CONSL	CONSULTANT LOGO:											
REV	REVISION DESCRIPTION	DATE										
2	ADDENDUM 1 (ACD-001)	09/07/202										

CONSTRUCTION DOCUMENTS

S241219-34-00

BLD-02841 - SURGERY AND EMERGENCY SERVICES PAVILION
FLOOR

SESP 1P742 1P745 CT SCANNER REPLACEMENT

SESP 1P742

SHEET NO.

SHEET NO.

JOHN F.

DMC PROJECT MANAGER SCALE

ZACH P.

DESIGNED BY DATE

AKH

DRAWN BY CAD FILE

AKH

-

NOTES:

1. USE J2 MINIMUM AT DOOR OPENINGS.

HEADER SPACED AT 8" MIN.

- 2. USE J2 AT 4'-0" MAX OPNGS IN 20GA WALLS (ALL STUD DEPTHS), 8"x18GA WALLS AND 4"x14GA WALLS.
- 3. USE 18GA MIN HEADERS AT 12'-0" MAX OPNGS IN 8" WALLS. 4. USE 16GA MIN HEADERS AT 16'-0" MAX OPNGS IN 3 5/8" & 4" WALLS. 5. USE 14GA MIN HEADERS AT 16'-0" MAX OPNGS IN 6" & 8" WALLS UNO.
- 6. USE HC4-10 HEADERS AT 16'-0" MAX OPNGS IN 8"x14GA WALLS. FOR JAMB, HEADER, AND SILL DETAILS, SEE SHEET **S-602**
- 8. "H4-8" INDICATES HEADER TYPE AND DEPTH OF VERTICAL STUD ELEMENTS INSIDE HEADER. "HC4-8" INDICATES COMPOSITE HEADER w/ ADDL SCREW
- REQUIREMENTS, SEE SCHEDULE & 3/S-602
- 9. FOR CONNECTION @ BASE OF WALL AT JAMBS SEE 7/S-601
- 10. FOR CONNECTION @ TOP OF WALL AT JAMBS SEE 5/S-601 11. 'W' WIDTH IS THE MAX WIDTH OF A SINGLE OPENING OR THE COMBINED WIDTH OF SIDE BY SIDE OPENINGS THAT SHARE A SINGLE JAMB STUD CONFIGURATION. 12. FOR HEADERS & SILLS, OPENINGS UP TO 1 1/4" MAX ARE ACCEPTABLE FOR CONDUIT. LOCATE OPENING AWAY FROM CLIPS & FLANGES. (2) HOLES MAX PER

B S-601 MAXIMUM HEIGHT FOR METAL STUD PARTITIONS DEFLECTION LIMIT L/120, NON-BEARING WITH DBL CABINETS OR EQUIP											
16"CC SPACING											
DEPTH	GAUGE	DESIGNATION 3	MAX HEIGHT								
3 5/8"	18	362S162-43	13'-6"								
3 5/8"	16	362S162-54	13'-6"								
3 5/8"	14	362S162-68	13'-6"								
4"	18	400S162-43	13'-6"								
4"	16	400S162-54	13'-6"								
4"	14	400S162-68	13'-6"								
6"	18	600S162-43	13'-6"								
6"	16	600S162-54	13'-6"								
6"	14	600S162-68	13'-6"								
8"	18	800S162-43	13'-6"								
8"	16	800S162-54	13'-6"								
8"	14	800S162-68	13'-6"								

NOTES:

1. STUDS SHALL BE DEPTH AS INDICATED ON ARCH DRAWINGS AND GAUGE AS DETERMINED BY THIS SCHEDULE. FOR TYPICAL WALL FRAMING CONDITIONS, SEE 1/S-601 2/S-601 3. DESIGNATION CONFORMS TO STEEL STUD MANUFACTURER'S ASSOCIATION

4. FOR WALL SUPPORTED CABINET INSTALLATION, SEE 14/S-602 THE MAX HEIGHTS NOTED IN THIS SCHEDULE ARE BASED ON THE USE OF SEISMIC COMPONENT LOAD FP OR A LIVE LOAD OF 5PSF, WHICHEVER GOVERNS.

TRACK ATTACHMENT AT JAMB STUDS											
JAMB	TRACK ATTACHMENT METHOD										
TYPE	SHOT PINS	1/2"Ø BOLTS									
J1	1	1	1								
J2	2	2	1								
J3	3	3	1								
J4	4	4	2								


NOTES:

1. SCHEDULE INDICATES TRACK ATTACHMENTS REQUIRED WHERE JAMB STUDS OCCUR. SEE TYPICAL SILL AND TOP TRACK ATTACHMENT DETAILS FOR BASIC ATTACHMENT METHODS (I.E. SHOT PINS, SMS, BOLTS, ETC.) & CONDITION'S BEYOND JAMB STUDS.

2. LOCATE ALL REQUIRED ATTACHMENTS AS CLOSE TO JAMB STUDS AS POSSIBLE. MAINTAIN ALL FASTENER SPACING AND EDGE DISTANCE REQUIREMENTS. AT SHOT PINS, SEE TYPICAL NOTES. AT SMS, MAINTAIN 1.5 x DIAMETER MIN EDGE DISTANCE & SPACING. AT BOLTS, SPACE NO CLOSER THAN 12 DIAMETERS AND NO MORE THAN 9" FROM END OF TRACK. 3. BOLTS SHOULD HAVE 4" EFFECTIVE EMBED DEPTH (MIN.)

IN LIEU OF BOLTS, 1/2"Ø HILTI KB-TZ2 BOLTS w/ 3 1/4"

EFFECTIVE EMBED MAY BE USED.

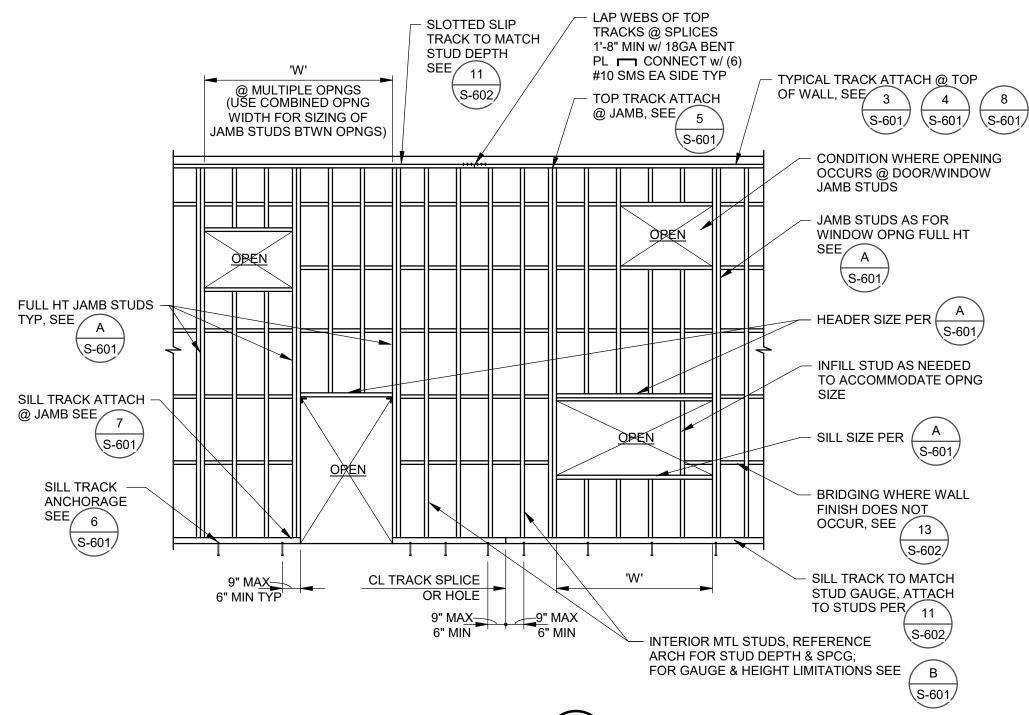


FULL HEIGHT INTERIOR \S-601

**METAL STUD WALL** 


CONNECT w/ (6) #10 SMS EA SIDE TYP - JAMB STUDS PER – FLOOR OR ROOF -CENTER ON DIÁG BRCG SEE PLANS DIAG BRCG @ 48"CC/ AND AT JAMBS PER (\_ JAMB STUDS AS FOR WINDOW OPNG SEE / A \ - HEADER SIZE PER (S-601) - SILL SIZE PER (-SILL TRACK ATTACH -**BRIDGING WHERE WALL** @ JAMB SEE FINISH DOES NOT OCCUR, SEE / 13 \S-601/ S-602/ SILL TRACK ANCHORAGE SILL TRACK TO MATCH SEE 6 STUD GAUGE, ATTACH TO STUDS PER 11 S-601, \S-602/ 9" MAX 6" MIN TYP TYP DOOR 6" MIN TYP WINDOW CL TRACK SPLICE OR HOLE - INTERIOR MTL STUDS, REFERENCE 9" MAX 6" MIN 6" MIN ARCH FOR STUD DEPTH & SPCG; FOR GAUGE & HEIGHT LIMITATIONS SEE / B

**PARTIAL HEIGHT INT** \S-601. **METAL STUD WALL** 

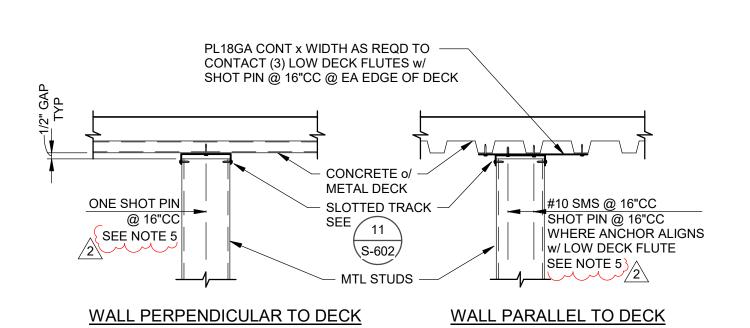

1. WHERE WALL IS PARALLEL TO DECK, & WALL CL IS WITHIN 1 1/2" OF CL OF LOW DECK FLUTE, TOP TRACK MAY BE ATTACHED DIRECTLY TO DECK AS IN PERPENDICULAR COND & CONT PL MAY BE OMITTED. SEE SHOT PIN NOTES FOR SPACING, EDGE DISTANCE & PLACEMENT REQUIREMENTS.
 WHERE BARE METAL DECK OCCURS, ATTACH TRACK OR PL18GA TO DECK WITH #10 SMS @ 16" CC (2 SMS @ PL) 4. FOR COND @ JAMB STUDS SEE <u>5/S-601</u>

(5. AT CONTR OPTION, SINGLE 3/8" HILTI KB-TZ2 w/ 2" EMBED MAY BE INSTALLED IN LIEU OF SHOTPIN(S). SLIP TRACK TO DECK w/ S-601,

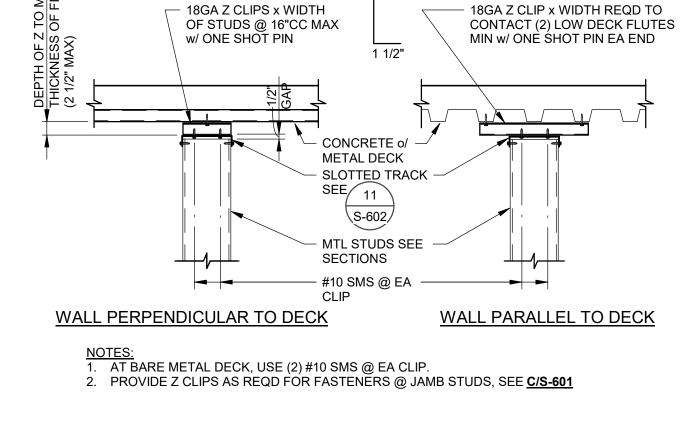




TOP TRACK SUPPORT AT JAMBS

SLIP TRACK TO DECK w/

FILL w/ FIREPROOFING

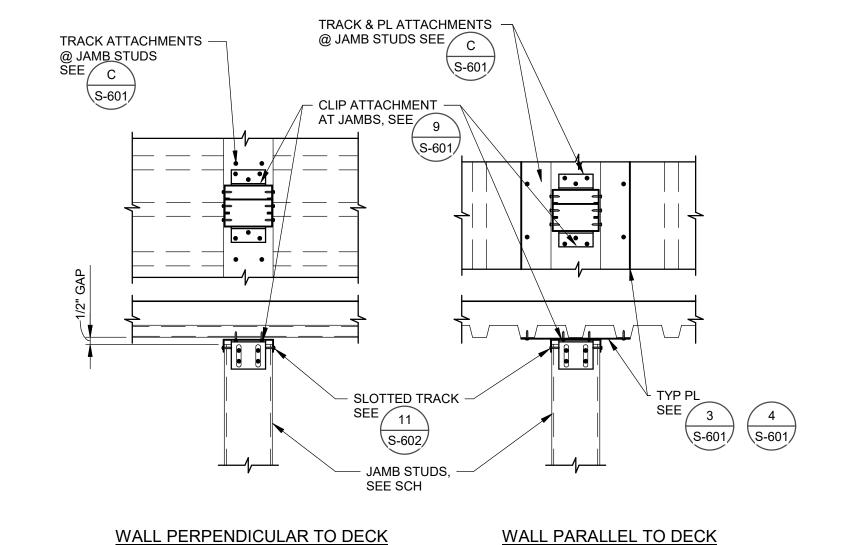

- LAP WEBS OF TOP TRACKS @ SPLICES

1'-8" MIN w/ 18GA BENT PL 1/4"


MATCH FP-THICKNESS

(2) Z CLIPS x WIDTH OF

**STUDS**; SEE RIGHT (MAY

BE OMITTED WHERE NO


FP OCCURS)

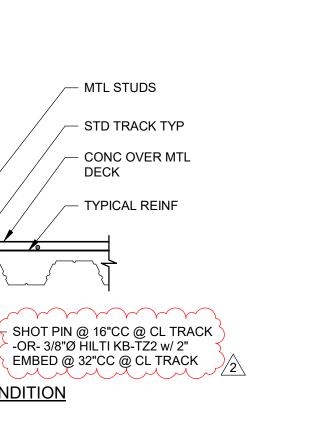



TYPICAL CONDITION

FILL w/o FIREPROOFING

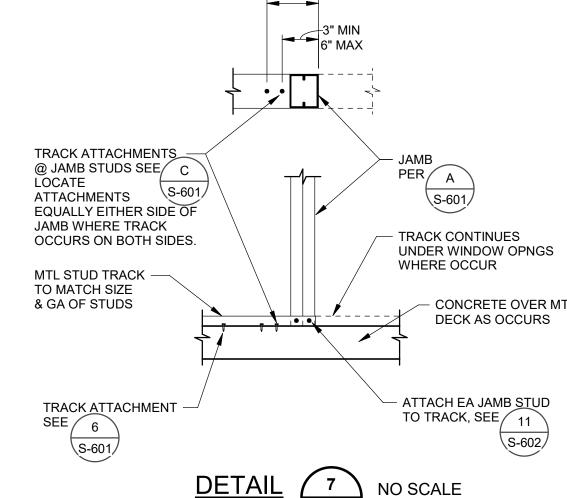

JAMB STUD AT SILL


JAMB


**TRACK** 

8'-0" MAX

HEADER

JAMB

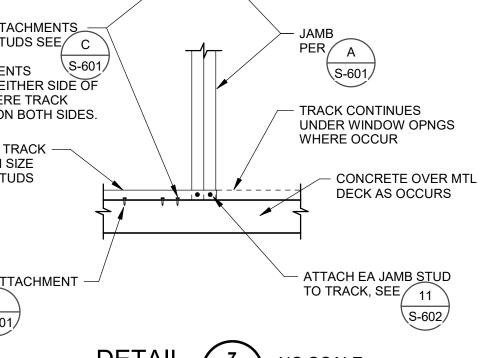


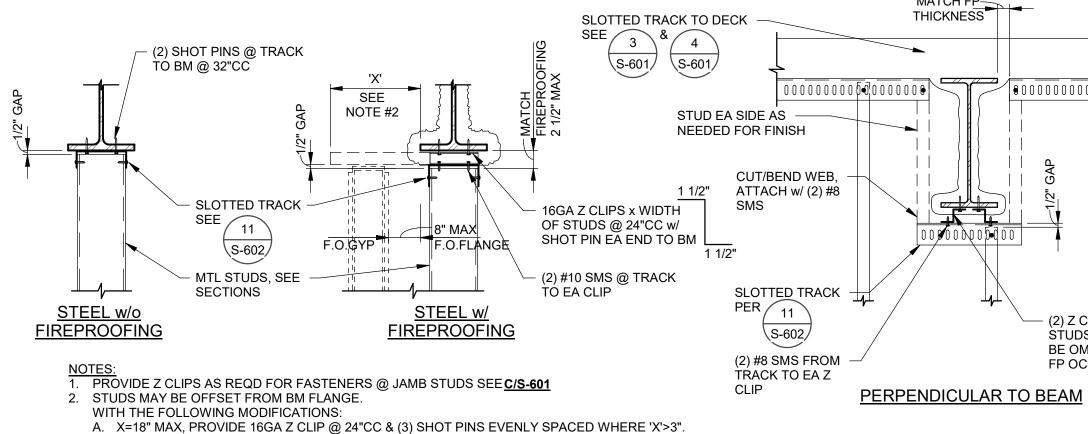

3. NOTIFY THE SEOR PRIOR TO ATTACHING TO MOMENT FRAME BEAMS OUTSIDE

OF THE PROTECTED ZONE. NO ATTACHMENTS SHALL BE MADE WITHIN

PROTECTED ZONES OF MOMENT FRAME BEAMS.

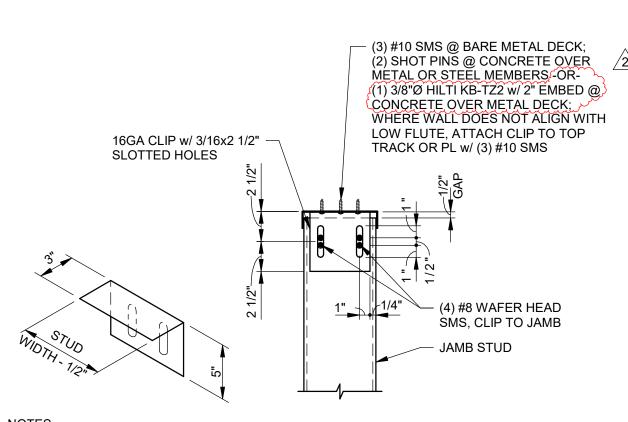


NOTES:


1. PROVIDE CLIP AT ALL EXTERIOR WALL JAMB STUDS AT SLOTTED TRACKS. PROVIDE CLIP AT ALL INTERIOR WALL DEFLECTION TRACKS WHERE OPENING WIDTH IS GREATER THAN 8'-0" WIDE. 2. CLIP TO OCCUR ONE SIDE OF J2 JAMBS, BOTH SIDES OF J3 & J4 JAMBS.

JAMB STUD CLIP AT SLIP
TRACK

S-601,

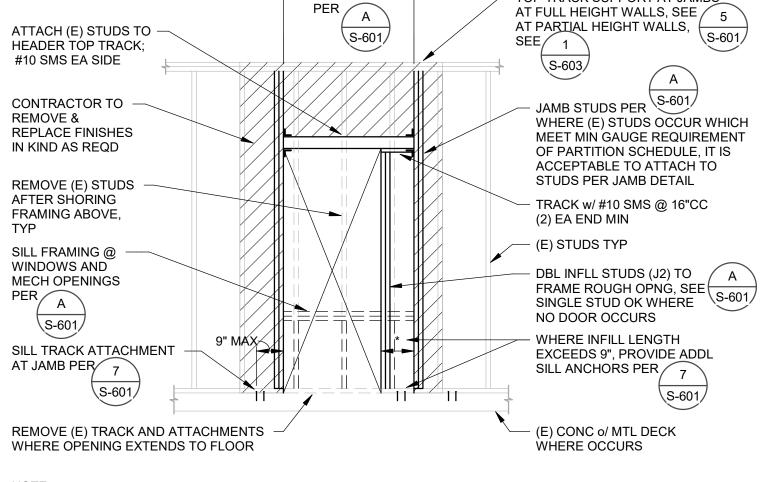

STUD FRAMING TO MATCH DEPTH OF (E) STUDS w/ MIN GAUGE PER INTERIOR METAL STUD PARTITION SCHEDULE OPENING AT (E) WALL \S-601

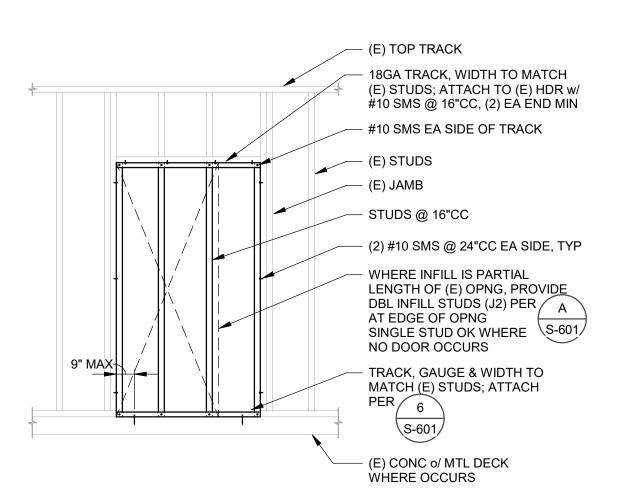

STUD FRAMING TO MATCH DEPTH OF (E) STUDS w/ MIN GAUGE PER INTERIOR METAL STUD PARTITION SCHEDULE OPENING INFILL \S-601,

PARTMENT OF HEALTHCARE ACCESS AND INFORMATION

600 Q Street, Suite 100 Sacramento, CA 95811 www.nachtlewis.com 916.329.4000



**UCDAVIS** HEALTH

FACILITIES DESIGN & CONSTRUCTION 4800 2ND AVENUE SUITE 3010 SACRAMENTO, CALIFORNIA 95817 (916)734-7024





CONSTRUCTION DOCUMENTS


**PAVILION** NNER

-028<sup>4</sup> FLO \_ JOHN F. ZACH P. 07/01/2024 AKH

45

-00 SUI

AKH

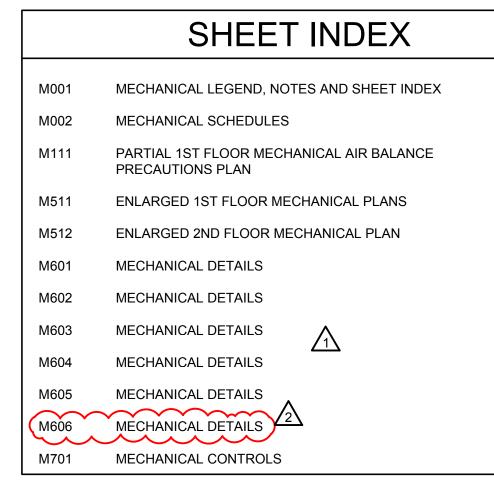

### GENERAL NOTES

- CONTRACTOR SHALL VISIT SITE TO REVIEW SCOPE OF WORK PRIOR TO SUBMISSION OF BID.
- 2. DRAWINGS ARE DIAGRAMMATIC AND SHALL NOT BE SCALED TO DETERMINE EXACT PLACEMENT OF NEW WORK. VERIFY ALL DIMENSIONS AND CONDITIONS IN THE FIELD BEFORE PROCEEDING WITH WORK. EXACT PLACEMENT SHALL BE COORDINATED BASED ON ACTUAL FIELD MEASUREMENTS AND CONDITIONS.
- 3. COORDINATE REQUIREMENTS OF NEW WORK WITH OTHER TRADES AND PROVIDE ALL NECESSARY APPURTENANCES AND INCIDENTAL LABOR, INCLUDING PARTS AND ACCESSORIES, CONNECTIONS, SYSTEM START-UP AND TESTING AS REQUIRED TO ACHIEVE A COMPLETE FULLY FUNCTIONING INSTALLATION READY FOR OPERATION.
- OF ALL PROJECT WORK AND SUBMIT TO THE OWNER'S REPRESENTATIVE FOR REVIEW AND APPROVAL. SHOP DRAWINGS SHALL INCLUDE DETAILED PLAN VIEW LAYOUTS (1/4" SCALE MINIMUM) SHOWING EQUIPMENT, DUCTWORK AND PIPING WITH DUCT AND PIPE SIZES AND ELEVATIONS ABOVE FINISHED FLOOR. COORDINATE WORK WITH OTHER TRADES AS REQUIRED TO ACHIEVE INTENDED ARCHITECTURAL ELEVATIONS.

PRIOR TO FABRICATION, CONTRACTOR SHALL PREPARE FULLY COORDINATED DETAILED SHOP DRAWINGS (DRAWN TO SCALE)

- 5. AVOID ROUTING PIPING ABOVE ELECTRICAL EQUIPMENT AND CABLE TRAYS. WHERE INSTALLATION OF PIPING ABOVE ELECTRICAL EQUIPMENT OR CABLE TRAYS IS UNAVOIDABLE, INSTALL PIPING WITH A MINIMUM NUMBER OF JOINTS. JOINTS, FITTINGS, VALVES OR SIMILAR COMPONENTS SHALL BE LOCATED A MINIMUM OF 36 INCHES FROM EACH SIDE OF EQUIPMENT OR TRAY. PROVIDE DRIP PAN(S) WITH MOISTURE DETECTION ABOVE CRITICAL EQUIPMENT.
- 6. ALL WORK SHALL COMPLY WITH THE CALIFORNIA CODE OF REGULATIONS, TITLE 24 (2022 EDITION), INCLUDING THE CALIFORNIA BUILDING CODE (CBC), CALIFORNIA MECHANICAL CODE (CMC), CALIFORNIA PLUMBING CODE (CPC), CALIFORNIA FIRE CODE (CFC), CALIFORNIA GREEN BUILDING STANDARDS CODE, CALIFORNIA ENERGY CODE AND CALIFORNIA ELECTRICAL CODE.
- 7. ALL WORK MUST BE PERFORMED IN ACCORDANCE WITH THE GENERAL CONDITIONS OF THE PRIME CONTRACT.
- 8. CONSTRUCTION SHALL BE ORGANIZED IN SUCH A MANNER AS TO MINIMIZE DISRUPTION TO FACILITY OPERATIONS AND DISTURBANCE OF OCCUPANTS. NOTIFY OWNER'S REPRESENTATIVE A MINIMUM OF 48 HOURS IN ADVANCE OF ANY REQUIRED SYSTEM SHUTDOWNS, DISTURBANCE OF OR ENCROACHMENT INTO OCCUPIED AREAS. PERFORM ACTIVITIES SUCH AS MASONRY DRILLING AND SAWCUTTING ONLY DURING DESIGNATED HOURS; DAMPEN NOISE AND VIBRATION TRANSMITTED TO OCCUPIED AREAS TO THE GREATEST EXTENT POSSIBLE. MAINTAIN EGRESS FROM OCCUPIED AREAS AT ALL TIMES. DO NOT OBSTRUCT OR OTHERWISE IMPEDE PEDESTRIAN OR VEHICULAR TRAFFICWAYS CRITICAL TO THE ONGOING OPERATION OF THE FACILITY.
- 9. CONTRACTOR SHALL COMPLY WITH THE FACILITY'S POLICIES AND PROCEDURES REGARDING CONTAINMENT /ISOLATION OF CONSTRUCTION AREAS AND ACTIVITIES THROUGHOUT CONSTRUCTION OF THE PROJECT. PROVIDE DUST PROTECTION, CONSTRUCTION BARRIERS, AND /OR FILTRATION ON HVAC SYSTEM INLETS AS REQUIRED TO PROTECT OCCUPIED AREAS AND AFFECTED HVAC SYSTEMS FROM CONTAMINATION BY AIRBORNE POLLUTANTS (INCLUDING DUST, SMOKE, FUMES AND ODORS) GENERATED BY CONSTRUCTION ACTIVITIES.
- 10. MEANS, METHODS AND TIMING OF WORK SHALL BE COORDINATED WITH AND APPROVED BY THE OWNER'S REPRESENTATIVE INSOFAR AS THEY AFFECT FACILITY OPERATIONS. MEANS AND METHODS ARE STILL SUBJECT TO ACCEPTANCE BY THE AUTHORITY HAVING JURISDICTION AND MUST COMPLY WITH DESIGN AND CODE INTENT.
- 11. PRE-APPROVED PIPES, DUCTS, AND CONDUITS SEISMIC BRACING
- A. THE CONTRACTOR SHALL PROVIDE LAYOUT DRAWINGS OF THE SUPPORTS, ATTACHMENTS, AND BRACING SYSTEMS IN ACCORDANCE WITH THE SELECTED HCAI PRE-APPROVED SYSTEM AND SHALL BE SUBMITTED TO THE REGISTERED DESIGN PROFESSIONAL (RDP) IN RESPONSIBLE CHARGE OF THE PROJECT FOR REVIEW TO VERIFY THAT THE DETAILS ARE IN CONFORMANCE WITH THE CODE REQUIREMENTS. THE LAYOUT DRAWINGS SHALL AS A MINIMUM SATISFY THE REQUIREMENTS OF ASCE 7 SECTION 13.6 AS MODIFIED BY THE CBC 2022 SECTION 1617A.
- a) THE STRUCTURAL ENGINEER OF RECORD (SEOR) SHALL VERIFY THAT THE SUPPORTING STRUCTURE IS ADEQUATE FOR THE FORCES IMPOSED ON IT BY THE SUPPORTS, ATTACHMENTS, AND BRACES INSTALLED IN ACCORDANCE WITH THE
- PRE-APPROVAL IN ADDITION TO ALL OTHER LOADS.
  b) THE SEOR SHALL FORWARD THE SUPPORTS, ATTACHMENTS, AND BRACING DRAWINGS (INCLUDING APPROVED AMENDED CONSTRUCTION DOCUMENTS FOR SUPPLEMENTARY FRAMING WHERE REQUIRED) TO THE DISCIPLINE IN RESPONSIBLE CHARGE WITH A NOTATION INDICATING THAT THE DRAWINGS HAVE BEEN REVIEWED AND ARE IN
- GENERAL CONFORMANCE WITH A NOTATION INDICATING THAT THE DRAWINGS HAVE BEEN REVIEWED AND ARE IN GENERAL CONFORMANCE WITH THE PRE-APPROVAL AND THE DESIGN OF THE PROJECT.

  c) A "SHOP DRAWING STAMP" MAY BE USED TO INDICATE COMPLIANCE WITH THIS REQUIREMENT.
- d) THE REGISTERED DESIGN PROFESSIONAL (RDP) OTHER THAN SEOR, MAY PROVIDE THE SHOP DRAWING STAMP FOR SMALL PROJECTS AT THE DISCRETION OF THE HCAI DISTRICT STRUCTURAL ENGINEER.
- B. THE SEOR SHALL DESIGN ANY SUPPLEMENTARY FRAMING THAT IS NEEDED TO RESIST THE LOADS, MAINTAIN STABILITY AND/OR IS REQUIRED FOR INSTALLATION OF PRE-APPROVED SYSTEM.
- a) THE SUPPLEMENTARY FRAMING SHALL BE SUBMITTED TO HCAI AS AN AMENDED CONSTRUCTION DOCUMENTS (ACD).
- C. THE LAYOUT DRAWINGS (WITH THE SHOP DRAWING STAMP) SHALL BE SUBMITTED TO HCAI TO REVIEW:
- a) STRUCTURE SUPPORTING THE DISTRIBUTION SYSTEM HAS ADEQUATE CAPACITY.
- b) SEISMIC DESIGN FORCES (FP) ARE IN ACCORDANCE WITH THE CBC 2022.
   c) VERIFY THAT SUBMITTAL IS WITHIN THE SCOPE OF HCAI PRE-APPROVAL OF MANUFACTURER'S CERTIFICATION (OPM).
- 12. REFER TO STRUCTURAL DRAWINGS FOR SEISMIC CRITERIA.
- 13. THE EQUIPMENT MANUFACTURERS AND MODELS SPECIFIED ON THE DRAWINGS SERVE AS THE BASIS OF DESIGN. NO SUBSTITUTIONS OF ANY EQUIPMENT ARE ALLOWED WITHOUT FIRST OBTAINING APPROVAL FROM THE OWNER'S REPRESENTATIVE. ANY PROPOSED SUBSTITUTIONS MUST BE FROM ONE OF THE ALTERNATE MANUFACTURERS LISTED IN THE SPECIFICATIONS; MUST MATCH THE PHYSICAL CONFIGURATION AND REQUIREMENTS OF THE SPECIFIED MODEL INCLUDING OVERALL DIMENSIONS, INLET AND OUTLET CONFIGURATION, REQUIRED CLEARANCES, ACCESS AND POWER REQUIREMENTS; AND MUST MEET SEISMIC CERTIFICATION REQUIREMENTS WHERE MANDATED BY THE AUTHORITY HAVING JURISDICTION. PERFORMANCE FEATURES AND CONSTRUCTION OF ANY PROPOSED SUBSTITUTION SHALL MEET OR EXCEED THOSE SPECIFIED ON THE DRAWINGS AND IN THE SPECIFICATIONS. STRUCTURAL ENGINEERING CALCULATIONS FOR EQUIPMENT SUPPORT AND ANCHORAGE SHALL BE SUBMITTED BY THE CONTRACTOR AT THE TIME OF SUBMITTAL OF ANY SUBSTITUTION FOR REVIEW BY THE ARCHITECT, MECHANICAL AND STRUCTURAL ENGINEERS OF RECORD, AND HCAI FIELD PERSONNEL. SUBSTITUTIONS REQUIRING CHANGES TO THE CONTRACT DOCUMENTS BY MEANS OF A CHANGE ORDER ARE NOT ALLOWED.
- 14. WHERE EXISTING UTILITIES NOT SHOWN ON THE DRAWINGS ARE ENCOUNTERED, NOTIFY OWNER'S REPRESENTATIVE IMMEDIATELY. SUPPORT AND PROTECT UTILITIES UNTIL PROVISIONS CAN BE MADE FOR RELOCATION OR OTHER SOLUTION.
- 15. CUTTING AND DEMOLITION WORK SHALL NOT COMPROMISE STRUCTURAL INTEGRITY OF THE EXISTING CONSTRUCTION OR DAMAGE PORTIONS OF EXISTING WORK TO REMAIN.
- 16. OWNER RESERVES THE RIGHT TO RETAIN ALL MATERIALS AND EQUIPMENT REMOVED FROM THE PROJECT. ANY ITEMS OR MATERIALS NOT DESIRED BY THE OWNER SHALL BE REMOVED FROM THE OWNER'S PROPERTY BY THE CONTRACTOR AT THE CONTRACTOR'S EXPENSE
- 17. COORDINATE METHOD, ROUTE AND TIMING OF MATERIAL AND DEBRIS REMOVAL WITH OWNER'S REPRESENTATIVE PRIOR TO ANY REMOVAL.

18. PATCH AND REPAIR ANY DAMAGE TO WALLS, FLOORS, CEILINGS, CABINETS, HARDWARE, WINDOWS, FIXTURES, ETC. RESULTING


FROM PROJECT WORK. REFER TO ARCHITECTURAL PLANS AND SPECIFICATIONS FOR DRYWALL AND FINISH PATCHWORK AND

- REPAIR REQUIREMENTS. MATCH EXISTING FINISHES AS CLOSELY AS POSSIBLE UNLESS NOTED OTHERWISE. PATCHES AND REPAIRS SHALL RESTORE FINISH TO "LIKE NEW" CONDITION.

  19. SEAL AND PROTECT ALL PIPE, DUCT AND CONDUIT PENETRATIONS OF FLOORS, WALLS, CEILINGS AND ROOF. METHODS AND
- MATERIALS USED FOR TREATMENT OF PENETRATIONS THROUGH RATED ASSEMBLIES SHALL BE U.L. AND FIRE MARSHAL APPROVED.
- 20. ALL LOCATIONS FOR SAW-CUTTING OF CONCRETE SLABS, CORING OF CONCRETE SURFACES, DRILLING FOR ANCHOR BOLTS, ETC. SHALL BE COORDINATED WITH AND APPROVED BY A CALIFORNIA LICENSED STRUCTURAL ENGINEER <u>PRIOR</u> TO COMMENCING WORK.
- 21. ALL ROOFING AND FLASHING ELEMENTS SHOWN ON THESE DRAWINGS ARE FOR REFERENCE ONLY. CONTRACTOR SHALL REFER TO ARCHITECTURAL DRAWINGS FOR ALL ROOFING AND FLASHING DETAILS.
- 22. CONTRACTOR MAY SUBSTITUTE NEW ROUND OR RECTANGULAR DUCT SHOWN ON PLANS WITH ROUND OR RECTANGULAR DUCT OF EQUIVALENT OR GREATER CROSS-SECTIONAL AREA. CONTRACTOR TO INDICATE ON SHOP DRAWING SUBMITTAL WHERE SUCH SUBSTITUTIONS OCCUR. CONTRACTOR TO BE RESPONSIBLE FOR RE-ENGINEERING ALL DUCTWORK SUPPORTS FOR SUBSTITUTED DUCTWORK.
- 23. CONTRACTOR SHALL COORDINATE FINAL THERMOSTAT LOCATIONS WITH OTHER TRADES, INCLUDING ARCHITECTURAL ELECTRICAL AND FIRE ALARM.
- 24. CONTRACTOR SHALL LABEL ALL VALVES SEQUENTIALLY USING THE EXISTING FACILITY TAG INVENTORY LIST. USE METAL TAGS. TAGS SHALL TO BE 2" DIAMETER AND FABRICATED OF BRASS OR STAINLESS STEEL. TAGS SHALL BE ATTACHED WITH JACK CHAIN MADE FROM THE SAME MATERIAL.
- 25. MECHANICAL EQUIPMENT TAGS USED WITHIN THESE PROJECT DRAWINGS ARE GENERIC FOR PROJECT DOCUMENT DEVELOPMENT AND DESIGN TEAM COORDINATION. CONTRACTOR SHALL COORDINATE THE PREFERRED EQUIPMENT TAGS/NAMING WITH THE UNIVERSITY REPRESENTATIVE. UPDATED TAG/NAMING INFORMATION SHALL BE INCLUDED IN THE CONTRACTOR AS-BUILTS AND PROJECT RECORD DRAWINGS SUBMITTAL AT PROJECT COMPLETION.
- 26. ALL NEW WASTE PIPING SHALL BE SLOPED UNIFORMLY BETWEEN THE UPPER TERMINAL OF THE WASTE SYSTEM AND/OR SITE PIPING NOT LESS THAN ½" PER FOOT, UNLESS OTHERWISE NOTED. WHERE SLOPES LESS THAN ½" PER FOOT ARE INDICATED, THE NEW PIPING SHALL BE SLOPED TO ACHIEVE THE MAXIMUM SLOPE POSSIBLE, BUT NOT LESS THAN INDICATED OR ALLOWED BY CODE.

### HCAI INTENT NOTE

THE INTENT OF THE CONSTRUCTION DOCUMENTS IS TO RECONSTRUCT THE HOSPITAL BUILDING IN ACCORDANCE WITH THE 2022 CBC. SHOULD ANY CONDITIONS DEVELOP NOT COVERED BY THE APPROVED CONSTRUCTION DOCUMENTS, WHEREIN THE FINISHED WORK WILL NOT COMPLY WITH THE 2022 CBC, AMENDED CONSTRUCTION DOCUMENTS (ACDs) DETAILING AND SPECIFYING THE REQUIRED WORK SHALL BE SUBMITTED TO AND APPROVED BY HCAI BEFORE PROCEEDING WITH THE WORK.

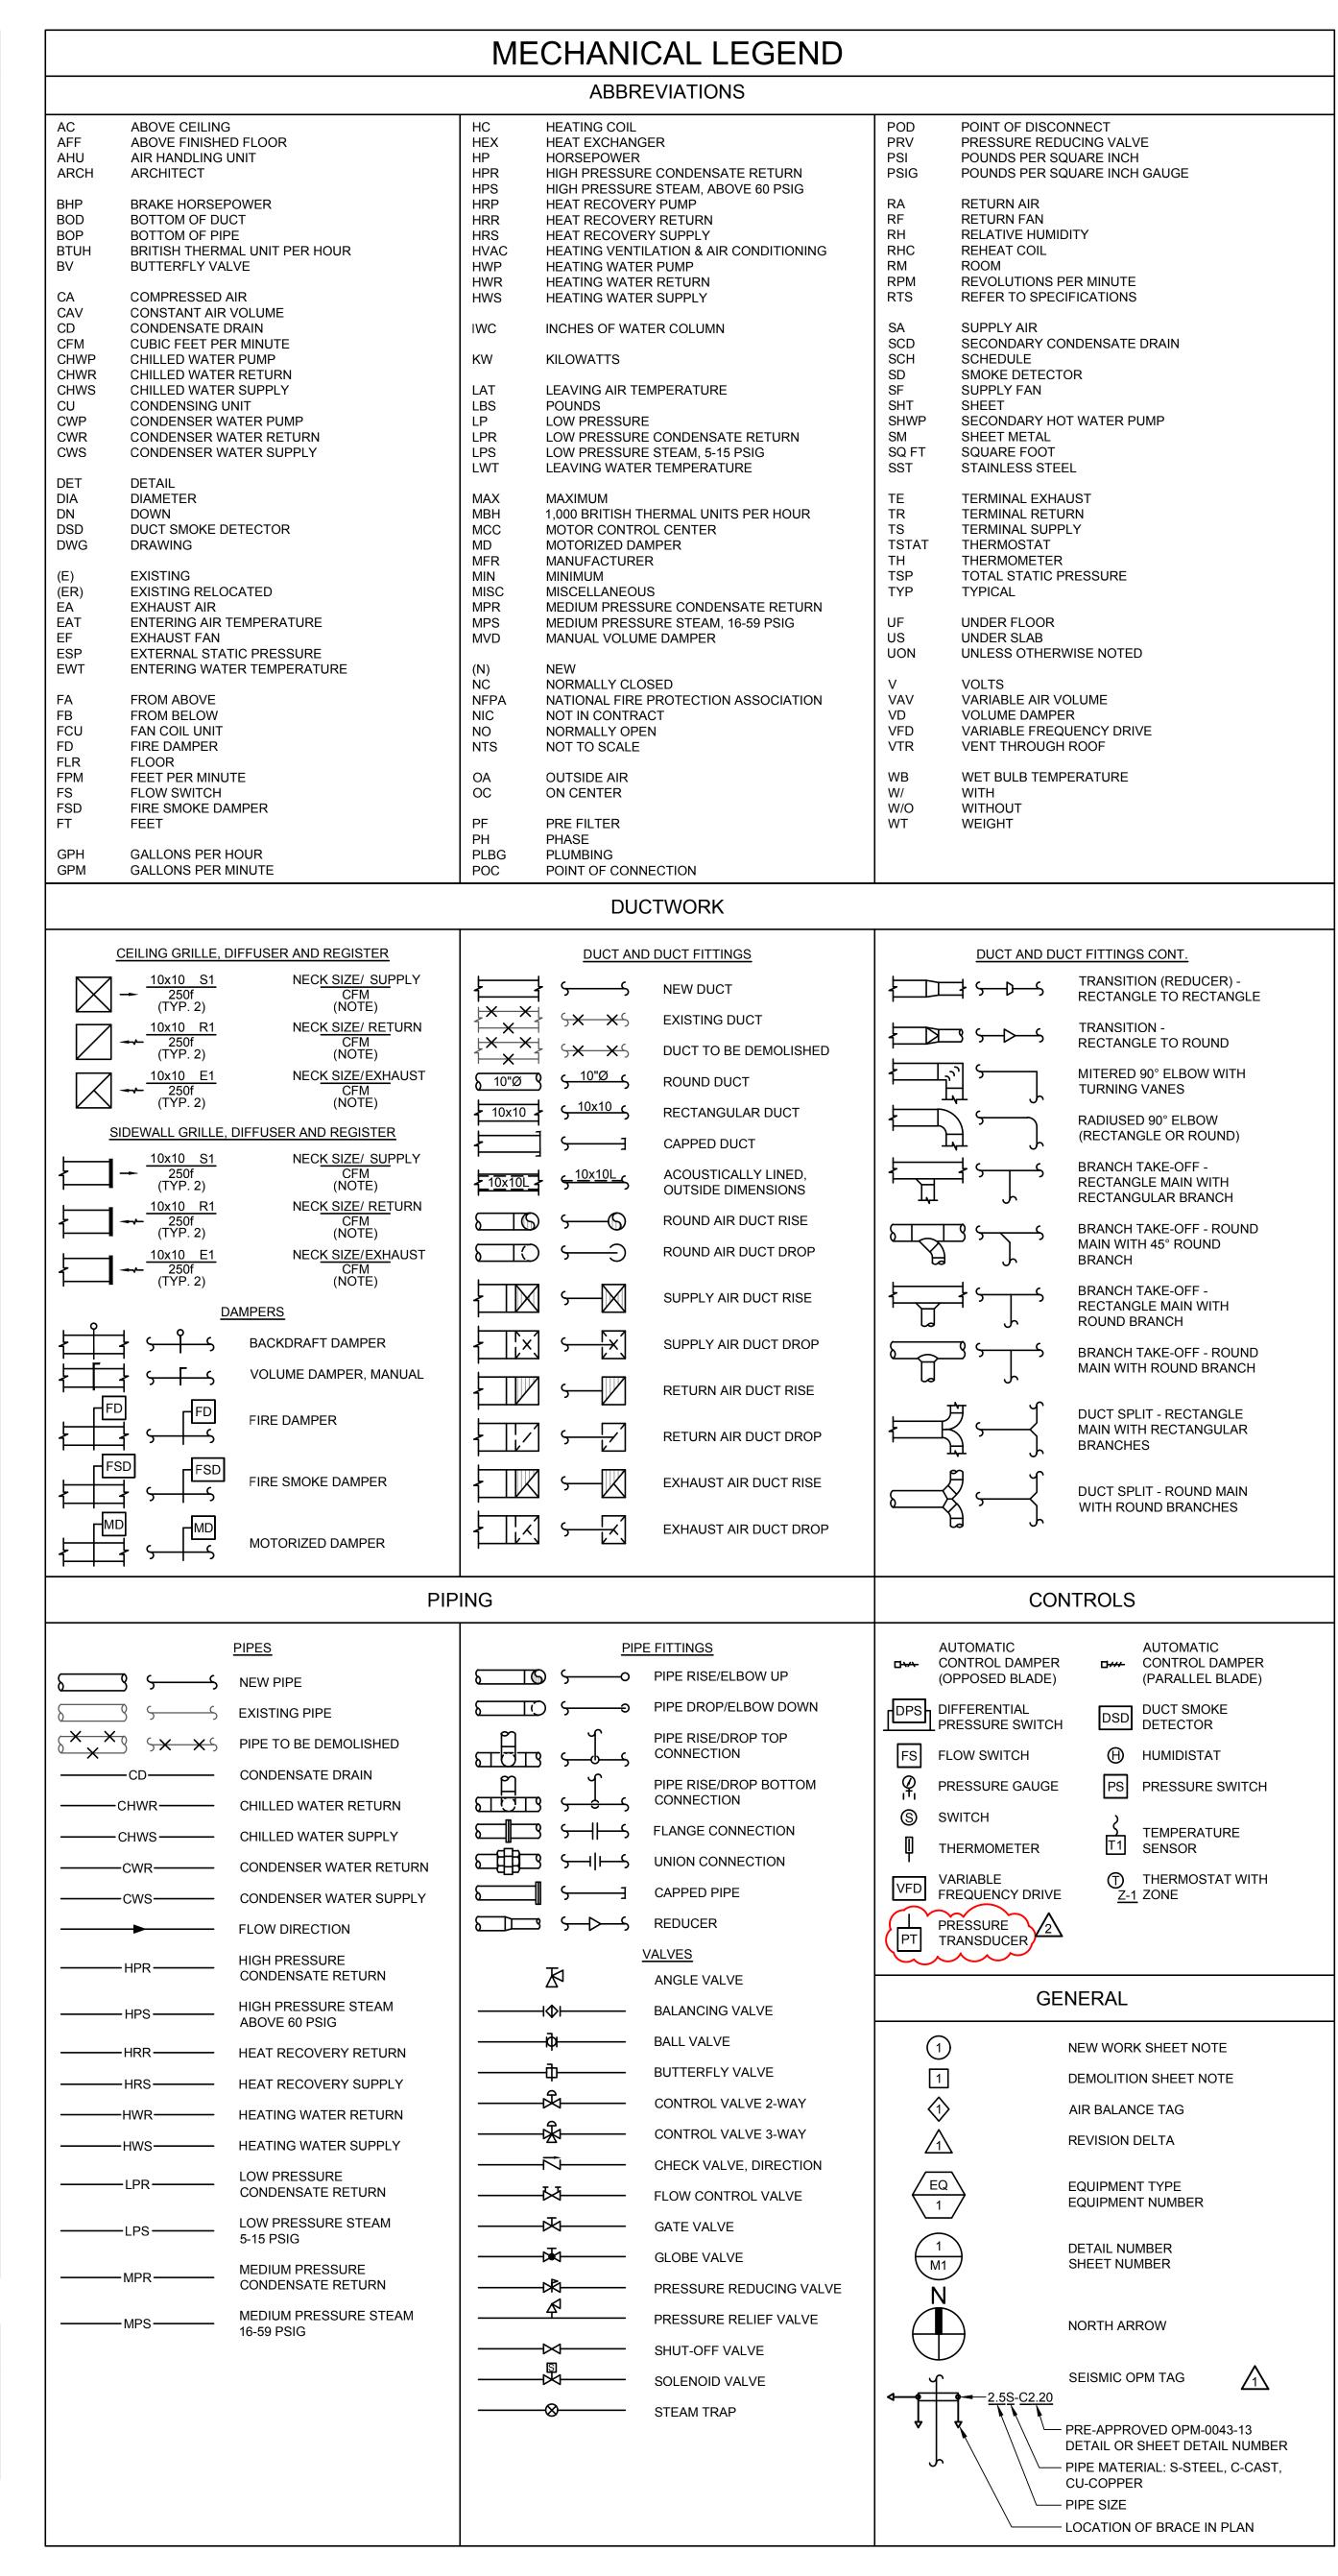

EPARTMENT OF HEALTHCARE ACCESS AND INFORMATION:

## nacht&lewis

600 Q Street, Suite 100 Sacramento, CA 95811 www.nachtlewis.com 916.329.4000



### UC**DAVIS** HEALTH

FACILITIES DESION & CONSTRUCTION
4800 2ND AVENUE SUITE 3010
SACRAMENTO, CALIFORNIA 95817
[910]734-7024



CONSU	CONSULTANT LOGO:								
REV	REVISION DESCRIPTION	DATE							
1	BACKCHECK 1	11/1/2							
2	ADDENDUM 1 (ACD-001)	10/17/2							

CONSTRUCTION DOCUMENTS

RY AND EMERGENCY SERVICES PAVILION T SCANNER

P742 1P745 CT SCANNER
CEMENT
HANICAL LEGEND,

ARCH.\ENGR. FD&C JOB NO.

J. Flath\S. Crosby 9557740

UCDMC PROJECT MANAGER AS SHOWN

DESIGNED BY DATE

SSC 08/09/24

DRAWN BY CAD FILE SHEET CO.

MGE/MJR

	DIFFUSER AND GRILLE SCHEDULE												
TAG	MANUFACTURER	MODEL NO.	TYPE	DESCRIPTION	BORDER	FINISH	OBD	NOTES:					
S1	TITUS	MCD	SUPPLY	MODULAR CORE	LAY-IN	WHITE	NO	12					
R1	TITUS	PAR	RETURN	PERFORATED	LAY-IN	WHITE	NO	1					
E1	TITUS	PAR	EXHAUST	PERFORATED	LAY-IN	WHITE	NO	1					
NOTEC								•					

1) NECK SIZES AS SHOWN.

2 ALL DIFFUSERS USE 4-WAY BLOW UNLESS OTHERWISE INDICATED BY BLOW ARROWS.

	CAV AIR TERMINAL SCHEDULE												
TAG	AG INLET COOLING CFM HEATING OUTLET COIL SIZE AIRSIDE HEATING MATER SIDE NO. ROWS SIZE NOTES:												
CAV-1	10"	500	500	14 x 12.5	14x12.5	1.0	1.5	.5	2	1/2	124		
CAV-2	12"	1,000	N/A	14 x 12.5	N/A	N/A	N/A	N/A	N/A	N/A	134		
NOTES:	NOTES:												

2 HEATING WATER INLET TEMP. 180° LEAVING TEMP. 40°.

3 CAV BOX WITH NO COIL.

4) ELECTRICAL SUPPLY TO THE CONTROLS SHALL BE CONNECTED TO ESSENTIAL POWER.

	REHEAT COIL SCHEDULE												
TAG	MANF. MODEL	MANF. MODEL	COIL SIZE WxH	CFM	AIRSIDE DELTA P	HEATING MBH	EAT (°F)	LAT (°F)	HEATING GPM	WATER SIDE DELTA P FT. H2O	NO. ROWS	WEIGHT (LBS)	NOTES:
RHC-1	GREENHECK	HW58S01A13	18X20	1990	24	53	60	85	3.1	5	1	19	1234
RHC-2		HW58S01A13	18X20	1990	24	53	60	85	3.1	5	1	19	1234

1 HEATING WATER 180/145°F

2) DDC CONTROLLER, REHEAT COIL VALVE AND ROOM SENSOR PROVIDED BY CONTROLS CONTRACTOR, REFERENCE SHEET M701.

3 SEE DETAIL 2/M603 FOR SUPPORT DETAIL.

4 ELECTRICAL SUPPLY TO THE CONTROLS SHALL BE CONNECTED TO ESSENTIAL POWER.

	CHILLED WATER FAN COIL UNIT SCHEDULE															
TAG	MANUFACTURER	MODEL NO.	SYS. TOTAL CAP. (MBH)		SYS. SENS.	WAT	TER REQUIF	REMENTS	1U	NIT ELECT	RICAL DAT	ГА	CFM	EXT. STATIC	UNIT OPER.	NOTES
				CAP. (MBH)	GPM	WPD (F.W.C.)	EWT/LWT °F	VOLTS	PHASE	FLA	HP		(IN. W.C.)	WEIGHT (LBS.)		
FCU 1	PRICE	BCH 40	62.7	53.6	10.4	2.92	42°/54°	115	1	25.60	(1) X2	1,990	1.7	705	12345	
FCU 2	PRICE	BCH 40	62.7	53.6	10.4	2.92	42°/54°	115	1	25.60	(1) X2	1,990	1.7	705	12345	

(1) COOLING CAPACITY BASED UPON EAT 71.5°F DB, 58.2°F WB & 42°F EWT INTO COOLING COIL.

(2) CHILLED WATER CONTROL VALVE SHALL BE 2-WAY MODULATING, SEE CONTROL VALVE SCHEDULE.

(3) PROVIDE WITH 2" MERV 6, 35% PLEATED FILTERS, PER CMC 408.2.4. OSA FOR FCU'S IS SERVED FROM (AHU-11) AND IS A 100% OSA UNIT WITH 30% PRE-FILTERS AND 90% FINAL FILTERS, REFER TO PARTIAL AIR BALANCE SCHEDULE BELOW FOR ADDITIONAL INFORMATION.

(4) UNIT SHALL BE CONNECTED TO EMERGENCY POWER, AND SHALL BE TIED INTO THE FIRE ALARM SYSTEM FOR UNIT SHUT-DOWN, REFER TO ELECTRICAL AND FIRE ALARM SYSTEM PLANS FOR ADDITIONAL INFO.

5 UNIT SUPPLIED SHALL COMPLY WITH HCAI SEISMIC CIRTIFICATION OSP-0378.

F	PARTIAL AIR BALANCE SCHEDULE (AHU-11, EF-12 & FCU-1 & 2)														
ROOM NAME	ROOM NAME 2022 CMC 2022 CMC CODE CALCULATIONS											DESIGN AIR FLOW			
	TABLE 4A EQUIVALENT	AREA SQ.FT.	CLG. HT. FT.	VOLUME CU.FT.	REL. PRESS	ALL ROOM EXHAUST	AC/HR	TOTAL CFM	OA. AC/HR	OA CFM	SA CFM	RA CFM	EA CFM	TA CFM	
CT Scan Room – 1P742	CT SCAN	507	8	4056	NR	NR	6	406	2	135	1,990	1,490	500	0	
CT Scan Room – 1P745	CT SCAN	479	8	3832	NR	NR	6	383	2	128	1,990	1,490	500	0	
Control Area – 1P740	CT SCAN	392	9	3528	NR	NR	6	353	2	118	500	0	475	-25	
(E) Patient Toilet Room – 1P741	TOILET ROOM	62	8.5	527	Negative	YES	10	88	NR		90	0	115	+25	
Reading Room 1P743	NO TABLE 4-A EQUIVALENT; VENTILATION PER ASHRAE 62.1	482	9	4338	NR	NR	0	0	0	41	435	0	435	0	
(E) DX QC Work Area – 1P740B	NO TABLE 4-A EQUIVALENT; VENTILATION PER ASHRAE 62.1	322	9	2898	NR	NR	0	0	0	27	255	0	255	0	
		,	•	,	,			•	•	TOTAL	5,260	2,980	2,280	0	

EQUIPMENT IS LOCATED IN MEZZANINE MECHANICAL ROOM, ON 2ND FLOOR. EXISTING AHU-11 & EF-12 ARE CONSTANT VOLUME W/ VFD MOTORS, SUPPLIED POWER IS FROM EMERGENCY POWER BRANCH CIRCUIT. (TYP). AHU IS 100% OUTSIDE AIR UNIT WITH 30% PRE FILTERS & 90% FINAL FILTERS SECTION. AHU-11 SUPPLIES OSA TO NEW FAN COIL UNITS 1 & 2 SERVING CT ROOMS. FOR FILTRATION AT FCU'S SEE FAN COIL UNIT SCHEDULE. AREAS SERVED BY EQUIPMENT HAS FULL COVERAGE SMOKE DETECTION SYSTEM. EXISTING AHU & EF ARE TIED INTO EXISTING FIRE ALARM SYSTEM FOR AUTOMATIC SHUT-DOWN. NEW FCU-1 & 2 SHALL ALSO BE TIED INTO THE FIRE ALARM SYSTEM FOR AUTOMATUC SHUT-DOWN PER CMC 608.1 EXCEPTION 1. DEPARTMENT OF HEALTHCARE ACCESS AND INFORMATION:

600 Q Street, Suite 100 Sacramento, CA 95811 www.nachtlewis.com 916.329.4000



**UCDAVIS** HEALTH

FACILITIES DESIGN & CONSTRUCTION 4800 2ND AVENUE SUITE 3010 SACRAMENTO, CALIFORNIA 98817 [010]734-7024




CONSU	Ministra	
REV	REVISION DESCRIPTION	DATE
1	BACKCHECK 1	11/1/24
2	ADDENDUM 1 (ACD-001)	10/17/25

CONSTRUCTION DOCUMENTS

J. Flath\S. Crosby SCALE
AS SHOWN

DATE
08/09/24

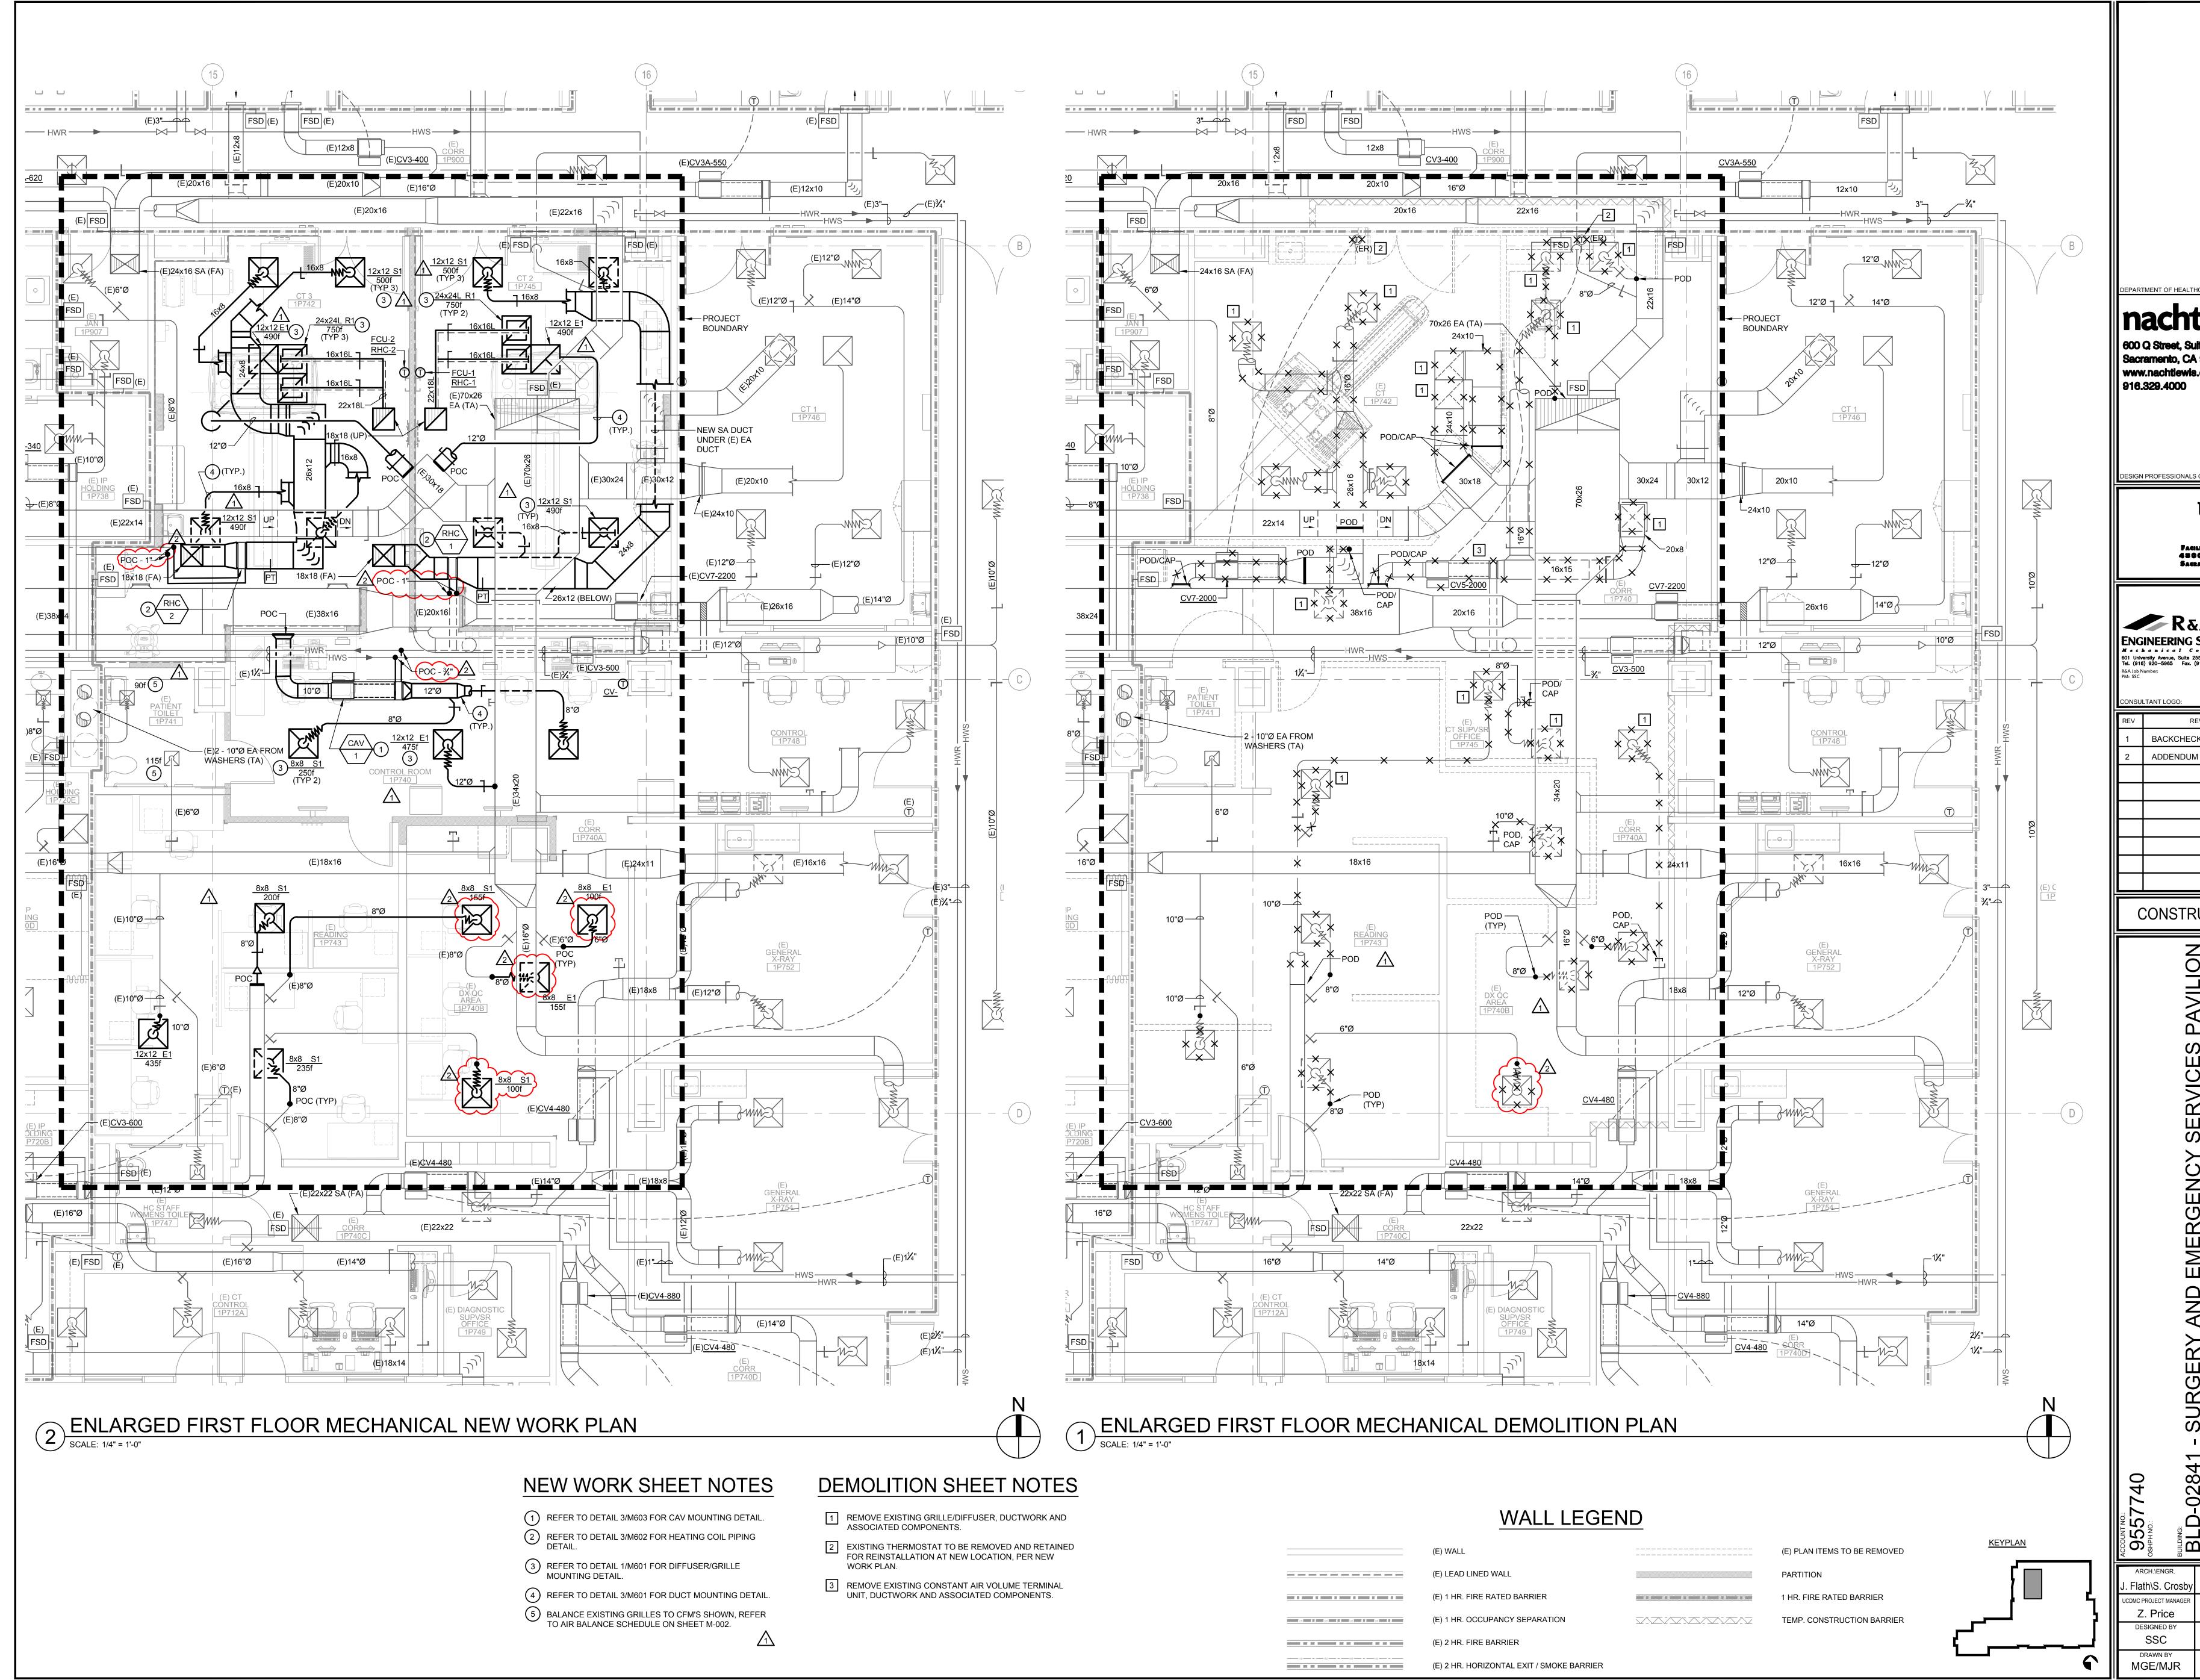

600 Q Street, Suite 100 Sacramento, CA 95811 www.nachtlewis.com




**UCDAVIS** HEALTH



CONSULTANT LOGO:									
REV	REVISION DESCRIPTION	DATE							
1	BACKCHECK 1	11/1/24							
2	ADDENDUM 1 (ACD-001)	10/17/25							

CONSTRUCTION DOCUMENTS

9557740 **AS SHOWN** 08/09/24

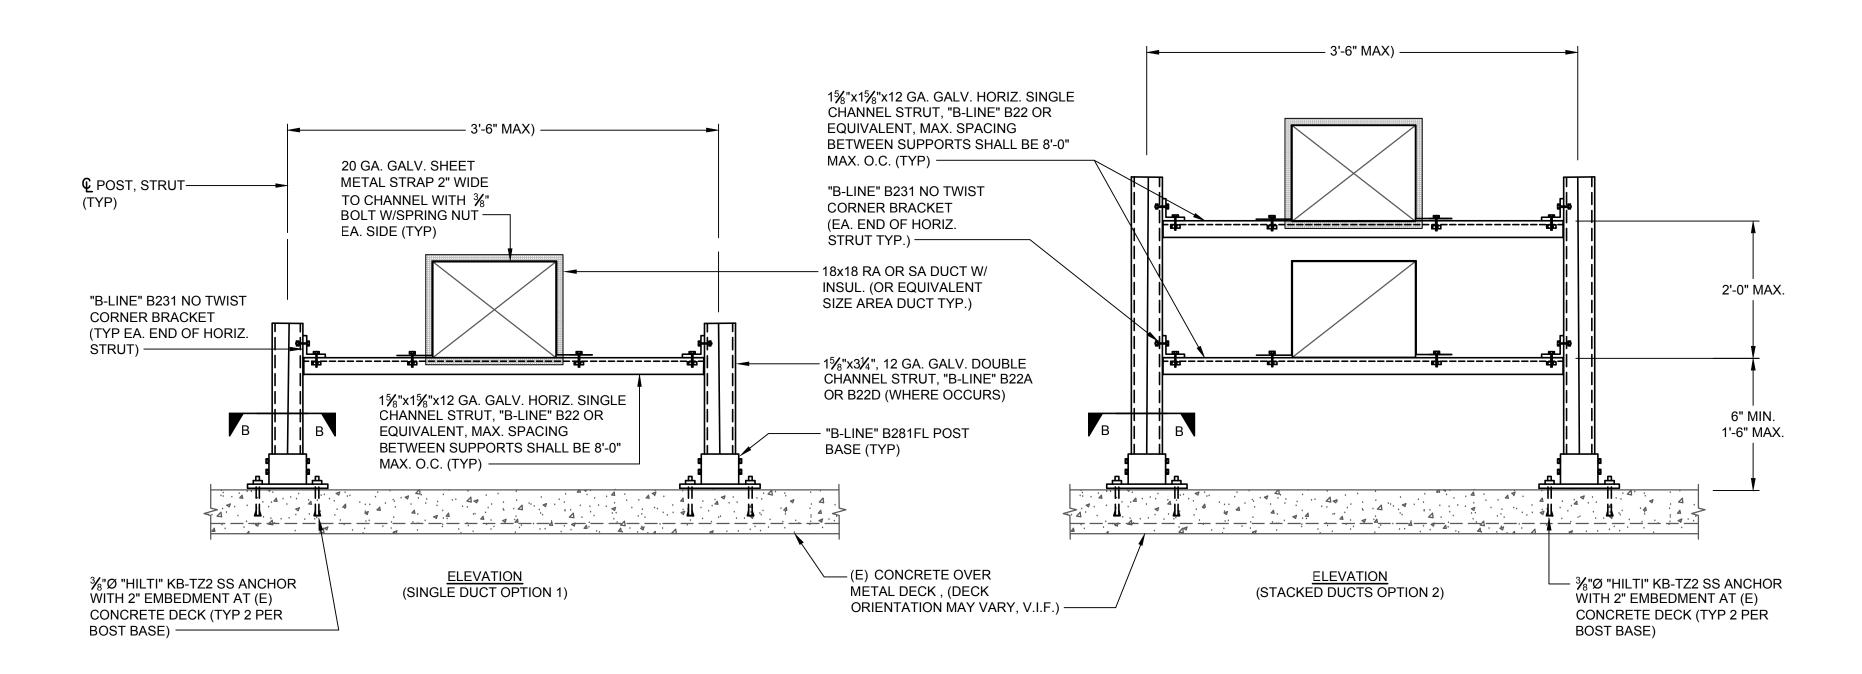


### NOTES

- MATERIAL:

   A. PRE-FABRICATED STEEL STRUTS AND CONNECTORS:
   A. PRE-FABRICATED STEEL STRUTS AND CONNECTORS:
   ASTM A-653 SS GRADE 33 GALVANIZED, AS MANUFACTURED BY COOPER B-LINE OR EQUAL. OTHER STRUT BRANDS MAY BE USED ONLY WITH PRIOR
   APPROVAL FROM THE STRUCTURAL ENGINEER OF RECORD. FITTINGS SHALL BE HOT ROLLED, PICKLED AND OILED STEEL CONFORMING TO ASTM A-575, A-576, A-636 OR A-636 AND ASTM A1011 SS GRADE 33. CHANNEL NUTS SHALL BE STAMPED OR FORMED STEEL BAR STOCK, CASE HARDENED, CONFORMING TO ASTM 1011 SS GRADE 33. ALL STRUT CONNECTORS SHALL BE GALVANIZED.
- 2. PROVIDE DUCT SUPPORTS WITHIN 3 FEET OF CHANGES IN DUCT DIRECTION AND SUPPORT SPACING AT 8'-0" MAX. O.C., SEE MECHANICAL PLAN FOR RECOMMENDED SUPPORT LOCATIONS.

## FLOOR MOUNTED DUCT SUPPORT DETAILS SCALE: NONE

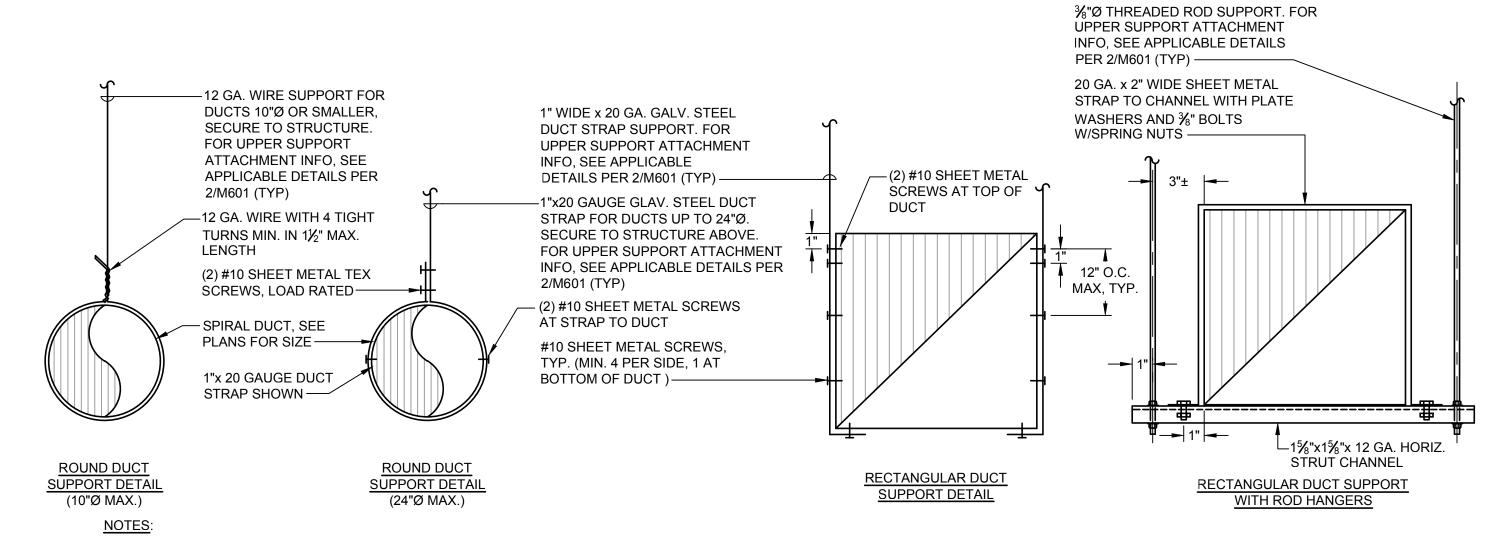


- 1. NO BRACING REQUIRED: ALL DUCTWORK SHALL FALL UNDER ONE OF THE EXCEPTIONS LISTED UNDER CBC SECTION 1617A.1.25) TOTAL WEIGHT OF DUCTWORK SUPPORTED BY TRAPEZE ASSEMBLIES SHALL BE LESS THAN 10 LBS/FT. 1b.) SUPPORTS FROM STRUCTURE 12" OR LESS. 2. PROVISION MADE TO AVOID IMPACT FROM ADJACENT DUCTS AND CROSS SECTIONAL AREA OF DUCTWORK IS 6 SQ/FT OR LESS.
- 2. MAX. LOAD SHALL NOT EXCEED 50 LBS PER SUPPORT AT 10'-0" O.C. (FOR RECTANGULAR DUCT) OR 100 LBS FOR ROUND DUCT WITH

DUCT SUPPORT DETAIL

- 3. DOUBLE NUTS REQUIRED AT TOP & BOTTOM OF HANGER RODS (TYP).
- 4. ALL SUPPORT MATERIALS SHALL BE GALVANIZED. NO SLOTTED STRUT ALLOWED.
- 5. FOR INFORMATION NOT SHOWN REFER TO "OPM 0043-13" (TYP).

## DIFFUSER/GRILLE MOUNTING DETAIL SCALE: NONE

(LAY-IN T-BAR CEILING)

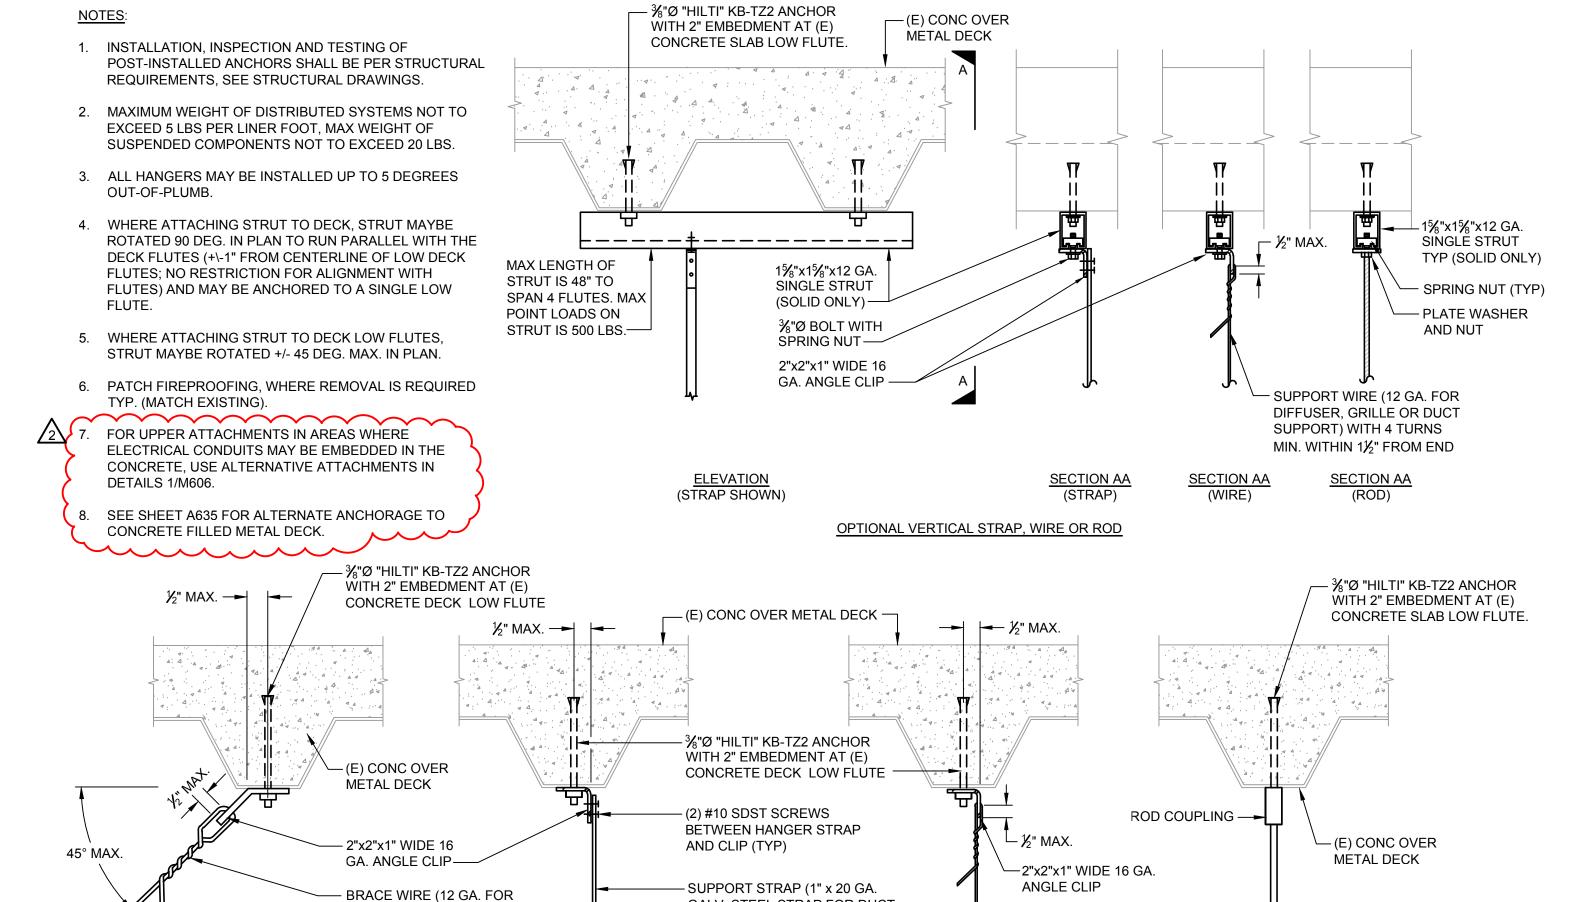

GALV. STEEL STRAP FOR DUCT

SUPPORT) PREVENT BENDING

OF STRAP AT 90° BEND

## UPPER ATTACHMENTS - CONCRETE OVER METAL DECK SCALE: NONE


VERTICAL STRAP

DIFFUSER, GRILLE OR DUCT

SUPPORT) WITH 4 TURNS

MIN. IN 1½" EACH END.

**DIAGONAL BRACING** 

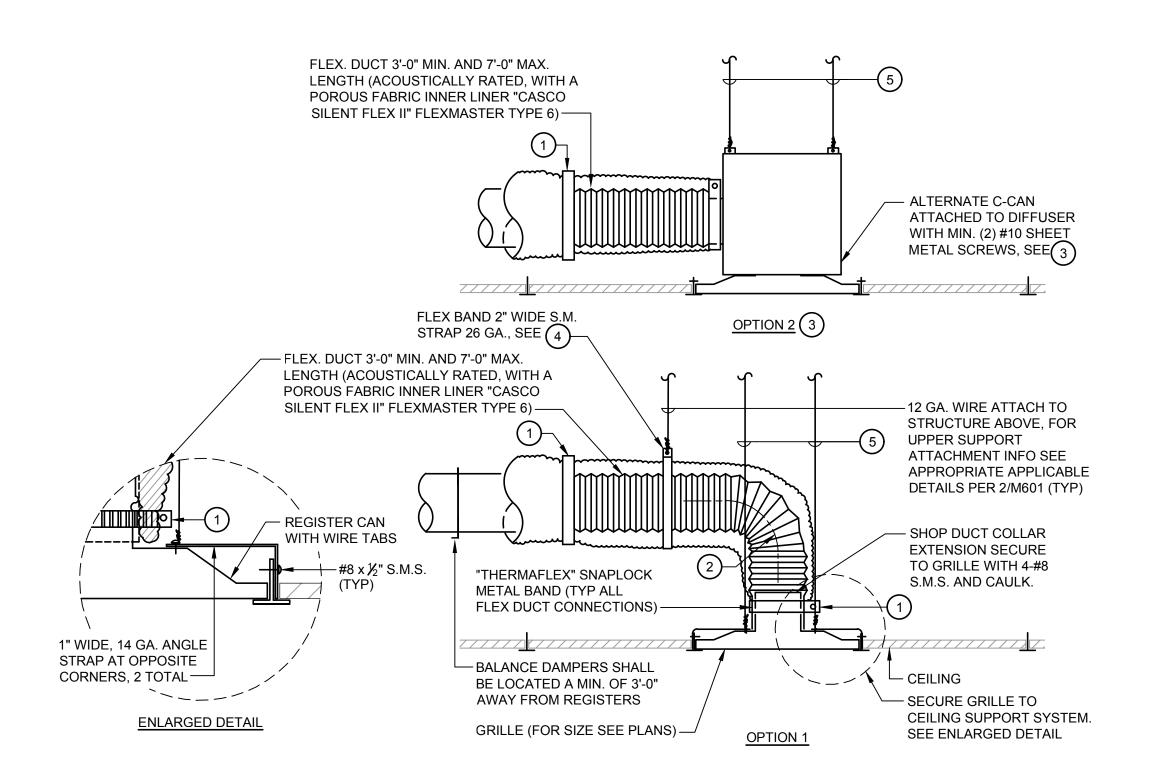

### NOTES

- SLIDE CORE AT LEAST 1" OVER COLLAR. TAPE AND CLAMP CORE. PULL JACKET AND INSULATION OVER CORE, TAPE AND CLAMP OVER ENTIRE ASSEMBLY.
- MINIMUM CENTER LINE RADIUS ON FLEXIBLE DUCTS ARE 1.5 X FLEXIBLE DUCT DIAMETER (NOT LESS THAN 1.0 WHEN THE MINIMUM RADIUS CANNOT BE ACHIEVED.)
- OPTION 2 USING C-CAN WITH ROUND COLLAR TO BE USED ONLY WHEN SPACE LIMITATION WILL NOT ALLOW FOR FLEX DUCT TO MAKE A FULL RADIUS 90° BEND INTO TOP OF STANDARD GRILLE.
- MAXIMUM HANGER SPACING 48" O.C., MAXIMUM SAG BETWEEN HANGERS IS ½" PER FOOT, 2" MAXIMUM.
- (2) 12 GA. SLACK WIRE HANGERS FOR AIR TERMINAL DEVICES THAT WEIGH LESS THAN 56 LBS. PLACE ON DIAGONALLY OPPOSITE CORNERS. FOR UPPER SUPPORT ATTACHMENT INFO SEE APPROPRIATE APPLICABLE DETAILS PER 2/M601 (TYP).

(LAVINIT DAD OF UNIO)

 $-\frac{3}{8}$ " ALL-THREAD ROD

SUPPORT (TYP)

VERTICAL ROD

— SUPPORT WIRE (12 GA. FOR DIFFUSER, GRILLE OR DUCT SUPPORT) WITH (4) TURNS MINIMUM WITHIN 1½" FROM END

VERTICAL WIRE

nacht&lewis
600 Q Street, Suite 100
Sacramento, CA 95811



UCDAVIS HEALTH

FACILITIES DESION A CONSTRUCTION 4800 2ND AVENUE SUITE 3010 SACRAMENTO, CALIFORNIA 95817 [016]724-7024

R&A

ENGINEERING SOLUTIONS 
601 University Avenue, Suite 255, Sacramento, CA 95825
Tel. (916) 920–5965
Fax. (916) 920–9239

R&A Job Number:
PM: SSC

NIA14323
Designer / Drafter: AM/MJR

PM: SSC	Designer / Drafter: AM/MJR	ANE OF	CALIFOR
CONSU	LTANT LOGO:		
REV	REVISION DESCRIPTION		DA
2	ADDENDUM 1 (ACD-001)		10/1

CONSTRUCTION DOCUMENTS

SURGERY AND EMERGENCY SERVICES PAVILION 17745 CT SCANNER

ARCH.\ENGR. FD&C JOB NO.

J. Flath\S. Crosby 9557740


JCDMC PROJECT MANAGER SCALE


Z. Price AS SHOWN

DESIGNED BY DATE

SSC 08/09/24

DRAWN BY CAD FILE SHEET OF MGE/MJR - - -

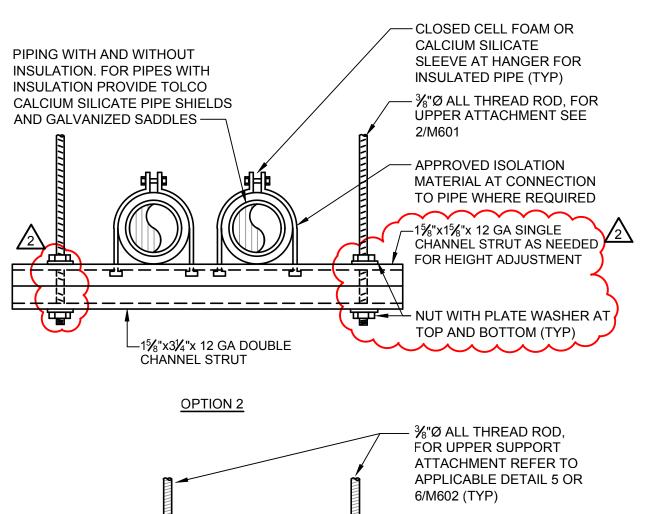

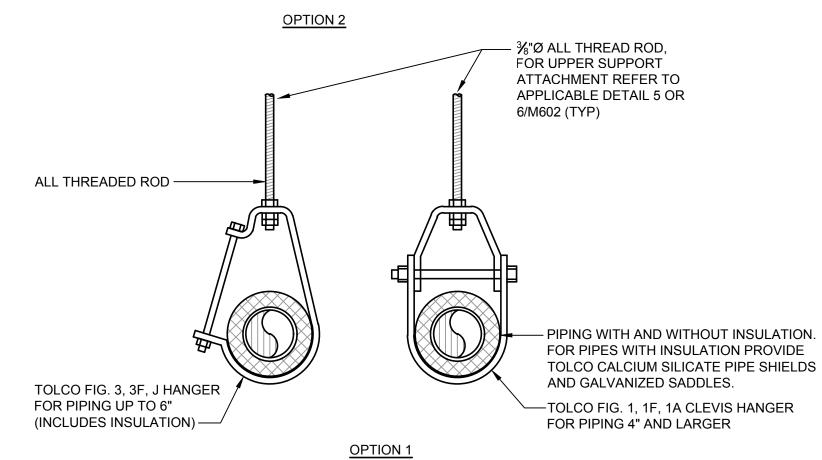


- 1. NO BRACING REQUIRED, REFER TO CBC 1617A1.26; A. TRAPEZE ASSEMBLIES WITH \%" OR \%" DIA. ROD HANGERS NOT EXCEEDING 12" IN LENGTH FROM THE PIPE SUPPORT POINT TO THE CONNECTION AT THE SUPPORTING STRUCTURE, DO NOT SUPPORT PIPING WITH Ip GREATER THAN 1.0, AND NO SINGLE PIPE EXCEEDS 2" DIA. AND TOTAL WEIGHT SUPPORTED BY
- SINGLE TRAPEZE IS 100 LBS OR LESS. B. PROVISION MADE TO AVOID IMPACT WITH STRUCTURAL OR NON-STRUCTURAL COMPONENTS OR TO PROTECT THE PIPING IN THE EVENT OF SUCH IMPACT, THE PIPE IS SUPPORTED BY INDIVIDUAL ROD HANGER 3/8" OR 1/2" DIA. WHERE EACH HANGER IN THE PIPE RUN IS 12" OR LESS IN LENGTH FROM THE PIPE SUPPORT POINT TO THE CONNECTION AT THE SUPPORTING STRUCTURE, AND THE TOTAL WEIGHT SUPPORTED BY ANY SINGLE ROD IS 50 LBS OR LESS. IN ADDITION REFER TO OPM 0043 SHEET A10.5 FOR PIPE SIZE AND SERVICE PIPE LIMITATIONS.
- 2. WHERE BRACING IS REQUIRED: REFER TO OPM-0043 AND DEFERRED APPROVAL DOCUMENT: PROVIDE GRAVITY SUPPORTS BETWEEN BRACED SUPPORTS TO MEET SUPPORT SPACING REQUIREMENTS. ALL SUPPORT SPACING REQUIREMENTS SHALL COMPLY WITH CMC TABLE 313.3 AND CMC 1109.6 REQUIREMENTS. ALL HANGERS MAY BE INSTALLED UP TO 5 DEGREES OUT OF PLUMB.
- COORDINATE WITH ELECTRICAL AND CONTROLS CONTRACTOR FOR SUPPORT OF CONDUITS WITHIN TRAPEZE HANGERS.
- 4. DOUBLE NUTS REQUIRED AT TOP & BOTTOM OF HANGER RODS (TYP).
- 5. ALL SUPPORT MATERIALS SHALL BE GALVANIZED. NO SLOTTED STRUT ALLOWED.
- 6. FOR INFORMATION NOT SHOWN REFER TO "OPM 0043-13"

### NON-SEISMIC

PIPE HANGER SUPPORT DETAILS

SCALE: NONE

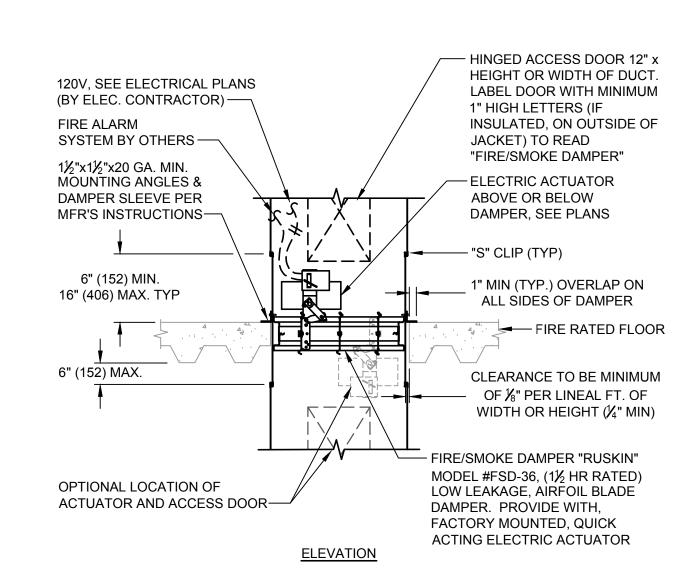


1. FIRE/SMOKE DAMPER SHALL BE CALIFORNIA STATE FIRE MARSHAL (CSFM) APPROVED AND INSTALLED STRICTLY PER MANUFACTURER'S PRINTED INSTRUCTIONS. INSTALLATION INSTRUCTIONS AND CSFM LISTINGS SHALL BE MADE AVAILABLE TO THE INSPECTING AUTHORITIES.

2. DETAIL IS FOR REFERENCE ONLY. INSTALL PER MANUFACTURERS SUPPLEMENTAL


- INSTALLATION INSTRUCTIONS. FOR CONCRETE FLOOR OVER METAL DECK.
- 3. DAMPER CSFM LISTING NO. 3235-0245:0124. 11/2-HOUR UL555 & UL555S LEAKAGE RATING CLASS 2.
- 4. ACCESS DOOR SHALL BE LOCATED TO PROVIDE MAINTENANCE AND TESTING REQUIREMENTS FOR ACTUATOR AND ALLOW VISUAL INSPECTION OF DAMPER. LOCATION SHALL BE CONVENIENT FOR MAINTENANCE ACCESS.
- 5. ARCHITECT TO PROVIDE MINIMUM 16"x16" RATED ACCESS DOOR IN CEILING, NEAR ACTUATOR TO ALLOW FOR MAINTENANCE AND TESTING.

### HORIZONTAL FIRE/ SMOKE DAMPER DETAIL SCALE: NONE

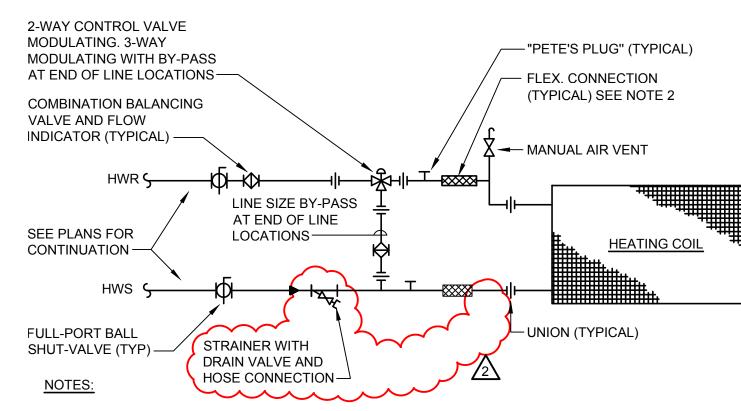

- 1. ALL VALVES AND FITTINGS SHALL BE LINE SIZE UNLESS OTHERWISE NOTED ON PLANS. SEE PLANS FOR BRANCH LINE SIZES. ALL ABOVE CEILING DRAINS, VENTS AND VALVES MUSE BE ACCESSIBLE FOR MAINTENANCE AND OPERATION.
- 2. PROVISIONS SHALL BE MADE FOR EXPANSION, CONTRACTION AND STRUCTURAL SETTLEMENT [OSHPD 1, 1R, 2, 4 AND 5 PIPE CONNECTIONS LESS THAN 2½" SHALL HAVE FLEXIBLE CONNECTORS OR (3) 90° OFFSETS IN CLOSE PROXIMITY OF CONNECTION PER CMC 1210.2]
- 3. PROVIDE STRAIGHT SECTION OF PIPE DOWNSTREAM AND UPSTREAM OF TCV, MIN. 5 PIPE DIAMETER IN LENGTH OR AS DIRECTED BY VALVE MFR.

## **HEATING COIL** REHEAT COIL PIPING DIAGRAM SCALE: NONE

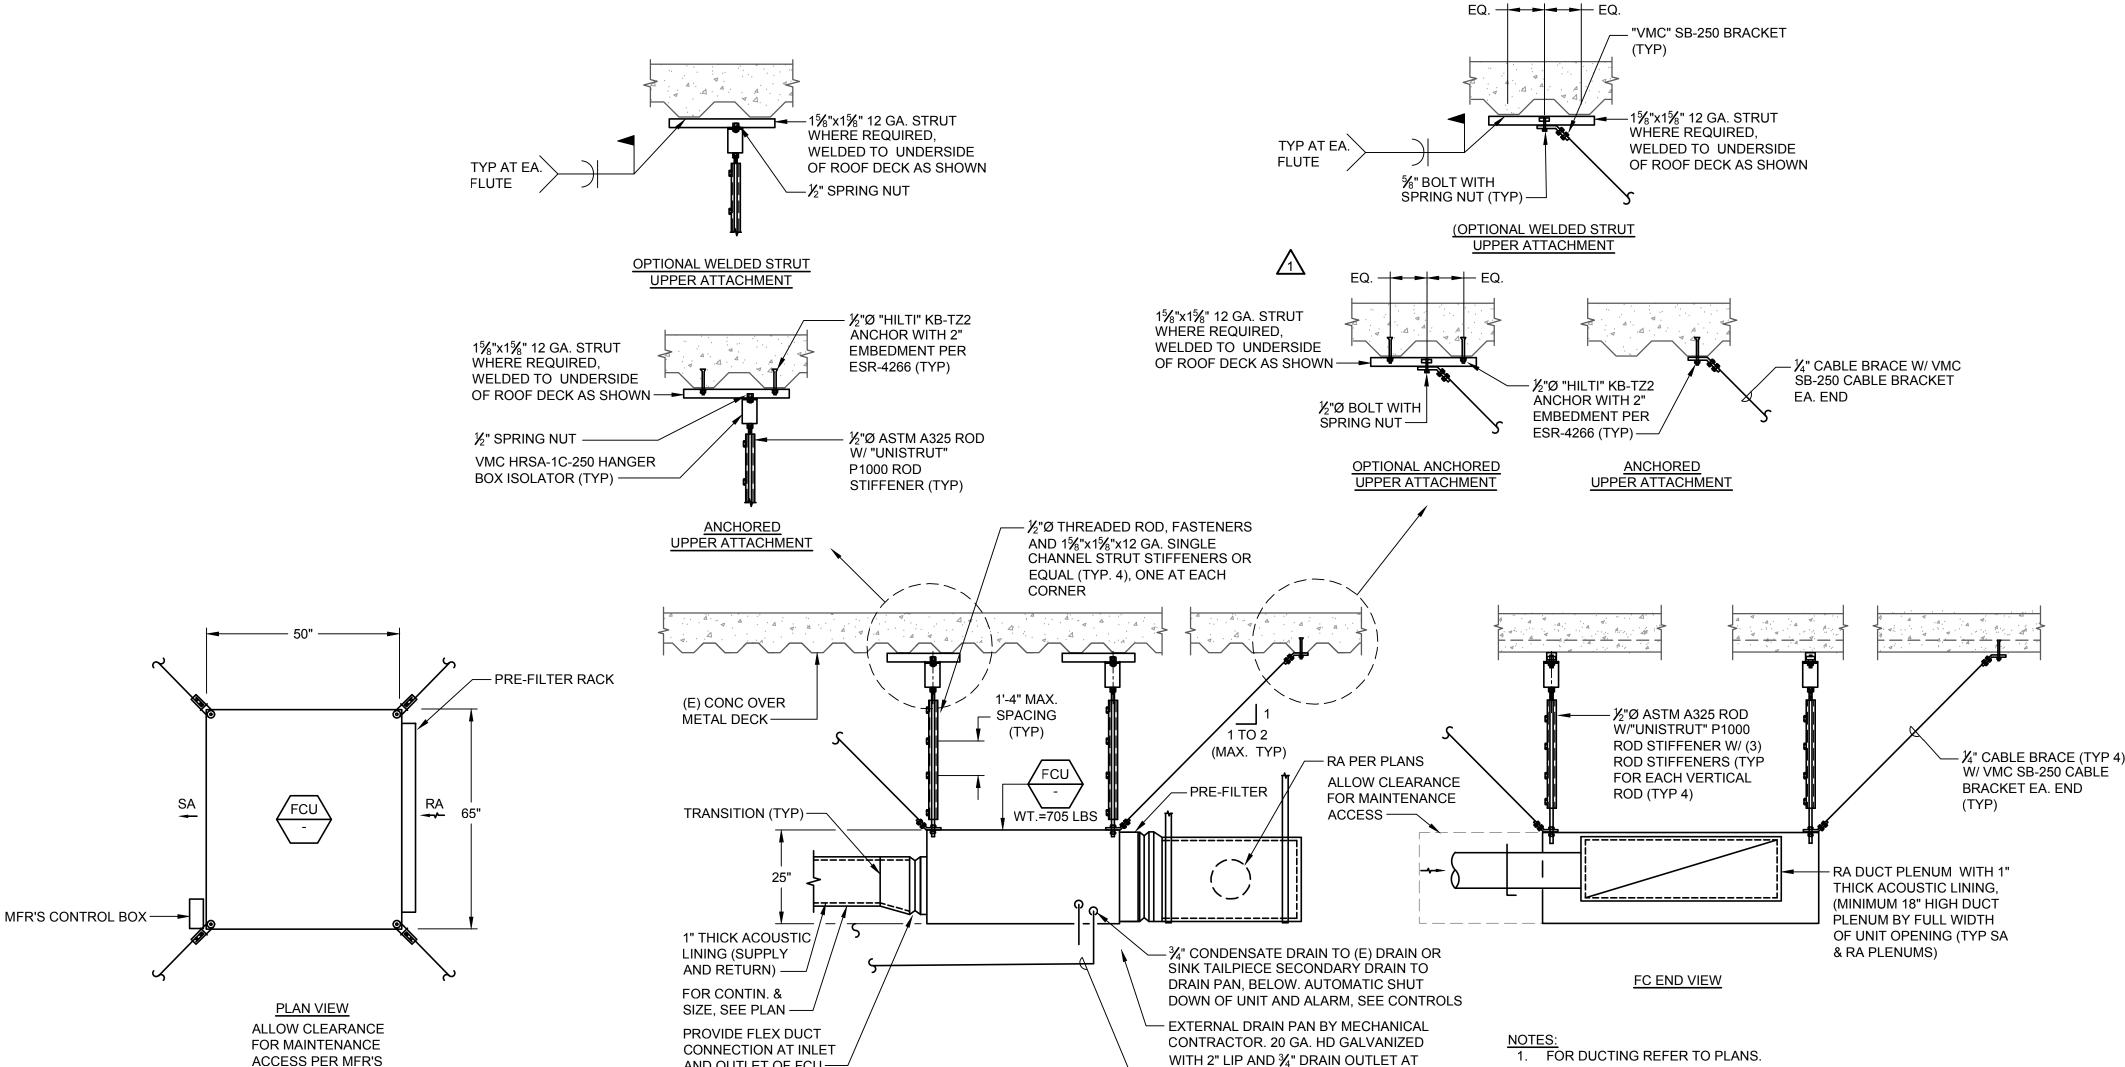

**ELEVATION** 

REQUIRED CLEARANCES - "PETE'S" PLUG (TYP) AND WEATHER COVER. ■ MANUAL AIR VENT CHWS/R, SEE COOLING COIL PLANS FOR SIZE -UNION (TYPICAL) STRAINER WITH DRAIN VALVE AND HOSE CONNECTION — 1. ALL VALVES AND FITTINGS SHALL BE LINE SIZE UNLESS OTHERWISE NOTED ON PLANS. SEE PLANS FOR BRANCH LINE SIZES. ALL ABOVE CEILING DRAINS, VENTS AND VALVES MUSE BE ACCESSIBLE FOR MAINTENANCE AND OPERATION.

FULL-PORT BALL SHUT-VALVE (TYP)


**BELIMO 2-WAY** 

VALVE. PROVIDE

MODULATING CONTROL

- 2. PROVISIONS SHALL BE MADE FOR EXPANSION, CONTRACTION AND STRUCTURAL SETTLEMENT. [OSHPD 1, 1R, 2, 4 AND 5 PIPE CONNECTIONS LESS THAN 21/2" SHALL HAVE FLEXIBLE CONNECTORS OR (3) 90° OFFSETS IN CLOSE PROXIMITY OF CONNECTION PER CMC 1210.2]
- 3. PROVIDE STRAIGHT SECTION OF PIPE DOWNSTREAM AND UPSTREAM OF TCV, MIN. 5 PIPE DIAMETER IN LENGTH OR AS DIRECTED BY VALVE MFR.
- 4. PROVE SEPARATE SHUT OFF VALVES IN FRONT OF COIL KITS, ON BOTH THE SUPPLY AND RETURN LINES.

## PCU CHILLED WATER COIL PIPING DIAGRAM SCALE: NONE

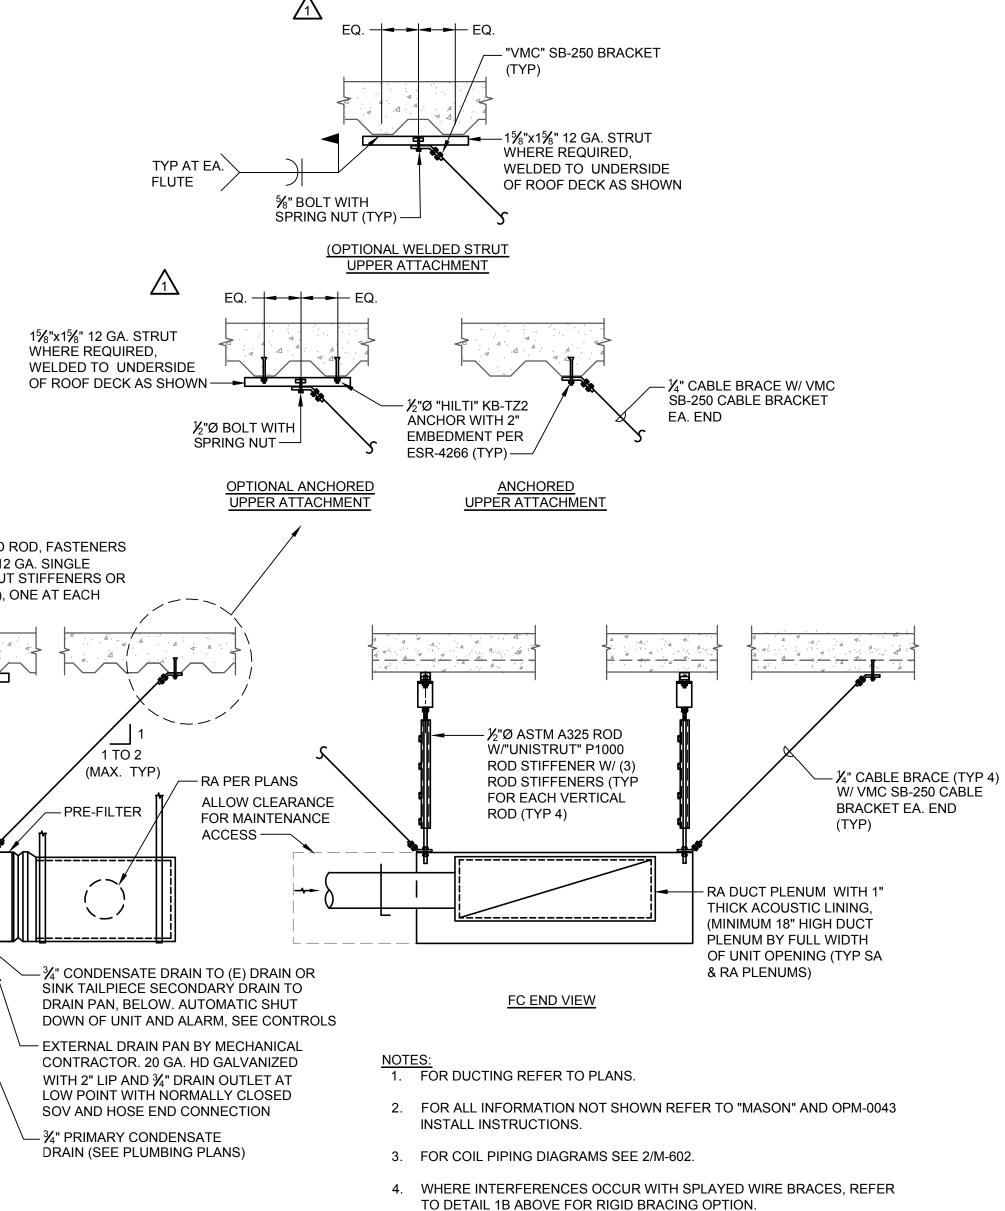

6. REPLACE ANY DAMAGED OR REMOVED FIREPROOFING, AS NEEDED.

ALL BOLTS WITH SPRING NUT CONNECTION SHALL BE PER MASON

METAL DECK.

SEE SHEET A635 FOR ALTERNATE ANCHORAGE TO CONCRETE FILLED

OPM-0043-13, UNISTRUT OPM-0295-13, OR B-LINE OPM-0052-13.

7. FOR SECONDARY DRAIN REFER TO PLUMBING PLANS.

EPARTMENT OF HEALTHCARE ACCESS AND INFORMATION:

600 Q Street, Suite 100 Sacramento, CA 95811 www.nachtlewis.com 916.329.4000



### **UCDAVIS** HEALTH

SACRAMENTO, CALIFORNIA 95817 [916]734-7024



CONSULTANT LOGO:									
REV	REVISION DESCRIPTION	DATE							
1	BACKCHECK 1	11/1/24							
2	ADDENDUM 1 (ACD-001)	10/17/25							

**CONSTRUCTION DOCUMENTS** 

ARCH.\ENGR. I. Flath\S. Crosby 9557740 JCDMC PROJECT MANAGER SCALE Z. Price **AS SHOWN** DESIGNED BY DATE 08/09/24


92

MGE/MJR

FAN COIL UNIT (FCU-1 & 2) MOUNTING DETAIL


REQUIREMENTS

AND OUTLET OF FCU

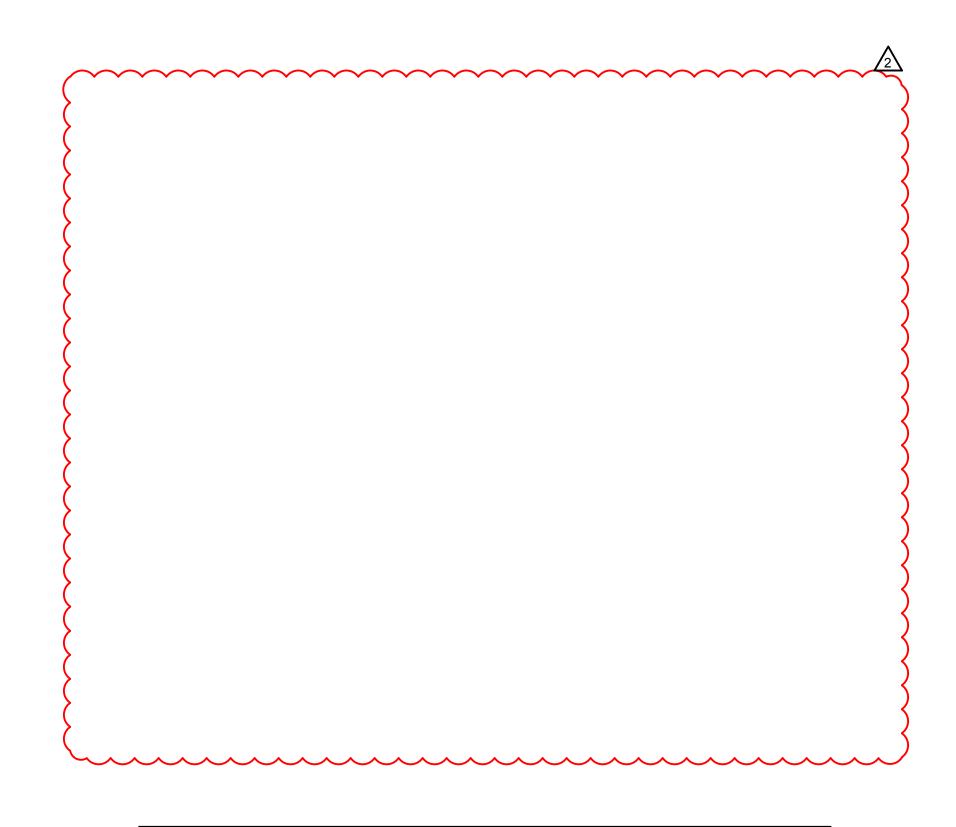

### FIRE-STOP / MEMBRANE PENETRATION DETAILS GENERAL NOTE

WHERE PROVIDED, THROUGH-PENETRATION FIRESTOP SYSTEM AND MEMBRANE PENETRATION DETAILS ARE FOR REFERENCE ONLY. THROUGH-PENETRATIONS AND MEMBRANE PENETRATIONS SHALL BE PROTECTED BY AN APPROVED PENETRATION FIRESTOP SYSTEM OR MEMBRANE PENETRATION FIRESTOP SYSTEM INSTALLED AS TESTED IN ACCORDANCE WITH ASTM E 814 OR UL 1479, WITH A MINIMUM POSITIVE PRESSURE DIFFERENTIAL OF 0.01 INCH (2.49 PA) OF WATER OR AS OTHERWISE PERMITTED BY CBC, SECTION 714, LISTED THROUGH-PENETRATION FIRESTOP SYSTEMS AND MEMBRANE PENETRATIONS SHALL BE INSTALLED IN ACCORDANCE WITH THE INSTALLATION DETAILS FOR LISTED SYSTEMS. LISTED THROUGH-PENETRATION FIRESTOP SYSTEMS, MEMBRANE PENETRATION PROTECTION AND OTHER PERMITTED MEANS AND METHODS OF PENETRATION PROTECTION SHALL BE SUBMITTED FOR OSHPD REVIEW AND APPROVAL PRIOR TO INSTALLATION.

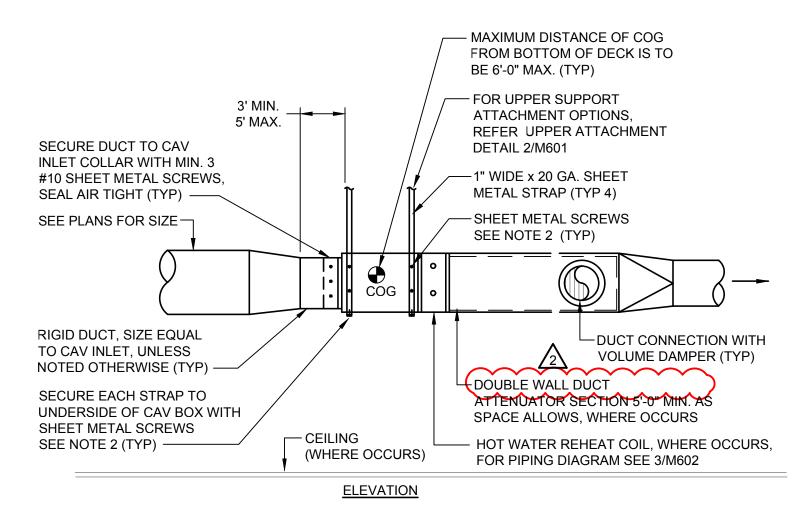


- 1. CAV BOX ATTACHMENTS: PROVIDE FLEXIBLE CONNECTIONS FOR PIPES AND CONDUITS, FOR COIL PIPING DETAIL SEE 3/M602. BOX W/COIL: WEIGHT IS LESS THAN 75 LBS. THEREFORE NO BRACING REQUIRED, REFER TO CBC 1705A.13.3.1 (9).
- 2. CAV BOXES 75 LBS OR LESS WITH COIL (WHERE OCCURS): SECURE STRAP TO BOX WITH SHEET METAL SCREWS, 2 ON EACH SIDE AND 1 ON BOTTOM (TYPICAL), SEAL WITH DUCT SEALANT. NO POP RIVETS ALLOWED.
- 3. FOR CAV BOXES WITH COIL (WHERE OCCURS) OVER 75 LBS: INSTALL PER OPM# 0043-13, SEE DETAIL 2/M603.
- 4. MAINTAIN ALL REQUIRED CLEARANCES AND ACCESS IN FRONT OF CAV CONTROL PANELS. NO PIPES, SPRINKLERS, CONDUITS, ETC. SHALL BE INSTALLED WITHIN THIS ZONE. COORDINATE CAREFULLY WITH OTHER TRADES AND UNIT MANUFACTURER.


### TERMINAL UNIT


(CAV OR VAV) CONFIGURATION DETAIL


SCALE: NONE

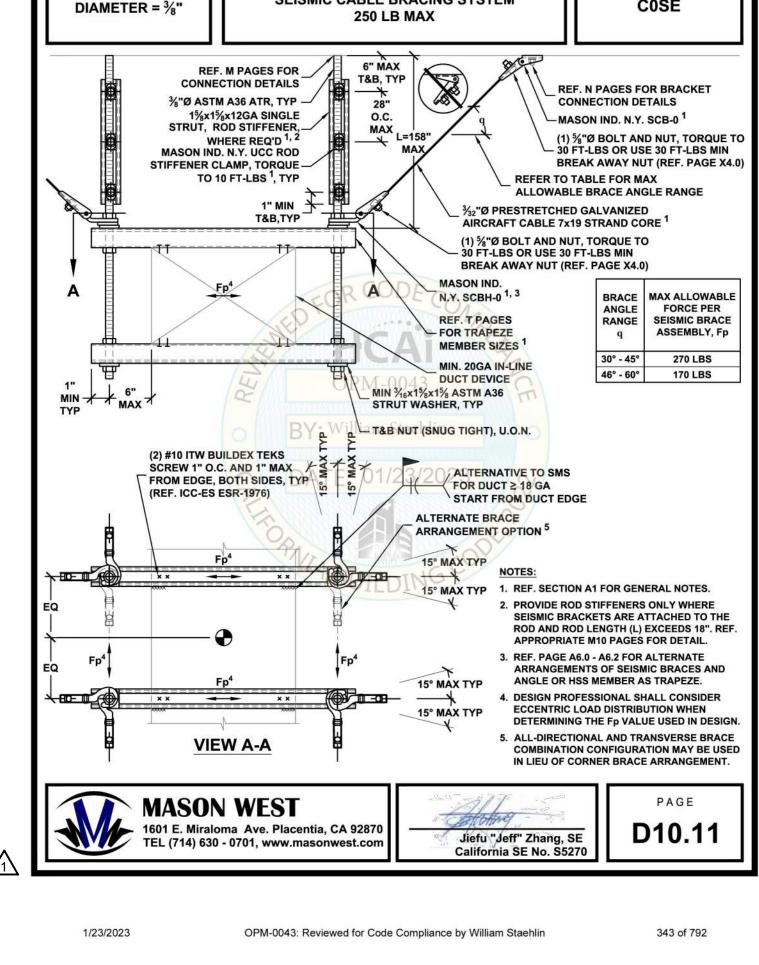





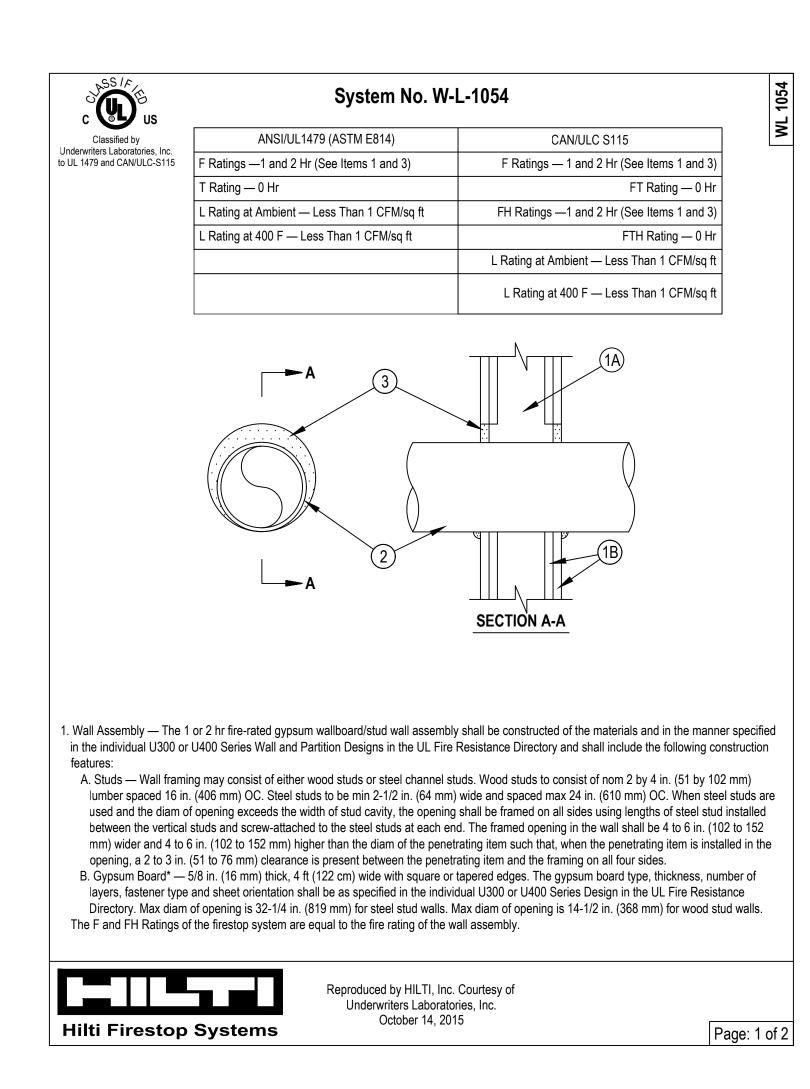

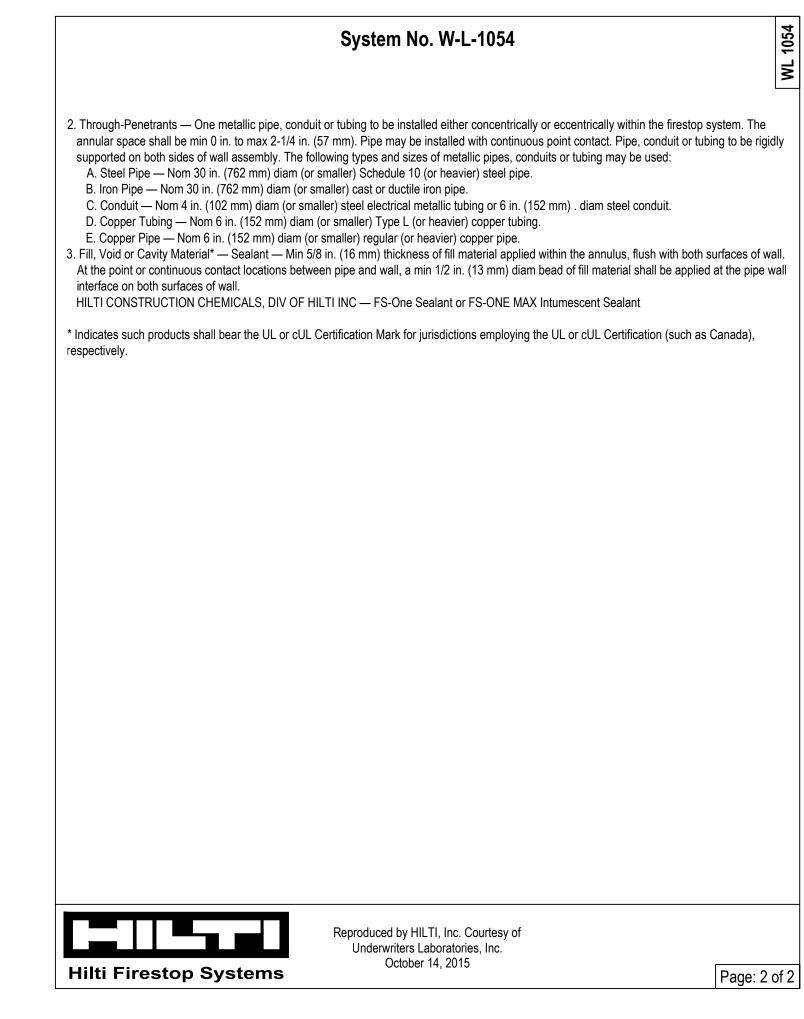

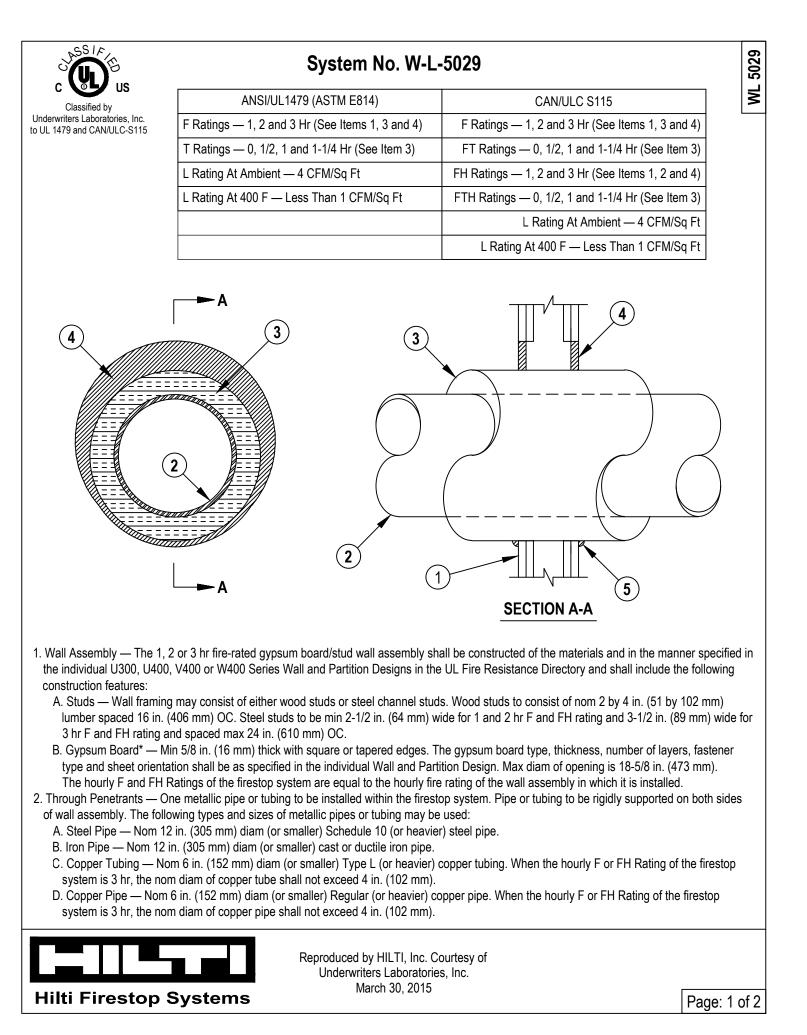

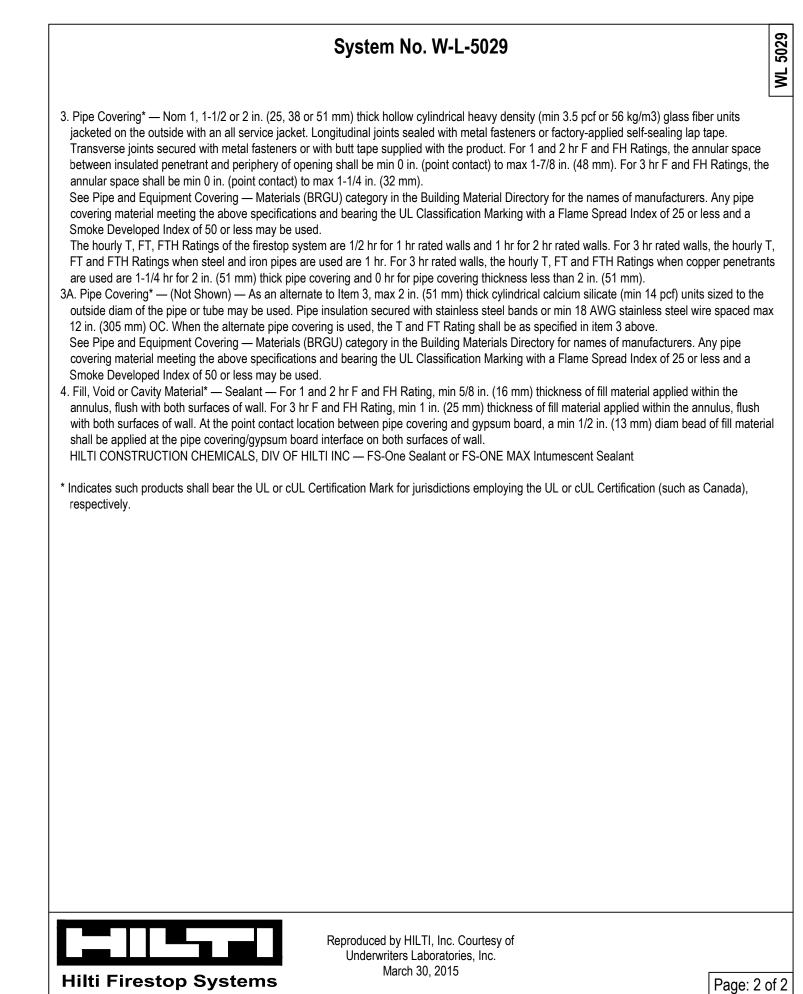

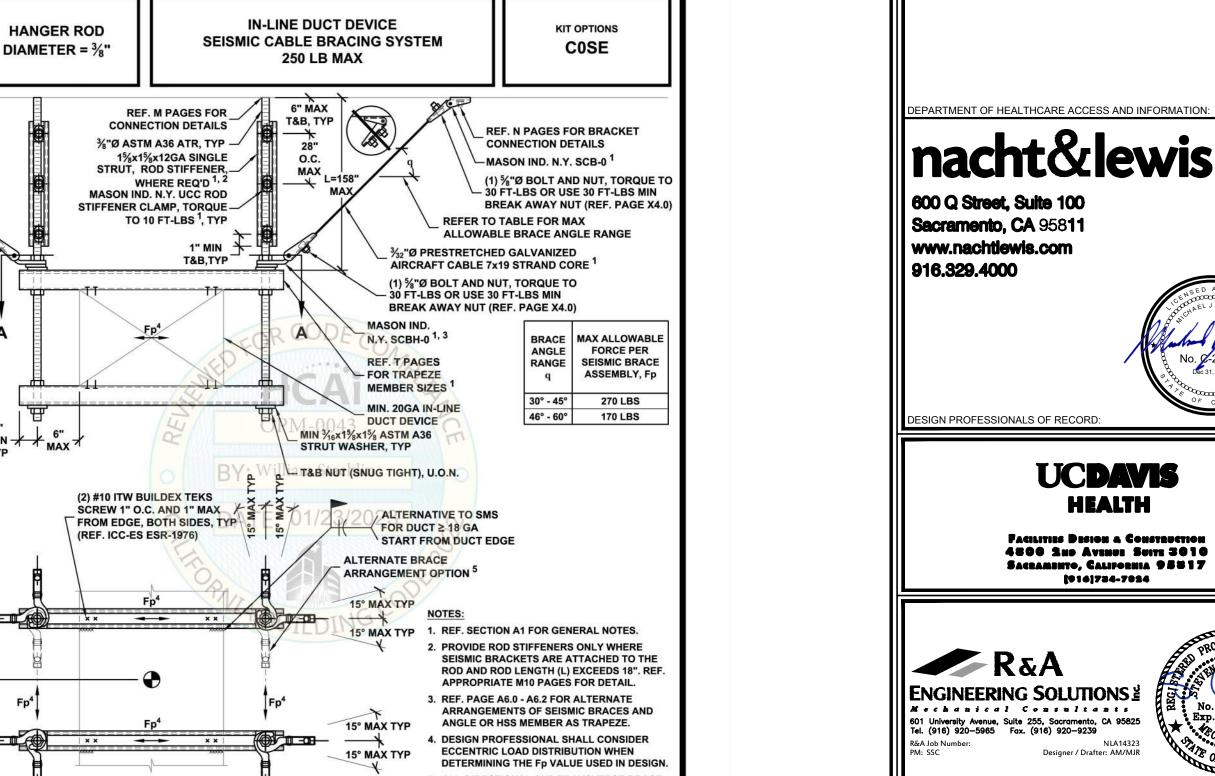

R&A Job Number: PM: SSC Designer / Drafter: AM/MJR CONSULTANT LOGO: REVISION DESCRIPTION DATE BACKCHECK 1 11/1/24 ADDENDUM 1 (ACD-001) 10/17/25

**UCDAVIS** 


SACRAMENTO, CALIFORNIA 95817


[916]734-7024

**CONSTRUCTION DOCUMENTS** 

I. Flath\S. Crosby 9557740 JCDMC PROJECT MANAGER Z. Price **AS SHOWN** DESIGNED BY 08/09/24 MGE/MJR

9557

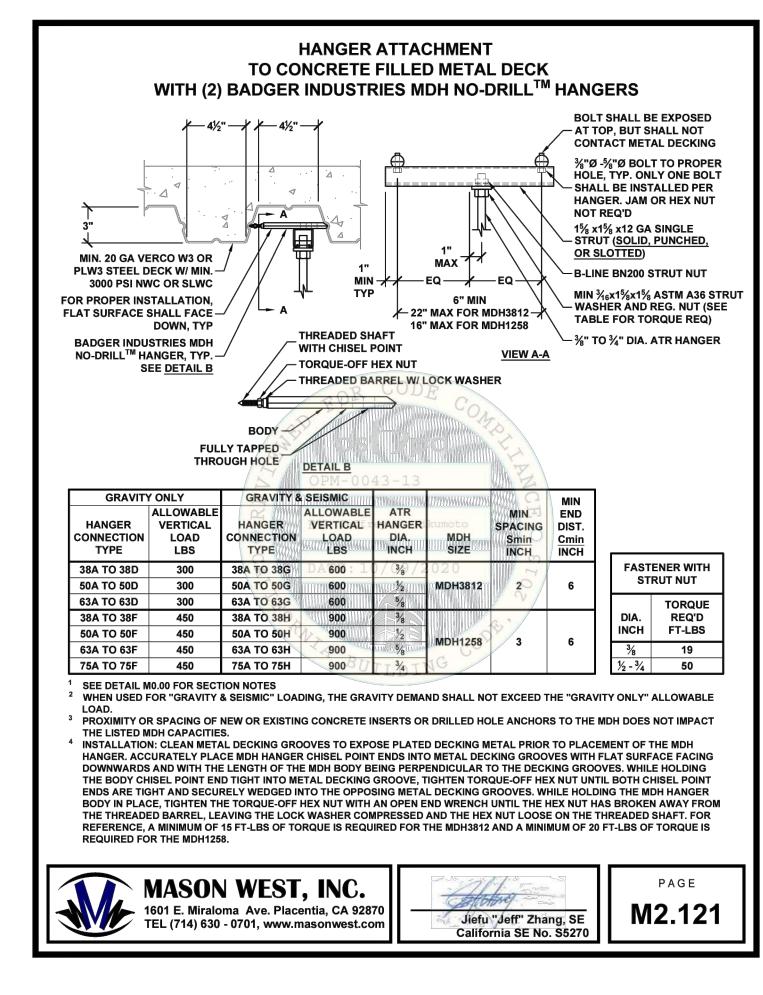


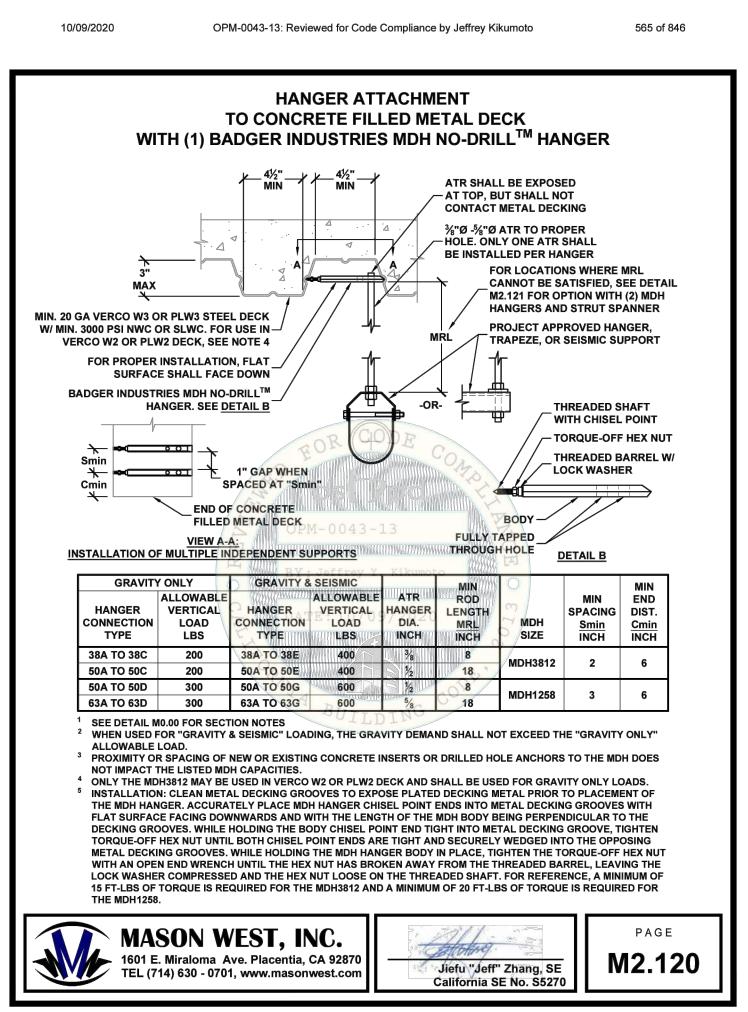


OPM-0043-13: Reviewed for Code Compliance by Jeffrey Kikumoto

563 of 846

10/09/2020

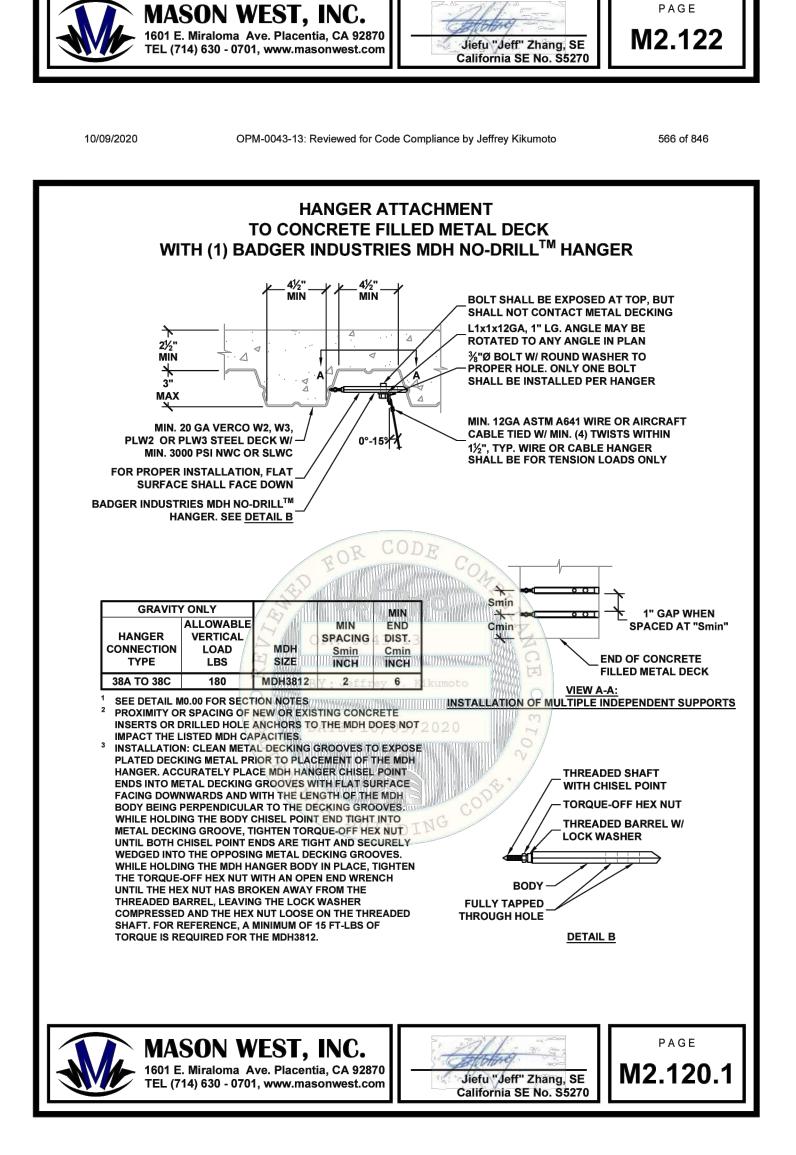

OPM-0043-13: Reviewed for Code Compliance by Jeffrey Kikumoto

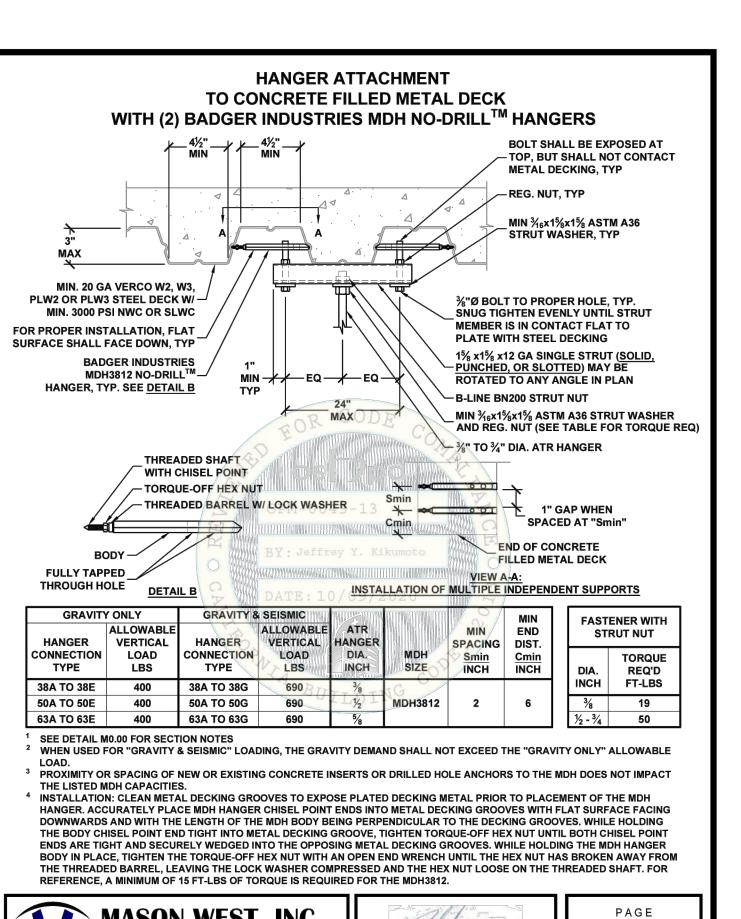

EPARTMENT OF HEALTHCARE ACCESS AND INFORMATION:

600 Q Street, Suite 100 Sacramento, CA 95811 www.nachtlewis.com

DESIGN PROFESSIONALS OF RECORD:

ENGINEERING SOLUTIONS

Mechanical Consultants

601 University Avenue, Suite 255, Sacramento, CA 95825 Tel. (916) 920-5965 Fax. (916) 920-9239

BACKCHECK 1

ADDENDUM 1 (ACD-001)

R&A Job Number: PM: SSC

CONSULTANT LOGO:

**UCDAVIS** 

HEALTH

4500 2mp Avenue Suite 3010

SACRAMENTO, CALIFORNIA 95817

[916]734-7024

FACILITIES DESION & CONSTR

Designer / Drafter: AM/MJF

REVISION DESCRIPTION

DATE

11/1/24

10/17/25

916.329.4000

**CONSTRUCTION DOCUMENTS** 

Ш S Ŋ

9557 ARCH.\ENGR. FD&C JOB NO. 9557740 l. Flath∖S. Crosby JCDMC PROJECT MANAGER SCALE Z. Price AS SHOWN DESIGNED BY DATE 08/09/24 DRAWN BY MGE/MJR

564 of 846

721 of 846

10/09/2020

WIRE/CABLE BRACE ATTACHMENT

MIN. 20 GA VERCO W2, W3,

MIN. 3000 PSI NWC OR SLWC

SURFACE SHALL FACE DOWN

HANGER. SEE <u>DETAIL B</u>

BRACE

PROXIMITY OR SPACING OF NEW OR EXISTING CONCRETE INSERTS OR

INSTALLATION: CLEAN METAL DECKING GROOVES TO EXPOSE PLATED

DRILLED HOLE ANCHORS TO THE MDH DOES NOT IMPACT THE LISTED

ACCURATELY PLACE MDH HANGER CHISEL POINT ENDS INTO METAL

DECKING GROOVES WITH FLAT SURFACE FACING DOWNWARDS AND

DECKING GROOVES. WHILE HOLDING THE BODY CHISEL POINT END

WITH THE LENGTH OF THE MDH BODY BEING PERPENDICULAR TO THE

TIGHT INTO METAL DECKING GROOVE, TIGHTEN TORQUE-OFF HEX NUT

UNTIL BOTH CHISEL POINT ENDS ARE TIGHT AND SECURELY WEDGED

INTO THE OPPOSING METAL DECKING GROOVES. WHILE HOLDING THE

WITH AN OPEN END WRENCH UNTIL THE HEX NUT HAS BROKEN AWAY

MDH HANGER BODY IN PLACE, TIGHTEN THE TORQUE-OFF HEX NUT

COMPRESSED AND THE HEX NUT LOOSE ON THE THREADED SHAFT.

FOR REFERENCE, A MINIMUM OF 15 FT-LBS OF TORQUE IS REQUIRED

MASON WEST, INC.

▲ 1601 E. Miraloma Ave. Placentia, CA 92870

TEL (714) 630 - 0701, www.masonwest.com

FROM THE THREADED BARREL, LEAVING THE LOCK WASHER

DECKING METAL PRIOR TO PLACEMENT OF THE MOH HANGER

SIZE

RANGE

SPACING

Sminey VCmin

OPM-0043-13: Reviewed for Code Compliance by Jeffrey Kikumoto

PLW2 OR PLW3 STEEL DECK W/ -

FOR PROPER INSTALLATION, FLAT

BADGER INDUSTRIES MDH NO-DRILL™

3/8"Ø BOLT TO PROPER HOLE. ONLY ONE \_

BOLT SHALL BE INSTALLED PER HANGER

ALLOWABLE

LATERAL

SEE DETAIL NO.00 FOR SECTION NOTES

LOAD

BRACKET

CONNECTION

TYPE

38A TO 38A

MDH CAPACITIES.

FOR THE MDH3812.

TO CONCRETE FILLED METAL DECK WITH (1) BADGER INDUSTRIES MDH NO-DRILL™ HANGER

**BOLT SHALL BE EXPOSED AT TOP, BUT** 

MIN. 12GA ASTM A641 WIRE OR AIRCRAFT

CABLE TIED W/ MIN. (4) TWISTS WITHIN

SHALL BE FOR TENSION LOADS ONLY

1½", TYP. WIRE OR CABLE HANGER

1" GAP WHEN

THREADED SHAFT

WITH CHISEL POINT

LOCK WASHER

DETAIL B

FULLY TAPPED /

Jiefu "Jeff" Zhang, SE

California SE No. S5270

THROUGH HOLE

TORQUE-OFF HEX NUT

THREADED BARREL W/

SPACED AT "Smin"

END OF CONCRETE

FILLED METAL DECK

SHALL NOT CONTACT METAL DECKING

L1x1x12GA, 1" LG, ANGLE MAY BE

ROTATED TO ANY ANGLE IN PLAN

	(ER)MED GAS	S COMBINATI	ON Z	ONE \	/ALVE	E BOX	& AF	REA A	LARM PANEL
TAG NO.	AREA SERVED / LOCATION	MANUFACTURER & MODEL	VAC	O2	MEDICAL GA	AS VALVE SIZ N2O	E N2	CO2	REMARKS
			VAO	02	IVIA	N2O	INZ	CO2	
/B/AA-1.4	(E) CORRIDOR 1P740	"BEACON MEDAES" MODEL AZVB3-AAB	11/4"	3/4"	3/4"	-	-	-	

### NOTES:

- ALARM INPUT POWER 100 TO 250 VAC 50 / 60 Hz, 1 AMP INPUT RATING. DRY/SLAVE CONTACTS MODULES FOR MA. UNIT SHALL BE PROVIDED WITH EMERGENCY BACK-UP POWER CIRCUIT TO MAINTAIN NORMAL OPERATION DURING PERIODS OF POWER OUTAGES. (REFER TO DIVISION 26 FOR POWER).
- (ER) PANEL HAS THE FOLLOWING: TOUCH SCREEN DIGITAL DISPLAY, AUDIBLE HORN & VISUAL INDICATOR ALARMS, FULL-PORT BALL VALVES, PRE-INSTALLED AREA ALARM SENSORS WITHIN THE BOX ON THE PATIENT SIDE AND VALVE PURGE PORTS.
- (ER) PANEL SHALL BE LABELED AS PER THE FACILITY STANDARDS AND INDICATE THE AREA SERVED.
- (ER) ZONE VALVE BOXE & AREA ALARM PANEL SHALL BE MOUNTED AT 66" ABOVE FINISHED FLOOR TO THE TOP OF THE PANEL. REFER TO ARCHITECTURAL PLANS FOR FINAL LOCATIONS AND MOUNTING HEIGHT.

MEDICAL GAS OUTLET SCHEDULE											
TAG NO.	DESCRIPTION	MANUFACTURER & MODEL	MINIMUM PIPE SIZE	CONNECTION SIZE	REMARKS						
<u>02-1</u>	WALL OUTLET (DISS KEY STYLE)	"BEACON MEDAES" SERIES 'B' 121100-00	1/2" 2	%"							
VAC-1	WALL OUTLET (DISS KEY STYLE)	"BEACON MEDAES" SERIES 'B' 121103-00	3/4"	3⁄8"							
<u>MA-1</u>	WALL OUTLET (DISS KEY STYLE)	"BEACON MEDAES" SERIES 'B' 121102-00	\ \mathcal{Y}_{2}'' \ \ \ \ \ \ \ \ \ \ \ \ \ \ \ \ \ \	%"							
<u>02-2</u>	CEILING OUTLET (DISS KEY STYLE)	"BEACON MEDAES" SERIES 'B' 4107 2092 69	\ \mathcal{Y}_{2}" \}	3∕8"							
VAC-2	CEILING OUTLET (DISS KEY STYLE)	"BEACON MEDAES" SERIES 'B' 4107 2092 71	34"	%"							
<u>MA-2</u>	CEILING OUTLET (DISS KEY STYLE)	"BEACON MEDAES" SERIES 'B' 4107 2092 71	\(\mu_2''\)	3∕8"							

- WALL MOUNTED, QUICK CONNECT FRONT ASSEMBLY OUTLET WITH U.S. COLOR CODE. REFER TO DETAIL 2/P6.1 AND ARCHITECTURAL DRAWINGS FOR FINAL MOUNTING LOCATION & HEIGHT.
- 2. PROVIDE BLANK SLIDE FOR WALL MOUNTED VACUUM BOTTLE RACK.
- 3. CONTRACTOR SHALL VERIFY AND MATCH FACILITY WALL OUTLET CONNECTION STYLE.
- 4. REFER TO ARCHITECTURAL PLANS FOR FINAL OUTLET LOCATIONS AND MOUNTING HEIGHTS.

### PLUMBING PIPE MATERIAL SCHEDULE

THE FOLLOWING LIST OF PIPE MATERIALS IS SOLELY INTENDED AS A GENERAL OVERVIEW OF SYSTEM TYPES & MATERIAL REQUIREMENTS THEREIN. THE CONTRACTOR SHALL CLOSELY COORDINATE WITH THE CONTRACT DOCUMENTS TO VERIFY ALL PROJECT SPECIFIC SYSTEMS AS WELL AS DIVISION 22 SPECIFICATIONS FOR GENERAL CONDITIONS & CONSTRUCTION REQUIREMENTS.

COORDINATE WITH THE CON-	TRACT DOCU	JMENTS TO VERIFY ALI	L PROJECT SF	PECIFIC SYSTEMS AS WELL AS DIVISION 22 SPEC	IFICATIONS FOR GENERAL CONDITIONS & CONSTR	UCTION REQUIREMENTS.
DESCRIPTION	SYMBOL	LOCATION	SIZE	MATERIAL TYPE	JOINT	INSULATION
DRAIN AND WASTE PIPE (WASTE , SANITARY WASTE, STORM DRAIN, RAINWATER LEADER & OVERFLOW PIPING)	-	ABOVE GROUND	ALL	NO HUB CAST IRON CONFORMING TO ASTM A888 AND CISPI 301 OR DWV COPPER PIPE AND FITTINGS CONFORMING TO ASTM B306 AND ASME B16.23 AND B16.29	NO HUB PIPE CONFORMING TO ASTM A888 AND CISPI 301. COUPLINGS CONFORMING TO ASTM 1277 AND CISPI 310 WITH STAINLESS STEEL BANDS. HEALTHCARE PROJECTS AND / OR OVER CRITICAL & SENSITIVE AREAS (AS DEFINED BY CMC SECTION 322.0) SHALL MEET THE REQUIREMENTS OF FM1680, SD CLASS 1 AND ASTM C1540 OR DWV COPPER PIPE AND FITTINGS SOLDERED AND CONFORMING TO ASTM B32	WHERE APPLICABLE. SEE NOTES.
SANITARY VENT	V	ABOVE GROUND	2-1/2" AND SMALLER	CAST IRON SOIL PIPE & FITTINGS CONFORMING TO ASTM A888 AND CISPI 301 OR DWV COPPER PIPE AND FITTINGS CONFORMING TO ASTM B306 AND ASME B16.23 AND B16.29	NO HUB COUPLING OR DWV COPPER PIPE AND FITTINGS SOLDERED AND CONFORMING TO ASTM B32	NONE
DOMESTIC WATER PIPE (TEMPERED WATER, TEMPERED WATER RETURN, HOT WATER, HOT WATER RETURN & COLD WATER)	-	ABOVE GROUND	1-1/4" AND SMALLER	ASTM B88, TYPE L COPPER TUBING, HARD-TEMPER WITH WROUGHT COPPER FITTINGS.	LEAD FREE SOLDER	WHERE APPLICABLE. SEE NOTES.
DOMESTIC WATER PIPE (TEMPERED WATER, TEMPERED WATER RETURN, HOT WATER, HOT WATER RETURN & COLD WATER)	-	ABOVE GROUND	1-1/2" AND LARGER	ASTM B88, TYPE L COPPER TUBING, HARD-TEMPER WITH WROUGHT COPPER FITTINGS.	BRAZED	WHERE APPLICABLE. SEE NOTES.
CONDENSATE DRAIN	CD	ABOVE GROUND (INSIDE BUILDINGS)	ALL	ASTM B88, TYPE L COPPER TUBING AND FITTINGS.	BRAZED	WHERE APPLICABLE. SEE NOTES.
CONDENSATE DRAIN	CD	ABOVE GROUND (OUTSIDE BUILDINGS)	ALL	ASTM B88, TYPE L COPPER TUBING AND FITTINGS, CAST IRON DRAIN PIPE & FITTINGS OR SCHEDULE 40 GALVANIZED STEEL PIPE AND CAST IRON DRAIN OR VENT FITTINGS	BRAZED OR LEAD-FREE SOLDER	NONE
MEDICAL GAS (CARBON DIOXIDE, OXYGEN, MEDICAL AIR, HIGH-PRESSURE MEDICAL COMPRESSED AIR, NITROUS OXIDE, NITROGEN & VACUUM)	-	ABOVE GROUND	1 1/4" AND SMALLER	ASTM B819 - TYPE L , SEAMLESS, DRAWN TEMPER, MEDICAL GAS TUBE THAT HAS BEEN FACTORY CLEANED, PURGED AND SEALED FOR OXYGEN SERVICE.	BRAZED	NONE

- TYPE DWV COPPER TUBING OR NO-HUB CAST IRON PIPE AND FITTING MAY BE USED FOR CONCEALED RAINWATER LEADERS. WHERE NO-HUB PIPING IS USED, THE FITTINGS AND COUPLINGS SHALL MATCH THOSE USED FOR WASTE PIPING.
- 2 ALL DOMESTIC WATER MALE AND FEMALE ADAPTERS OF ANY SIZE SHALL BE SOLDERED IN LIEU OF BRAZING.
- INSULATION FOR DOMESTIC HOT AND TEMPERED WATER SHALL BE IN COMPLIANCE WITH THE CALIFORNIA ENERGY CODE, SECTION 120.3 AND TABLE 120.3-A FOR HOT WATER PIPING 105-140 F. R-VALUE OF R-7.7 FIBERGLASS WITH ASJ-SSL JACKET FOR PIPING LESS THAN 1" DIAMETER AND R-VALUE OF R-12.5 FIBERGLASS WITH ASJ-SSL JACKET FOR PIPING 1" TO 1.5" DIAMETER.
- EXPOSED INSULATED PIPING WITHIN THE BUILDING SHALL HAVE A ZESTON 2000 25/50, PROTO LO-SMOKE, OR EQUAL, PVC JACKET AND FITTING COVER INSTALLED OVER THE INSULATION, APPLIED PER MANUFACTURER'S INSTRUCTIONS.
- PROVIDE PVC JACKETING COLOR CODED TO VCO STANDARDS OR PREFERENCES FOR ALL EXPOSED INSULATED LINES IN OCCUPIED SPACES AND IN MECHANICAL ROOMS.
- PROVIDE LABELING OF ALL INSULATED AND NON-INSULATED PIPING. LABELS TO BE AT 20 FOOT INTERVALS AND A MINIMUM OF ONE PER ROOM. PROVIDE DIRECTIONAL ARROWS OF FLOW AND LABEL ADJACENT TO AND SHUT-OFF VALVE DESCRIBING CONTENT.
- PIPE, TUBE AND FITTINGS USED IN POTABLE WATER SYSTEMS INTENDED TO SUPPLY DRINKING WATER SHALL MEET THE REQUIREMENTS OF NSF-61, "DRINKING WATER SYSTEMS COMPONENTS - HEALTH EFFECTS"
- PIPE, PIPE OR PLUMBING FITTINGS, FIXTURES, SOLDER AND FLUX INSTALLED IN A SYSTEM PROVIDING WATER FOR HUMAN CONSUMPTION SHALL COMPLY WITH LEAD FREE REQUIREMENTS OF THE CALIFORNIA HEALTH AND SAFETY CODE SECTION 116875. PROVIDE PRODUCT SUBMITTAL INFORMATION PROVING COMPLIANCE WITH LEAD FREE REQUIREMENTS.
- 9 HCAI APPROVED LOKRING TECHNOLOGY CONNECTORS ARE ACCEPTABLE FOR USE WHEN CONNECTING NEW MEDICAL GAS PIPING TO EXISTING UP TO AND INCLUDING 2" PIPE SIZE.

### PLUMBING FIXTURE SPECIFICATION & CONNECTION SCHEDULE

TAG	DESCRIPTION & LOCATION	BRANCH PIPING				MAKE & MODEL NO.	• REMARKS			
		W	V	DCW	DHW	WAKE & MODEL NO.	REIVIARRS			
<u>HWS-1</u>	HANDWASH SINK (CT 2, 1P745 & CT 3, 1P742)	2"	1½"	1/2"	1/2"	"AMERICAN STANDARD" MURRO MODEL 0958.908EC	WALL MOUNTED HAND WASH SINK, 21½"x20½",VITREOUS CHINA, LESS OVERFLOW WITH ACRYLIC SHROUD MODEL 0062.00EC, CONCEALED ARM SUPPORT AND FLAT GRID STRAINER. PROVIDE "CHICAGO FAUCET" MODEL 116.103.AB.1 GOOSENECK SENSOR OPERATED FAUCET, 1.5 GPM NON-AERATING LAMINAR FLOW OUTLET, MODEL 240.630.001.1 PLUG-IN SINGLE USE CLASS 2A TRANSFORMER (SEE DIVISION 26 FOR POWER) AND PAIRED WITH "CHICAGO FAUCET" MODEL 131-FMAE THERMOSTATIC MIXING VALVE WITH PIPE FLUSH MODE FOR THERMAL DISINFECTION.			

REFER TO DIVISION 22 SPECIFICATIONS FOR ADDITIONAL INFORMATION & ITEMS NOT OTHERWISE SHOWN OR NOTED.

AND SANITARY FITTINGS. PROVIDE IAPMO APPROVAL FOR TRAP, AND PROVIDE LESS TRAP SCREW CLEANOUT.

- PIPE, PIPE OR PLUMBING FITTINGS, FIXTURES, SOLDER AND FLUX INSTALLED IN A SYSTEM PROVIDING WATER FOR HUMAN CONSUMPTION SHALL COMPLY WITH LEAD FREE REQUIREMENTS OF THE
- FOR EACH CONNECTION TO FAUCETS, STOPS, HOSE BIBBS, ETC. EACH FIXTURE, EXCEPT HOSE BIBBS, SHALL HAVE A STOP VALVE INSTALLED ON THE WATER SUPPLY LINES TO PERMIT REPAIRS
- PROVIDE FIXTURES NOT HAVING INTEGRAL TRAPS WITH P-TRAP OF CHROMIUM-PLATED 17 GAUGE CAST BRASS, WITH 17 GAUGE SEAMLESS WALL RETURN, CONNECTED TO CONCEALED WASTE IN WALL
- INSULATE ALL EXPOSED WASTE PIPING AND DOMESTIC WATER SUPPLIES BELOW CBC ACCESSIBLE FIXTURES WITH CODE COMPLIANT MOLDED "CLOSED-CELL" VINYL COVERS. COVERS SHALL BE INSTALLED USING VANDAL RESISTANT FASTENERS AND MUST BE REMOVABLE. COVERS SHALL MEET FLAME SPREAD RATING NOT TO EXCEED 25 AND SMOKE DENSITY NOT TO EXCEED 50 WHEN TESTED IN ACCORDANCE WITH ASTM E-84, AND SHALL COMPLY WITH THE REQUIREMENTS OF CALIFORNIA CODE OF REGULATIONS, TITLE 24. "TRUEBRO" - LAV GUARD2 MODEL 103E-Z, "PLUMBEREX" -HANDY SHIELD (OR APPROVED EQUAL).
- 6. ALL SINKS AND URINALS SHALL BE PROVIDED WITH CLEANOUTS IN COMPLIANCE WITH THE CALIFORNIA PLUMBING CODE.
- . FAUCETS SHALL NOT BE EQUIPPED WITH AN AERATOR BUT MAY BE EQUIPPED WITH A NON-AERATING LAMINAR FLOW DEVICE AS PER HCAI REQUIREMENT AND THE 2022 CALIFORNIA PLUMBING CODE -SECTION 210.0 (c).
- . ALL ELECTRONIC SENSOR OPERATED FAUCETS & FLUSH VALVES SHALL BE CAPABLE OF FUNCTIONING AFTER LOSS OF NORMAL POWER IN COMPLIANCE WITH HCAI REQUIREMENT AND THE 2022 CALIFORNIA PLUMBING CODE - SECTION 210 (b) & 413.2. (REFER TO DIVISION 26 FOR POWER AND CRITICAL BRANCH CIRCUIT)
- 9. REFER TO ARCHITECTURAL PLANS FOR FINAL LOCATION AND MOUNTING HEIGHT OF CBC ACCESSIBLE FIXTURES.
- 10. WALL HUNG FIXTURES (UNLESS OTHERWISE NOTED) SHALL BE MOUNTED AT THE HEIGHT INDICATED ON THE ARCHITECTURAL DRAWINGS AND SHALL BE PROVIDED WITH IN-WALL SUPPORT CARRIER WITH THE FEET OF THE SUPPORT SECURELY ANCHORED TO THE FLOOR IN STRICT COMPLIANCE WITH THE MANUFACTURER'S WRITTEN INSTALLATION INSTRUCTIONS. PROVIDE CAST IRON SUPPORTS OF GRAPHITIC GRAY IRON, DUCTILE IRON OR MALLEABLE IRON. PROVIDE PRODUCT BY ONE OF THE FOLLOWING: "MIFAB", "WATTS", "JAY R. SMITH" AND "ZURN".
- a. LAVATORIES & HANDWASH SINKS: FLOOR MOUNTED, ADJUSTABLE WITH CONCEALED ARM SUPPORTS "MIFAB", MODEL MC-41-HCAI, (OR APPROVED EQUAL).

NOTE: PENDING THE REVIEW & APPROVAL OF THE PROJECT ARCHITECT & ENGINEER OF RECORD AND WHERE AN IN-WALL SUPPORT CARRIER ISN'T POSSIBLE A BACKING PLATE, ADJUSTABLE WITH CONCEALED ARM SUPPORTS COMPATIBLE WITH THE SPECIFIED FIXTURE -JAY R. SMITH SERIES 0722 (OR APPROVED EQUAL) MAY BE USED.

### CONDENSATE LIFT PUMP SCHEDULE

SYMBOL DESCRIPTION



"LITTLE GIANT", MODEL VCCA-20UL DRAIN PUMP WITH OVERFLOW DETECTION SWITCH. SIZED FOR 10 GALLONS PER HOUR (GPH) DISCHARGE AT 18 FT. HEAD AT 8.6 PSI. 3/8" BARBED 1/4 TURN RELEASE, TWIST-OFF LOCKING DISCHARGE ADAPTER WITH BUILT-IN CHECK VALVE. UNIT INCLUDES A 6 FT. ELECTRICAL CORD.

ELECTRICAL DATA: 115 VOLT, 60 HZ., 1.5 FLA, 93 WATTS

TOTAL FULL WEIGHT: 5.4 LBS.

### PLUMBING SPECIALTIES

				F LOMBING OF LCIALTIES
TAG	DESCRIPTION	MANUFACTURER	MODEL NUMBER	REMARKS
WCO	WALL CLEANOUT	MIFAB	L C1/60-RD	LINE SIZED NO-HUB CAST IRON STACK CLEANOUT WITH RECESSED THREADED PLUG AND ROUND, SMOOTH, STAINLESS STEEL ACCESS COVER WITH 3 1/2" ANCHOR SCREW.

EPARTMENT OF HEALTHCARE ACCESS AND INFORMATION:

600 Q Street, Suite 100 Sacramento, CA 95811 www.nachtlewis.com 916.329.4000




[916]724-7024



CONSU	LTANT LOGO:	
REV	REVISION DESCRIPTION	DATE
1	BACKCHECK 1	11/1/24
2	ADDENDUM 1 (ACD-001)	10/17/2

### **CONSTRUCTION DOCUMENTS**

AC OS OS BU	P. A. O.	N H	
ARCH.\ENGR.	FD&C JOB NO.	SHEE	T NO.
J. Flath\S. Crosby	9557740		
UCDMC PROJECT MANAGER	SCALE		00
Z. Price	AS SHOWN	P()	()/
DESIGNED BY	DATE	'	<b>\</b>
SSC	08/09/24		
DRAWN BY	CAD FILE	SHEET	OF

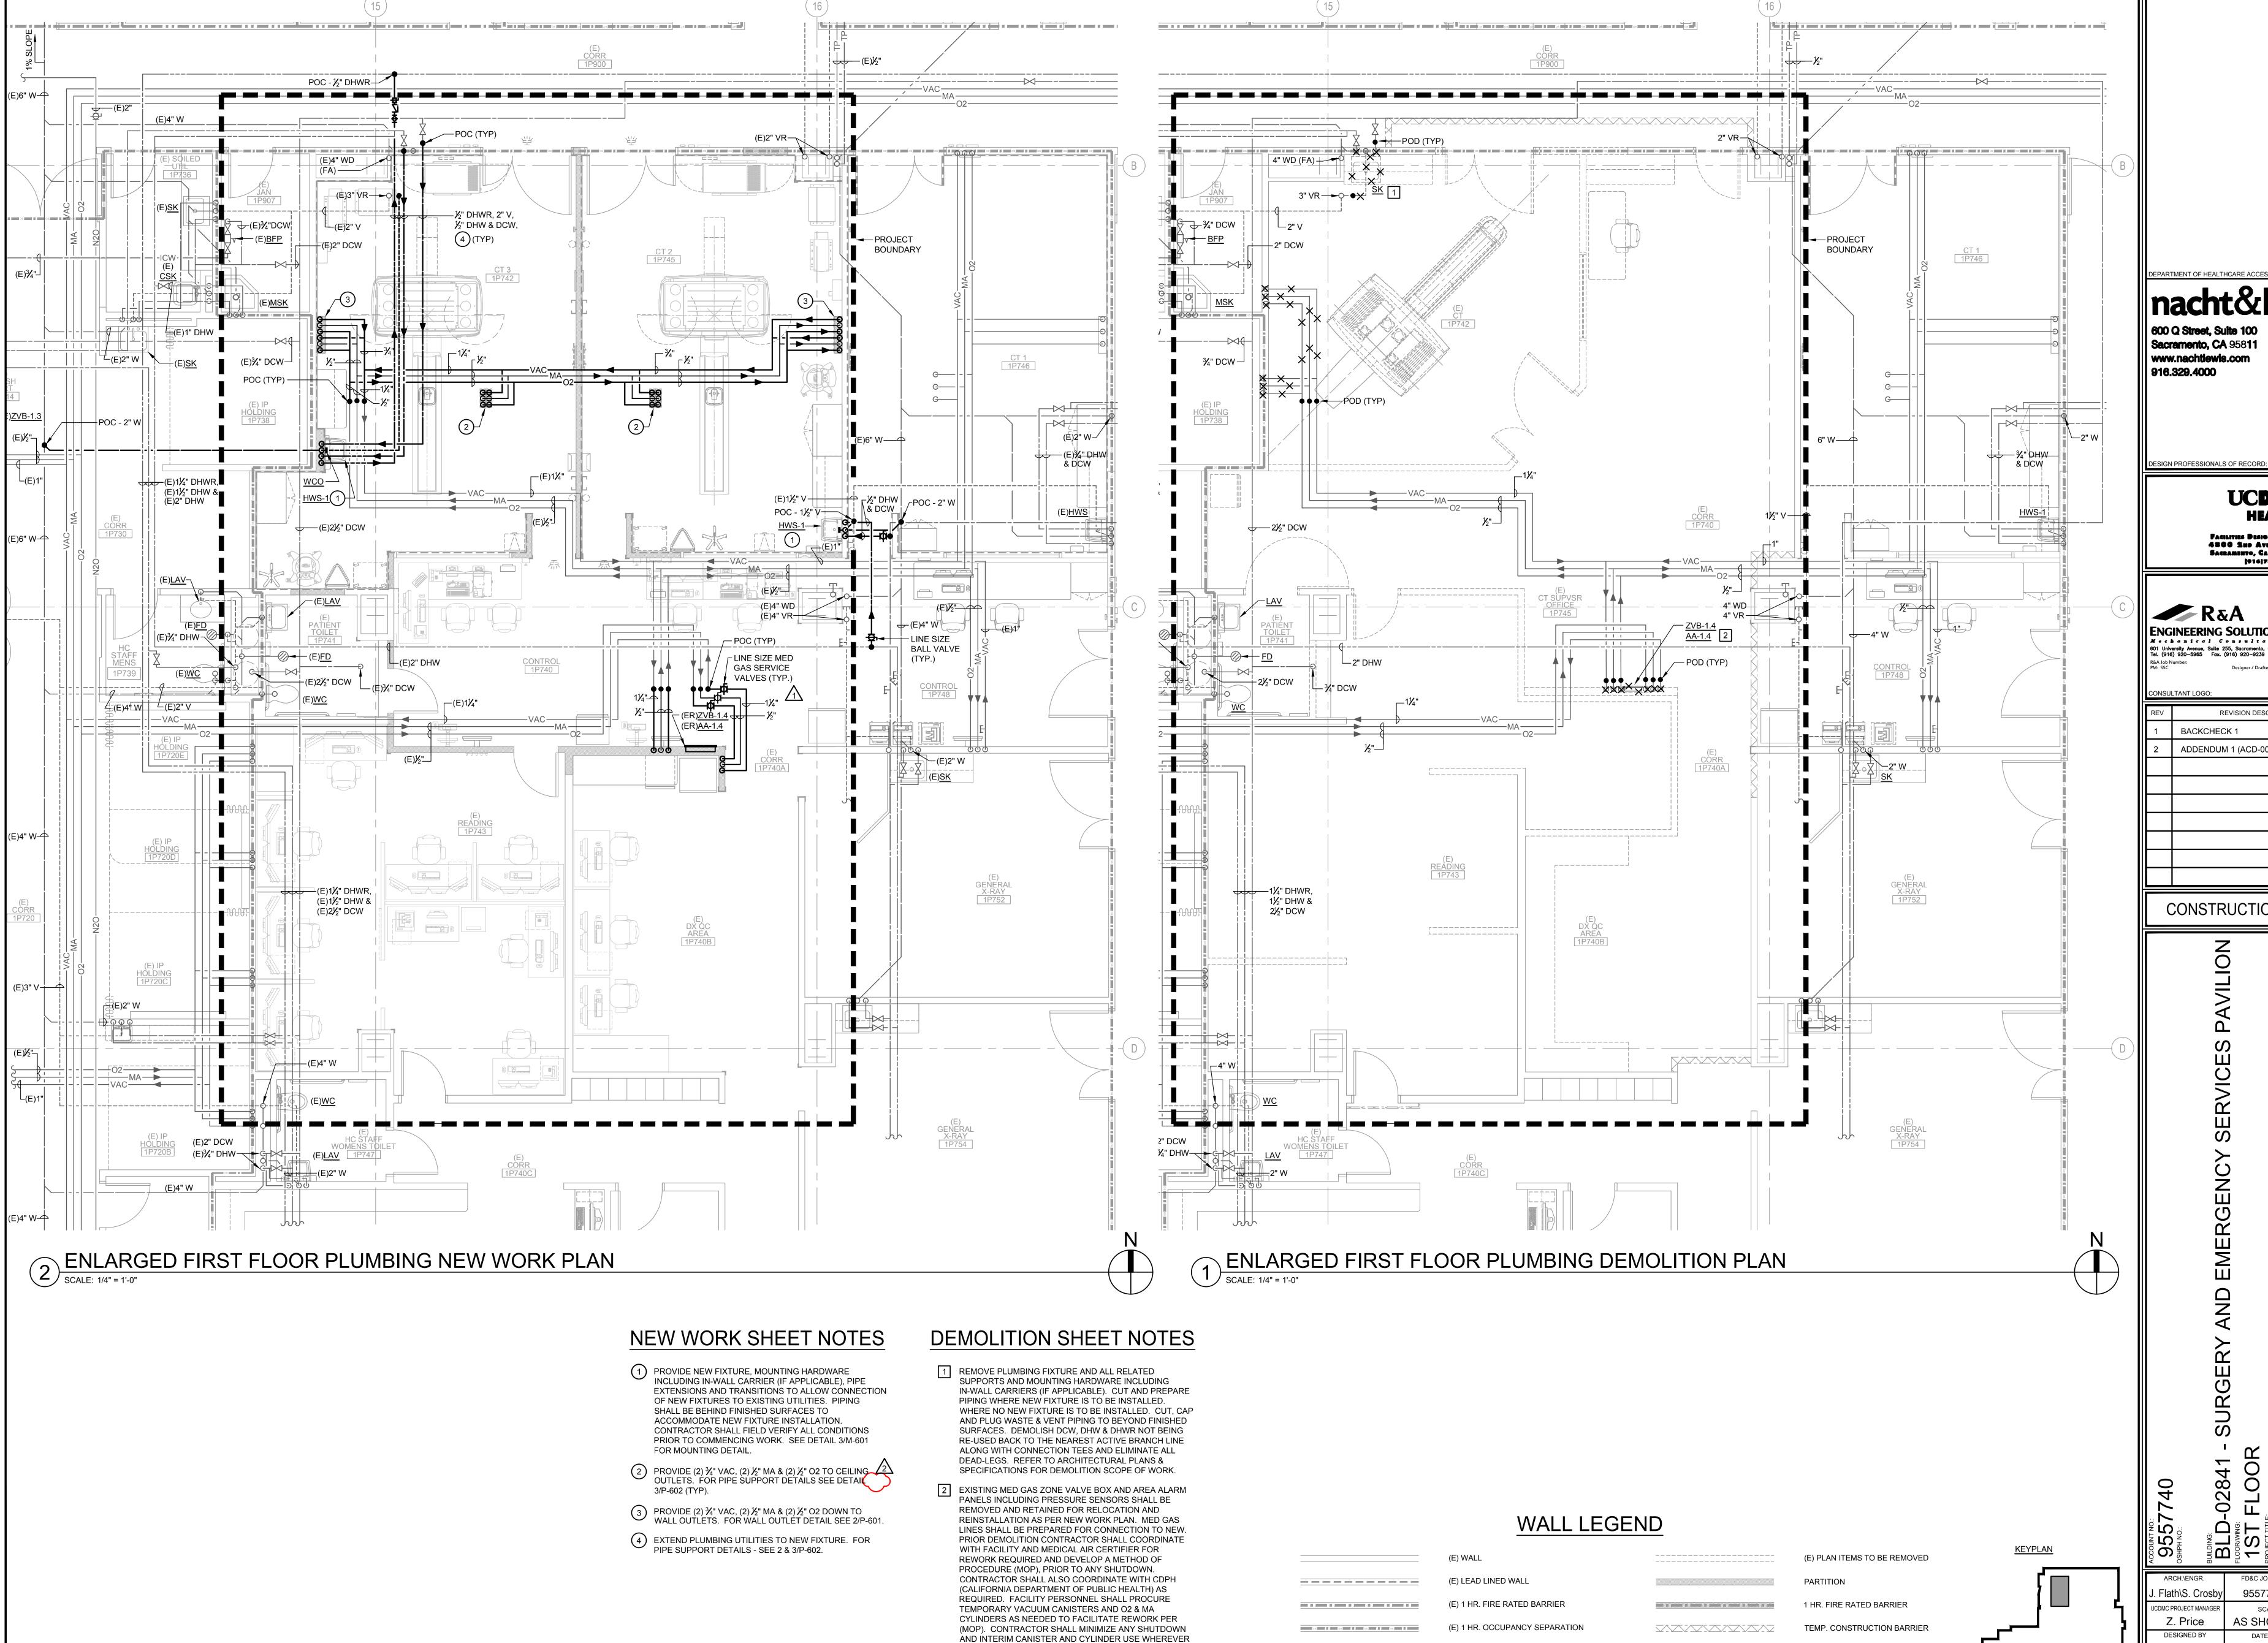

POSSIBLE. FOR ADDITIONAL INFO REFER TO NEW WORK

(E) 2 HR. FIRE BARRIER

(E) 2 HR. HORIZONTAL EXIT / SMOKE BARRIER

\_\_\_\_\_

EPARTMENT OF HEALTHCARE ACCESS AND INFORMATION:

600 Q Street, Suite 100 Sacramento, CA 95811 www.nachtlewis.com



**UCDAVIS** HEALTH


[916]734-7024



CONSU	LTANT LOGO:	
REV	REVISION DESCRIPTION	DATE
1	BACKCHECK 1	11/1/24
2	ADDENDUM 1 (ACD-001)	10/17/2

**CONSTRUCTION DOCUMENTS** 

9557740 **AS SHOWN** 08/09/24 MGE/MJR

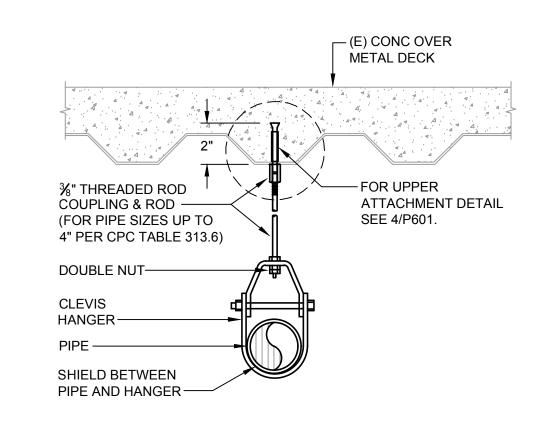

PLUMBING PIPE GRAVITY - (CAST IRON HUBLESS)					
	WASTE/RAINWATER		VENT		
DIAMETER	LB/FT	MAX. SPACING (SEE NOTE 2)	LB/FT	MAX. SPACING (SEE NOTE 2)	SEISMIC REQUIRED
1½"	6.40	-	2.9	-	NO
2"	8.80	-	3.8	-	NO
3"	13.70	-	5.4	-	NO

MEDICAL GASES - COPPER (TYPE L)				
I Diamatar I I P/ET I		HCAI SEISMIC REQ'D		
1/2"	0.28	6	NO	NO
3/4"	0.45	6	NO	NO
1"	0.65	6	NO	NO

DOMESTIC WATER - COPPER (TYPE L)			
Diameter	LB/FT W/INSUL.	MAX. SPACING (FT)	SEISMIC REQUIRED
1/2"	.99	6	NO
3/4"	1.36	6	NO
1"	1.80	6	NO


1. DETAIL SHOWN IS FOR GRAVITY SUPPORT OF PLUMBING UTILITY PIPING WITH SIZES NOTED, ANCHOR INSTALLATION SHALL COMPLY WITH OPM-0043-13 PAGE M2.20. FOR SEISMIC REQUIREMENTS REFER TO OPM-0043-13. NOTE THAT THERE ARE SPECIFIC EXCEPTIONS WHERE SEISMIC BRACING IS NOT REQUIRED, SUCH AS WHEN PIPE WEIGHT IS LESS THAN 5 LBS/LINEAR FOOT OR WHEN PIPE IS SUPPORTED WITHIN 12" OF STRUCTURE, REFER TO OPM FOR SPECIFIC INSTRUCTIONS. WHERE SEISMIC IS REQUIRED PROVIDE SEISMIC BRACING AND ROD STIFFENERS PER OPM. PIPING WITH NON-HAZARDOUS CONTENT WHICH WEIGH LESS THAN OR EQUAL TO 5 LBS/FT SUCH AS MEDICAL VACUUM OR COMPRESSED AIR ARE EXEMPT FOR SEISMIC DESIGN.

- 2. ALL SUPPORT SPACING AND BRACING REQUIREMENTS SHALL COMPLY WITH CPC TABLE 313.3.
- 3. PIPING WITH NON-HAZARDOUS CONTEXTS WHICH WEIGH LESS THAN OR EQUAL TO 5 LBS/FT SUCH AS MEDICAL VACUUM OR COMPRESSED AIR ARE EXEMPT FOR SEISMIC DESIGN.

### NON-SEISMIC

PIPE HANGER SUPPORT DETAILS

SCALE: NONE

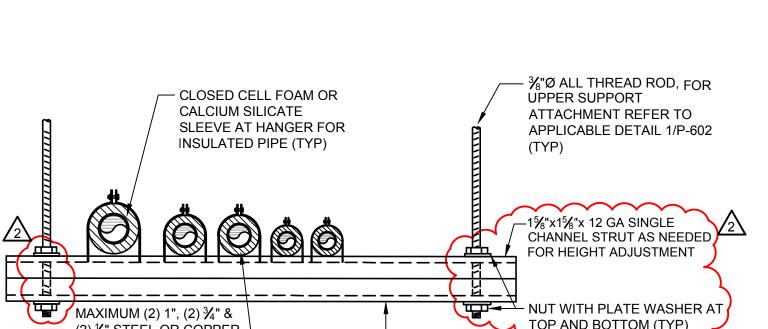

- CLOSED CELL FOAM OR

INSULATED PIPE (TYP)

- APPROVED ISOLATION

--1%"x1%"x 12 GA SINGLE

NUT WITH PLATE WASHER AT TOP AND BOTTOM (TYP)

FOR HEIGHT ADJUSTMENT

SLEEVE AT HANGER FOR

 $-\frac{3}{8}$ "Ø ALL THREAD ROD, FOR

UPPER ATTACHMENT SEE


MATERIAL AT CONNECTION

TO PIPE WHERE REQUIRED ~~~~~

CHANNEL STRUT AS NEEDED 2

CALCIUM SILICATE

2/M601

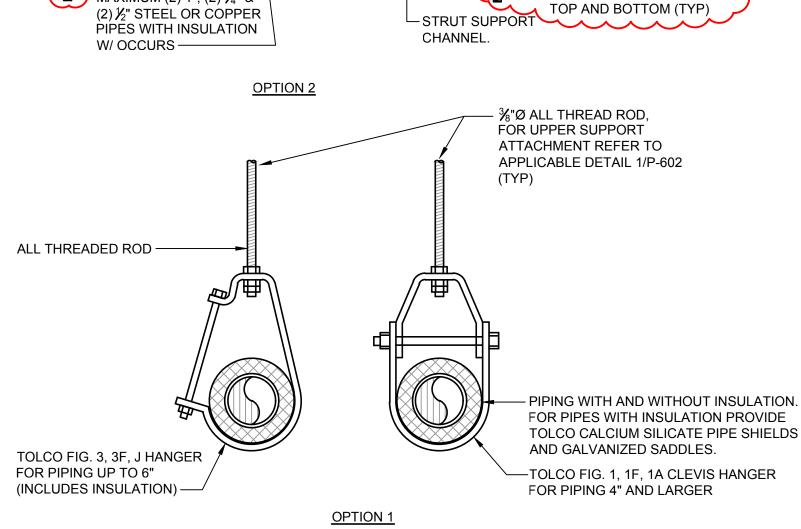

NOTES:

 $\triangle$ 

PIPING WITH AND WITHOUT

INSULATION, FOR PIPES WITH

INSULATION PROVIDE TOLCO

AND GALVANIZED SADDLES -


CALCIUM SILICATE PIPE SHIELDS

-15/8"x31/4"x 12 GA DOUBLE

CHANNEL STRUT

- 1. DOUBLE NUT ALL HANGERS AT BOTTOM OF HANGER RODS.
- COORDINATE WITH ELECTRICAL AND CONTROLS CONTRACTOR FOR SUPPORT OF CONDUITS WITHIN TRAPEZE HANGERS. MAX. 100 LBS PER TRAPEZE HANGER [CBC 1617A.1.26].
- ALL SUPPORT SPACING REQUIREMENTS SHALL COMPLY WITH CMC TABLE 313.3 AND CMC 1109.6 REQUIREMENTS AND PER TABLES IN DETAIL 5/P601.
- 4. ALL HANGERS MAY BE INSTALLED UP TO 5 DEGREES OUT OF PLUMB
- 5. MAX. 50 LBS PER SINGLE HANGER [CBC 1617A.1.26].
- 6. MAX. HANGER ROD LENGTH SHALL BE 5'-0" (TYP). ROD HANGERS LENGTHS USED SHALL BE INSTALLED TO AVOID IMPACT WITH OTHER STRUCTURAL OR NONSTRUCTURAL COMPONENTS OR PRECAUTIONS SHALL BE MADE TO PROTECT PIPING IN EVENT OF SUCH IMPACT. [CBC 1617A.1.26 A.]

## NON-SEISMIC 6 PIPE HANGER SUPPORT DETAILS SCALE: NONE

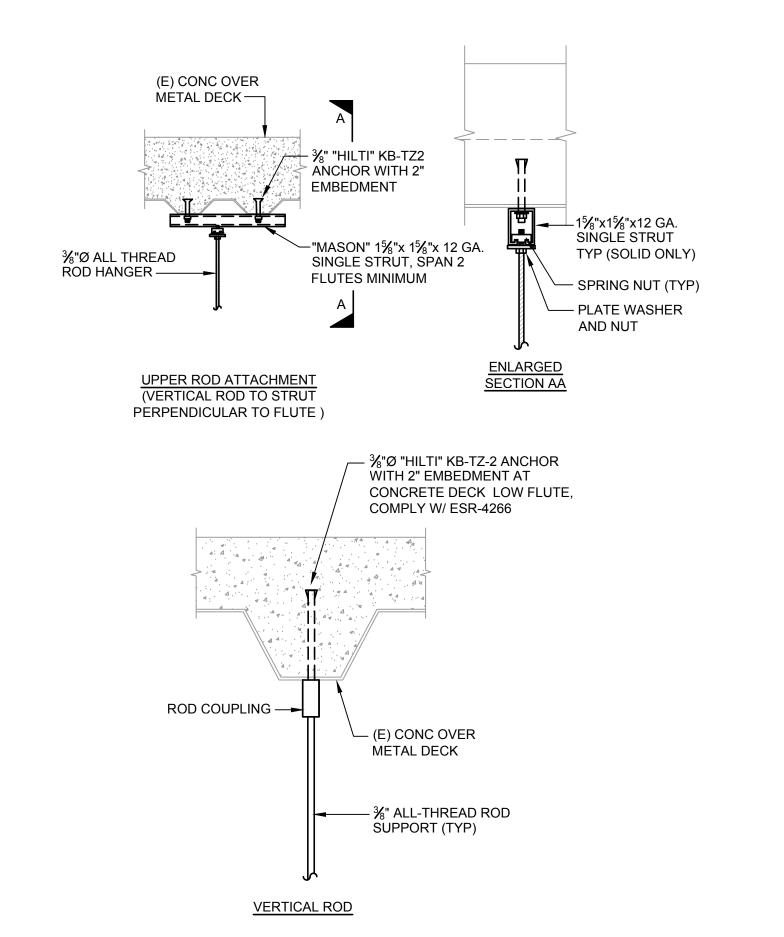


NOTES: 1. 124 LBS. MAX LOAD PER SUPPORT LOCATION.

2. INSTALLATION, INSPECTION AND TESTING OF POST-INSTALLED ANCHORS SHALL BE PER STRUCTURAL REQUIREMENTS, SEE ARCHITECTURAL DRAWINGS FOR MORE INFORMATION.


MIN. SPACING FROM ANY OTHER ADJACENT HANGER, SPLAY OR SUPPORT ROD SHALL BE 12". 2 SEE SHEET A635 FOR ALTERNATE ANCHORAGE TO CONCRETE FILLED METAL DECK.

VERTICAL UPPER ATTACHMENT DETAIL SCALE: NONE

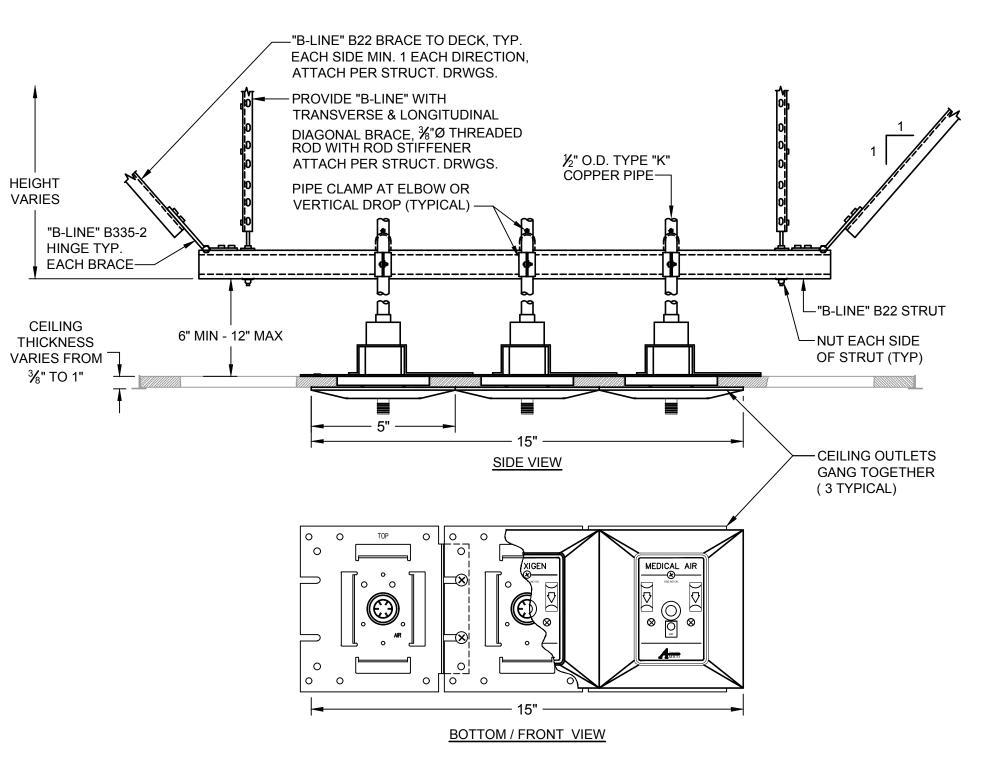


MEDICAL GAS CEILING OUTLET DETAIL

SCALE: NONE

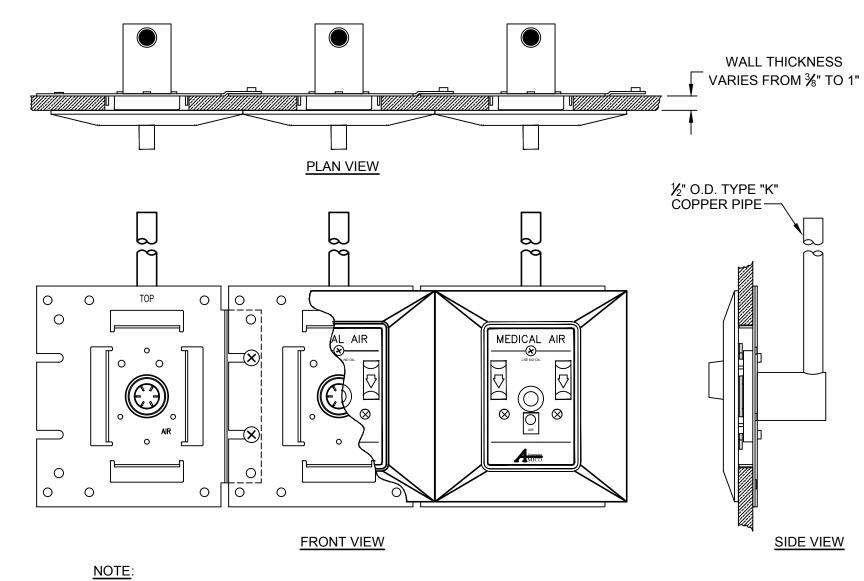

MAXIMUM 3 OUTLETS MAY BE GANGED TOGETHER WITHOUT ADDITIONAL SUPPORT

### MEDICAL GAS WALL OUTLET DETAIL SCALE: NONE

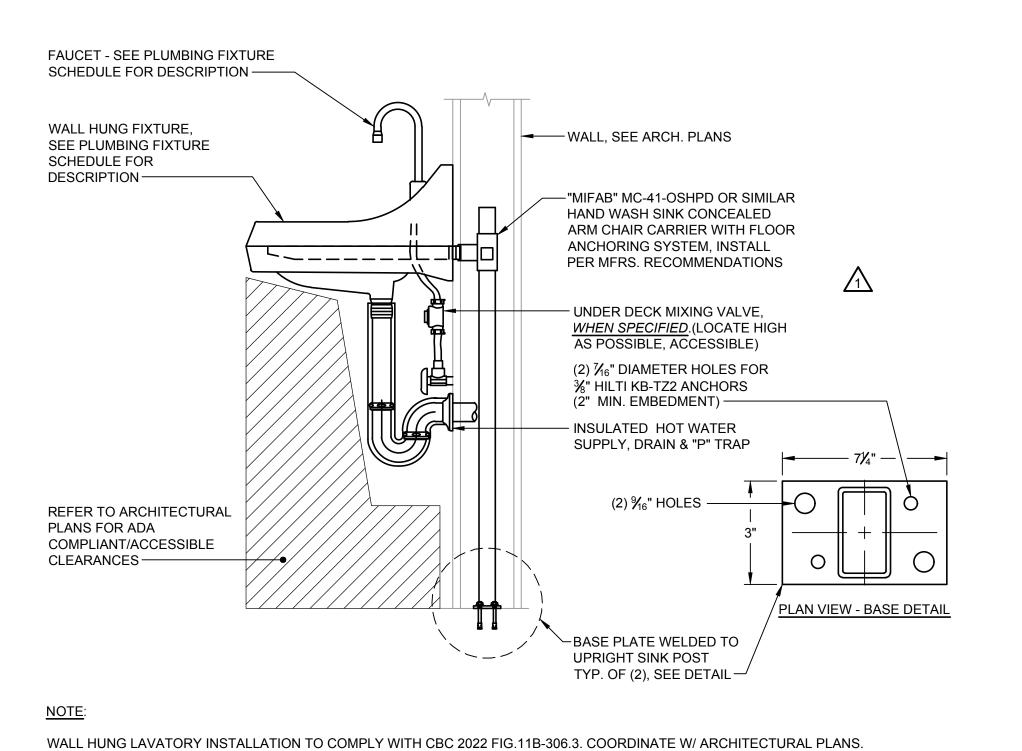

A HAND WASH SINK INSTALLATION DETAIL (ADA) SCALE: NONE

EPARTMENT OF HEALTHCARE ACCESS AND INFORMATION:





**UCDAVIS** HEALTH


[916]734-7024



CONSULTANT LOGO: REVISION DESCRIPTION DATE 11/1/24 BACKCHECK 1 ADDENDUM 1 (ACD-001) 10/17/25

**CONSTRUCTION DOCUMENTS** 

955. ARCH.\ENGR. I. Flath\S. Crosby 9557740 JCDMC PROJECT MANAGER Z. Price AS SHOWN DESIGNED BY DATE 08/09/24 MGE/MJR

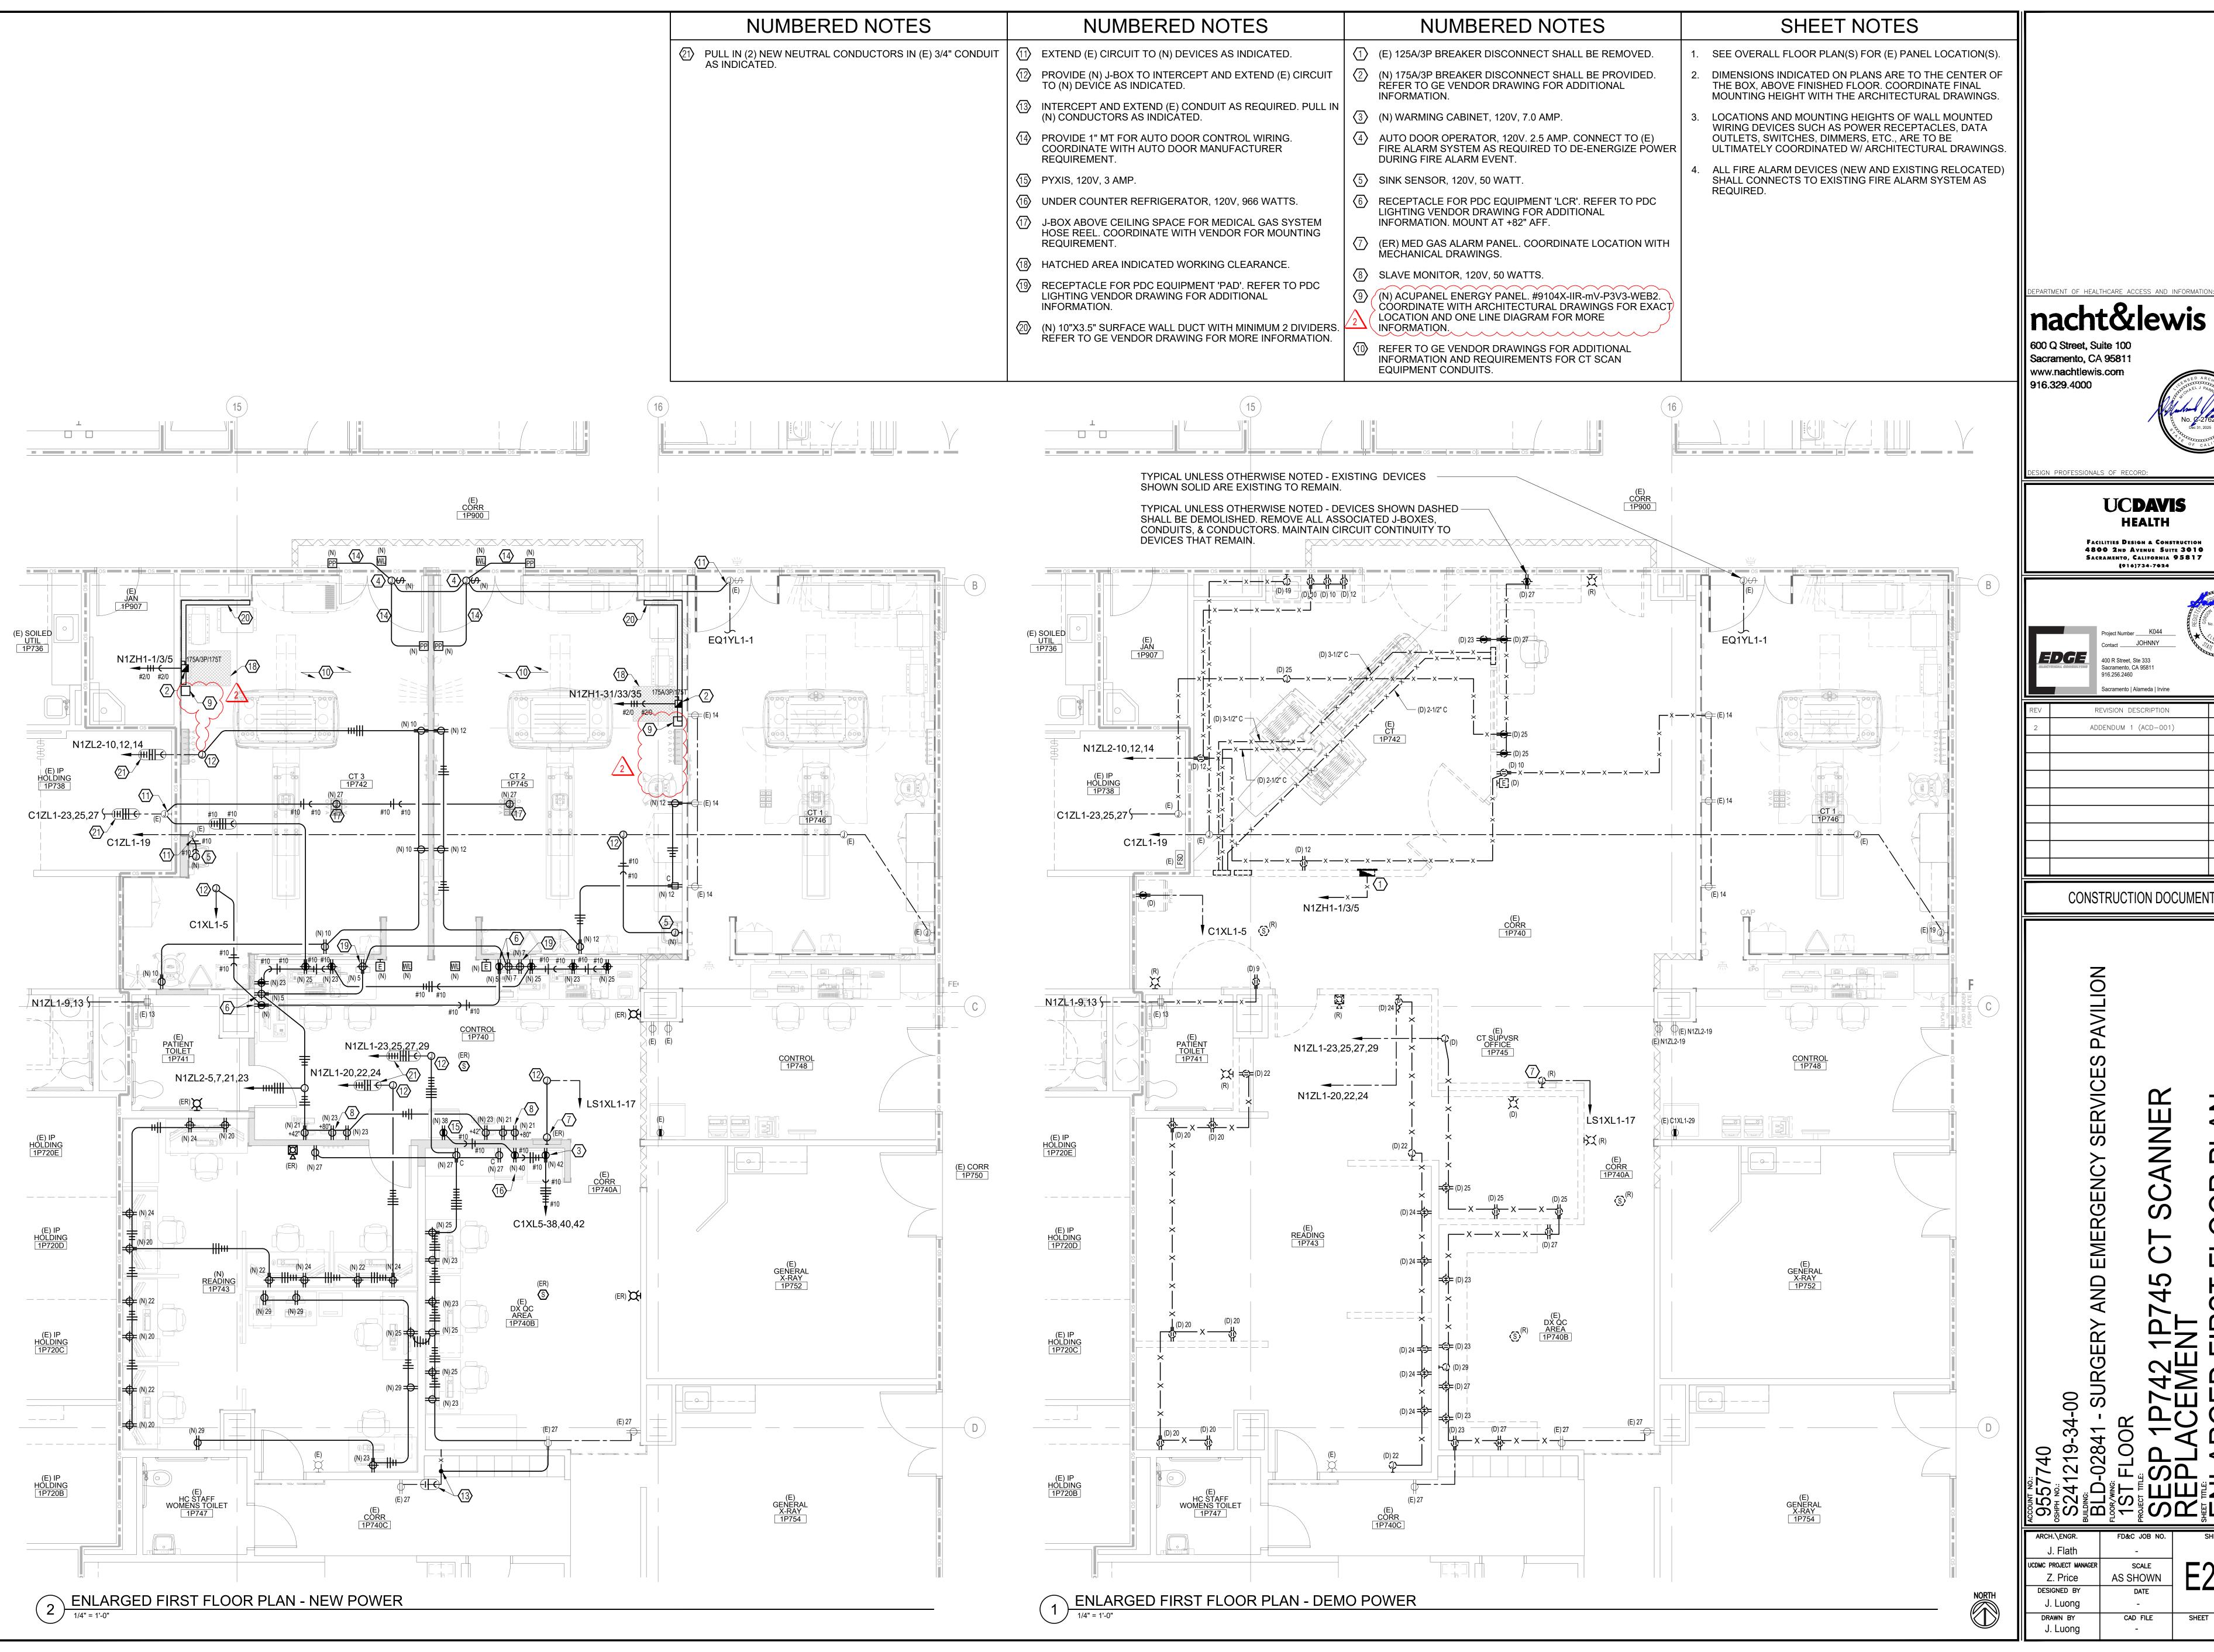


nacht&lewis

600 Q Street, Suite 100 Sacramento, CA 95811 www.nachtlewis.com

**UCDAVIS** HEALTH


FACILITIES DESIGN & CONSTRUCTION 4800 2ND AVENUE SUITE 3010 SACRAMENTO, CALIFORNIA 95817 \$916]734-7<del>02</del>4

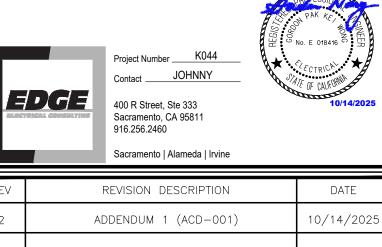

CONSTRUCTION DOCUMENTS

PA CEI S CEI N

AS SHOWN SHEET OF CAD FILE

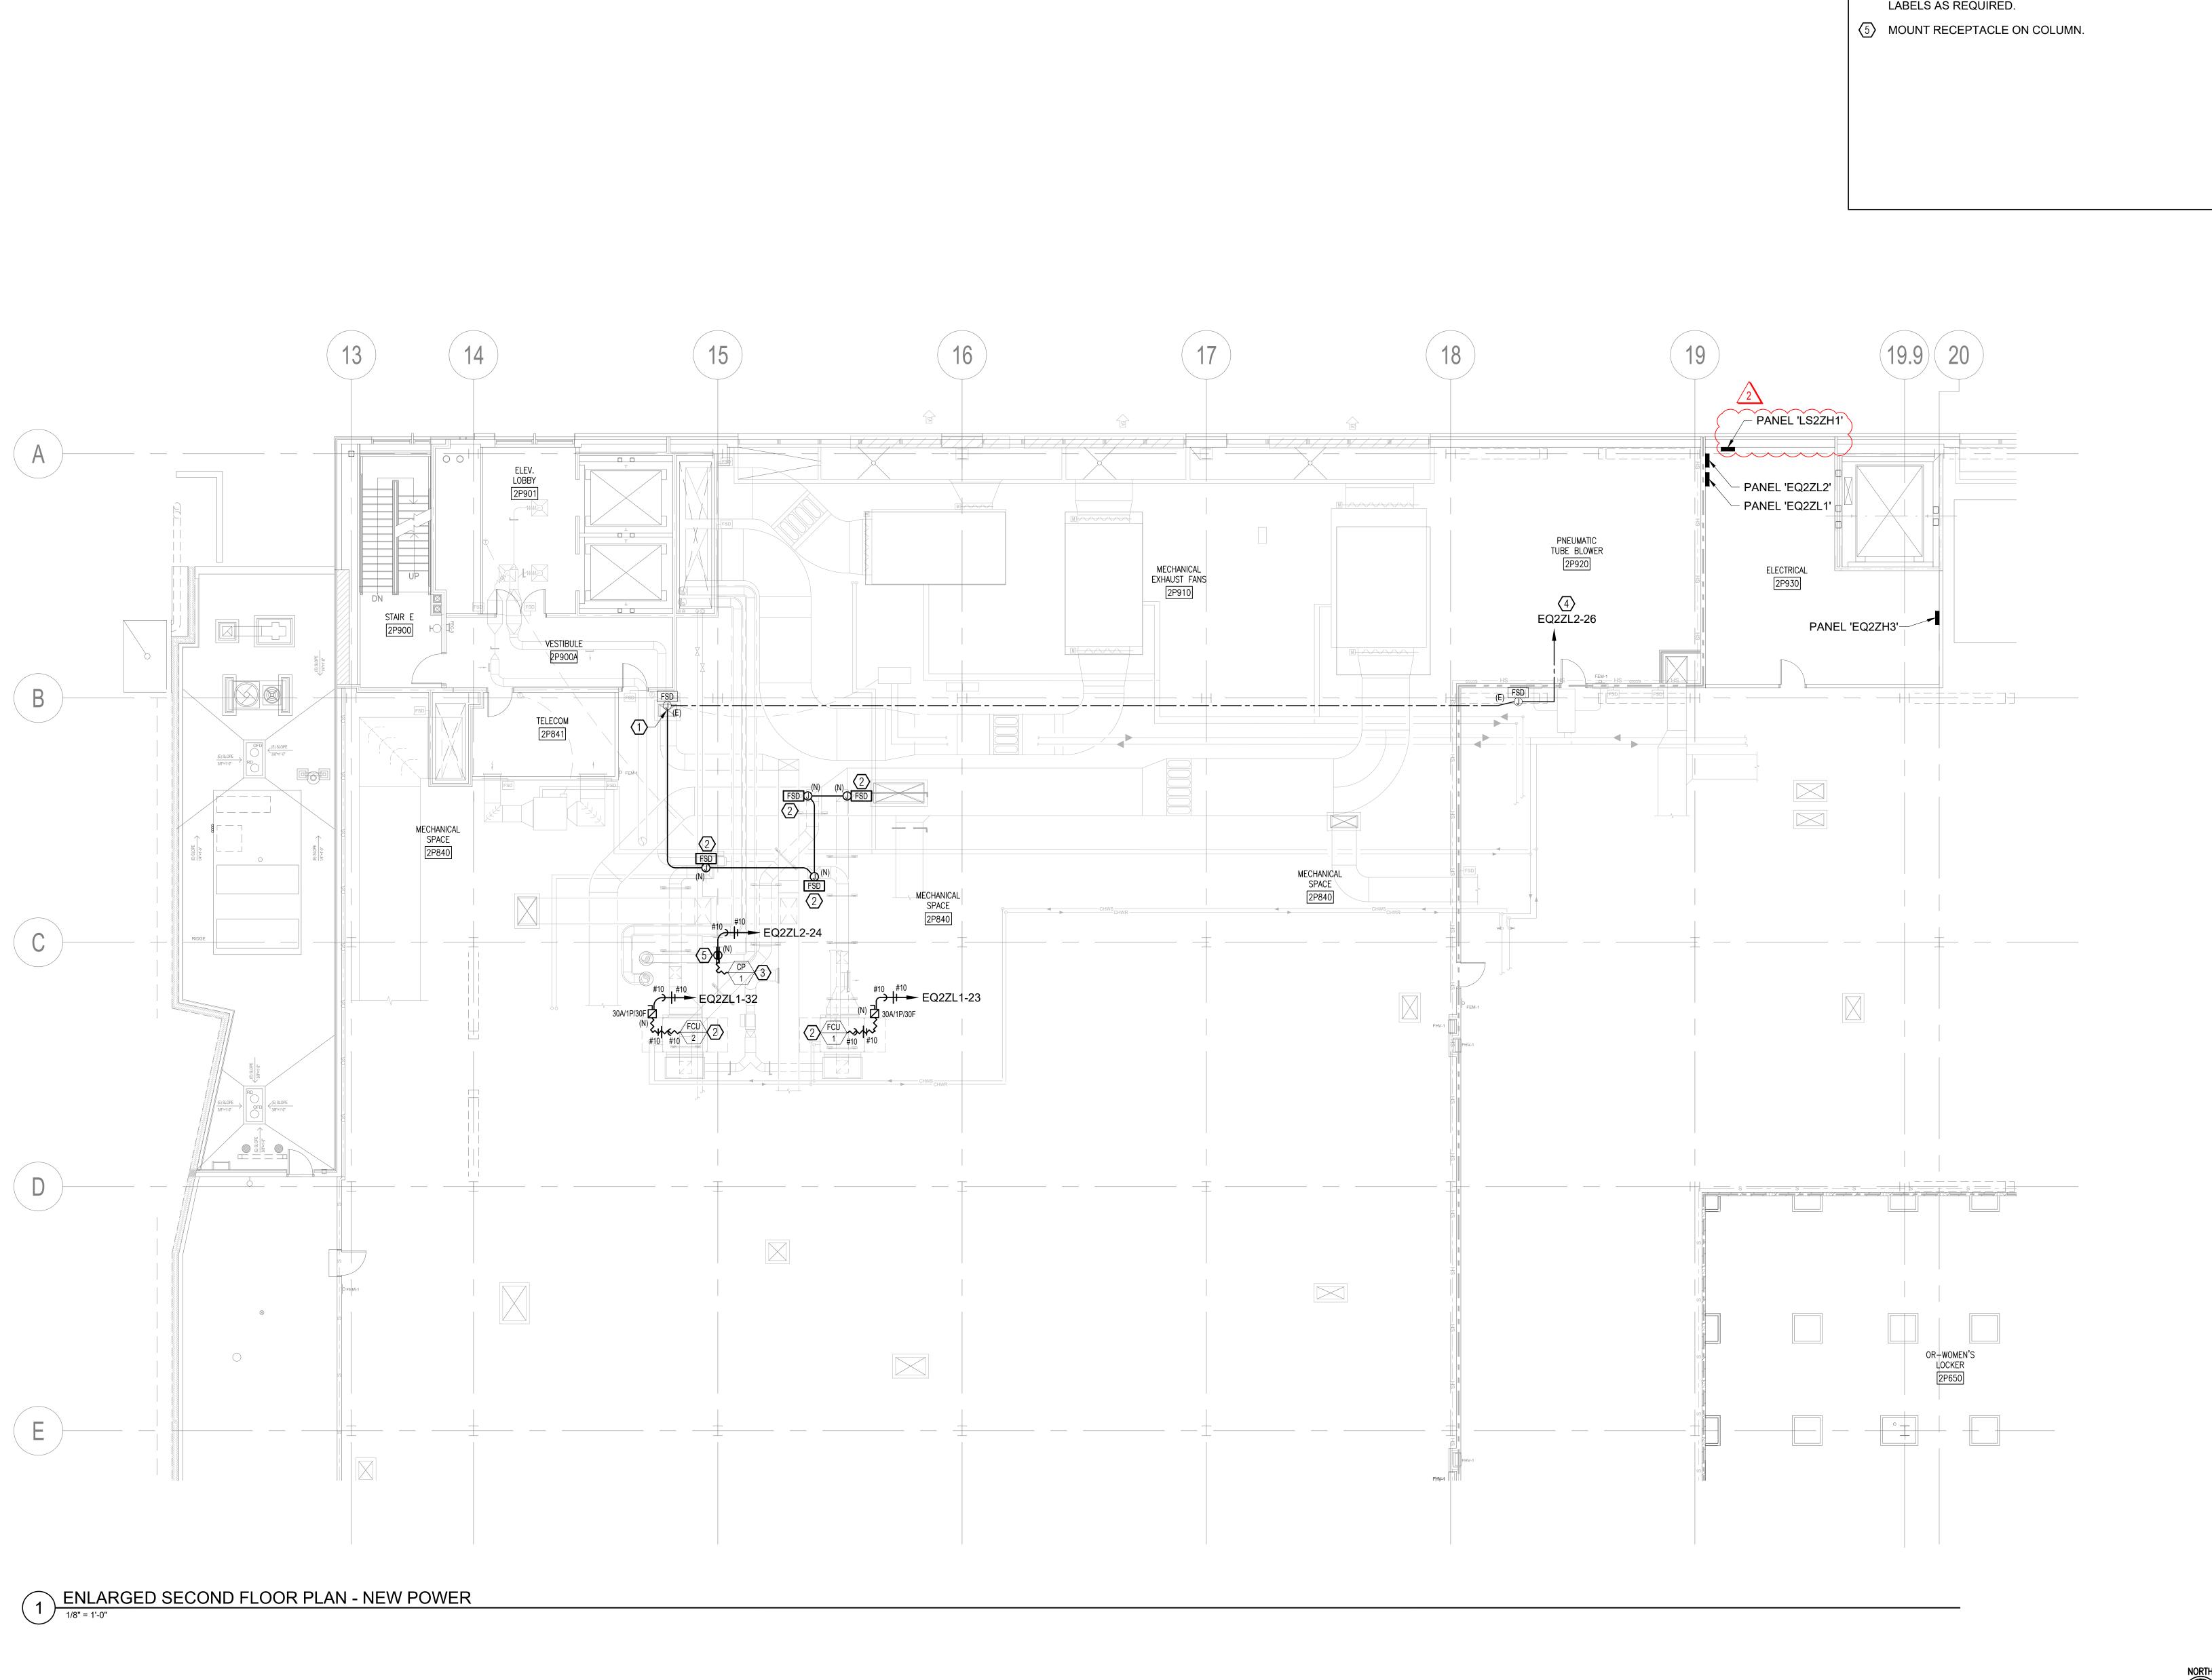

### NUMBERED NOTES

- EXTEND (E) CIRCUIT TO (N) DEVICES AS INDICATED.
- REFER TO MECHANICAL DRAWINGS FOR MORE INFORMATION, DETAIL, AND EXACT LOCATION.
- REFER TO PLUMBING DRAWINGS FOR MORE INFORMATION, DETAIL, AND EXACT LOCATION.
- RECIRCUIT HOMERUN FROM CIRCUIT EQ2XL1-32 TO CIRCUIT EQ2ZL2-26 AS REQUIRED. UPDATE EXISTING JUNCTION BOX LABELS AS REQUIRED.

DEPARTMENT OF HEALTHCARE ACCESS AND INFORMATION:

## nacht&lewis

600 Q Street, Suite 100 Sacramento, CA 95811 www.nachtlewis.com 916.329.4000

No. C-27624

Dec 31, 2025

OF CALLED

## UC**DAVIS**HEALTH

FACILITIES DESIGN & CONSTRUCTION 4800 2ND AVENUE SUITE 3010 SACRAMENTO, CALIFORNIA 95817 \$916)734-7024



REV	REVISION DESCRIPTION	DATE
2	ADDENDUM 1 (ACD-001)	10/14/202

CONSTRUCTION DOCUMENTS

SERVICES PAVILION

NER

742 1P745 CT SCANNER EMENT

ARCH.\ENGR. BILD-02841

STATE HOS SHEET

STATE HOS SHEET

STATE HOS SHEET

AS SHOWN

DMC PROJECT MANAGER AS SHOWN

TO SHEET

AS SHOWN

AND PROJECT MANAGER AS SHOWN

TO SHEET

AS SHOWN

TO SHEET

AS SHOWN

TO SHEET

TO SHEET

AS SHOWN

TO SHEET

T

NORTH

J. Flath


JCDMC PROJECT MANAGER
Z. Price
AS SHOWN

DESIGNED BY
J. Luong

DRAWN BY
J. Luong

CAD FILE
J. Luong

CAD FILE

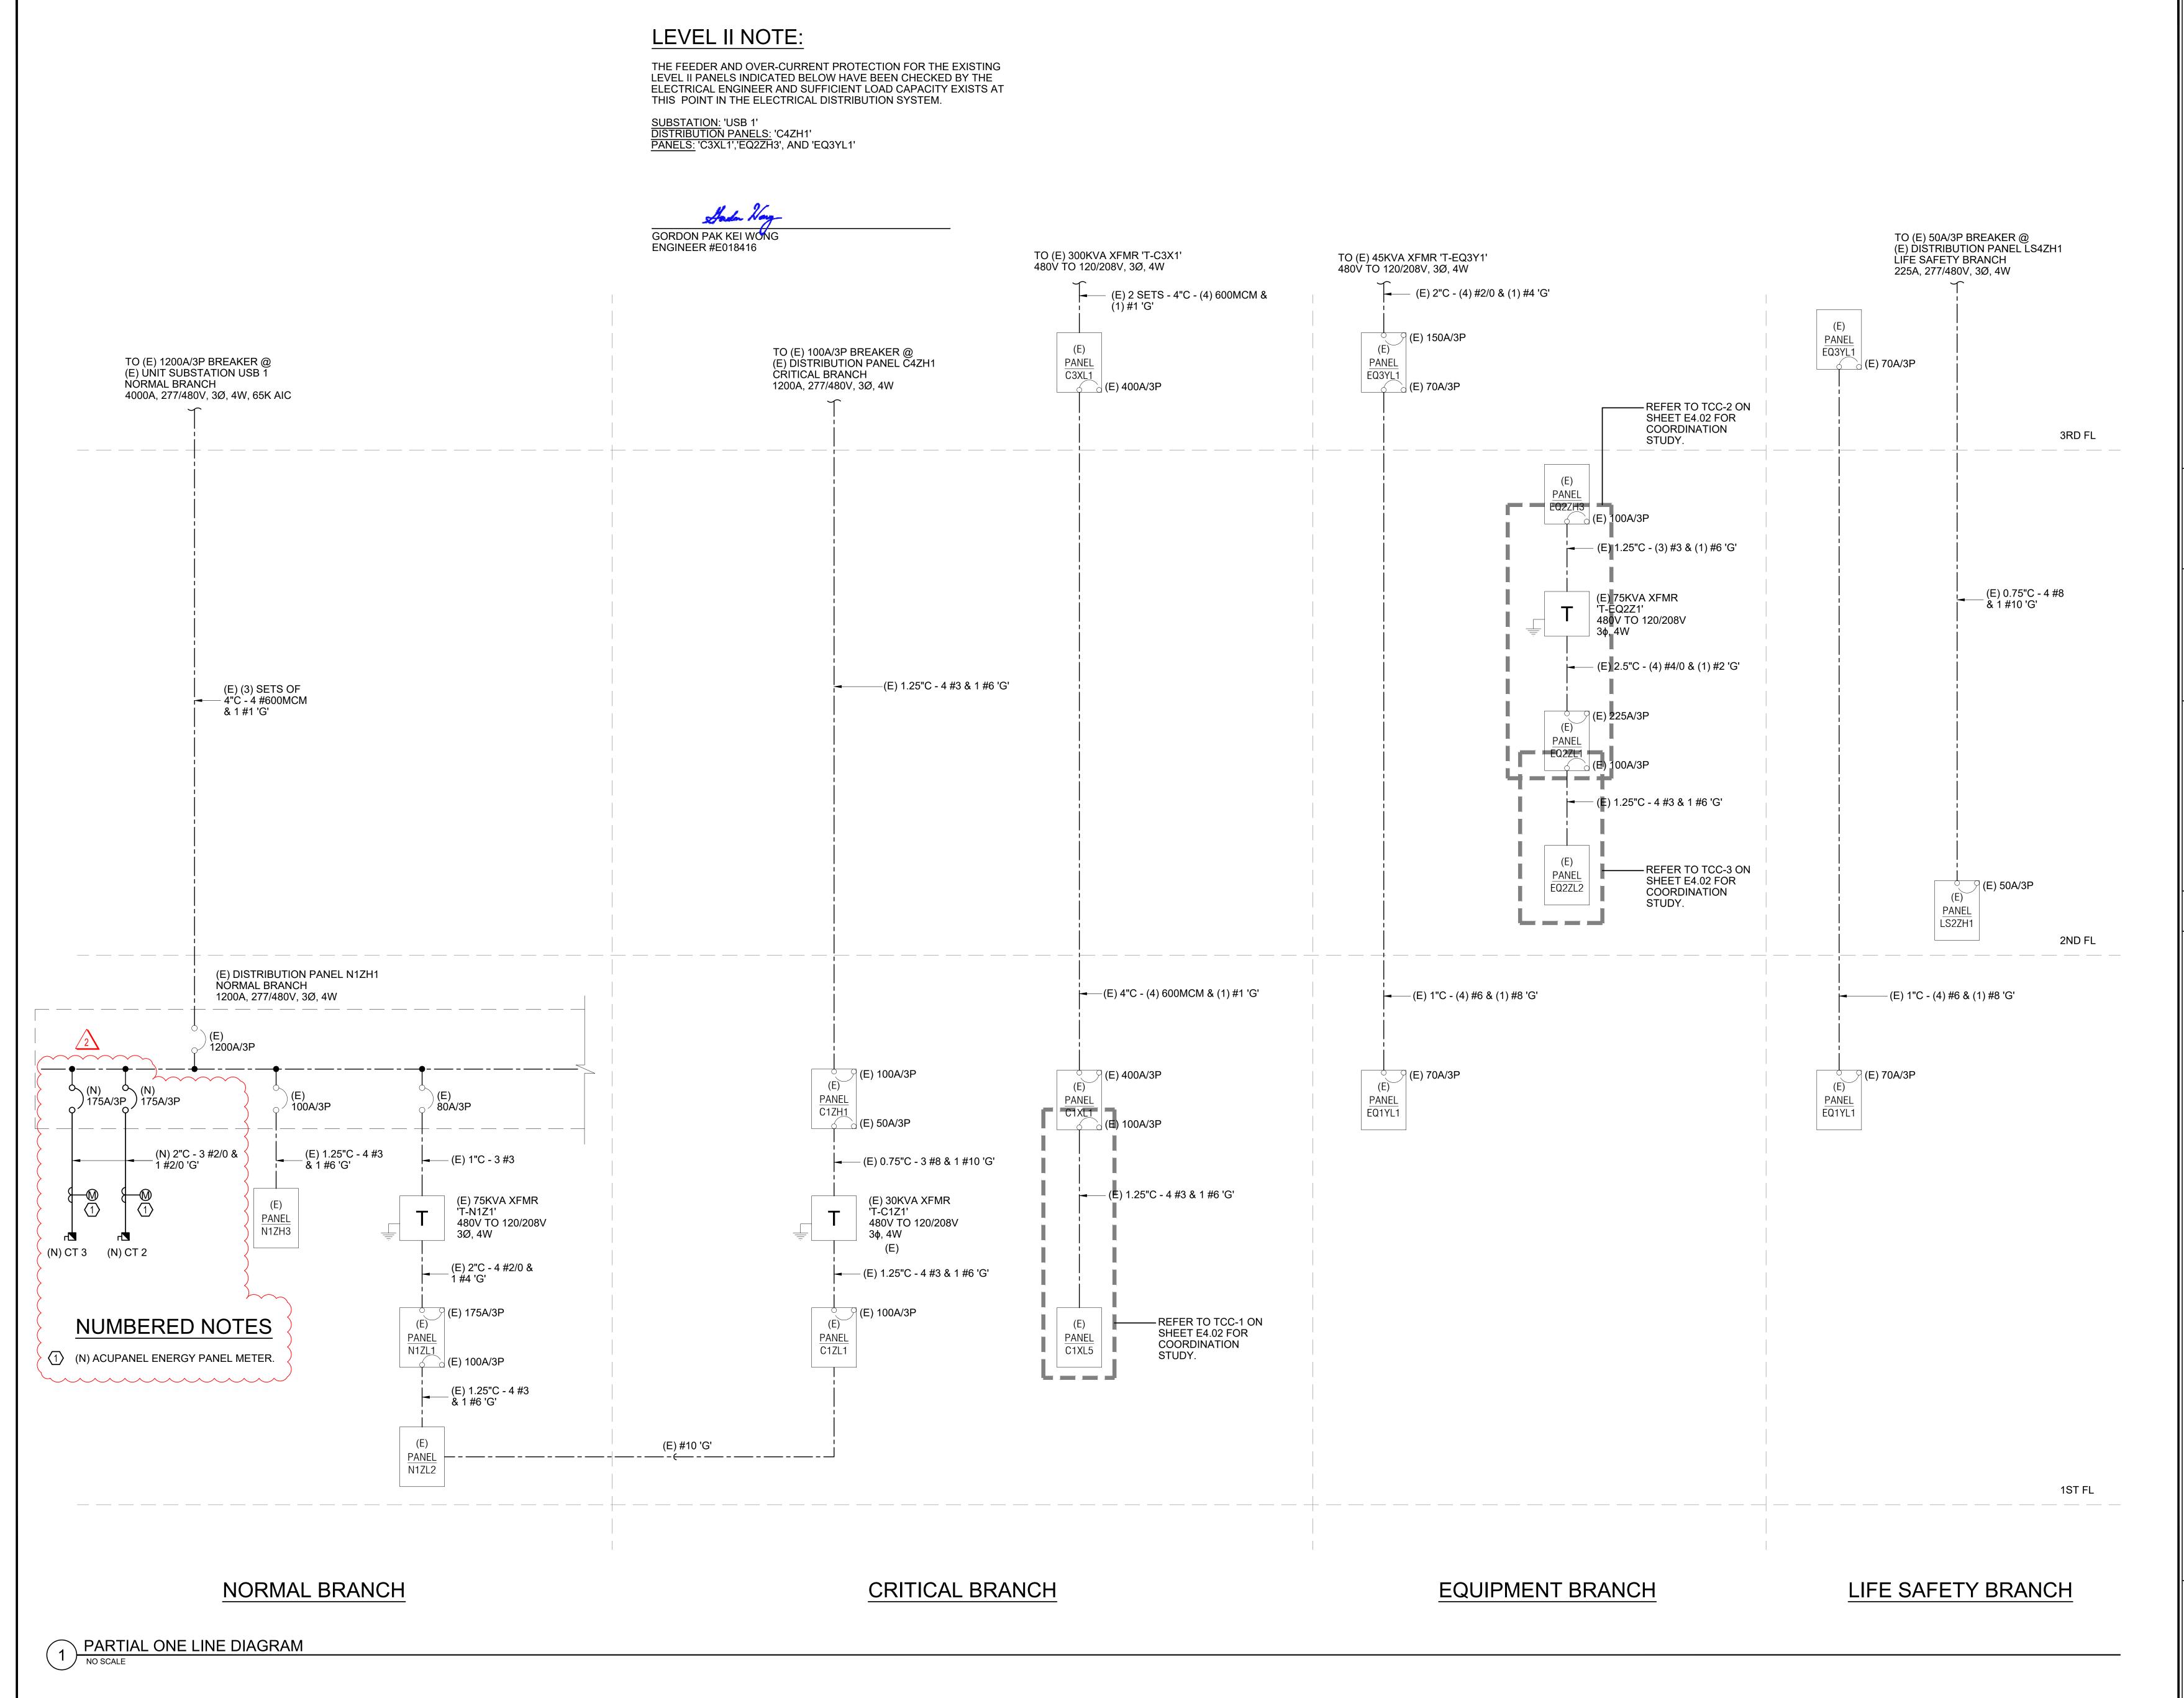

nacht&lewis


600 Q Street, Suite 100 Sacramento, CA 95811 www.nachtlewis.com 916.329.4000

UCDAVIS

HEALTH

FACILITIES DESIGN & CONSTRUCTION
4800 2ND AVENUE SUITE 3010
SACRAMENTO, CALIFORNIA 95817

{916}734-7024

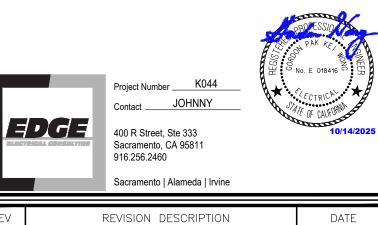

REV REVISION DESCRIPTION DATE

2 ADDENDUM 1 (ACD-001) 10/14/2025

CONSTRUCTION DOCUMENTS

ERY AND EMERGENCY SERVICES PAVILION 1P745 CT SCANNER

S241219-34-00
S241219-34-00
BULDING:
BLD-02841 - SURGERY / IST FLOOR
PROJECT TILE:
SESP 1P742 1P7
REPLACEMENT
SHET TILE:
(E) PARTIAL ON

ARCH.\ENGR. FD&C JOB NO.

J. Flath

UCDMC PROJECT MANAGER SCALE

Z. Price AS SHOWN


DESIGNED BY DATE

J. Luong

DRAWN BY CAD FILE SHEET

J. Luong

-

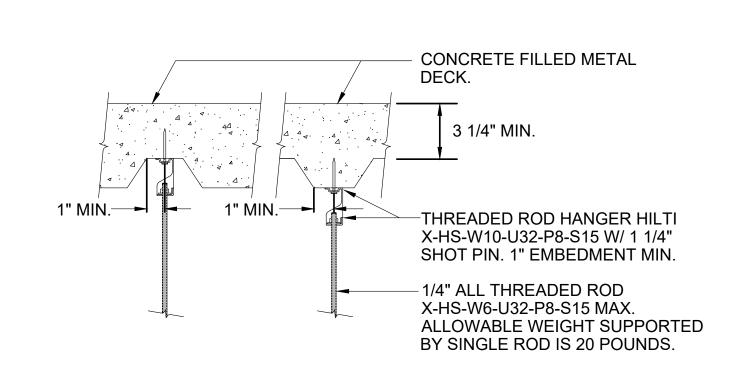

### NOTES:

- 1. UPON INSTALLATION OF FASTENER INTO CONCRETE FILLED METAL DECK, CONTRACTOR TO PATCH/REPAIR DAMAGE TO EXISTING. SPRAY APPLIED FIREPROOFING, AS REQUIRED, TO RESTORE ORIGINAL FIREPROOFING
- THICKNESS AND FIRE RATING. ANCHOR MAY BE PLACED AT HIGH OR LOW FLUTE, CENTER ANCHOR IN FLUTE TENSION TEST 10% OF CEILING CLIP ASSEMBLIES TO 20 LBS. SEE "POST INSTALLED" NOTES AND "POST INSTALLED
- ANCHOR TESTING CRITERIA" NOTES ON STRUCTURAL DRAWINGS FOR ADDITIONAL REQUIREMENTS. MAX. LENGTH OF ROD IS 60 INCHES. 5. SÉE SHĚET A635 FOR ALTERNATE ANCHORAGE TO CONCRÈTE FILLED METAL DĚCK.

### 1/4" THREADED ROD TO CONCRETE FILLED METAL DECK DETAIL

NO SCALE

MÉTAL DECK

2½" MIN

NO SCALE

(E) NORMAL WEIGHT CONCRETE ON-

3/8" DIAMETER HILTI -

**EMBEDMENT INTO LOW** 

FLUTE, ROD COUPLING.

THREADED ROD TO CONC FILLED METAL DECK - STRUT

SEE SHEET A635 FOR ALTERNATE ANCHORAGE TO CONCRETE FILLED METAL DECK.

AND HANGER ROD.

KBTZ2 WITH 2"

1. SUPPORTS AT 8'-0" O.C., MAX.

ONE HOLE STRAP CONDUIT DETAIL

NOTES: STRUT SUPPORTS SHALL BE LOCATED AT 10'-0" O.C., MAX. NO SLOTTED OR PREPUNCHED STRUTS PERMITTED. (5. SEE SHEET A635 FOR ALTERNATE ANCHORAGE TO CONCRETE FILLED METAL DECK.)

PLAN VIEW

### CONDUIT MOUNTING DETAIL - CONCRETE


NO SCALE

CONCRETE WALL.


3/8" DIAMETER HILTI KB-TZ2 WITH 2"——

PROVIDE CONDUIT CLAMP, TYPICAL.

EMBEDMENT. PROVIDE (2) PER

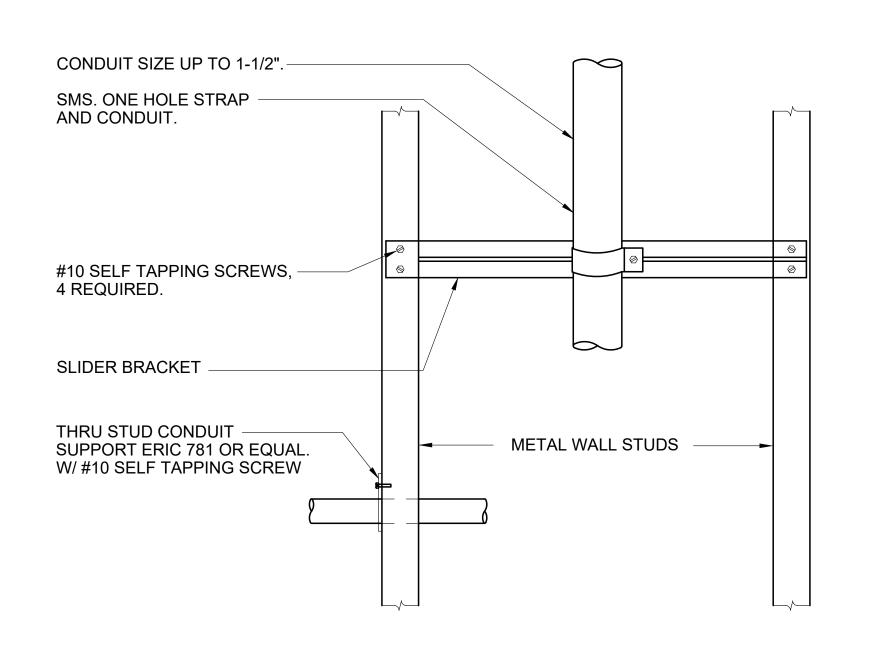



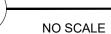

2" MIN

1 5/8 x 1 5/8 x 12GA CHANNEL

18" MINIMUM LENGTH. NO

SLOTTED OR PREDRILLED

3/8" DIAMETER THREADED

WASHERS AND DOUBLE

STRUTS PERMITTED.

ROD, W/ LARGE FLAT

- CHANNEL NUT.

-SHEET METAIL SCREW #8.

ONE HOLE STRAP AND


CONDUIT SIZE UP TO 3"

STUD WALL W/ GYP SHEATHING ONE OR BOTH SIDES (SIM. AT CONDITION W/O GYP SHEATHING).

CONDUIT

 $\Box \sqrt{\Box}$ 

**ELEVATION** 

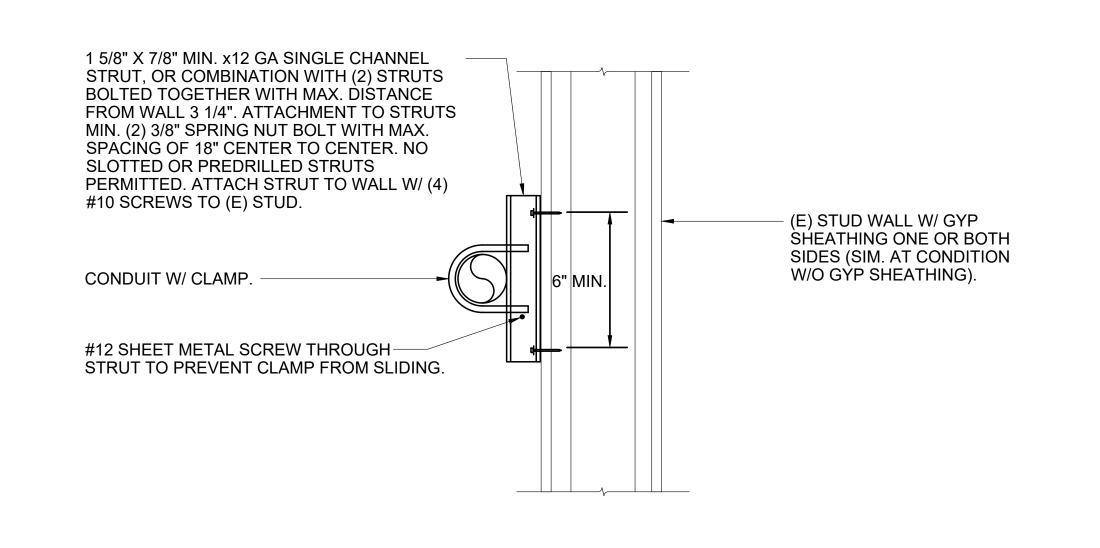

### NOTES:

- FOR 3/4" TO 3" CONDUIT, SUPPORTS @ 10'-0" OC MAX., MAX. WEIGHT PER CONNECTION IS
- 2. FOR 3" CONDUIT, SUPPORTS @ 6'-0" OC MAX., MAX. WEIGHT PER CONNECTION IS 50LBS. 3. FOR 4" CONDUIT, SUPPORTS @ 4'-0" OC MAX., MAX. WEIGHT PER CONNECTION IS 55LBS.

NO SCALE

NO SCALE

NOTES:

HORIZONTAL CONDUIT TO WALL DETAIL

CONCRETE FILLED METAL DECK. 3/8" DIAMETER HILTI KB-TZ2-W/ 2" EMBEDMENT MIN., TYPICAL. 3/8" DIAMETER THREADED 1-5/8" x 3-1/4", 1-5/8" x 7/8", 1-5/8" ROD COUPLER, TYPICAL. —1" MIN. x 1-5/8". OR 7/8" x 7/8" x12 GA PROVIDE REDUCING ROD SINGLE CHANNEL STRUT, 16" COUPLING WHERE 1/4" MIN. LENGTH, WHEN ROD IS ROD IS USED. NOT CENTERED ON LOW FLUTE PROVIDE W/ (2) 3/8" DIAMETER HILTI KBTZ2 W/ 2" EMBEDMENT 1/4" OR 3/8" DIAMETER ALL THREADED ROD, TYPICAL. PROVIDE SPRING CHANNEL ALLOWABLE WEIGHT NUT, SQUARE WASHER, AND SUPPORTED BY SINGLE ROD HEX NUT FOR THREADED ROD IS 50 POUNDS. CONNECTION.

### NOTES:

-1-5/8" x 3-1/4", 1-5/8" x 7/8", 1-5/8" x

1-5/8", OR 7/8" x 7/8" x12 GA SINGLE

-3/4" TO 1-1/4" MAX. CONDUIT. MAX.


CONTENTS = 2.5 LBS/FT, TYPICAL.

CHANNEL STRUT.

WEIGHT, CONDUIT AND

- VERIFY THAT CONCRETE OVER METAL DECK MUST COMPLY WITH FIGURES 5A TO 5D IN ICC ESR-4266. UPON INSTALLATION OF FASTENER INTO CONCRETE FILLED METAL DECK, CONTRACTOR TO PATCH/REPAIR DAMAGE TO EXISTING. SPRAY APPLIED FIREPROOFING, AS REQUIRED, TO RESTORE ORIGINAL FIREPROOFING THICKNESS AND FIRE RATING.
- ANCHOR MAY BE PLACED AT HIGH OR LOW FLUTE, CENTER ANCHOR IN FLUTE. TORQUE TEST 50% OF EXPANSION ANCHORS TO 30FT-LBS. SEE "POST INSTALLED" NOTES AND "POST INSTALLED
- ANCHOR TESTING CRITERIA" NOTES ON STRUCTURAL DRAWINGS FOR ADDITIONAL REQUIREMENTS SEE SHEET A635 FOR ALTERNATE ANCHORAGE TO CONCRETE FILLED METAL DECK.
- THREADED ROD TO CONCRETE FILLED METAL DECK HILTI ANCHORS

NO SCALE

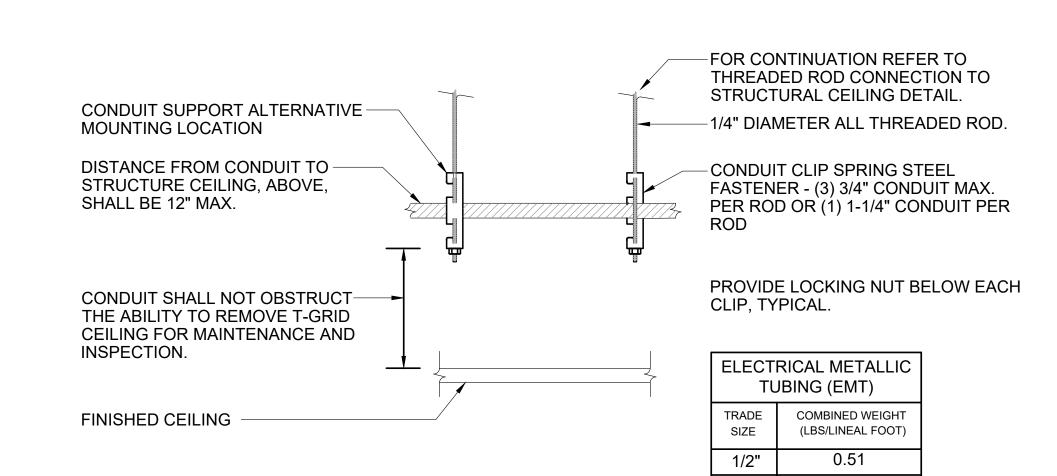


### **NOTES**

- SPACING BETWEEN SUPPORTS SHALL BE 10' MAXIMUM. MAXIMUM TOTAL LOAD PER CLIP IS 20LBS.
- 5 PLF MAXIMUM CONDUIT WEIGHT.

### THREADED ROD CONDUIT SUPPORT DETAIL

NO SCALE

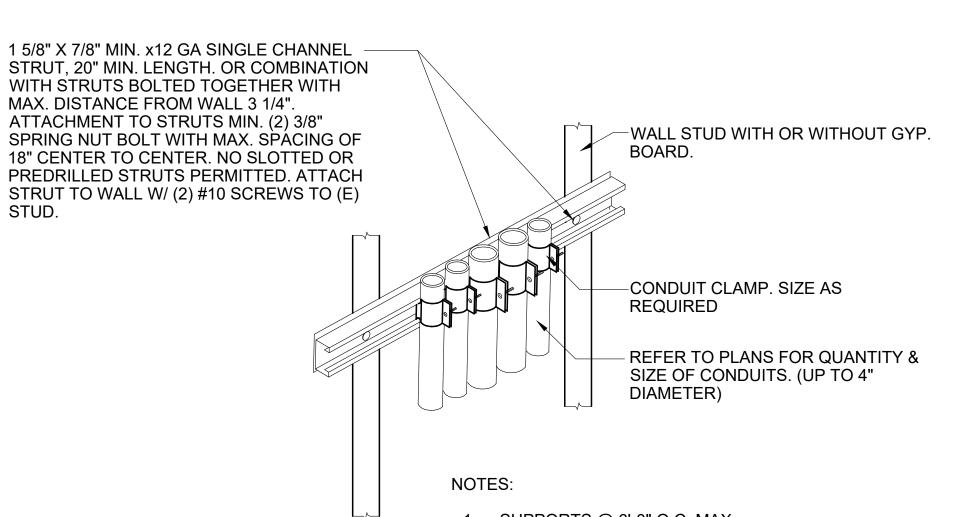

- 3. CONDUITS SHALL NOT EXCEED 10 PLF OR 100LBS MAX PER SPAN.

MULTIPLE VERTICAL CONDUIT SUPPORT DETAIL

NO SCALE

Project Number \_\_\_ Contact \_\_\_\_\_JOHNNY 400 R Street, Ste 333 Sacramento, CA 95811 916.256.2460 Sacramento | Alameda | Irvine

**UCDAVIS** 

HEALTH

FACILITIES DESIGN & CONSTRUCTION 4800 2ND AVENUE SUITE 3010 SACRAMENTO, CALIFORNIA 95817

(916)734-7<del>02</del>4

EPARTMENT OF HEALTHCARE ACCESS AND INFORMATION:

600 Q Street, Suite 100

Sacramento, CA 95811

www.nachtlewis.com

916.329.4000

REV	REVISION DESCRIPTION	DATE
2	ADDENDUM 1 (ACD-001)	10/14/202

CONSTRUCTION DOCUMENTS

ENC 出た S 00 E<sup>7</sup>

AS SHOWN Z. Price DESIGNED BY DATE J. Luong CAD FILE SHEET J. Luong

12 -0, -0, SSHPH NO.:
SSHPH NO.:
SSHPH NO.:
SHPH NO.: SUPPORTS @ 6'-0" O.C. MAX. J. Flath VERTICAL APPLICATION TO SINGLE STUD SIMILAR. STRUT TO BE 4" LONG MIN. CDMC PROJECT MANAGER


0.84

1.30

2.12

3/4"


1-1/4"

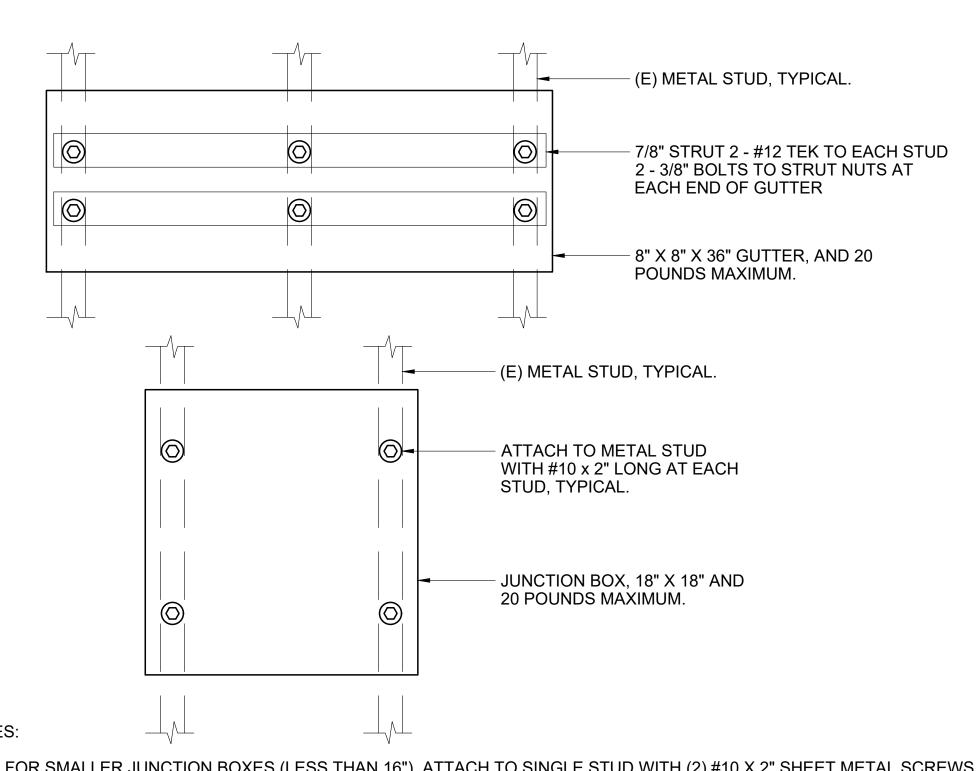

1. FOR SMALLER JUNCTION BOXES (LESS THAN 16"), ATTACH TO SINGLE STUD WITH (2) #10 X 2" SHEET METAL SCREWS. 2. SIMILAR AT CONDITION WITH OR WITHOUT GYP SHEATHING.

### JUNCTION BOX MOUNTED TO DRYWALL DETAIL

NO SCALE

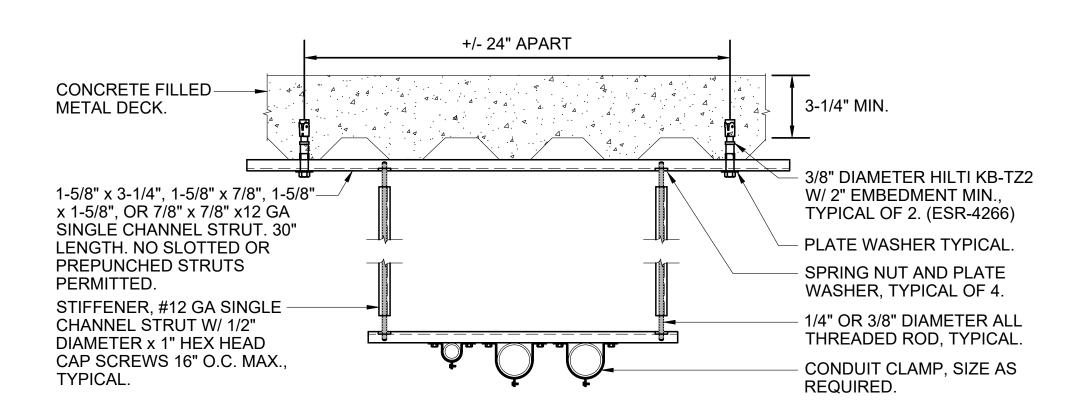


- 1. SPACING BETWEEN HANGERS SHALL BE PER CEC REQUIREMENTS, NOT EXCEEDING 3 FEET OF EACH
- RACEWAY TERMINATION, MAXIMUM OF 10 FEET BETWEEN SUPPORTS. ALL BACK TO BACK CHANNEL SHALL HAVE FILLET WELDS ON BOTH SIDES.
- PLACEMENT OF TRAPEZE SHALL NOT OBSTRUCT THE REMOVAL AND/OR INSTALLATION OF CEILING
- MATERIALS WHETHER FOR CONSTRUCTION OR MAINTENANCE.




### CONDUIT TRAPEZE MOUNTING TO CONCRETE FILLED METAL DECK DETAIL

NO SCALE

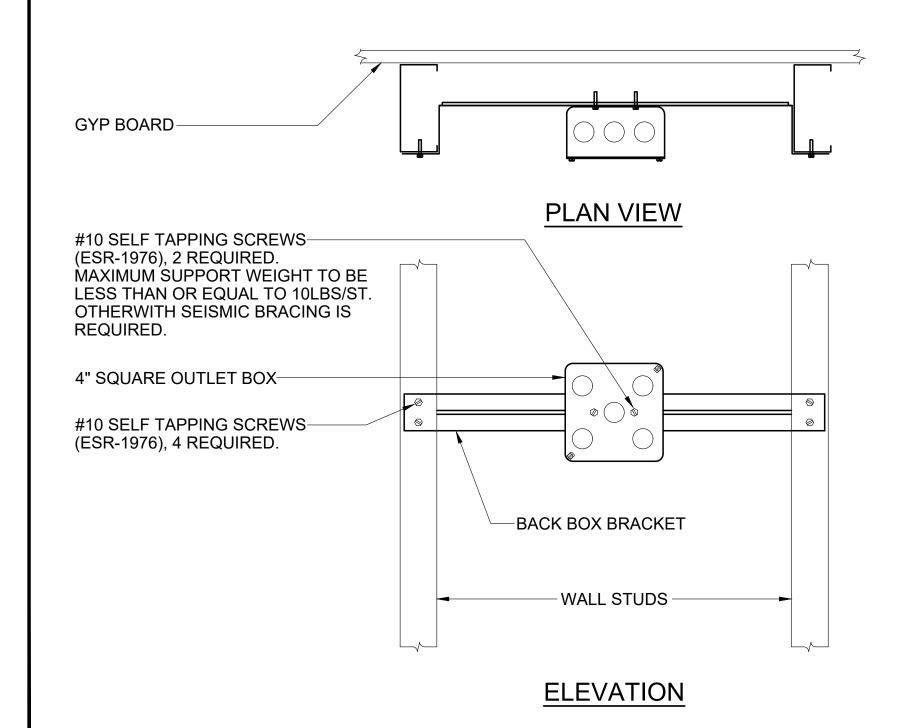

**BOX SUPPORT (BETWEEN STUDS)** 

NO SCALE

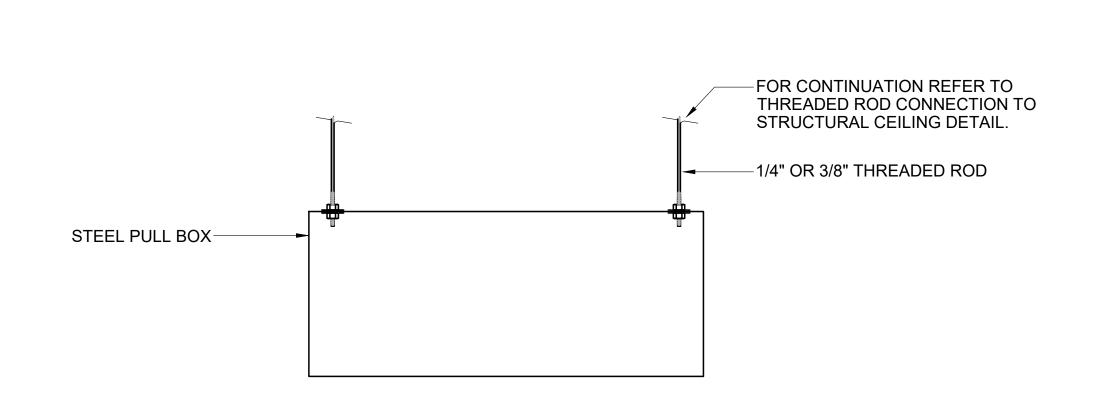


### NOTES:

1. SPACING BETWEEN HANGERS SHALL BE PER CEC REQUIREMENTS.

### LARGE PULL BOX SUPPORT DETAIL


NO SCALE

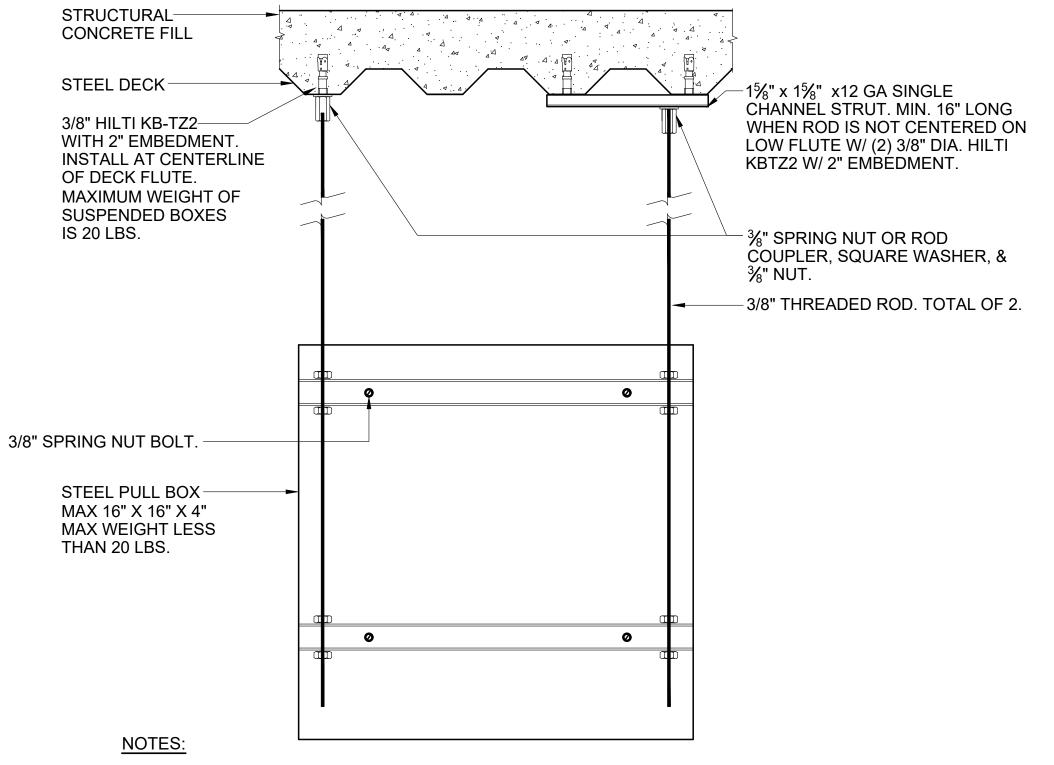

. SPACING BETWEEN HANGERS SHALL BE PER CEC REQUIREMENTS. 2. ANCHOR MAY BE PLACED AT HIGH OR LOW FLUTE. CENTER ANCHOR IN THE FLUTE.

### TYPICAL - LARGE PULL BOX SUPPORT DETAIL


NO SCALE

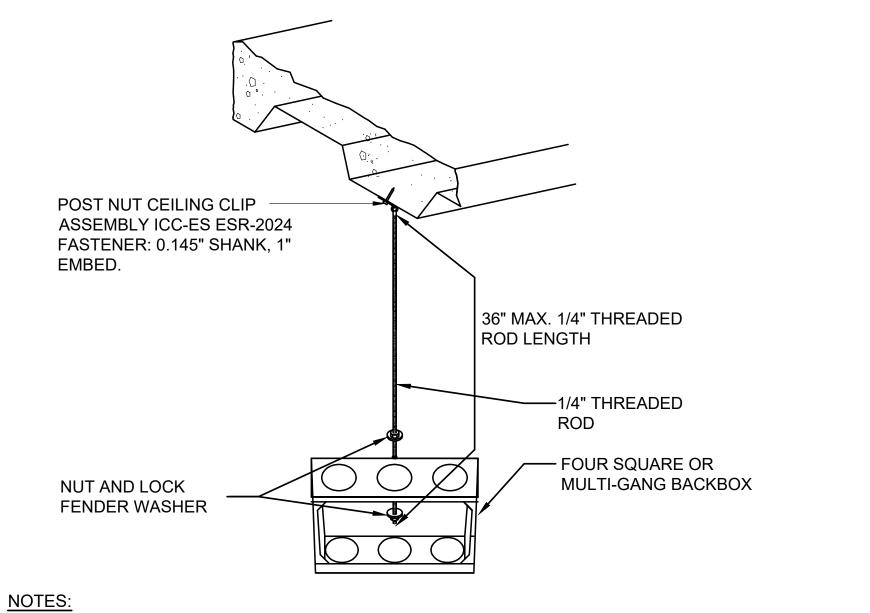


1. MAXIMUM WEIGHT = 20 LBS.

### SUSPENDED BOX MOUNTING DETAIL

NO SCALE

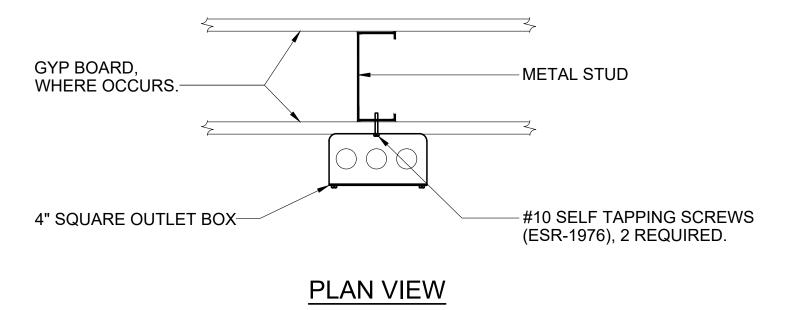


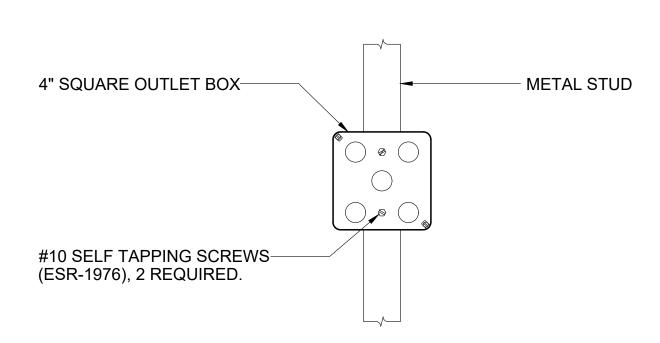

**ELEVATION** 


### **BOX SUPPORT (ON STUD)**

NO SCALE

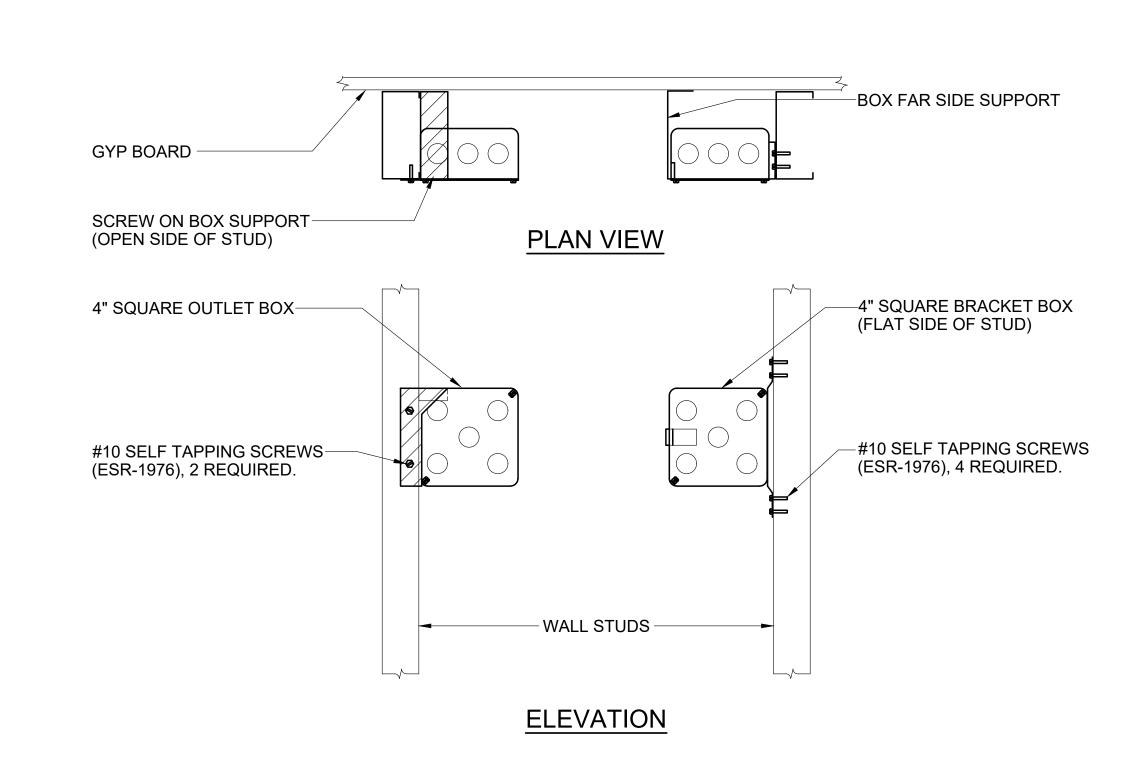

### **BOX SUPPORT (ON STUDS)**

NO SCALE

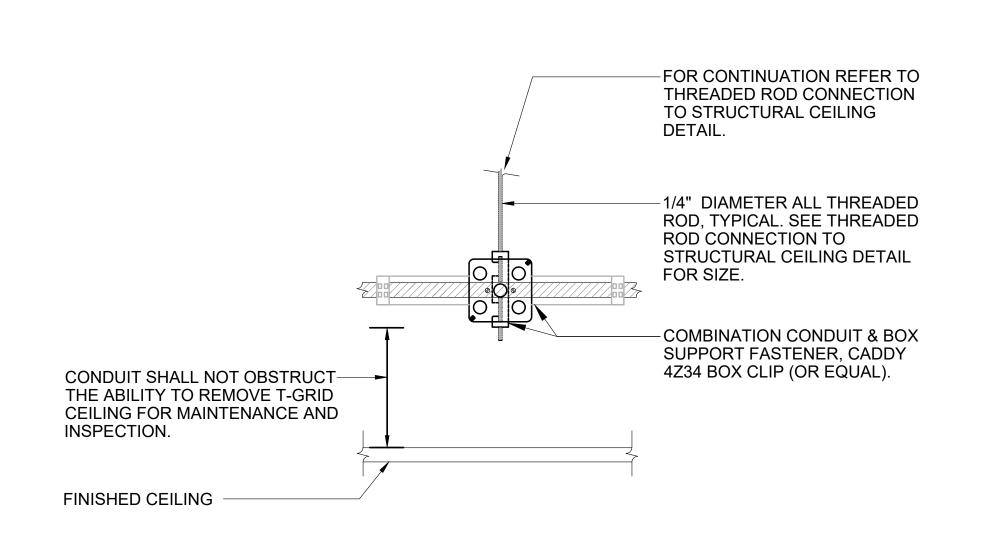

NOTES:

1. UPON INSTALLATION OF FASTENER INTO CONCRETE FILLED METAL DECK. CONTRACTOR TO PATCH/REPAIR DAMAGE TO EXISTING SPRAY APPLIED FIREPROOFING, AS REQUIRED, TO RESTORE ORIGINAL FIREPROOFING THICKNESS AND FIRE RATING.

SUSPENDED BOX AND CONDUIT SUPPORT FASTENER DETAIL

NO SCALE

EPARTMENT OF HEALTHCARE ACCESS AND INFORMATION:

600 Q Street, Suite 100 Sacramento, CA 95811 www.nachtlewis.com 916.329.4000

**UCDAVIS** HEALTH

FACILITIES DESIGN & CONSTRUCTION 4800 2ND AVENUE SUITE 3010 SACRAMENTO, CALIFORNIA 95817 [916]734-7<del>02</del>4




ADDENDUM 1 (ACD-001) 0/14/2025

CONSTRUCTION DOCUMENTS


ENC 42 ME 00 SL E<sup>2</sup>

SSPH NO.:
SSPH NO.:
SPHET TILE.
SHEET TILE. J. Flath JCDMC PROJECT MANAGEF SCALE Z. Price AS SHOWN DESIGNED BY DATE J. Luong DRAWN BY CAD FILE SHEET J. Luong

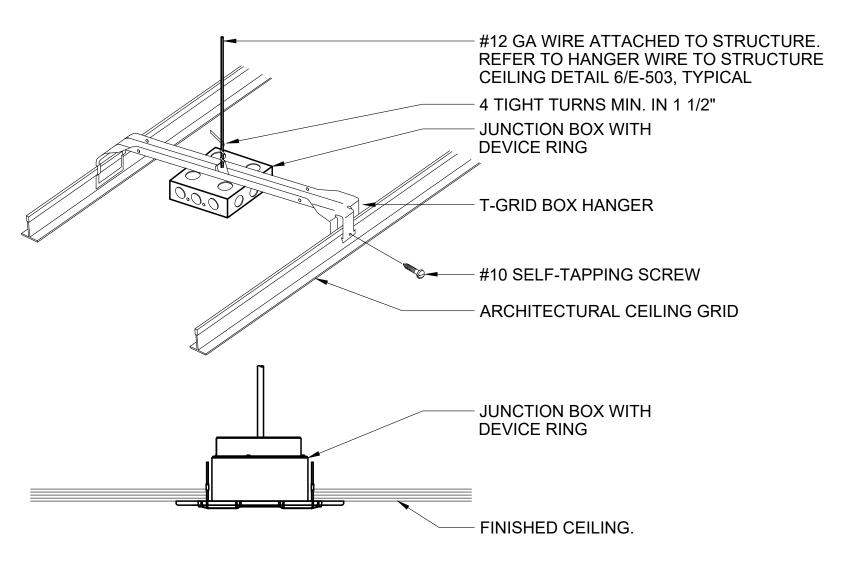


**CEILING MOUNTED JUNCTION BOX DETAIL** 

NO SCALE

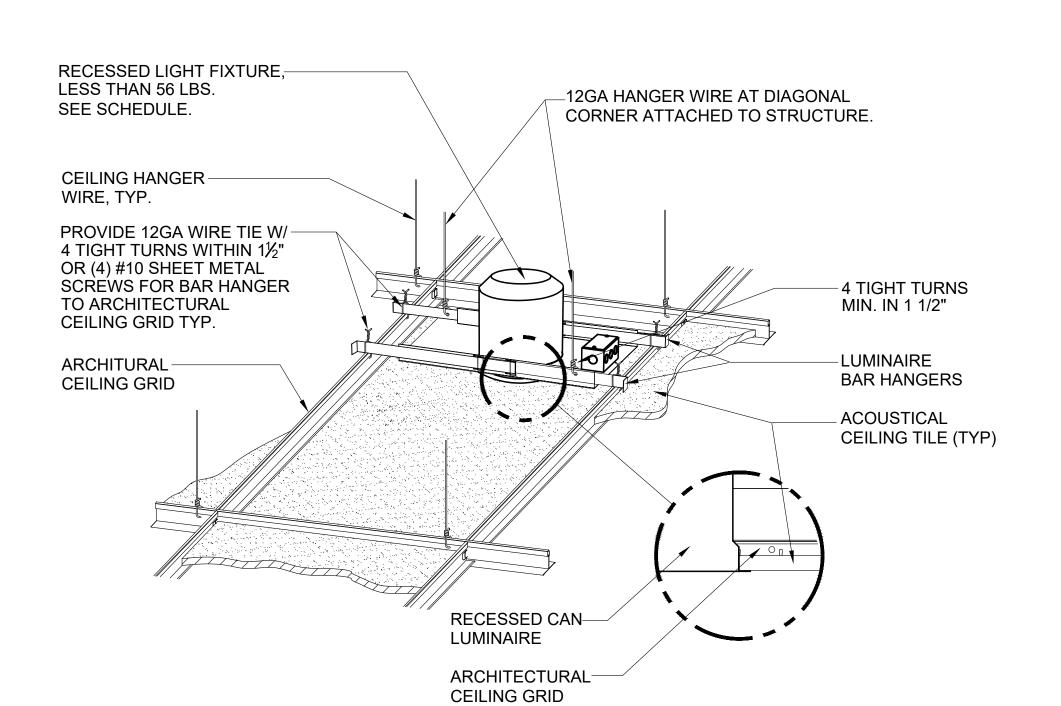

DOWNLIGHT FIXTURE MOUNTING DETAIL - LAY-IN CEILING

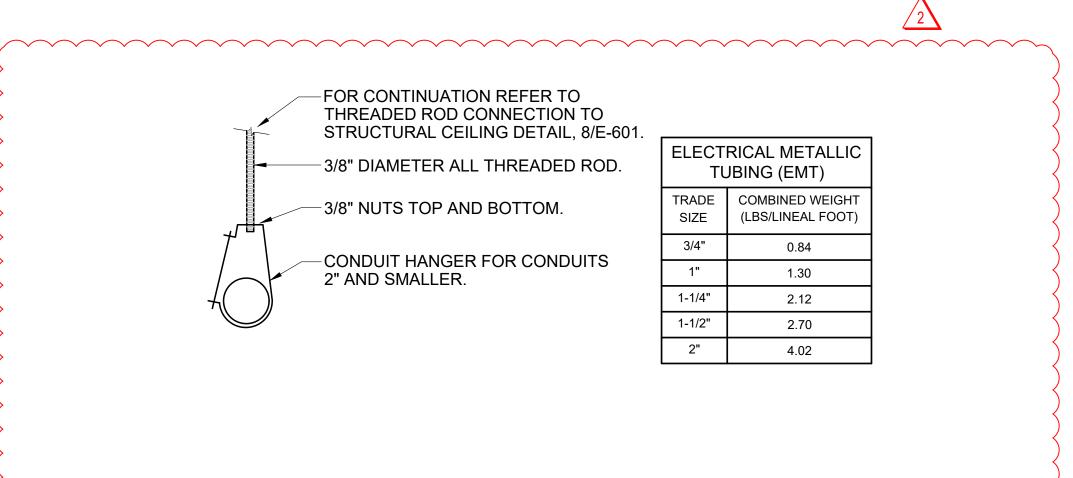


SPACING BETWEEN HANGERS SHALL BE PER CEC REQUIREMENTS. DO NOT EXCEED 3 FEET BETWEEN EACH RACEWAY TERMINATION AND MAXIMUM OF 10 FEET BETWEEN SUPPORTS. PLACEMENT OF HANGER SHALL NOT OBSTRUCT THE REMOVAL AND/OR INSTALLATION OF CEILING MATERIALS WHETHER FOR CONSTRUCTION OR MAINTENANCE.

\ CONDUIT SUPPORT DETAIL SCALE: NONE

METAL STUD 35/8" X 18 GA. MIN. ATTACH ACROSS THREE METAL STUDS WITH 3 #12 TEK SCREWS STUD WALL W/ GYP SHEATHING TOTAL OF SIX. (3 AT EACH STUD ONE OR BOTH SIDES (SIM. AT CONDITION W/O GYP SHEATHING). 8"x8"x36" MAX GUTTER

TYPICAL - GUTTER MOUNTING DETAIL

NO SCALE

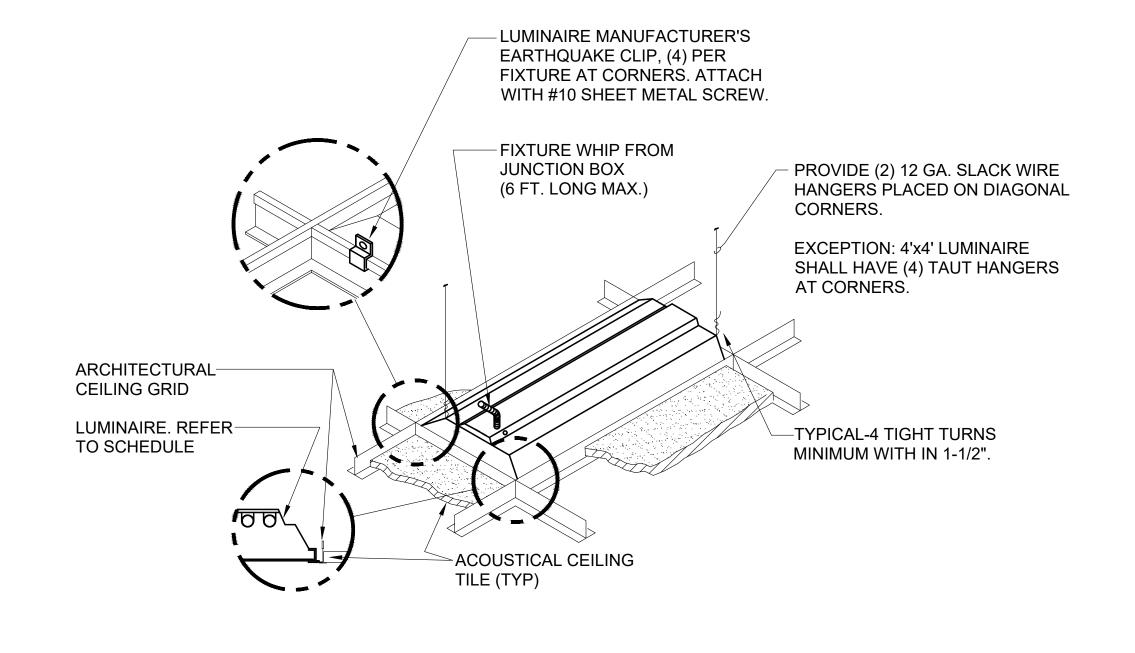


1. LUMINAIRE WEIGHT: LESS THAN 56LBS. 2. FOR LUMINAIRE WEIGHT MORE THAN 56LBS, SEE DETAIL "LIGHT FIXTURE MOUNTING DETAIL -LAY-IN CEILING W/ SEISMIC BRACING."

LIGHT FIXTURE MOUNTING DETAIL - LAY-IN CEILING SCALE: NONE

**DEVICE MOUNTING DETAIL** 

SCALE: NONE

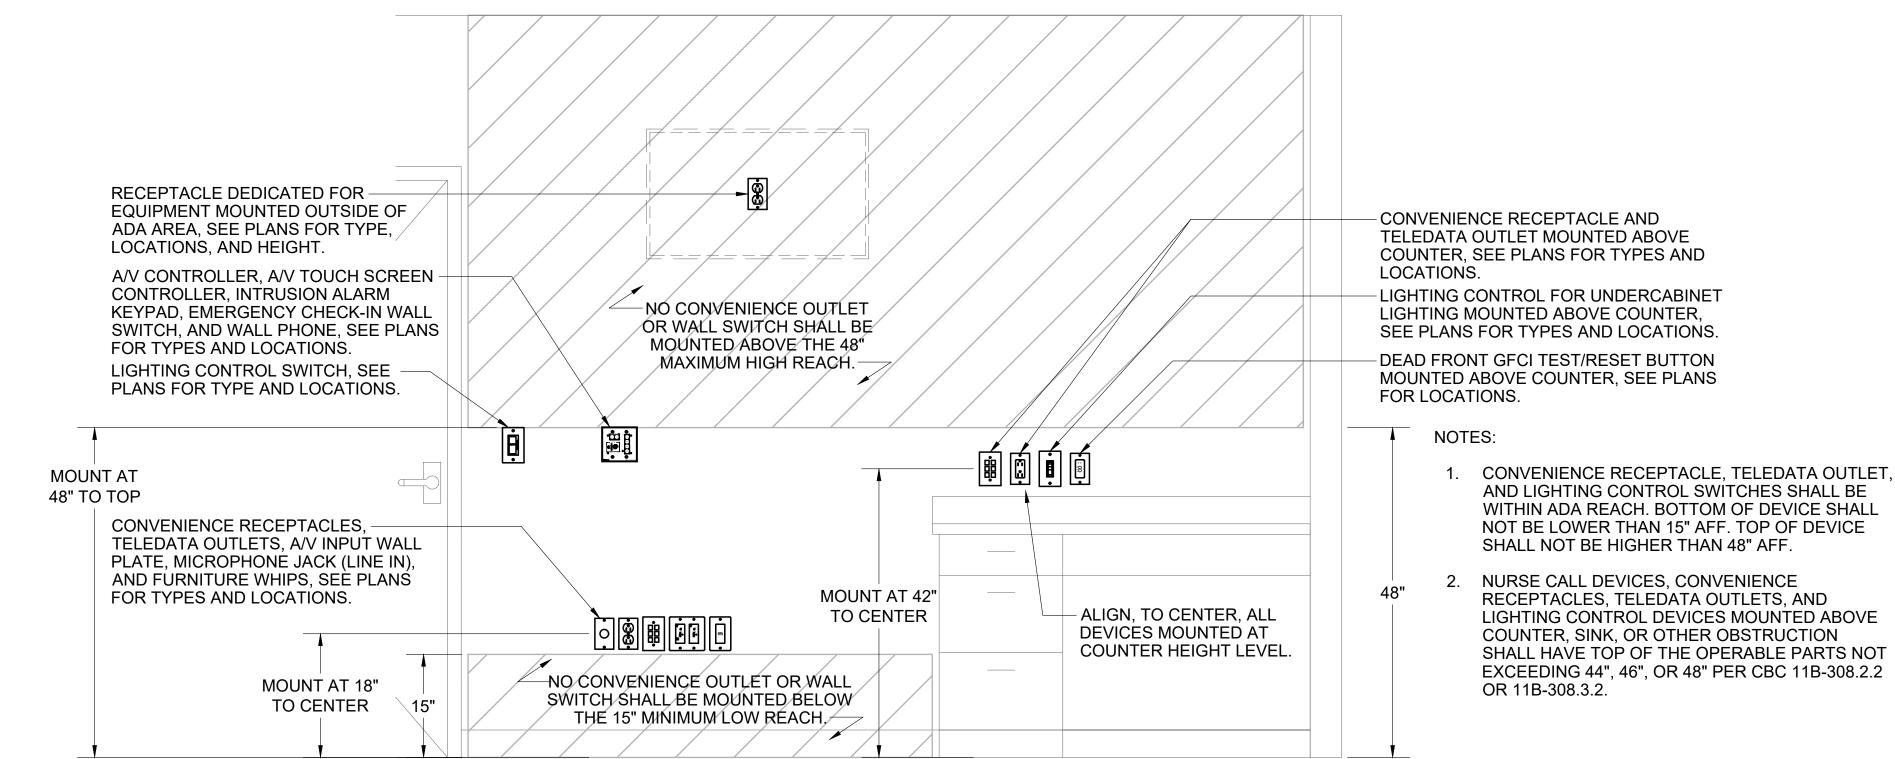

12 GA FLAT STRAP, 18" MAX. LENGTH. SPAN (2) STUDS. ATTACH TO METAL STUD WITH #10 x 2" LONG SHEET METAL SCREWS. - (E) METAL STUD AT 16" O.C. 3 5/8" x 18 GA. MIN., MAX. STUD HEIGHT. 1 5/8" X 7/8" MIN. x12 GA SINGLE JUNCTION BOX, MOUNT CHANNEL STRUT, 18" MAX. TO STRUT WITH 1/4" LENGTH. SPAN (2) STUDS. SPRING NUTS, BOLT ATTACH TO METAL STUD WITH AND FENDER WASHER. #10 x 2" LONG SHEET METAL MAX. WT = 20 POUNDS SCREWS. NO SLOTTED OR SPRING NUTS AND BOLTS PREDRILLED STRUTS SHALL BE TIGHTEN TO PERMITTED. 6FT-LBS PER MFR.

NOTE: SIMILAR AT CONDITION WITHOUT GYP. SHEATHING

WALL MOUNTED BOX SUPPORT DETAIL

NO SCALE

SEE PLANS FOR EXACT

CONFIGURATION

IDENTIFY COVER PLATE WITH PANEL AND -CIRCUIT NUMBER USING CLEAR THERMAL TRANSFER LAMINATED ADHESIVE TAPE WITH 1/8"H BLACK LETTERS. TYPICAL FOR RECEPTACLES AND LIGHTING CONTROL DEVICES. 2A-20 2A-20 2A-20 ON/OFF  $\Box$ DUPLEX RECEPTACLE - TYPICAL LIGHTING CONTROL AND COVER PLATE, DEVICE AND COVER PLATE,

RECEPTACLE AND LIGHT SWITCH DESIGNATION DETAIL

FACILITIES DESIGN & CONSTRUCTION 4800 2ND AVENUE SUITE 3010 SACRAMENTO, CALIFORNIA 95817 [916]734-7<del>02</del>4

**UCDAVIS** 

HEALTH

EPARTMENT OF HEALTHCARE ACCESS AND INFORMATION:

600 Q Street, Suite 100

Sacramento, CA 95811

www.nachtlewis.com

916.329.4000



ADDENDUM 1 (ACD-001) 0/14/202

CONSTRUCTION DOCUMENTS

22 00 SL E<sup>2</sup>

S241219S241219S241219BULDING:
BLD-028
FLOOR/WING:
1ST FLO
PROJECT TITE:
SHEET TITE:
CHARLES
SHEET TI J. Flath E7.06 JCDMC PROJECT MANAGER SCALE Z. Price **AS SHOWN** DESIGNED BY DATE J. Luong SHEET CAD FILE J. Luong

LIGHTING CONTROL DEVICES MOUNTED ABOVE COUNTER, SINK, OR OTHER OBSTRUCTION SHALL HAVE TOP OF THE OPERABLE PARTS NOT EXCEEDING 44", 46", OR 48" PER CBC 11B-308.2.2 OR 11B-308.3.2.

AND LIGHTING CONTROL SWITCHES SHALL BE

RECEPTACLES, TELEDATA OUTLETS, AND

SEE PLANS FOR EXACT

CONFIGURATION

